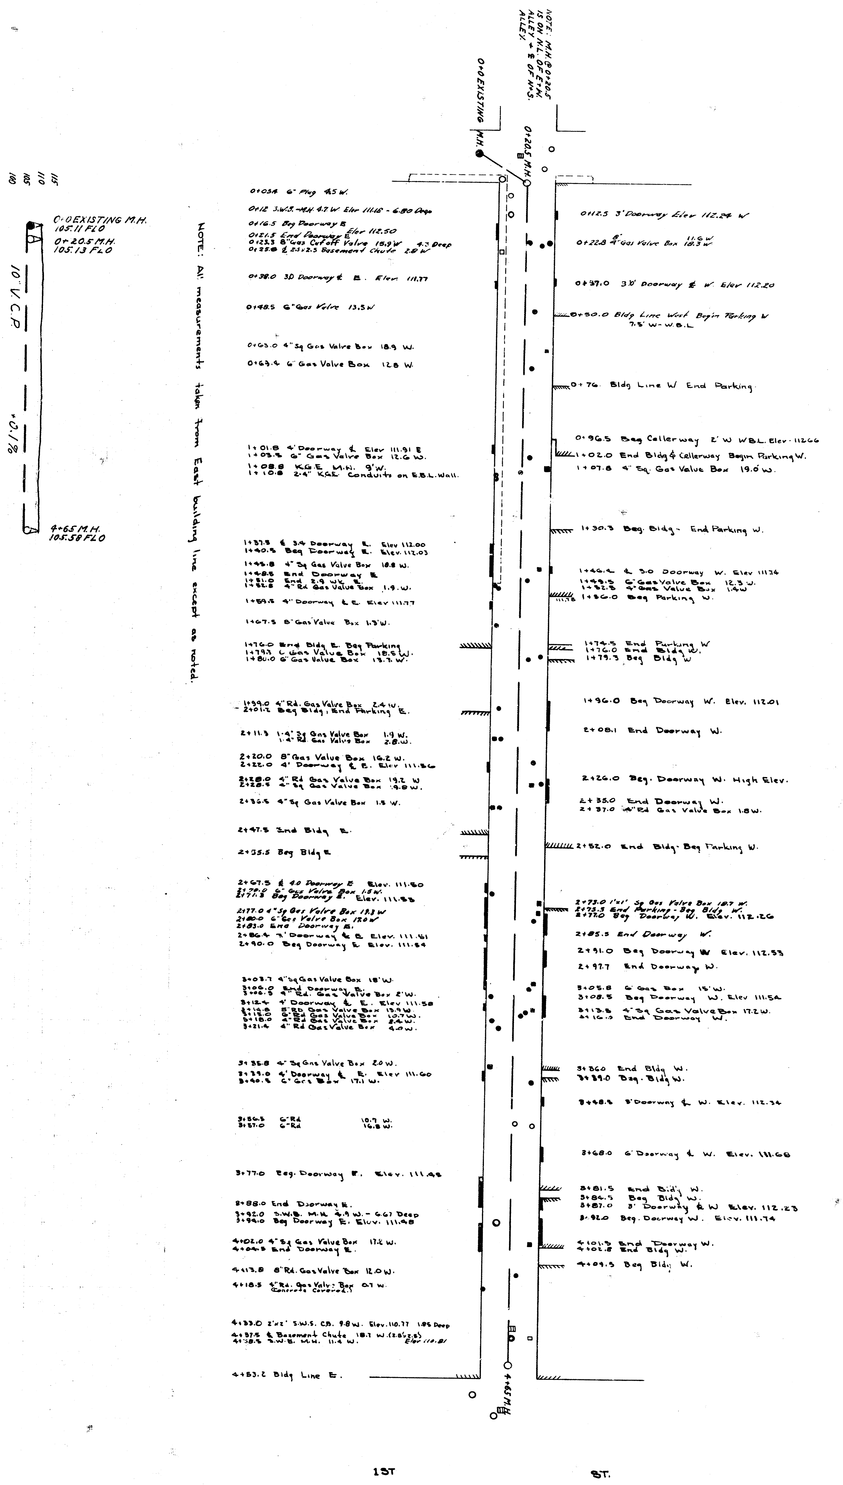

NOTE: All measurements taken from East building line except as noted.

DEPARTMENT of SERVICE
CITY of WICHITA, KANSAS
ENGINEERING DIVISION
L.K. WHITE - CITY ENGINEER
SANITARY SEWER
Scale: Profile 1" = 80' Plan 1" = 20'
APRIL 1947
S.S. 1 Between Broadway & Market from First to Alley N. of Douglas