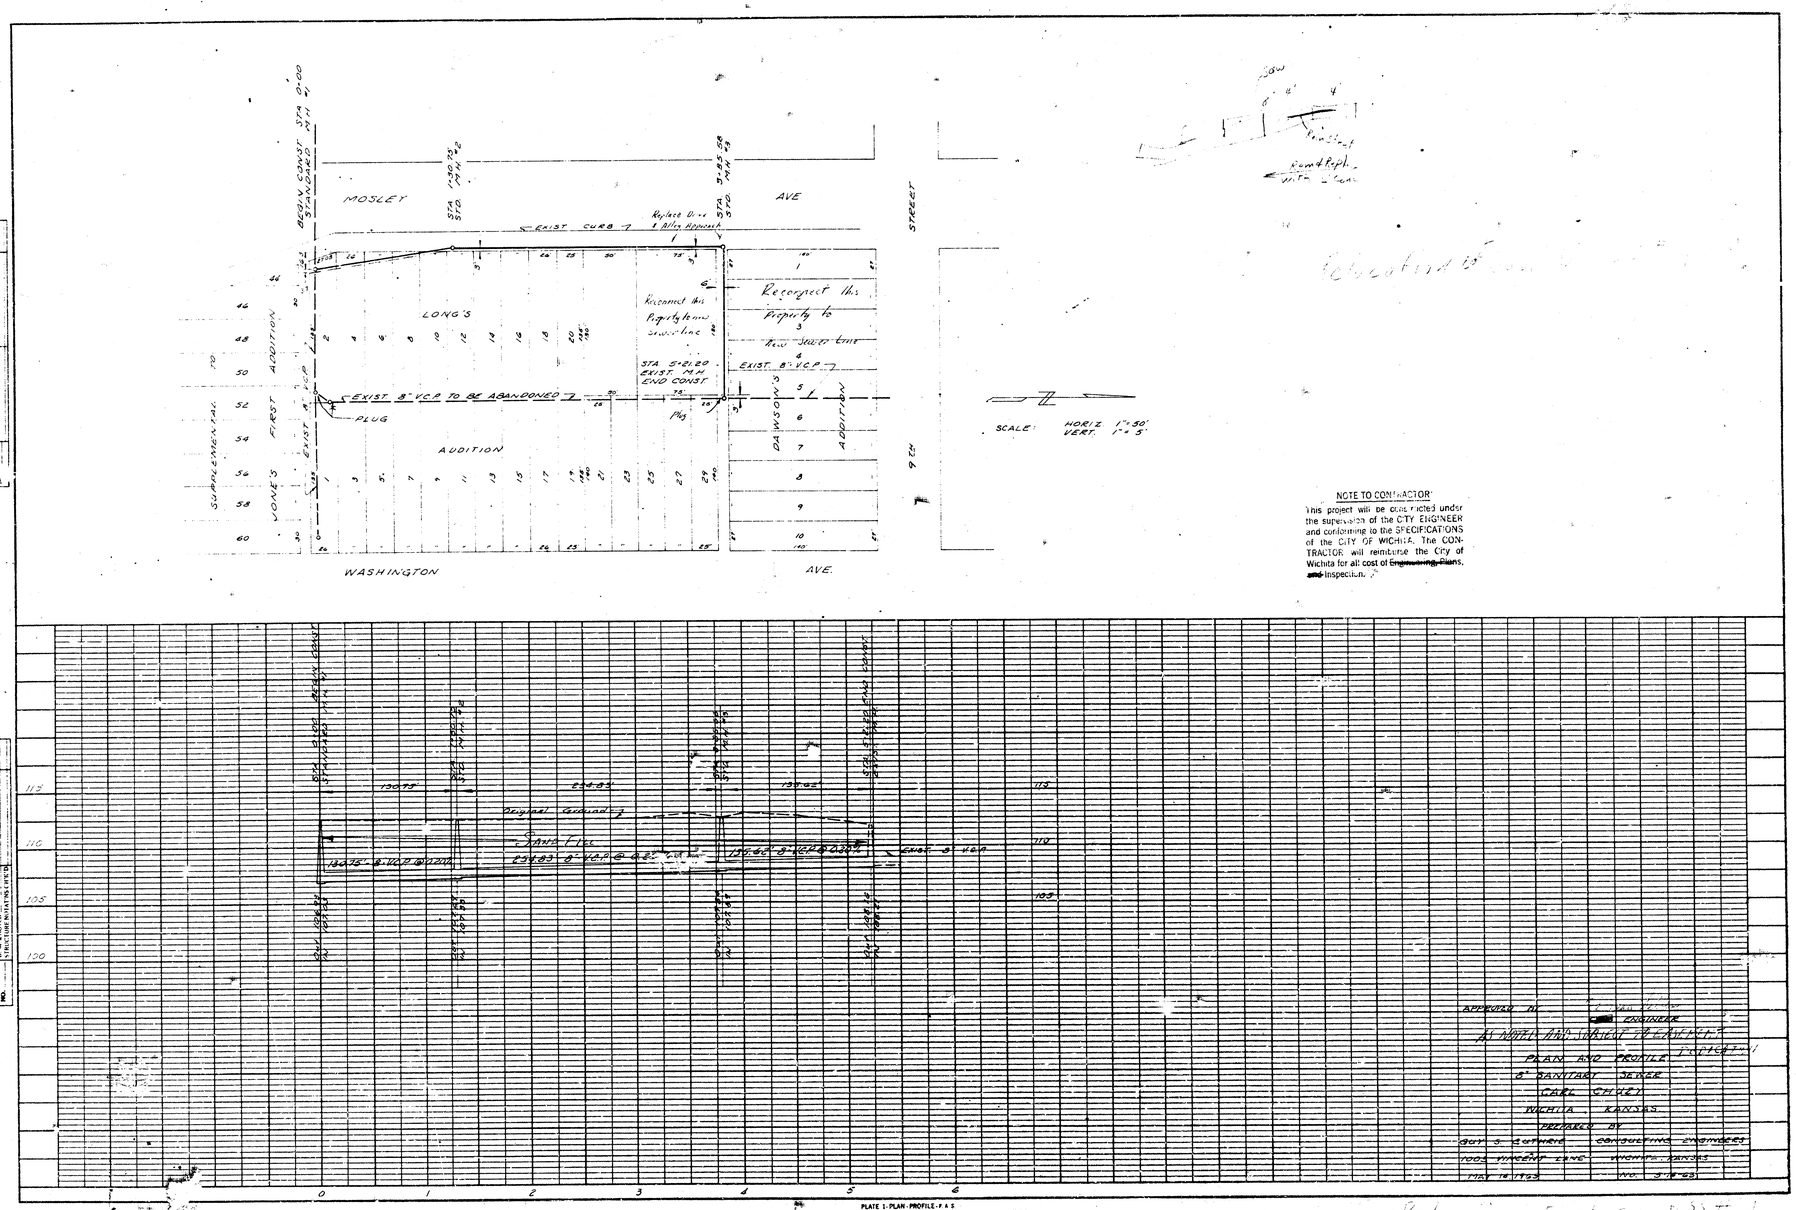

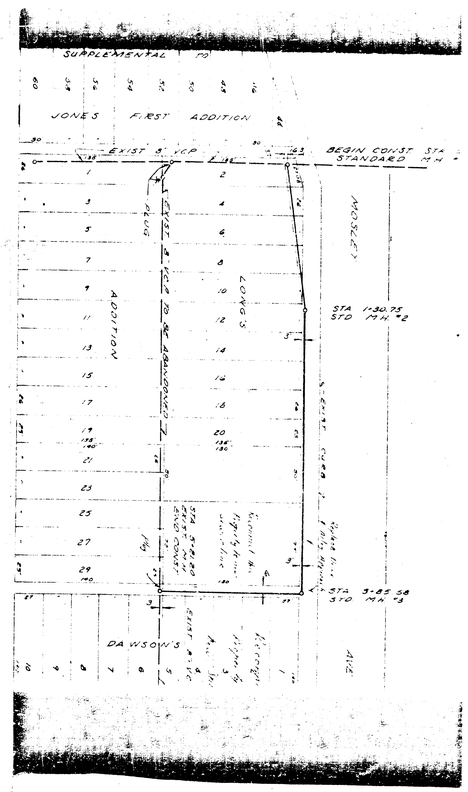

Relocation East Side #1