


Plan of Sewer District No. 3.

SCALE 100' = 1" ONE INCH

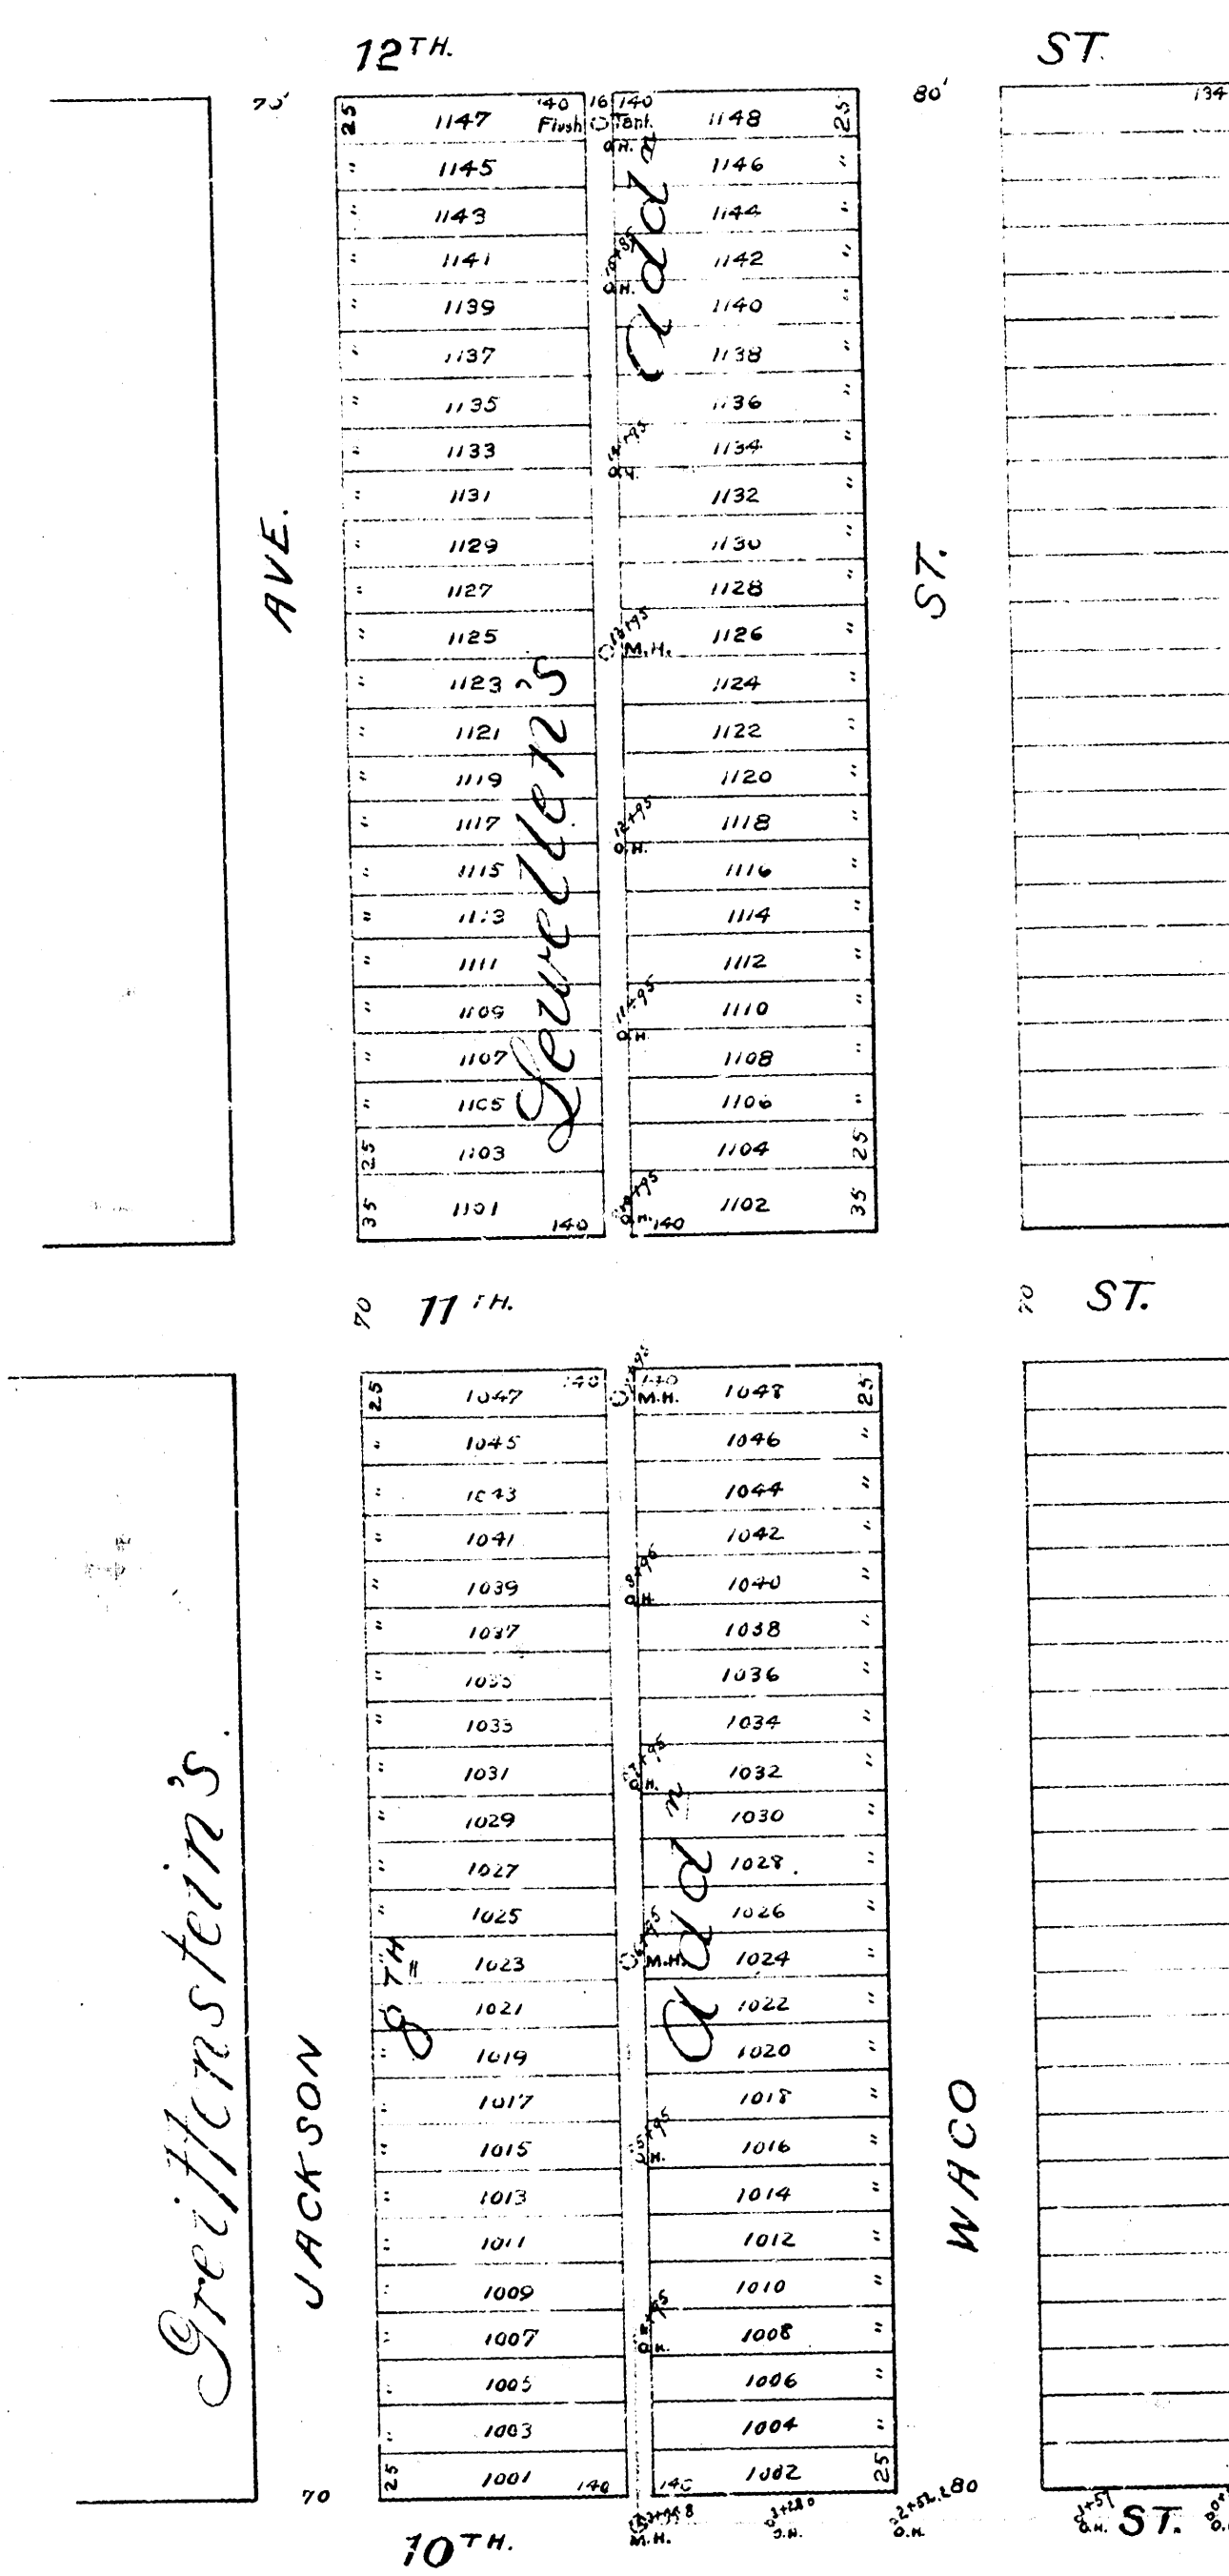

Jan. 1903
No. 3