


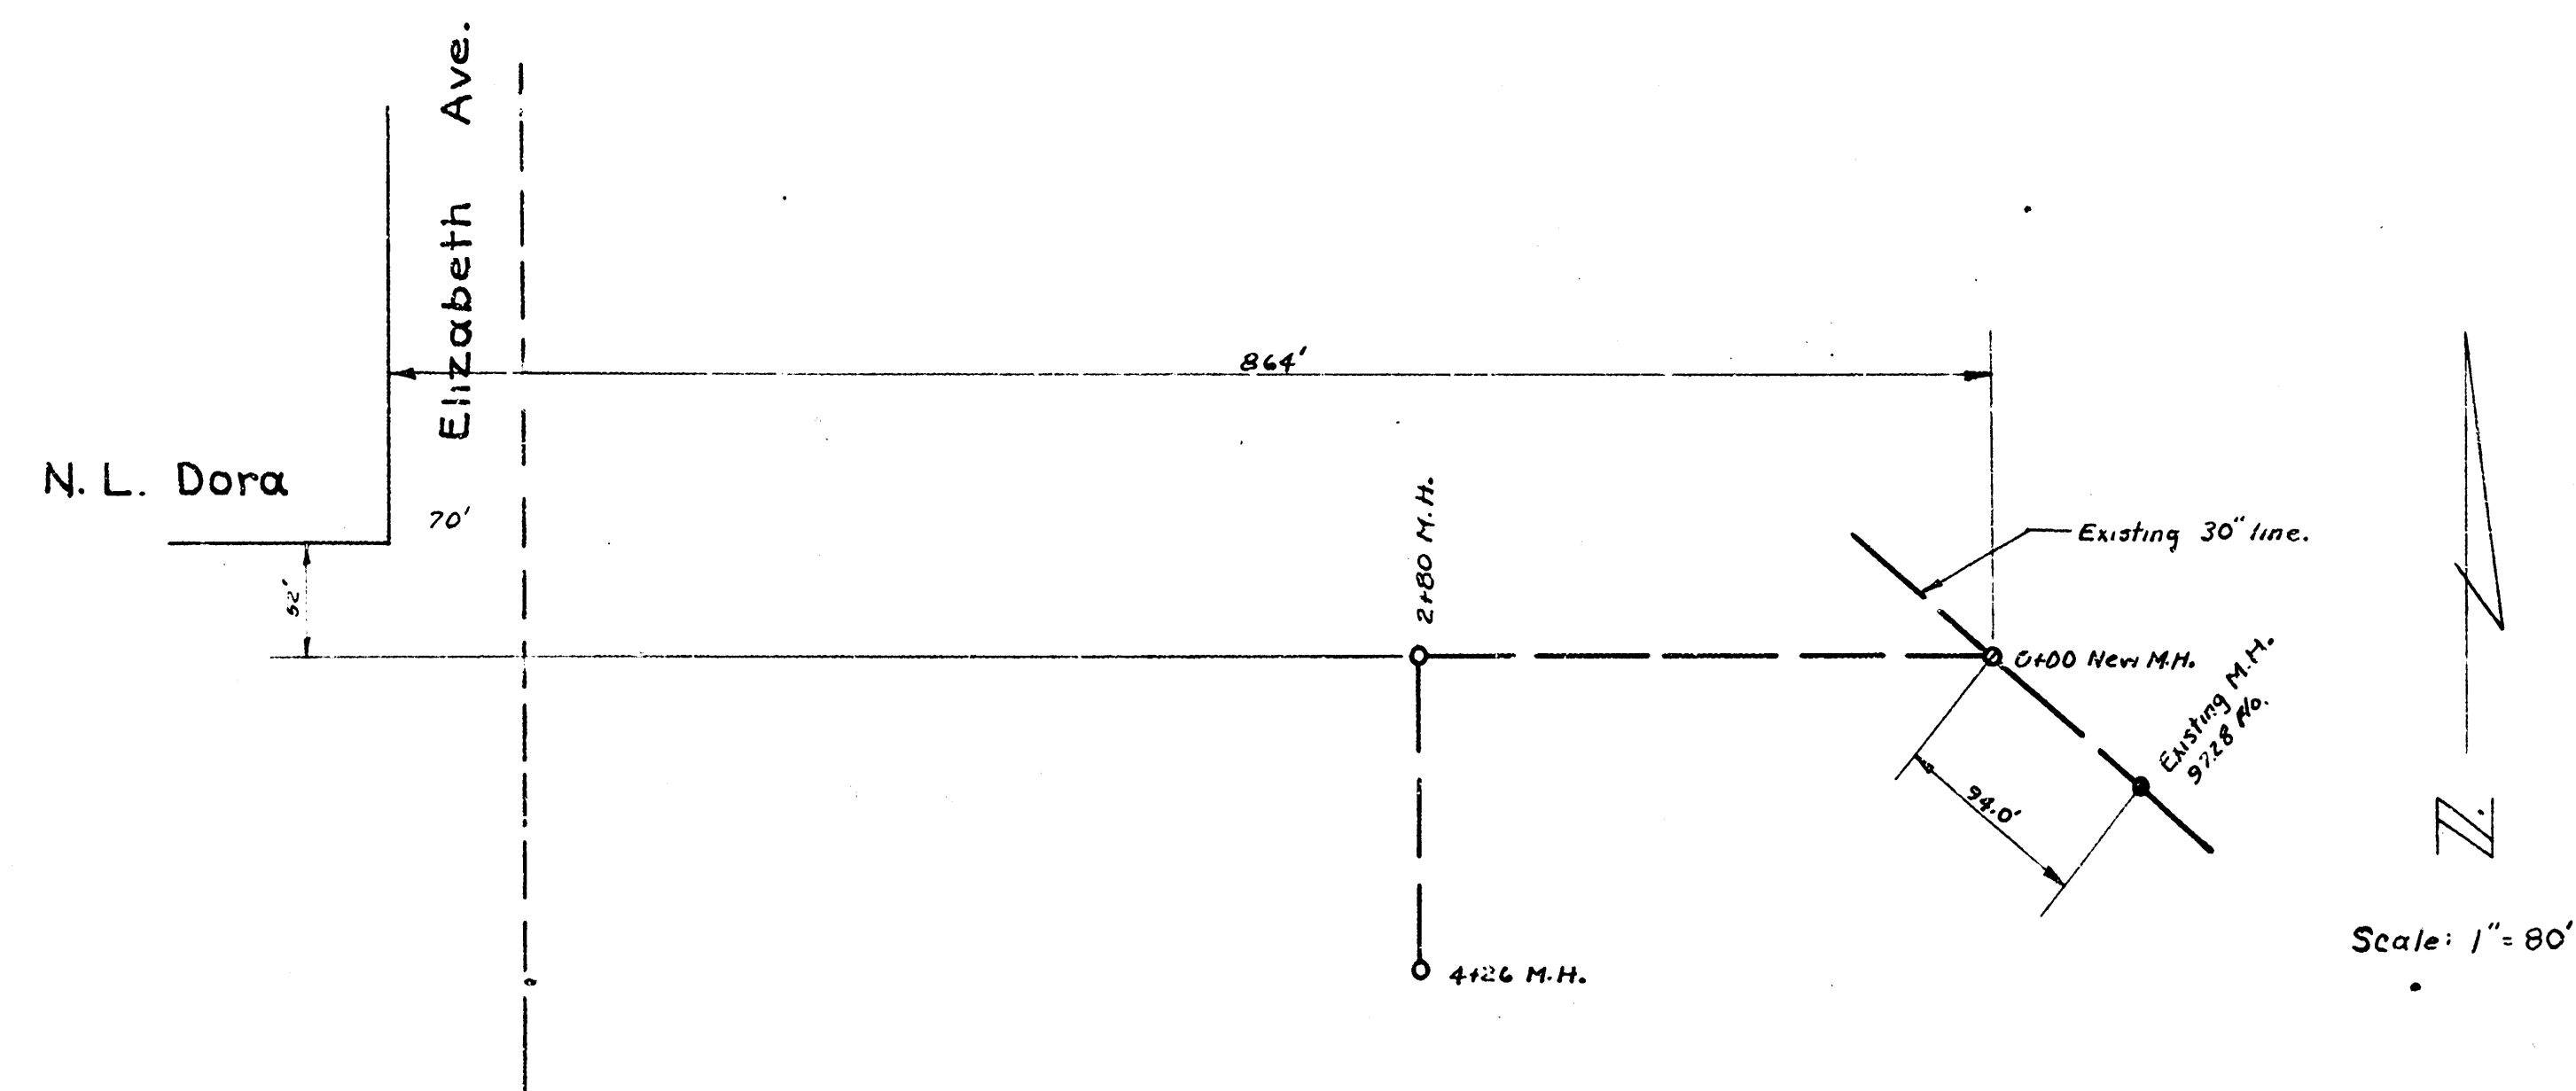


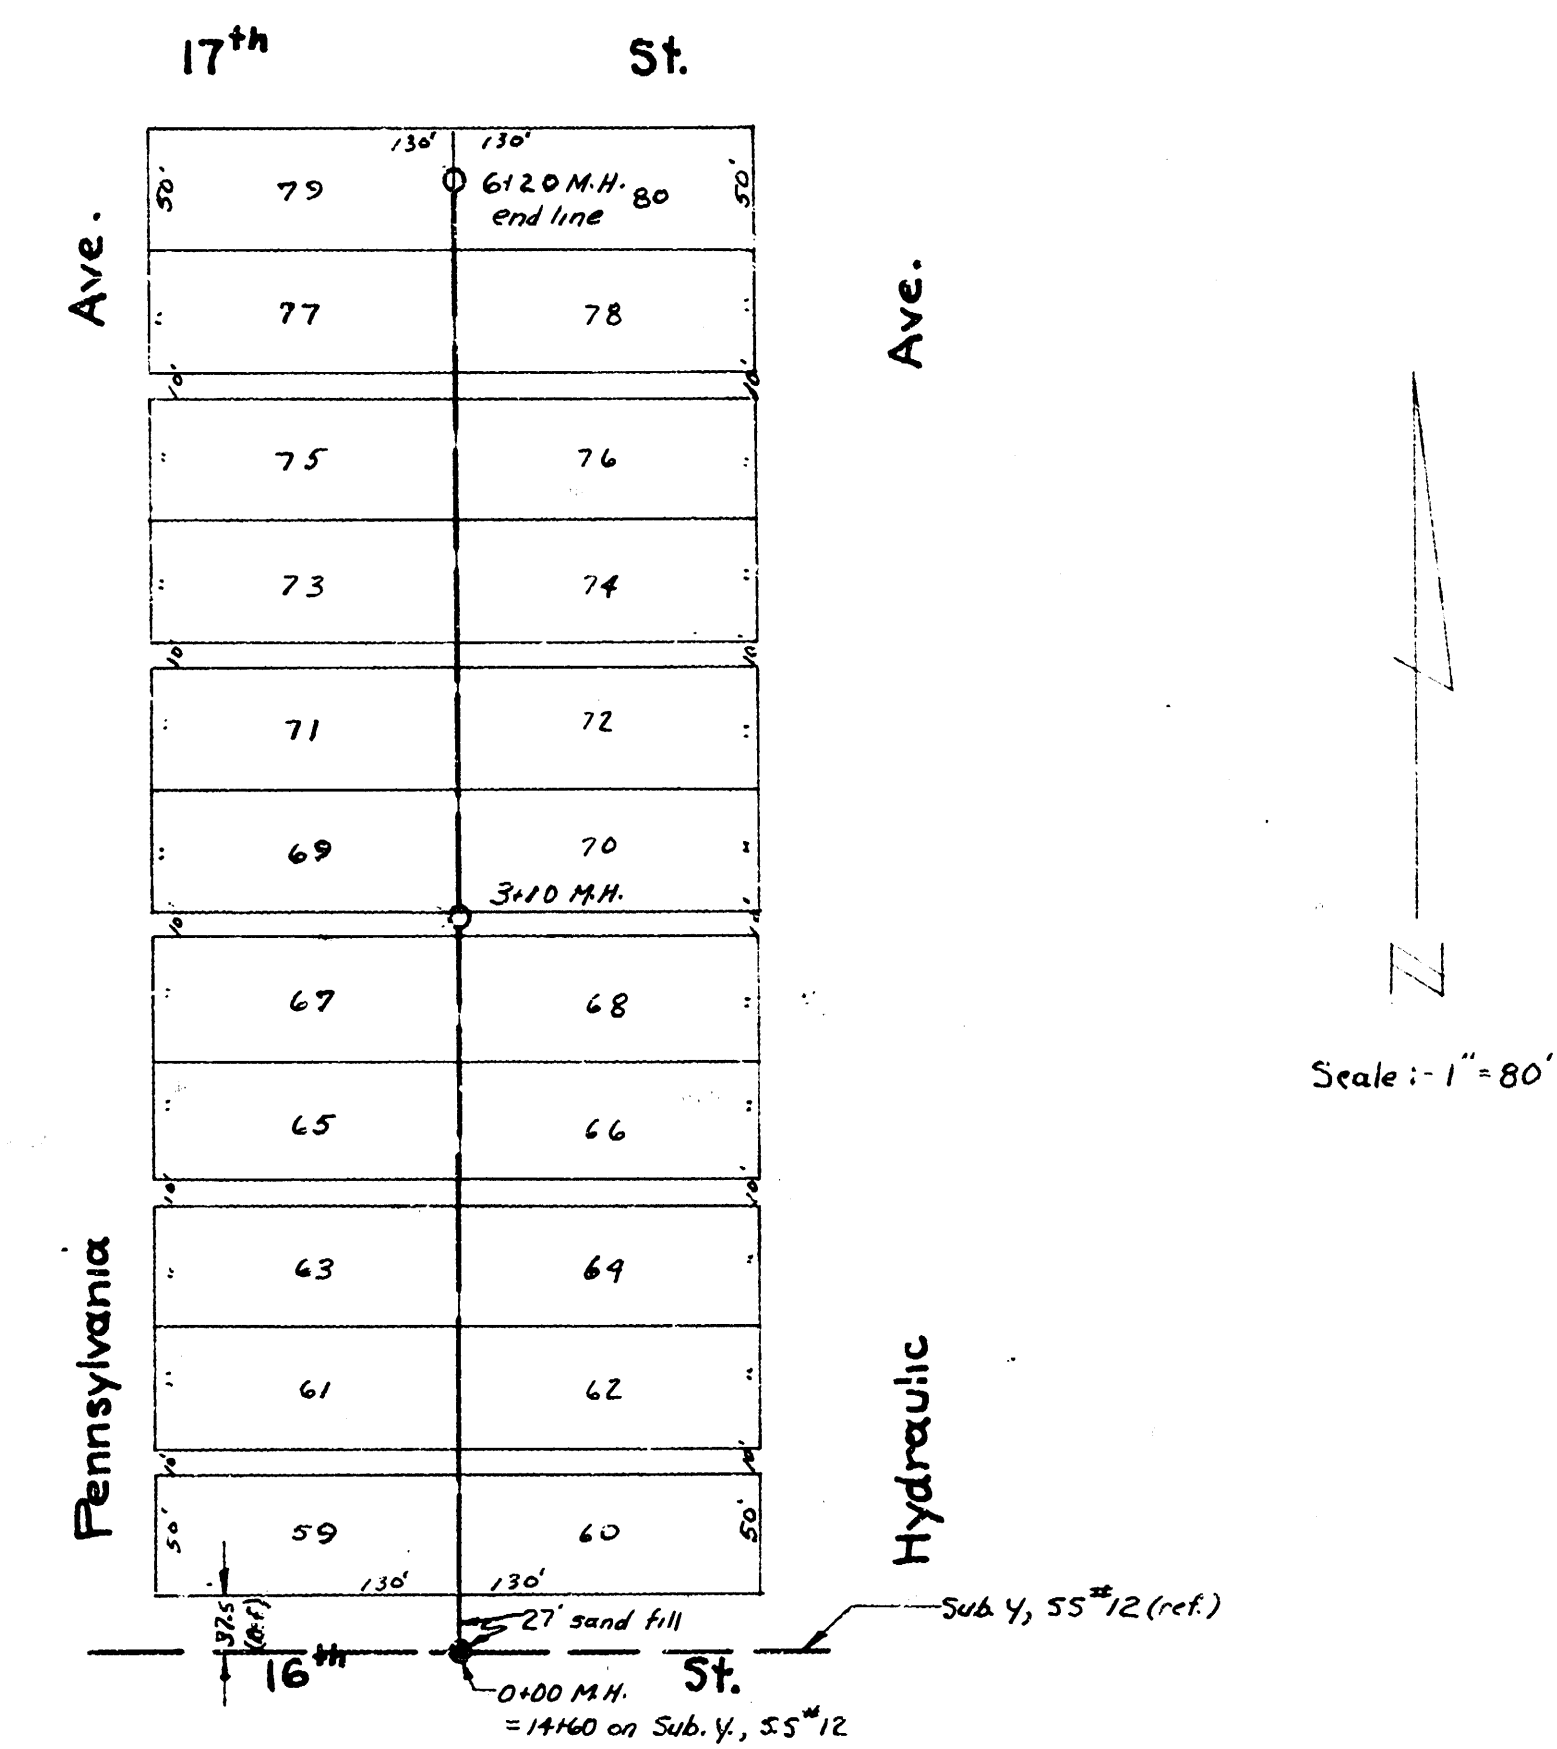

B. M. 10232 ~ Standard, S.W. Seneca & Wheeler.
 B. M. 10202 ~ 6" on S end of radius, W. ch. Seneca, N.L. Merton.
 B. M. 10129 ~ 5" S. ch. Esthner, W.L. Seneca.
 B. M. 10111 ~ 4" S. coping near NE. cor Bldg., S.W. Seneca & Dora.

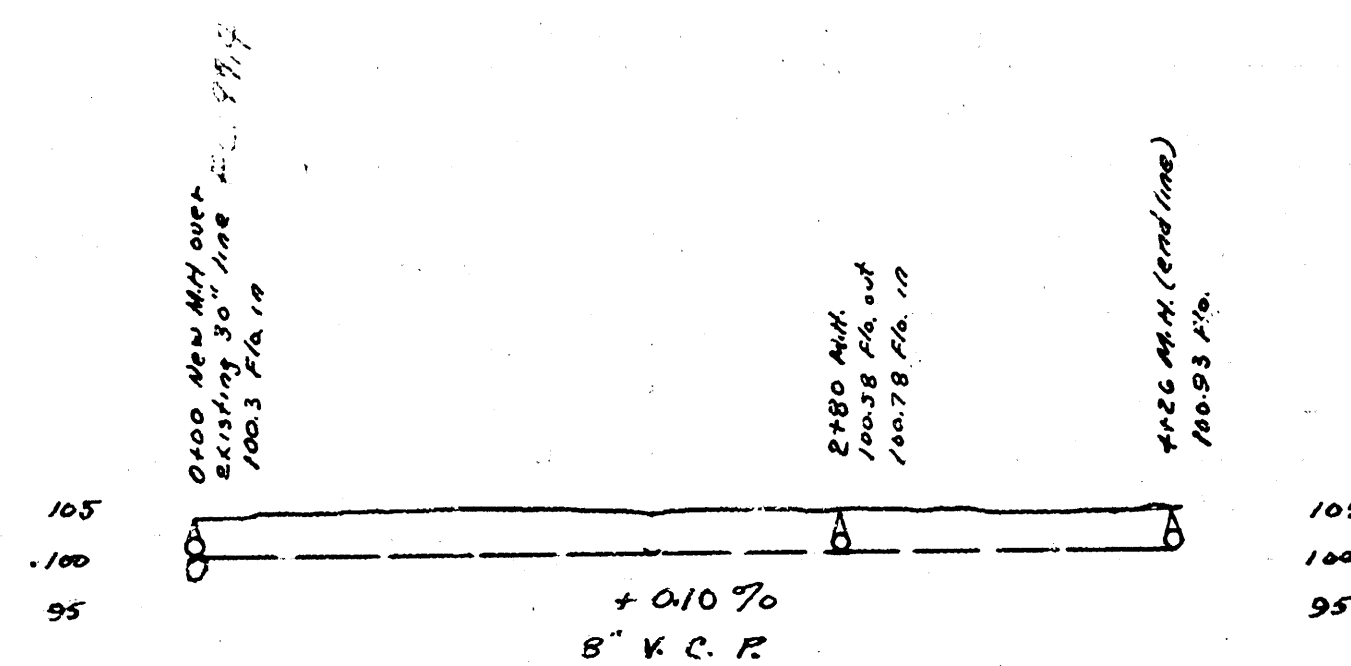

B. M. 11641 ~ R. rim of humble 16" & Hydraulic.

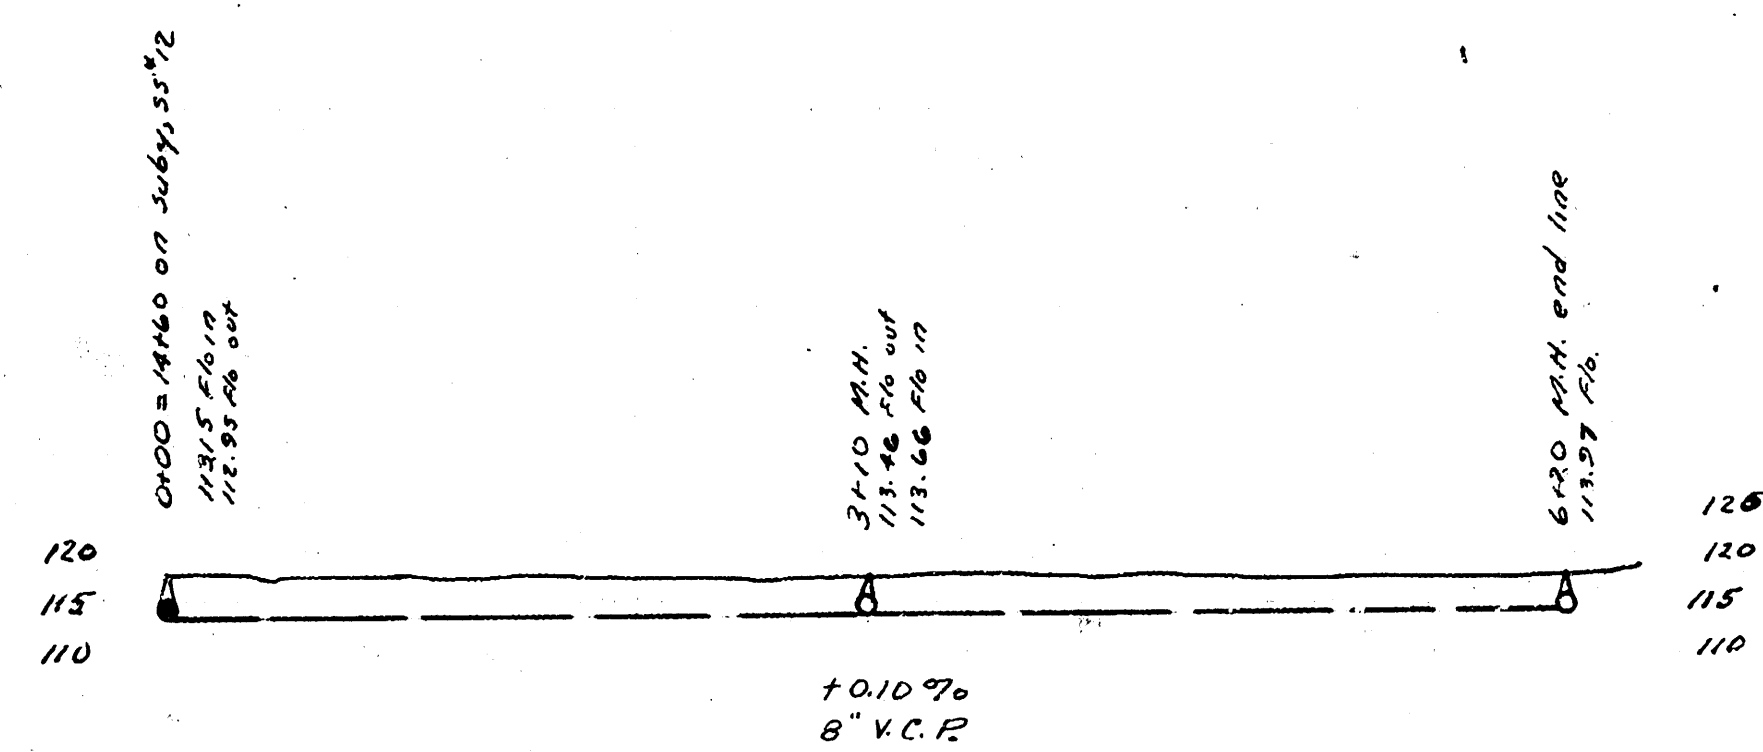

Lat. 23, Dist. T, S.S. No. 12
 Lat. M, S.S. No. 8
 City of Wichita, Kansas
 L. K. White ~ City Engineer
 Nov. 1950 Private Job
 Proj. C-20-30