

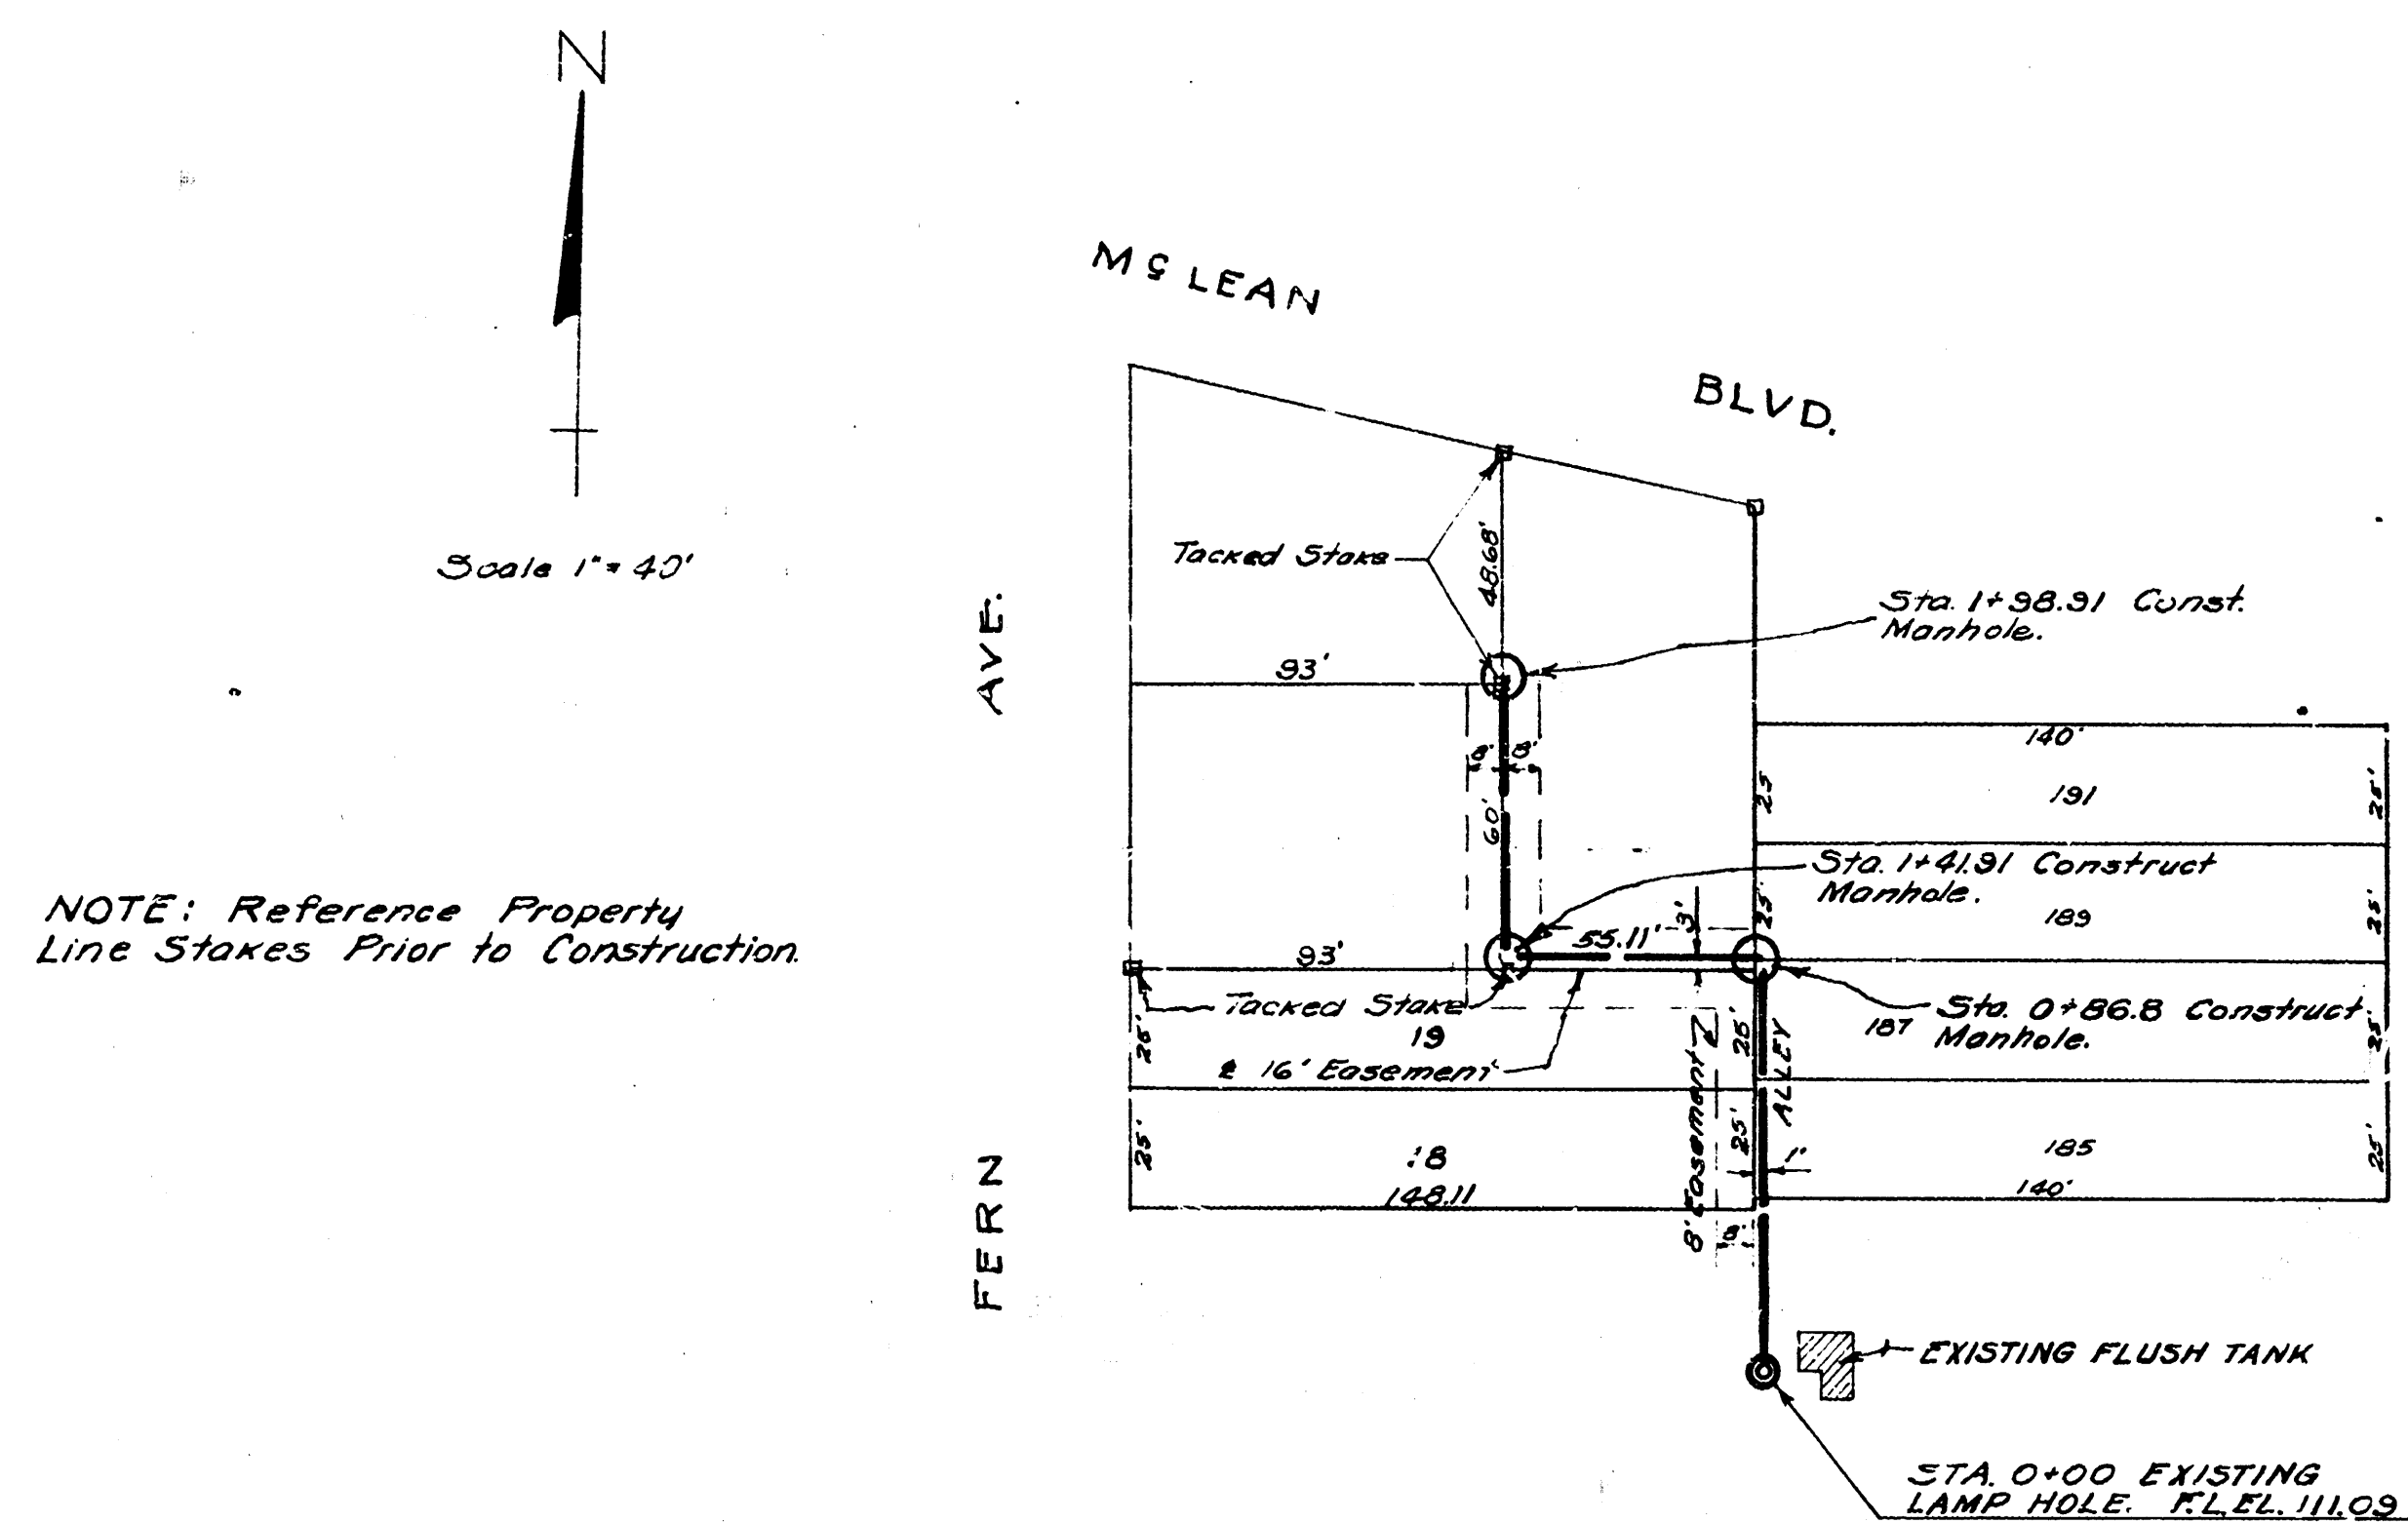


Date	Drawn by	Checked by	Note Book No.
June 1951	J.L.A.		H 2 & H 3

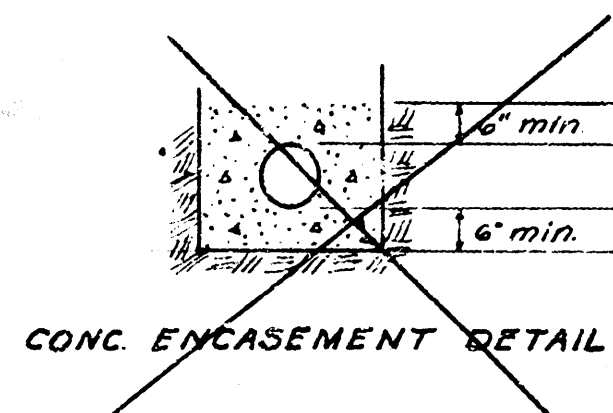


B.M. W. Rim of Manhole N.W.
Corner Vine & St. Louis. El. 115.37

NOTE BOOK NO. H2
Scale: 1" = 40' Horiz.
1" = 4' Vert.

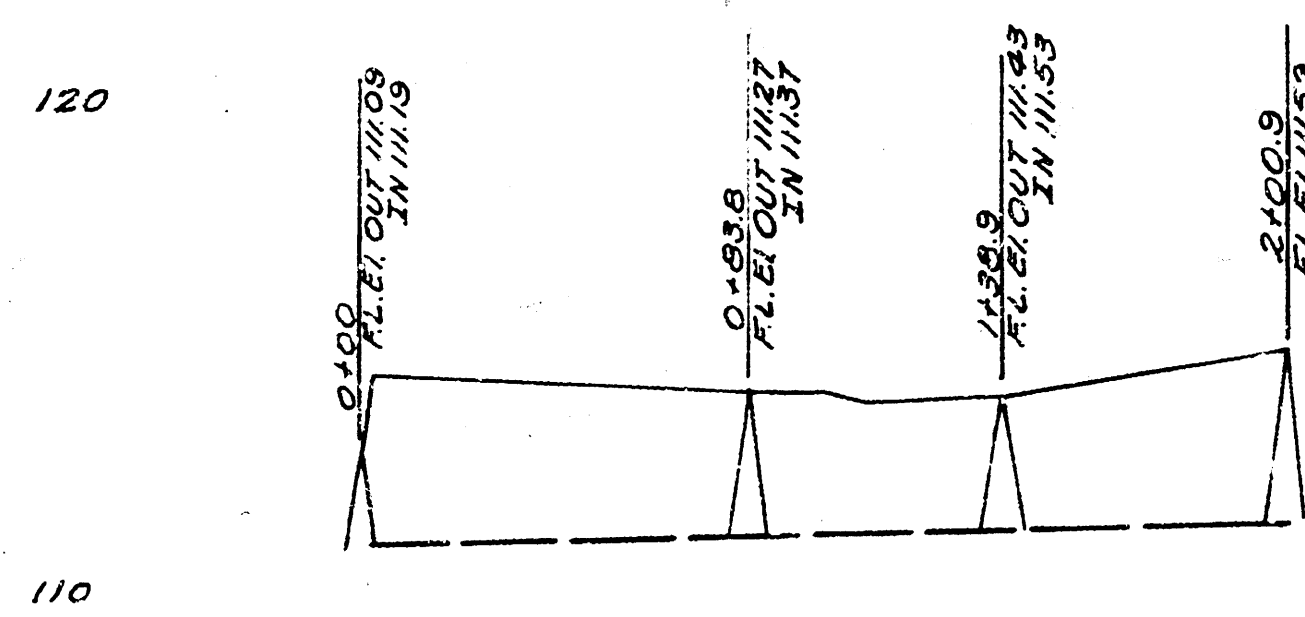


LAT. P DIST. SS. MAIN 8
CITY OF WICHITA KANSAS
L.K. WHITE CITY ENGINEER
Proj. No. C21-33

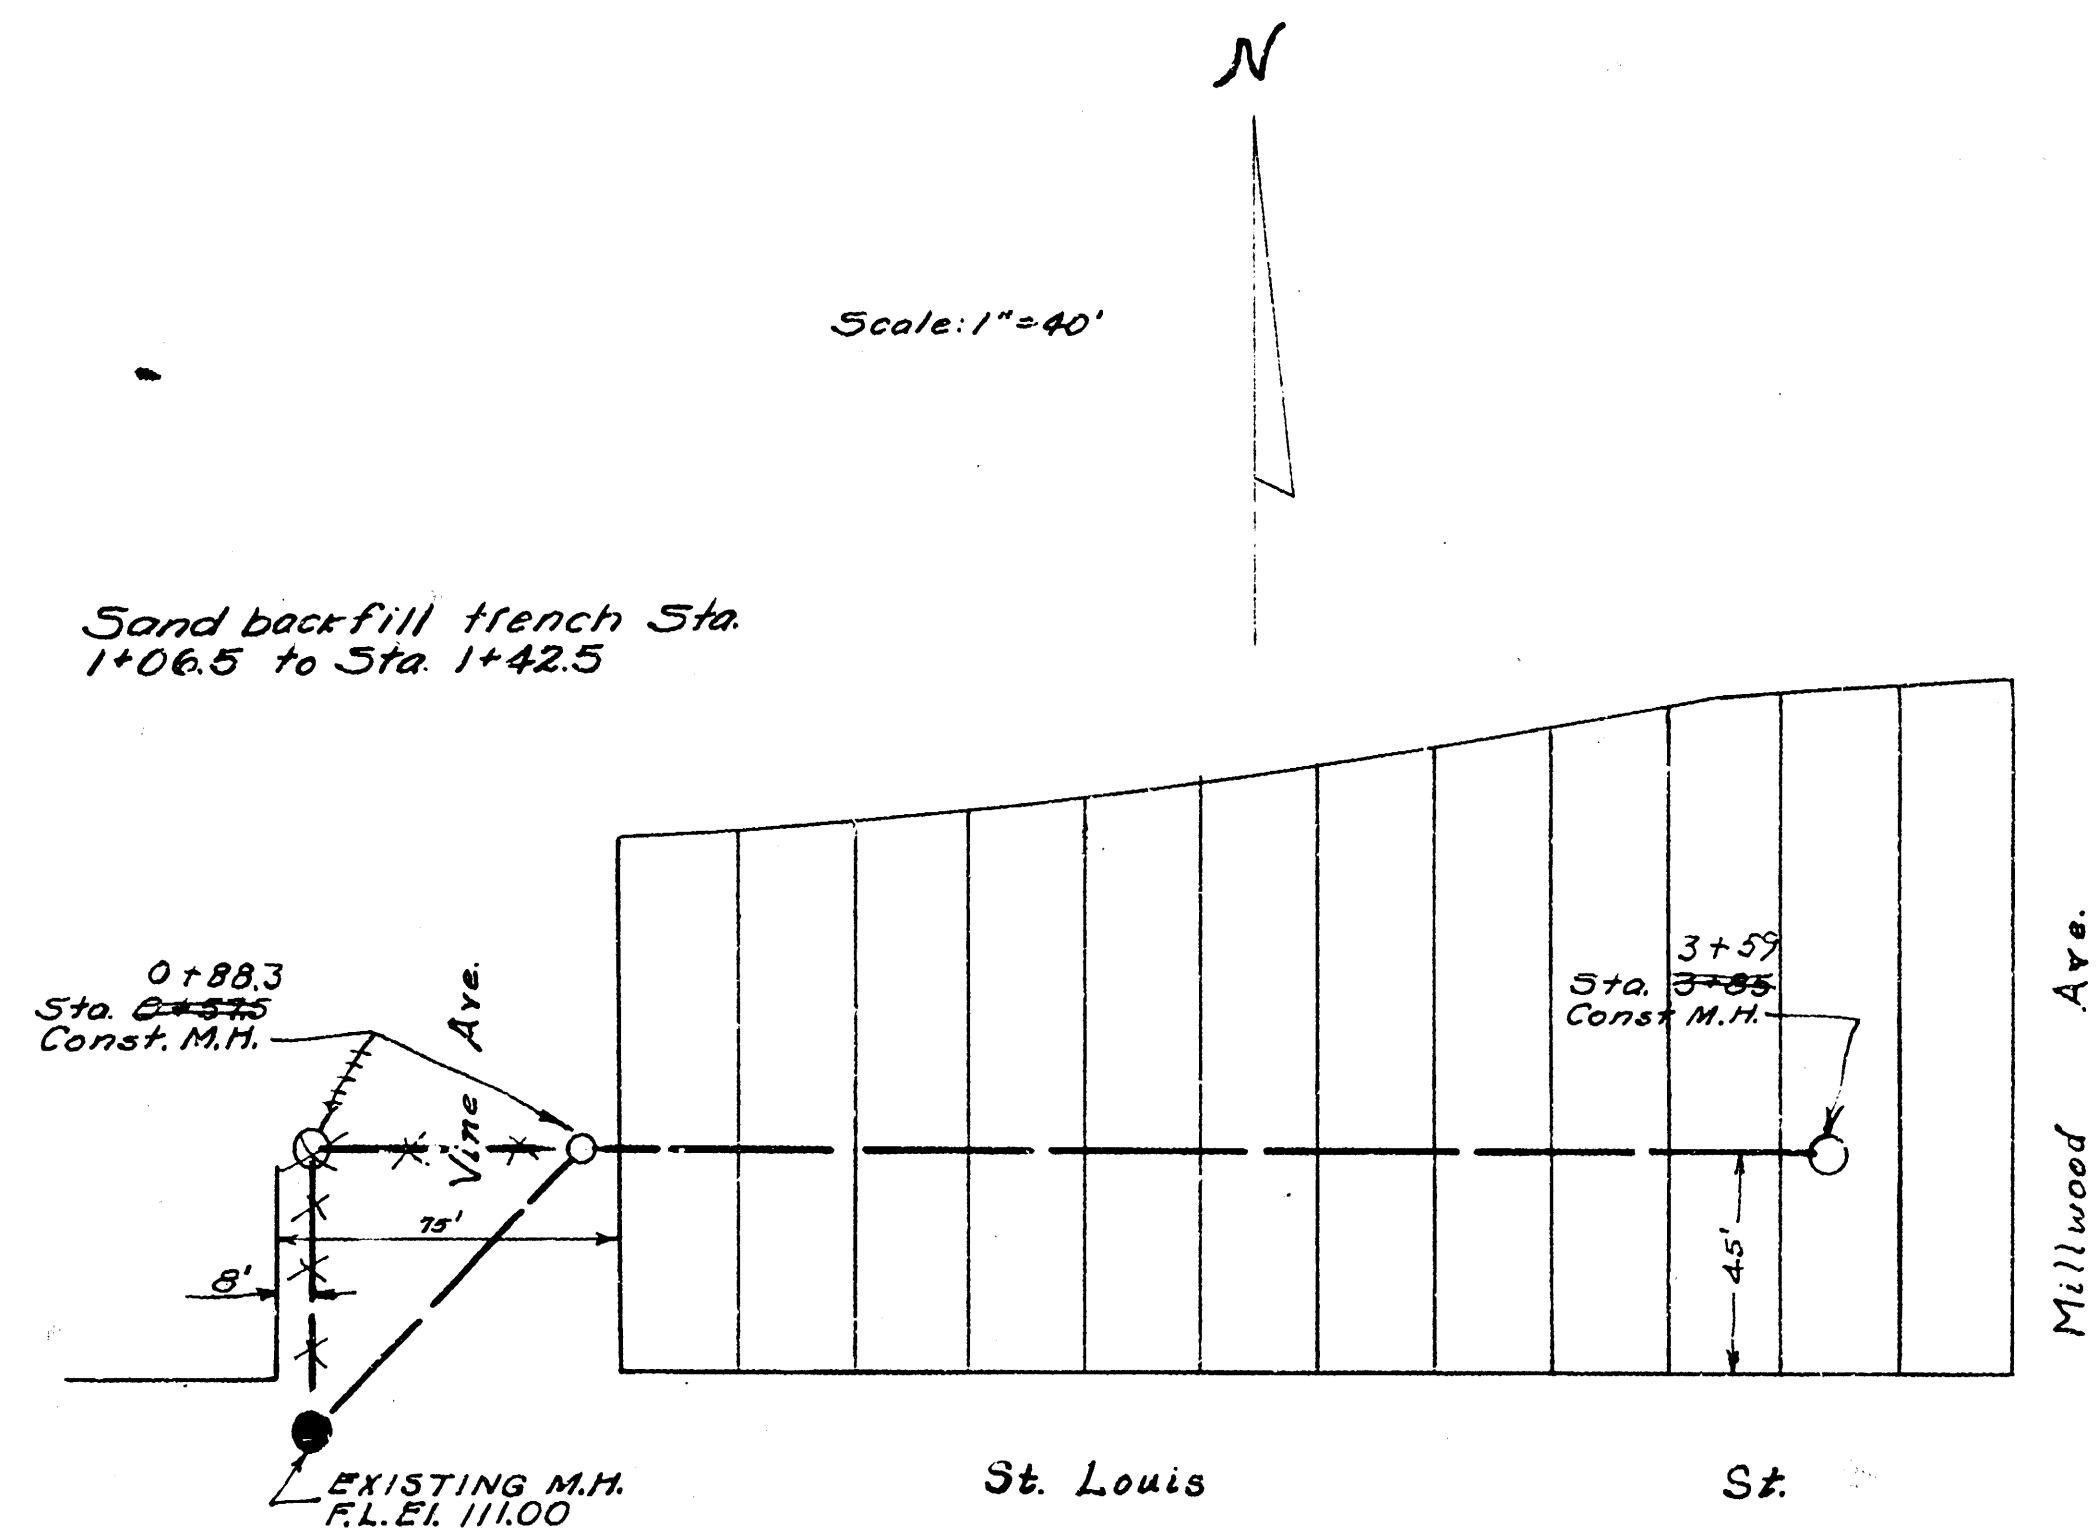

Scale: 1" = 40'
Book H-3

B.M. 115.37 W. rim of M.H. @ Sta. 0+20

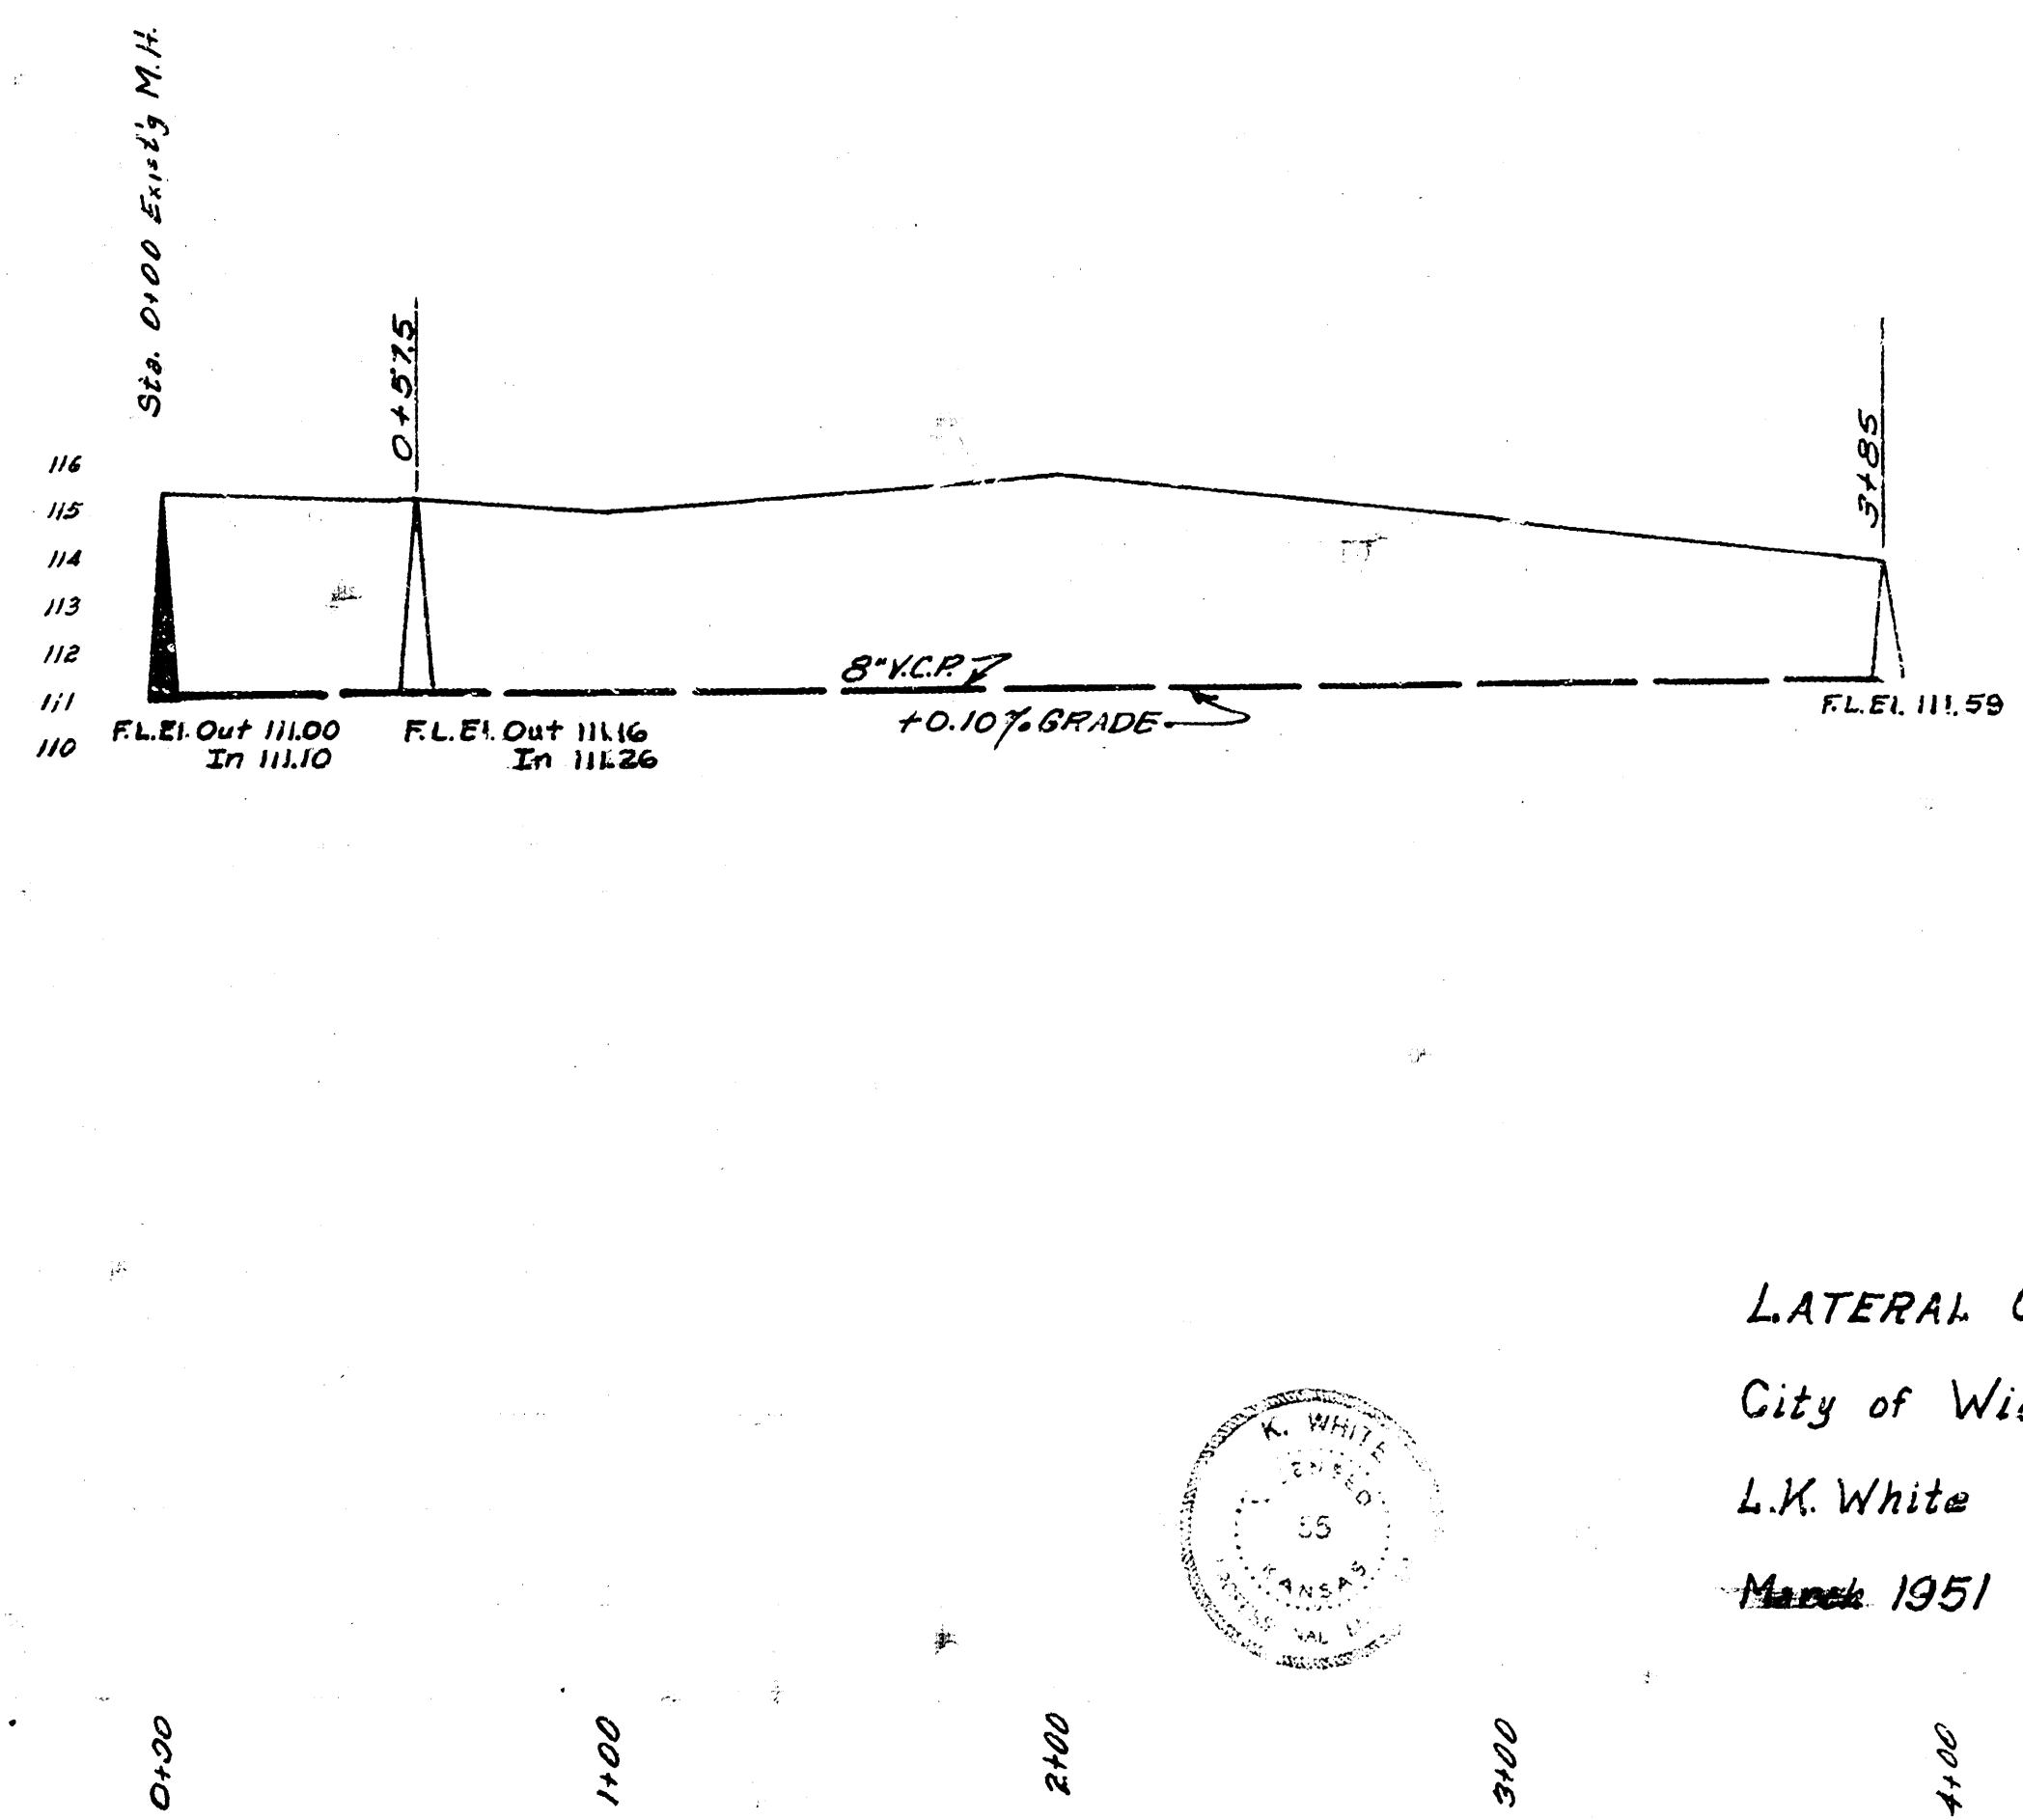

Scale:
Vertical - 1" = 4'
Horizontal - 1" = 40'

LATERAL Q, S.S.#8
City of Wichita, Kansas
L.K. White City Engineer
~~March~~ 1951 Private Contract