


PLAN
JPC-3

PROFILE

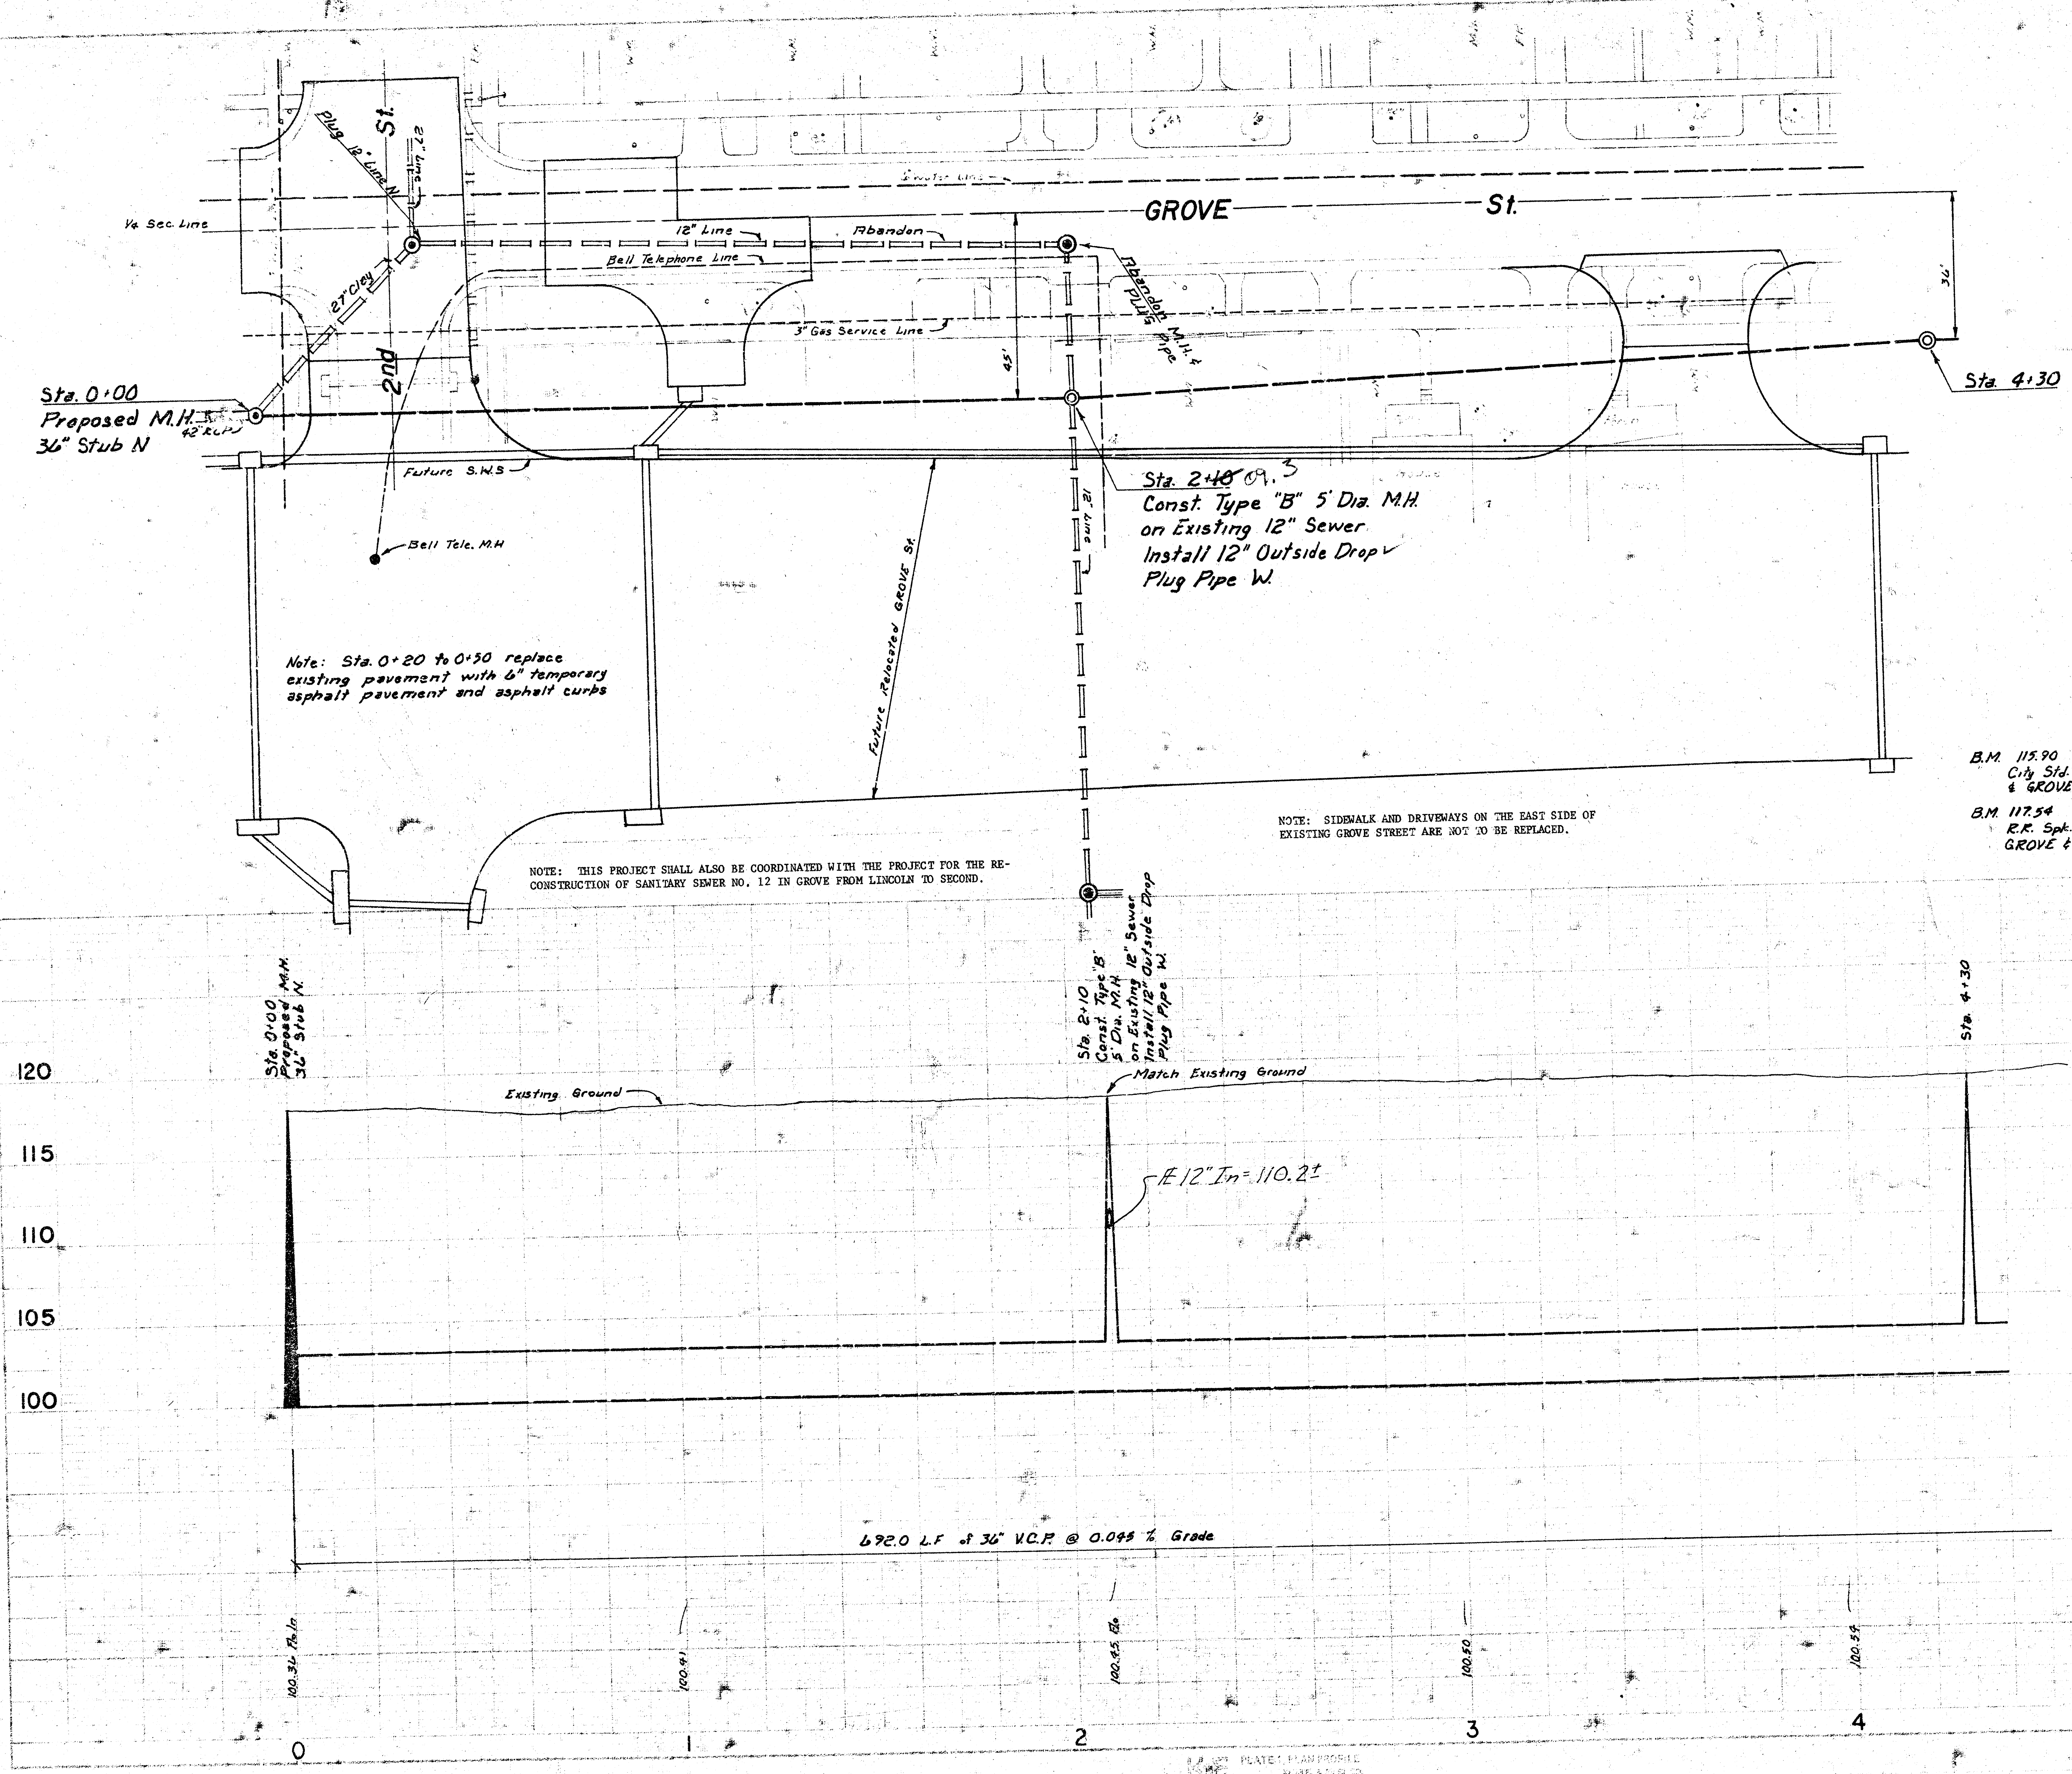

Scale:
Plan 1" = 20'
Profile 1" = 5'
Horizontal 1" = 20'

B.M. 115.90
City Sta. 34' N. & 23.5' W. of
GROVE & CENTRAL
B.M. 117.54
R.R. Spk. on E. Side R.R. N.W. Cor. of
GROVE & 2nd St.

GENERAL NOTE
RIGHT-OF-WAY MUST BE ACQUIRED FOR THIS PROJECT BEFORE CONSTRUCTION CAN BEGIN. THE CITY OF WICHITA ANTICIPATES THAT ALL OF THE RIGHT-OF-WAY NECESSARY TO FACILITATE CONSTRUCTION OF THIS PROJECT WILL BE ACQUIRED BY MARCH, 1979. CONTRACTORS BIDDING THIS PROJECT SHOULD ANTICIPATE THAT CONSTRUCTION OF THIS PROJECT WILL NOT BE ABLE TO BEGIN UNTIL SOMETIME IN MARCH OF 1979.
ALL BUILDINGS AND IMPROVEMENTS LOCATED IN THE PROPOSED RIGHT-OF-WAY FOR THIS PROJECT EAST OF THE WALK ALONG THE EAST SIDE OF EXISTING GROVE STREET MUST BE REMOVED BY OTHERS. CONTRACTOR WILL BE PERMITTED TO REMOVE ONLY THOSE EXISTING GROVE STREET SIDEWALKS AND DRIVEWAYS WHICH ARE ESSENTIAL TO FACILITATE CONSTRUCTION OF THE SEWER, HENCES, OR STRUCTURES OR SHEDS WHICH ARE LOCATED IN THE PROPOSED RIGHT-OF-WAY. THE ENGINEER'S APPROVAL PRIOR TO REMOVING ANY TREES, HENCES, OR STRUCTURES OR SHEDS WHICH ARE TO REMAIN SHALL BE OBTAINED FROM DAMAGE. THIS WORK WILL BE PAID FOR AT THE LOWEST PRICE BID FOR CLEARING RIGHT-OF-WAY.
CONSTRUCTION OF THIS PROJECT SHALL BE COORDINATED WITH THE CONSTRUCTION OF RELOCATED GROVE STREET. MANHOLE AT STATION 6 + 42 SHALL NOT BE CONSTRUCTED UNTIL GROVE STREET IS CLOSED AT THIS LOCATION BY PAVING CONTRACTOR.

RECONSTRUCTION of S.S. #12
in GROVE St. from 2nd to 3rd
City of WICHITA, KANSAS
R.W. LINN - CITY ENGINEER
Date: JUN 3 1979
Project No. 468-76-245-80592-000-000-001

Sheet 1 of 3

FILMED FROM THE BEST
AVAILABLE COPY

