




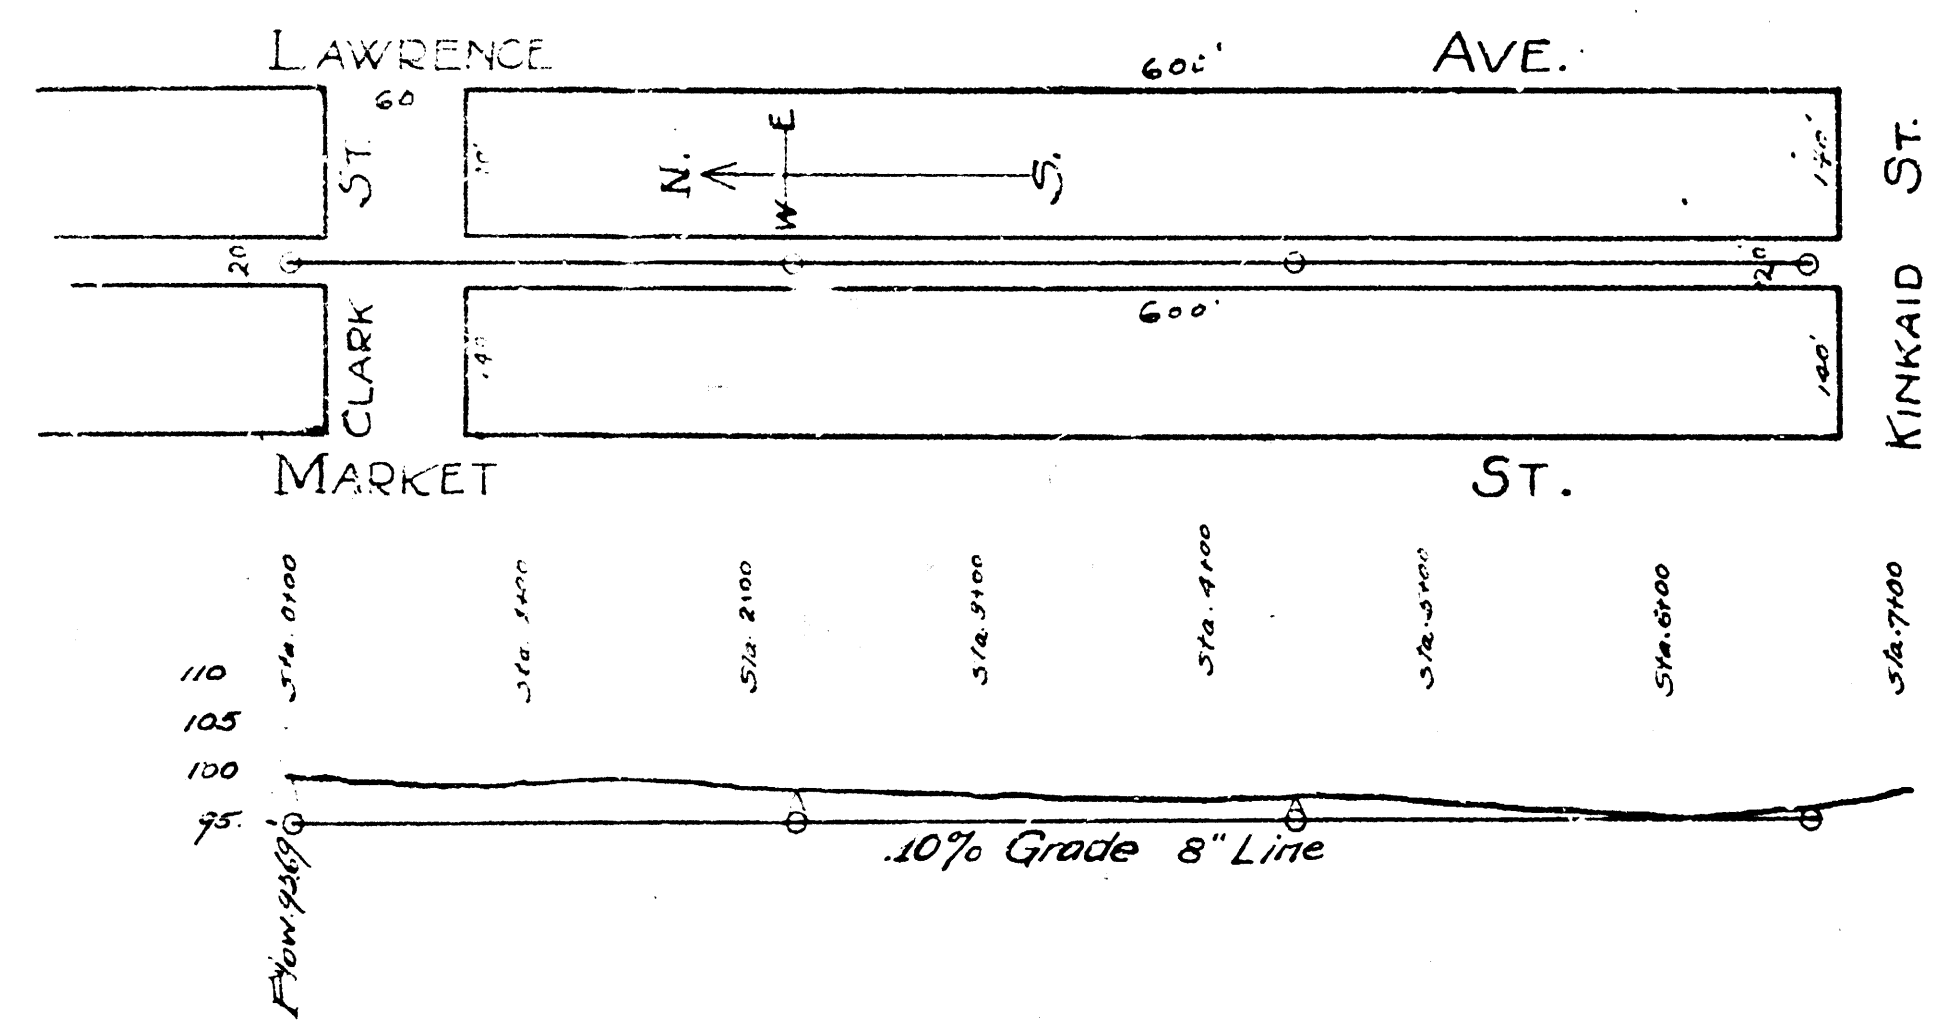


LATERAL "1" DISTRICT "C"
SANITARY SEWER No. 20

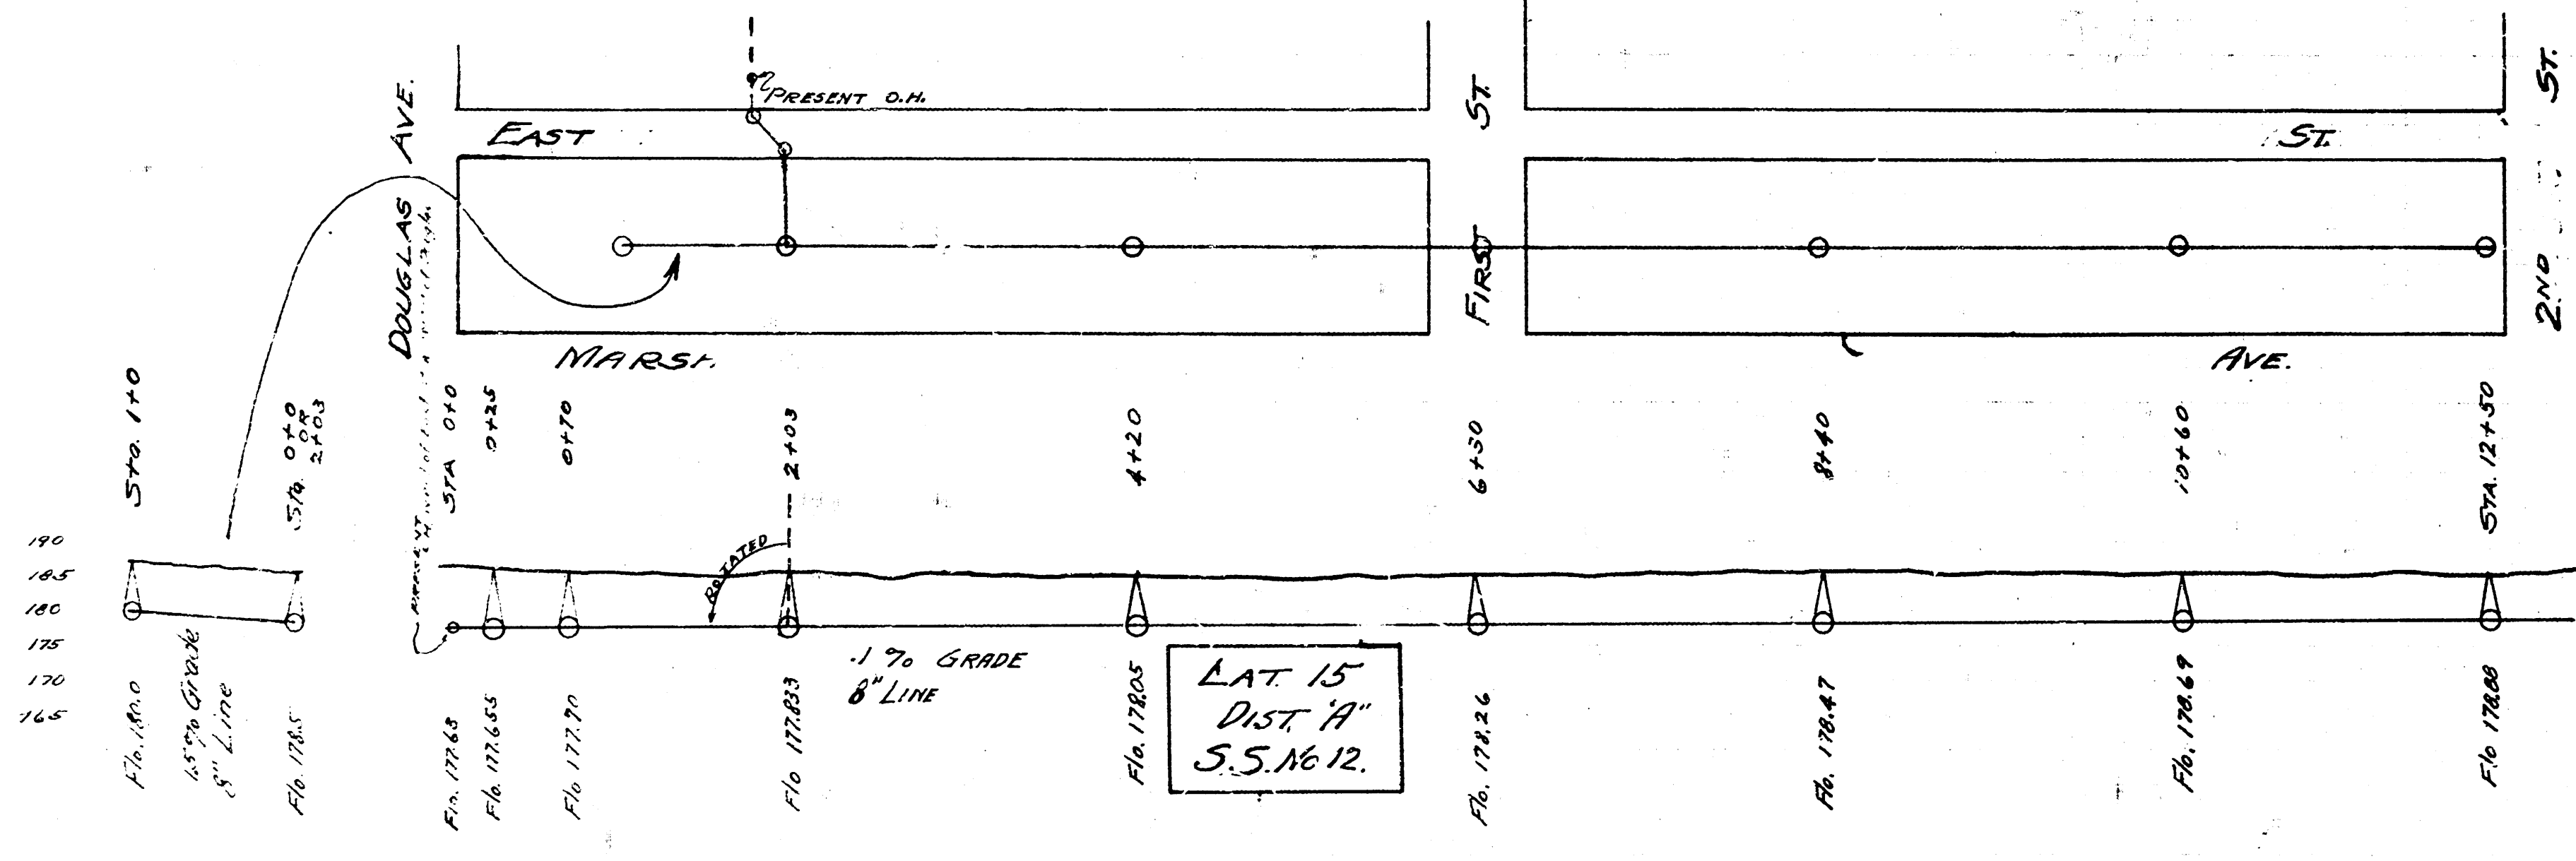

S.S. No. 12


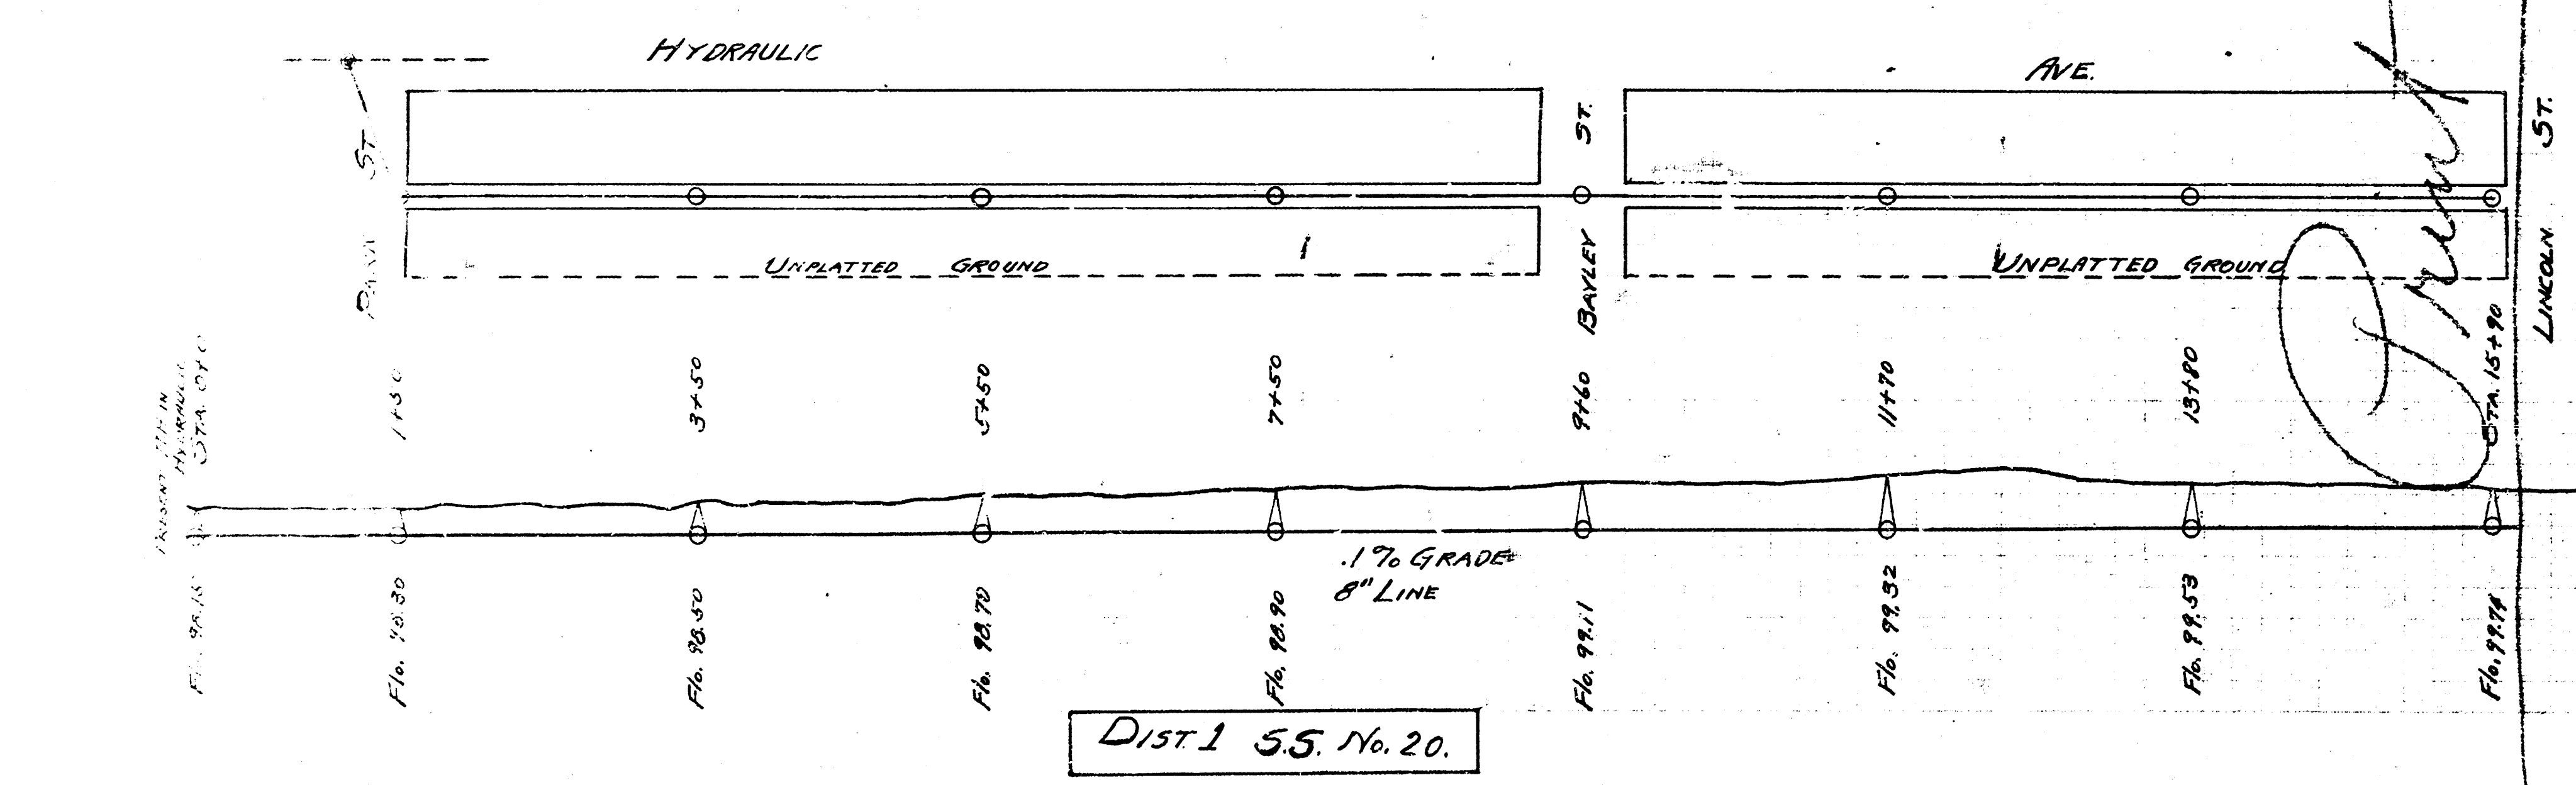


DIST. 1 S.S. No. 20

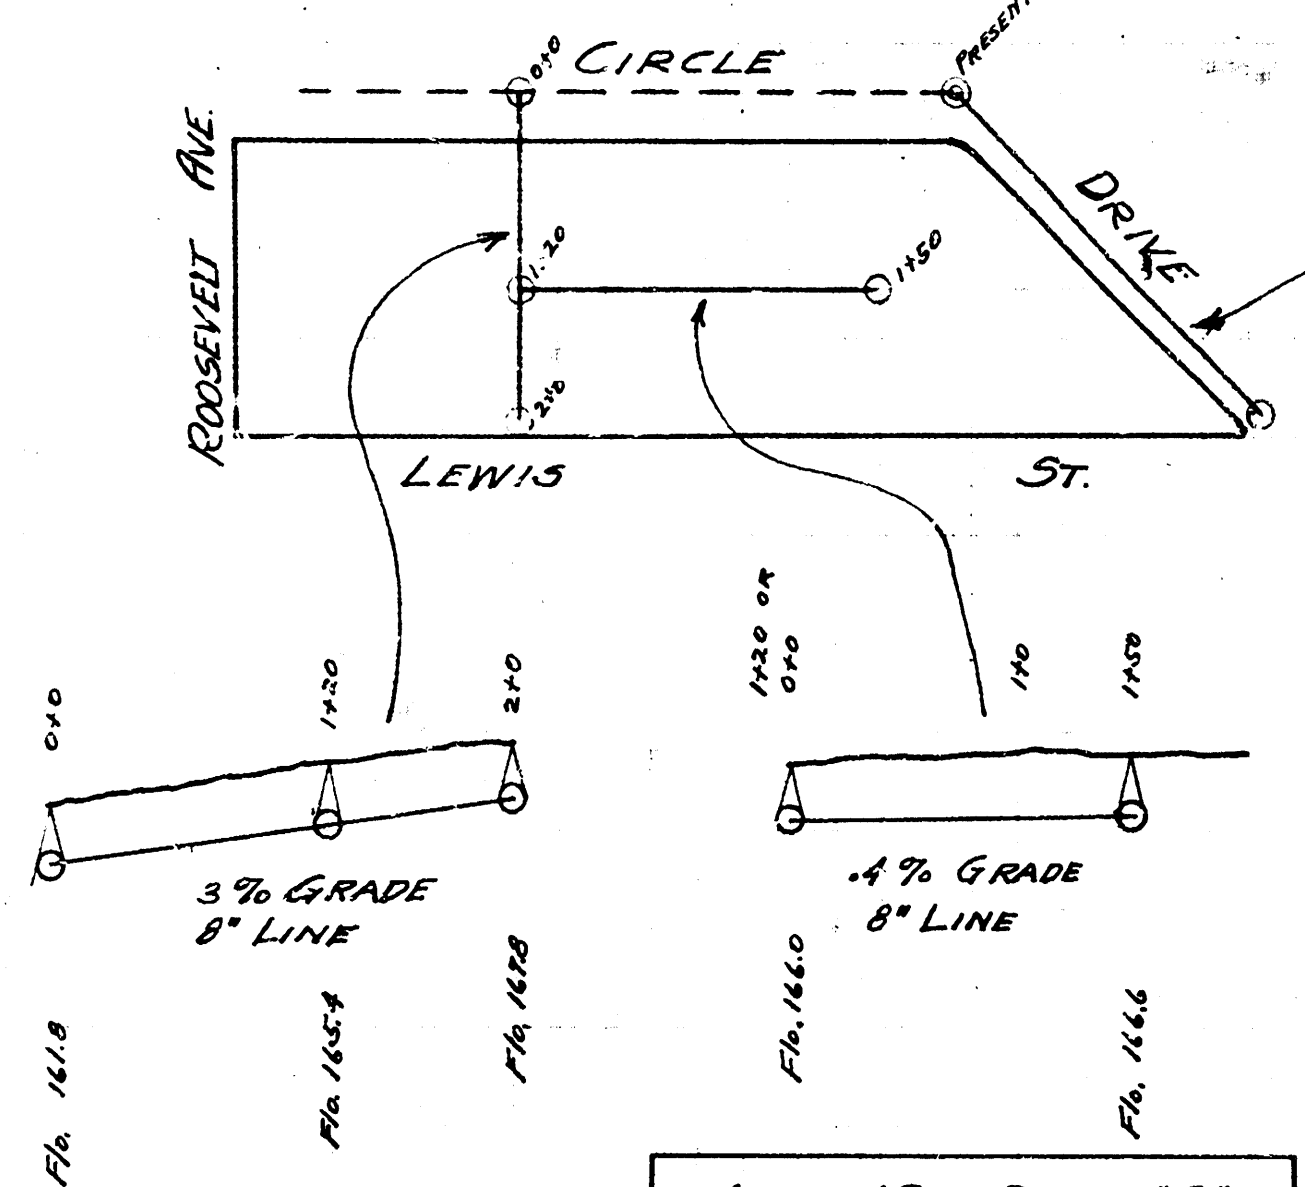


LAT. 16 - DIST. "A"
S.S. No. 12


Print to right of this line only

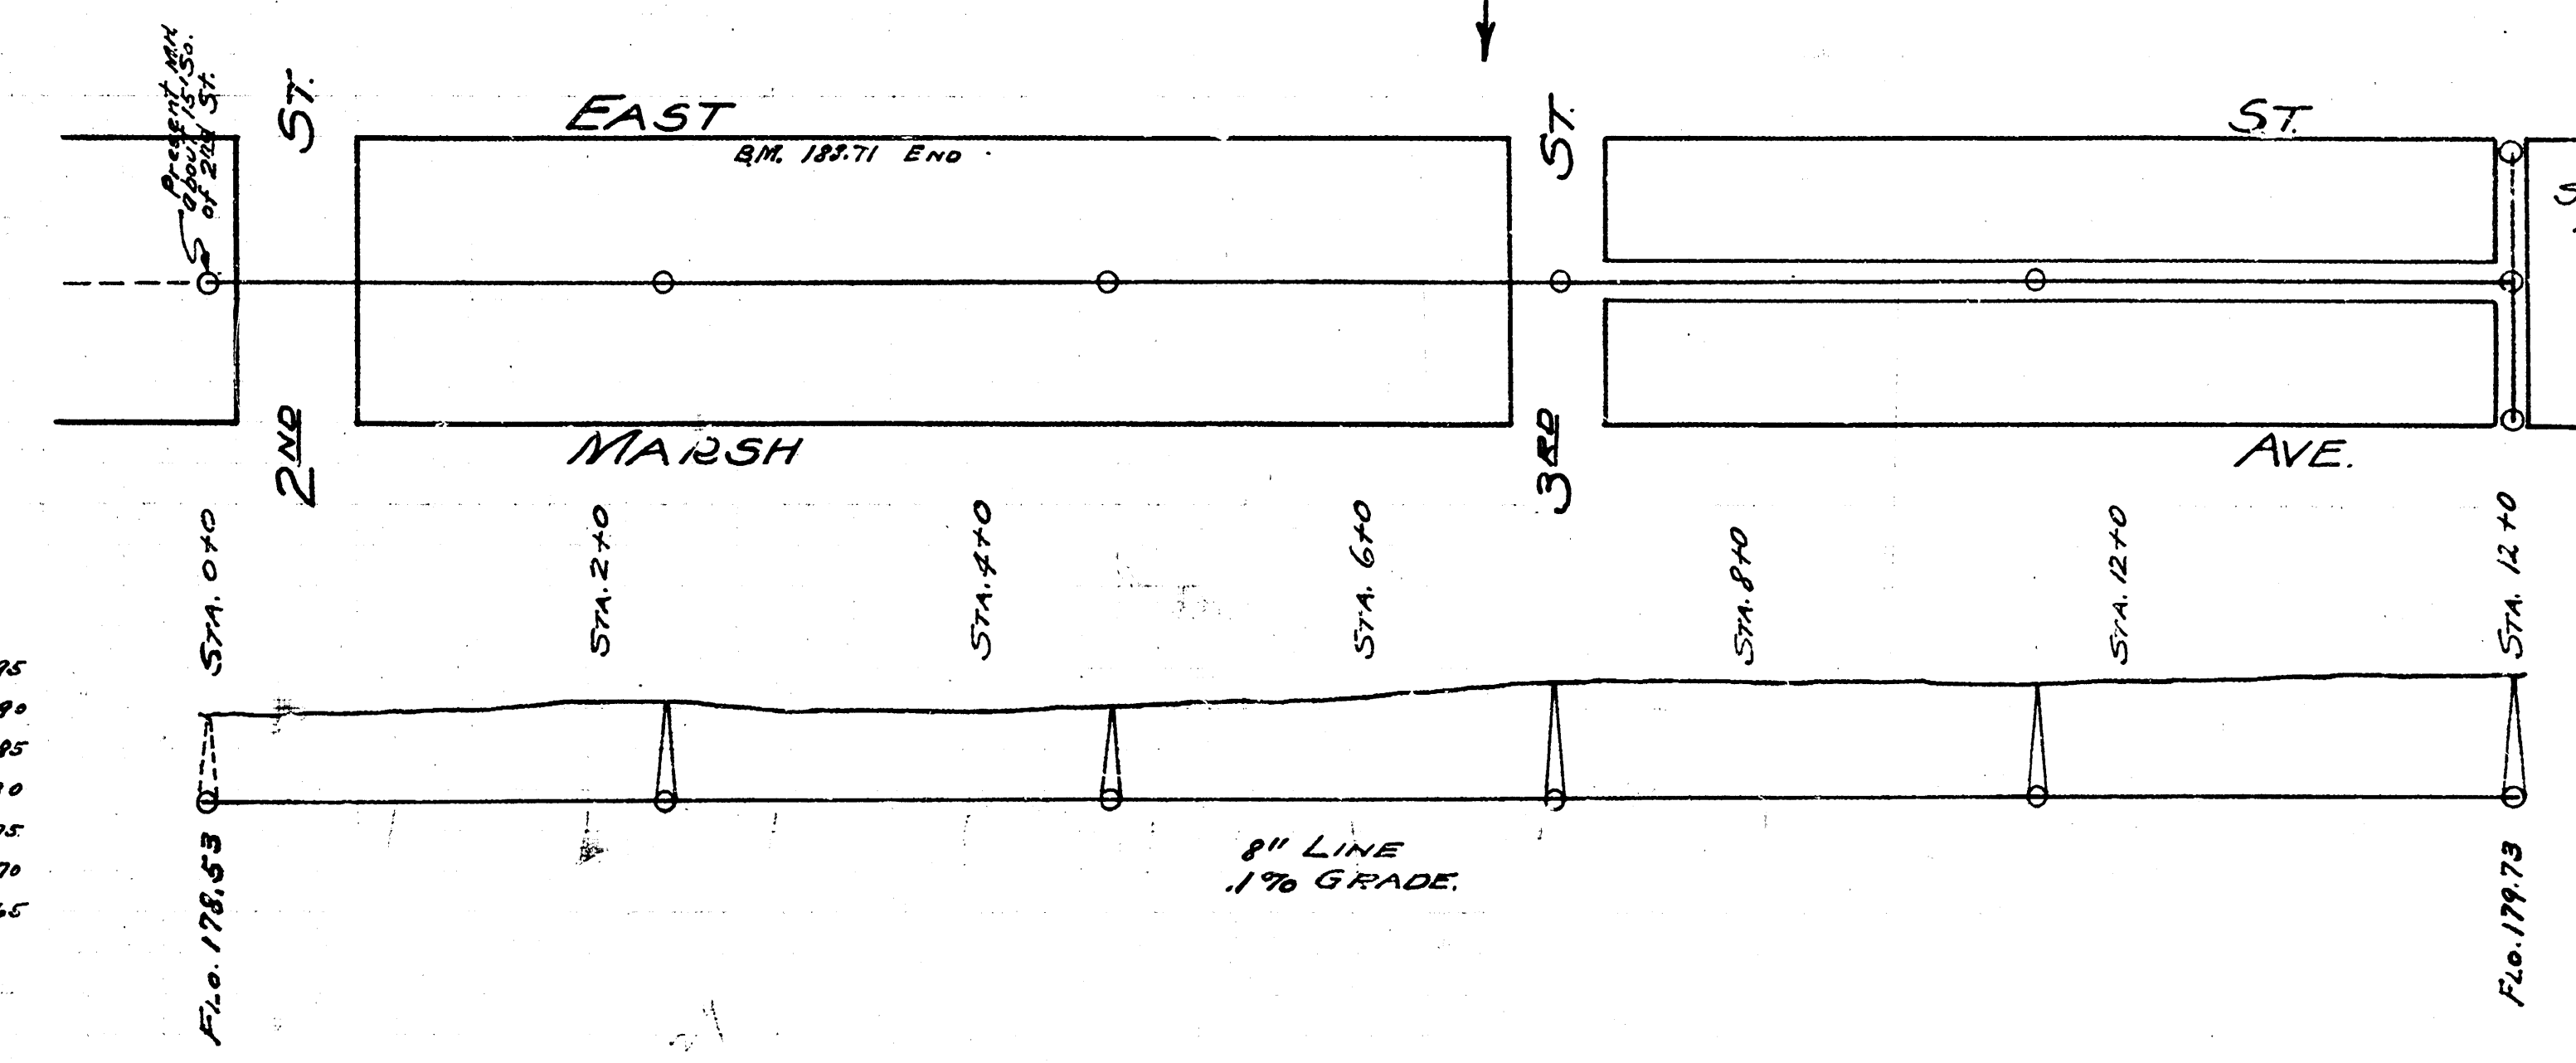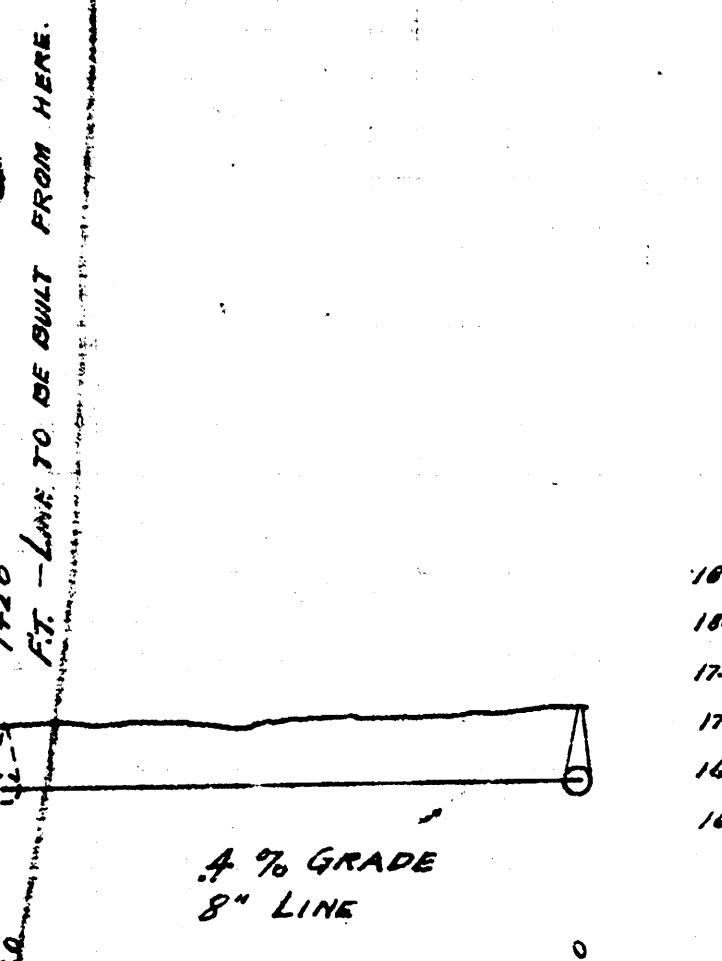

LAT. 2 - DIST. N-0
S.S. No. 20

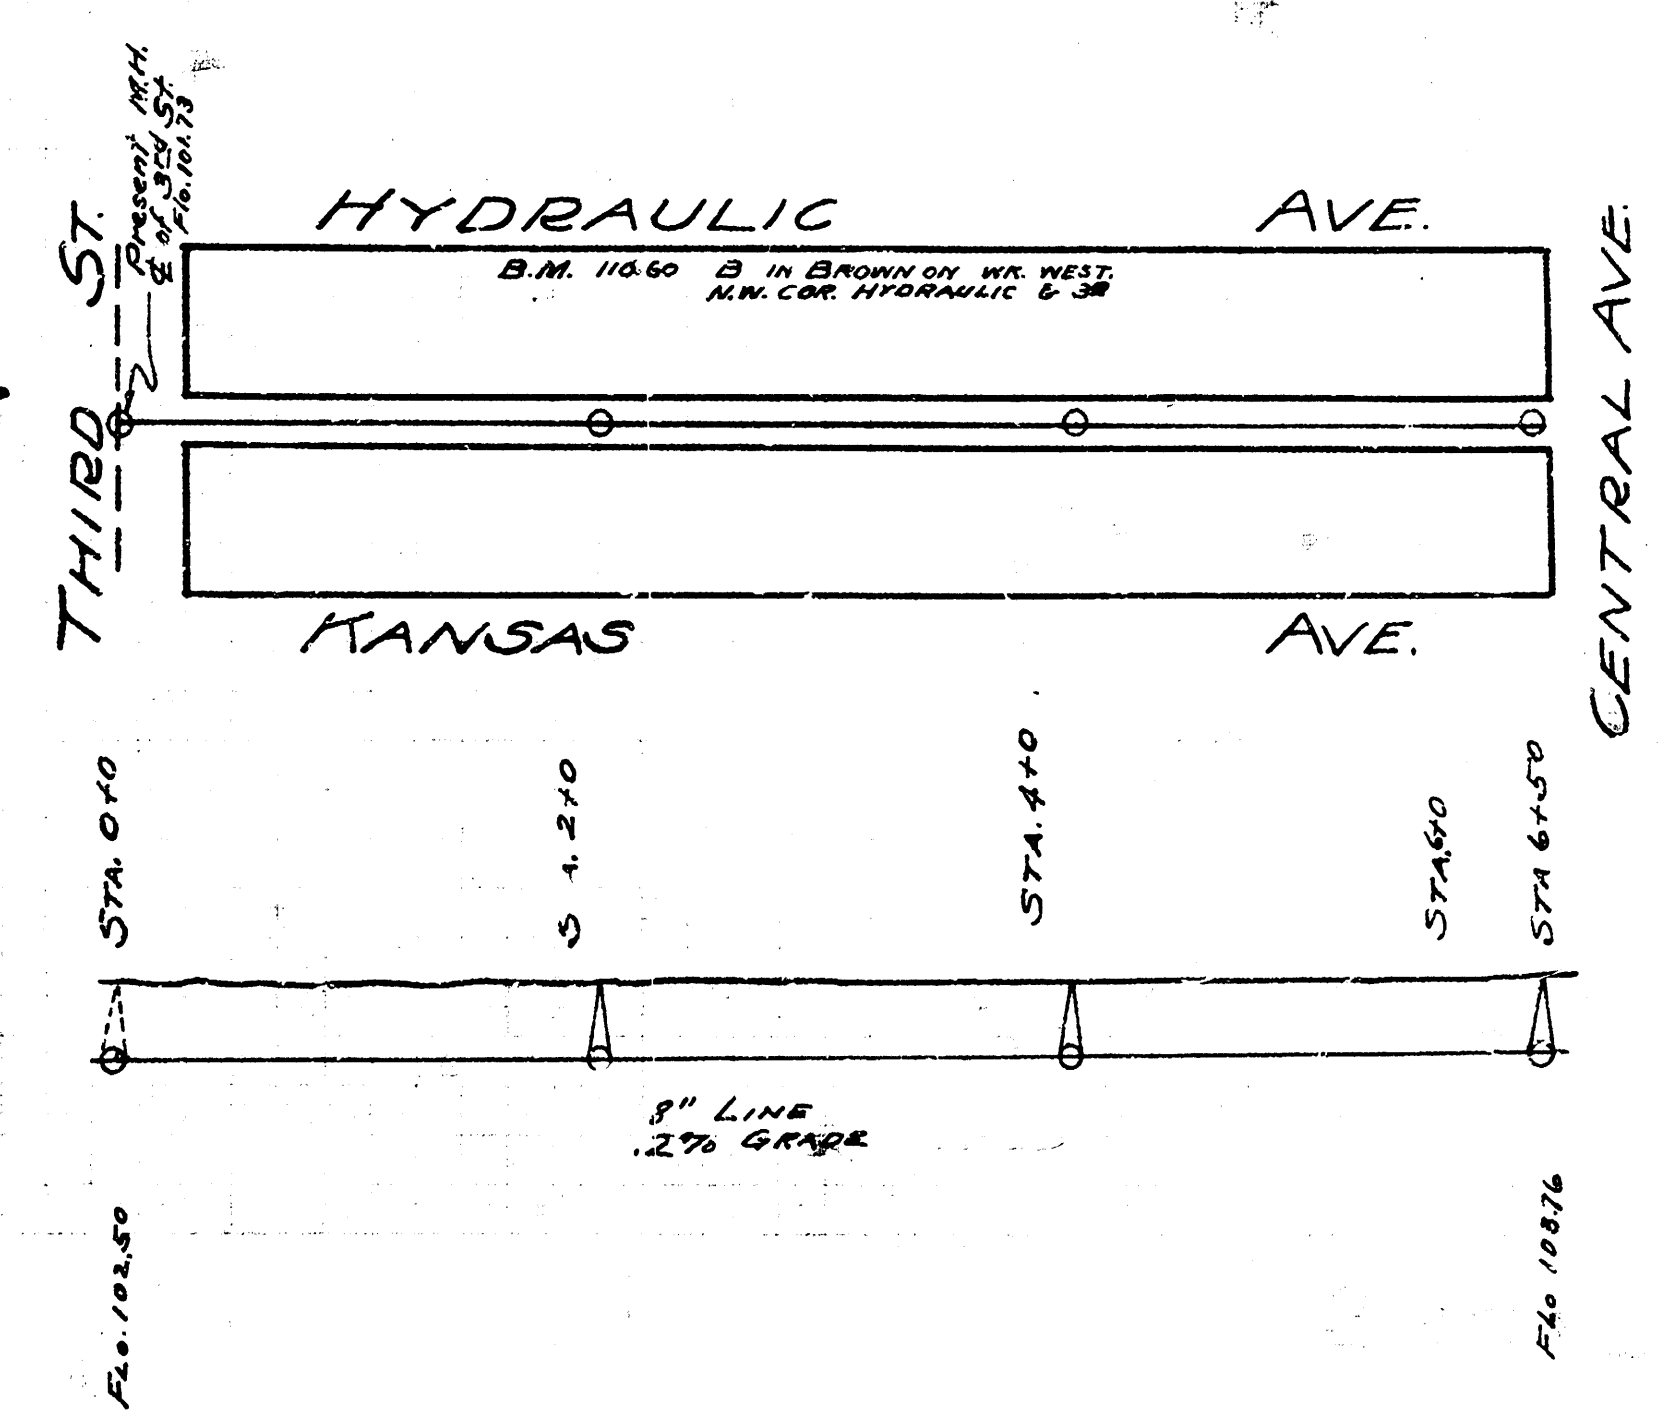

LAT 17 - DIST. A
S.S. No 12

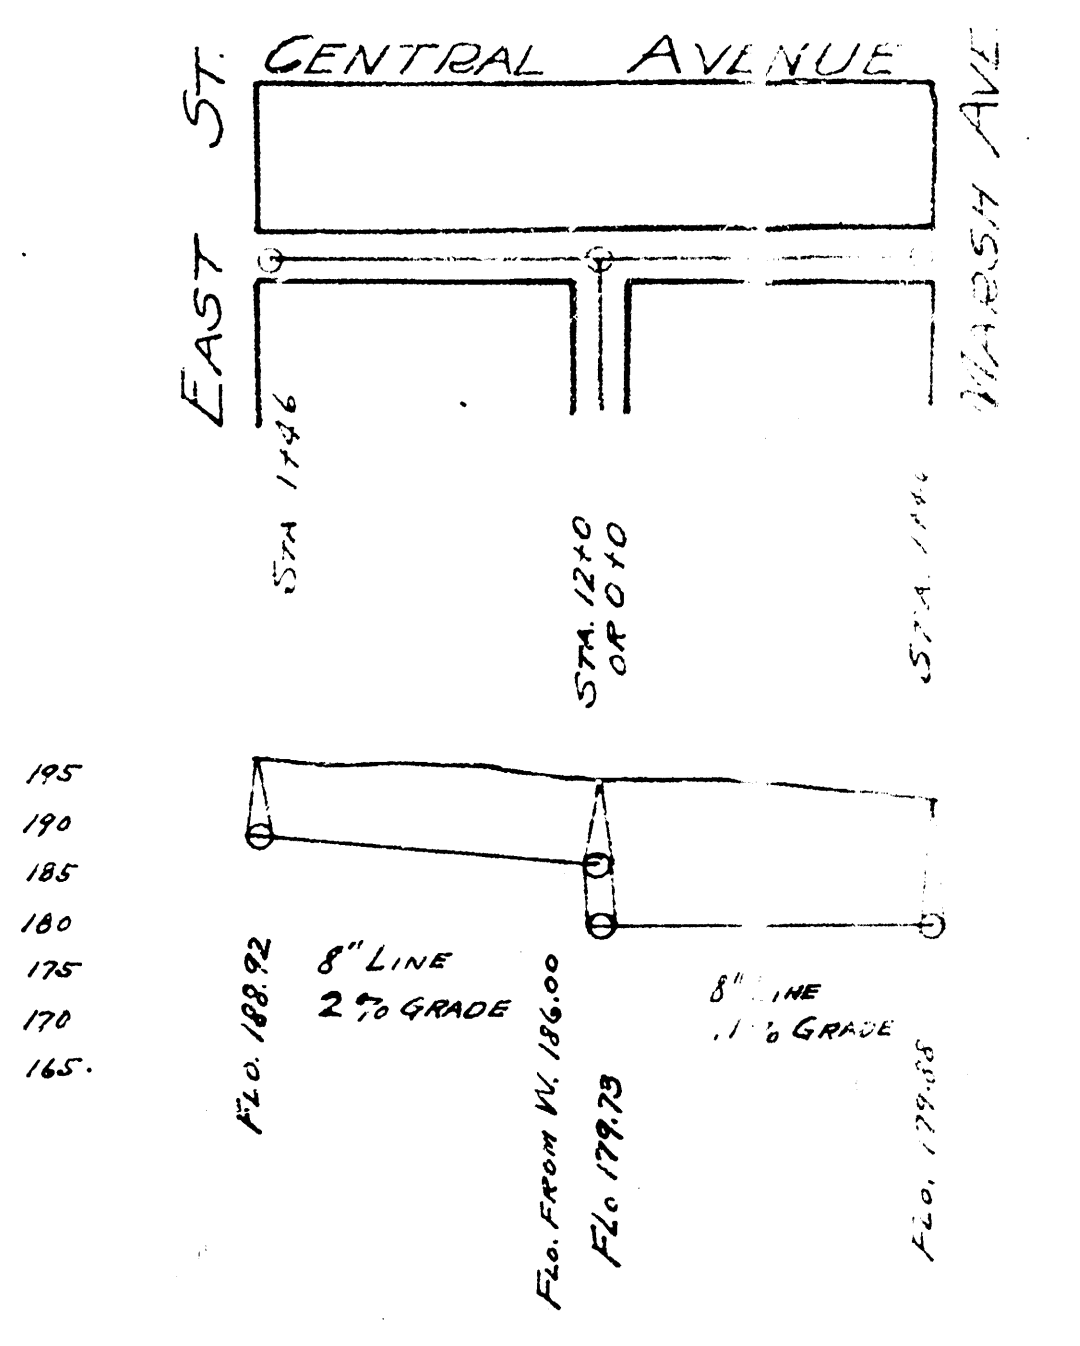

CENTRAL AVE.