



LAT. F - S.S. No. 8.

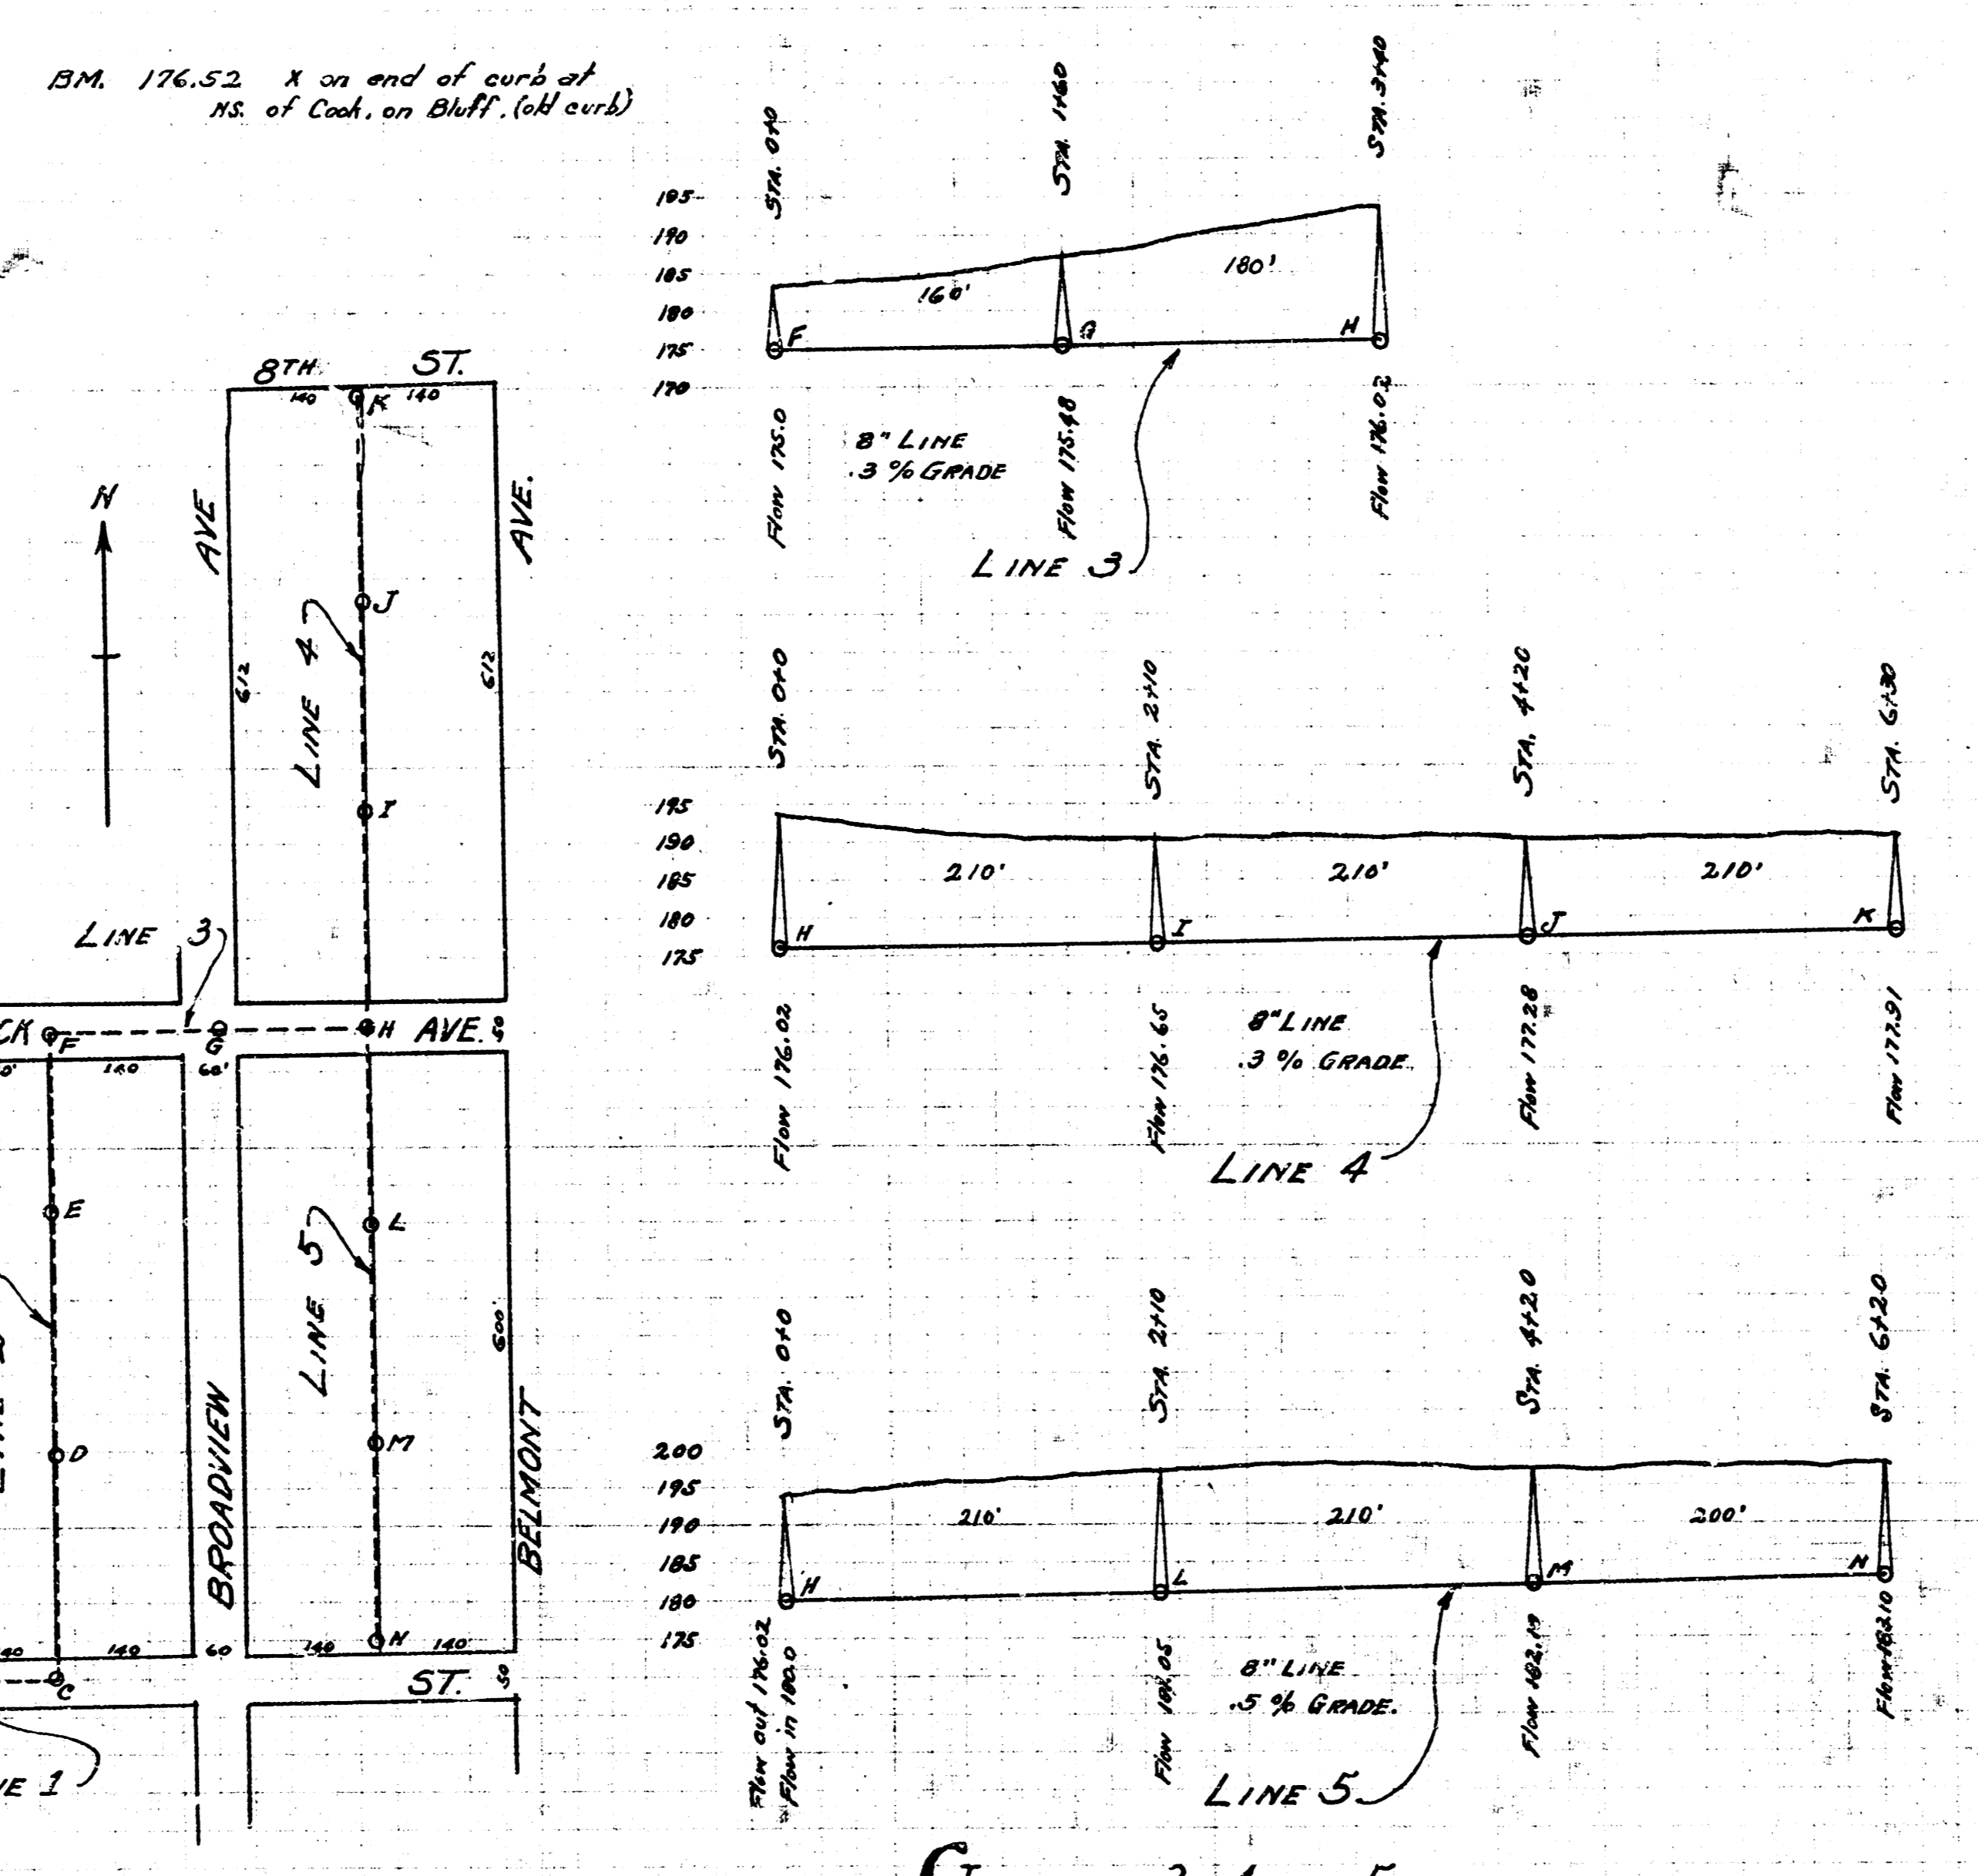


LINES 1 AND 2
LAT. Y - DIST. D - S.S. No. 12


LINES 3, 4 AND 5
LAT. 2 - DIST. D - S.S. No. 12

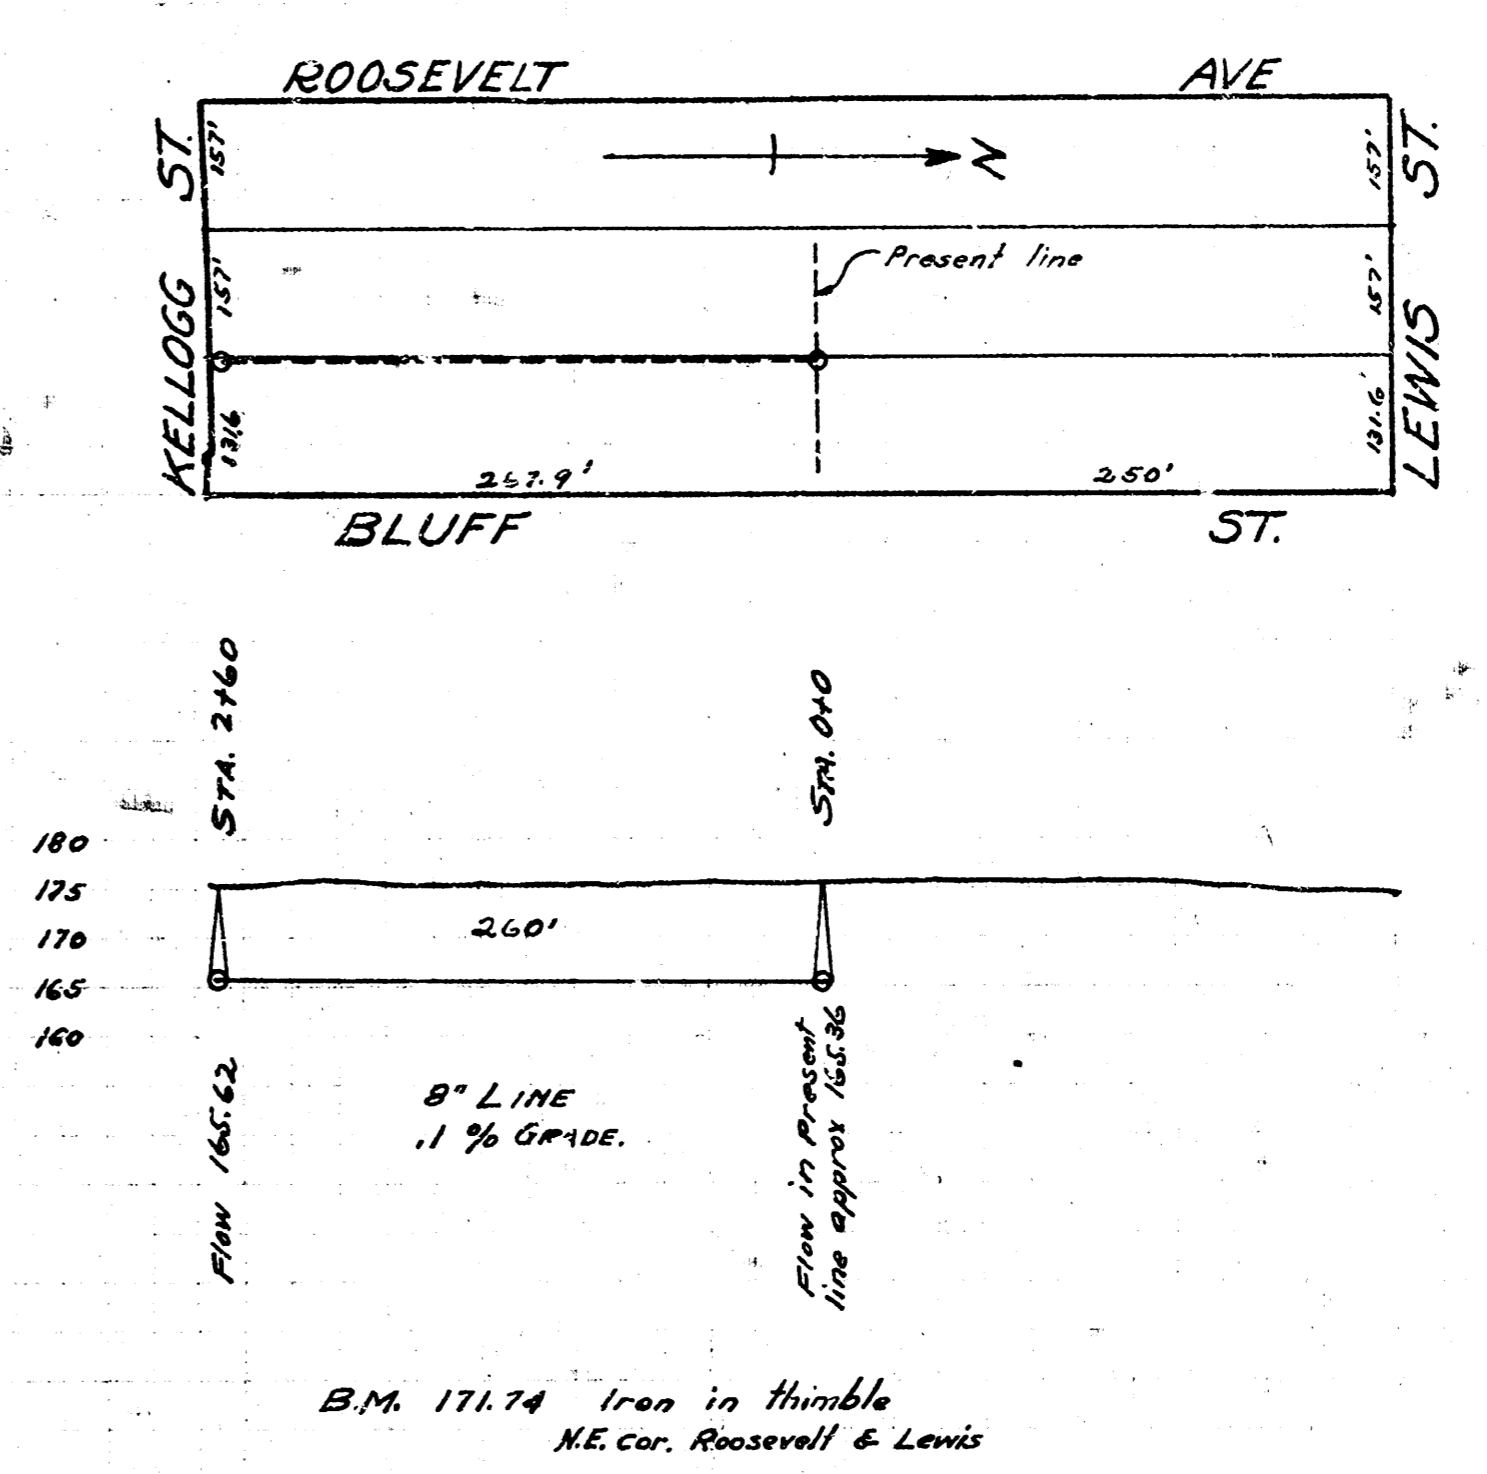

LAT. 27 - DIST. A - S.S. No. 12

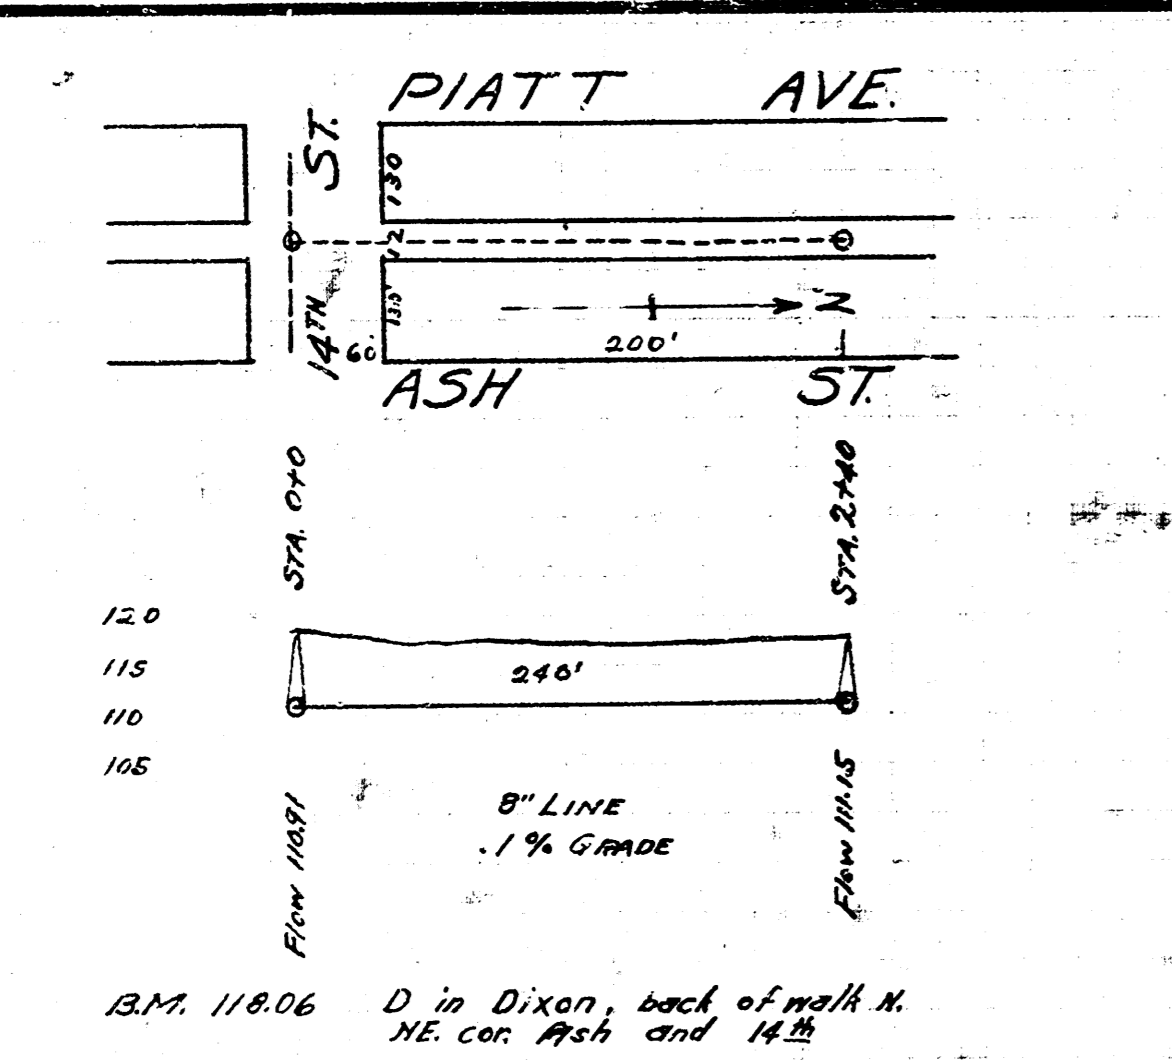

LAT. K - DIST. O - S.S. No. 12

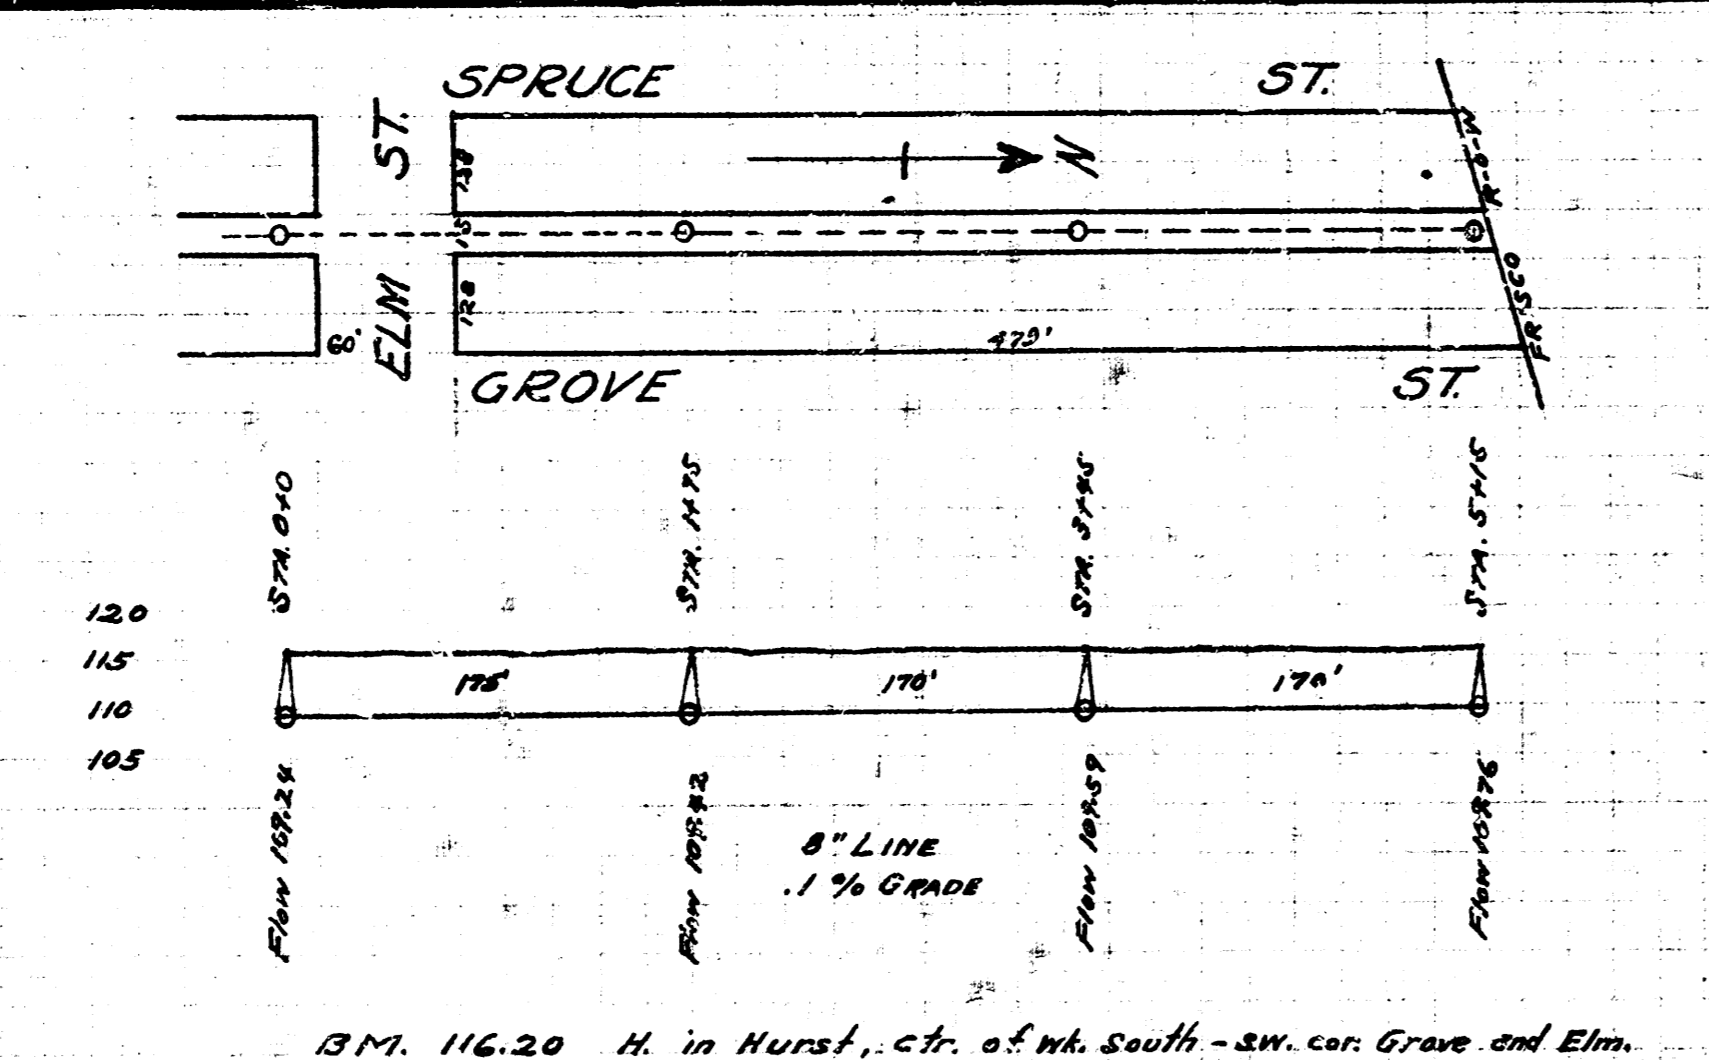

LAT. Z - DIST. D - S.S. No. 12