



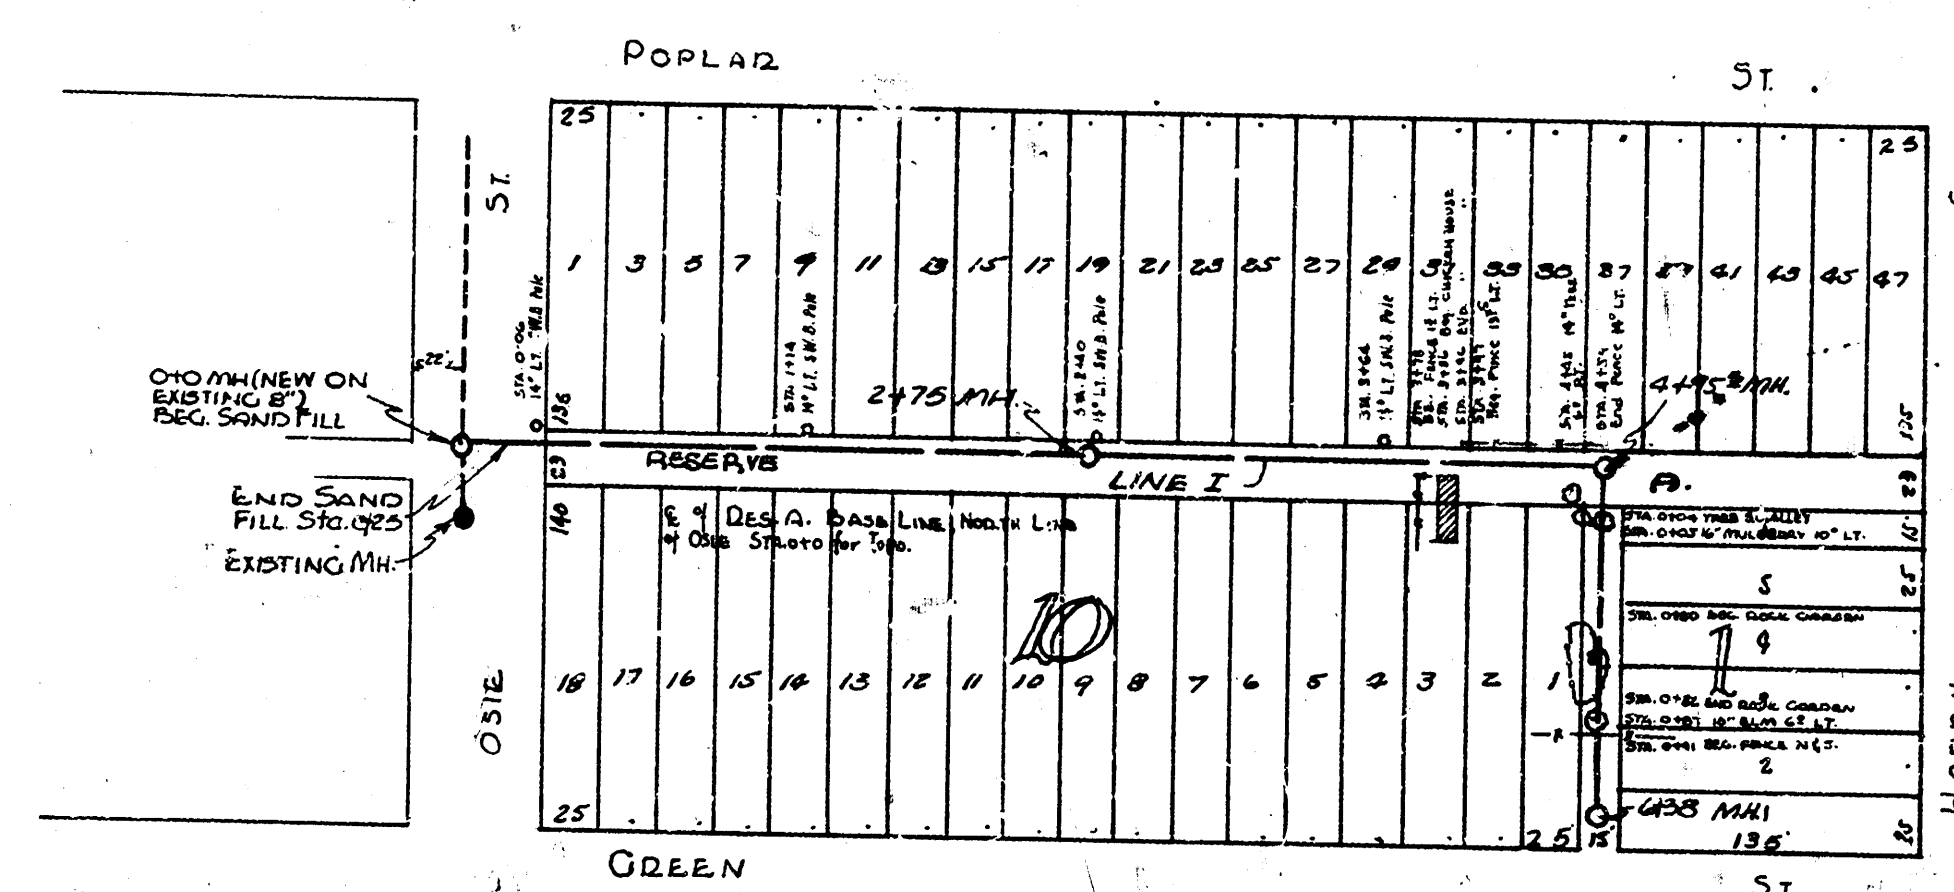

CLEARANCE OF SEWER LINE.
 S.W. Poles to the Lt. 15' from Sewer Line.
 Children House & Fence to # 121 24' Fence at the
 Lt. 24' from Sewer Line.

B.M. 100 97 22 SPIKE N.S. U.G.E. TRANSFORMER
 POLE N.S. 0316 165° W. OF WL. GREEN.

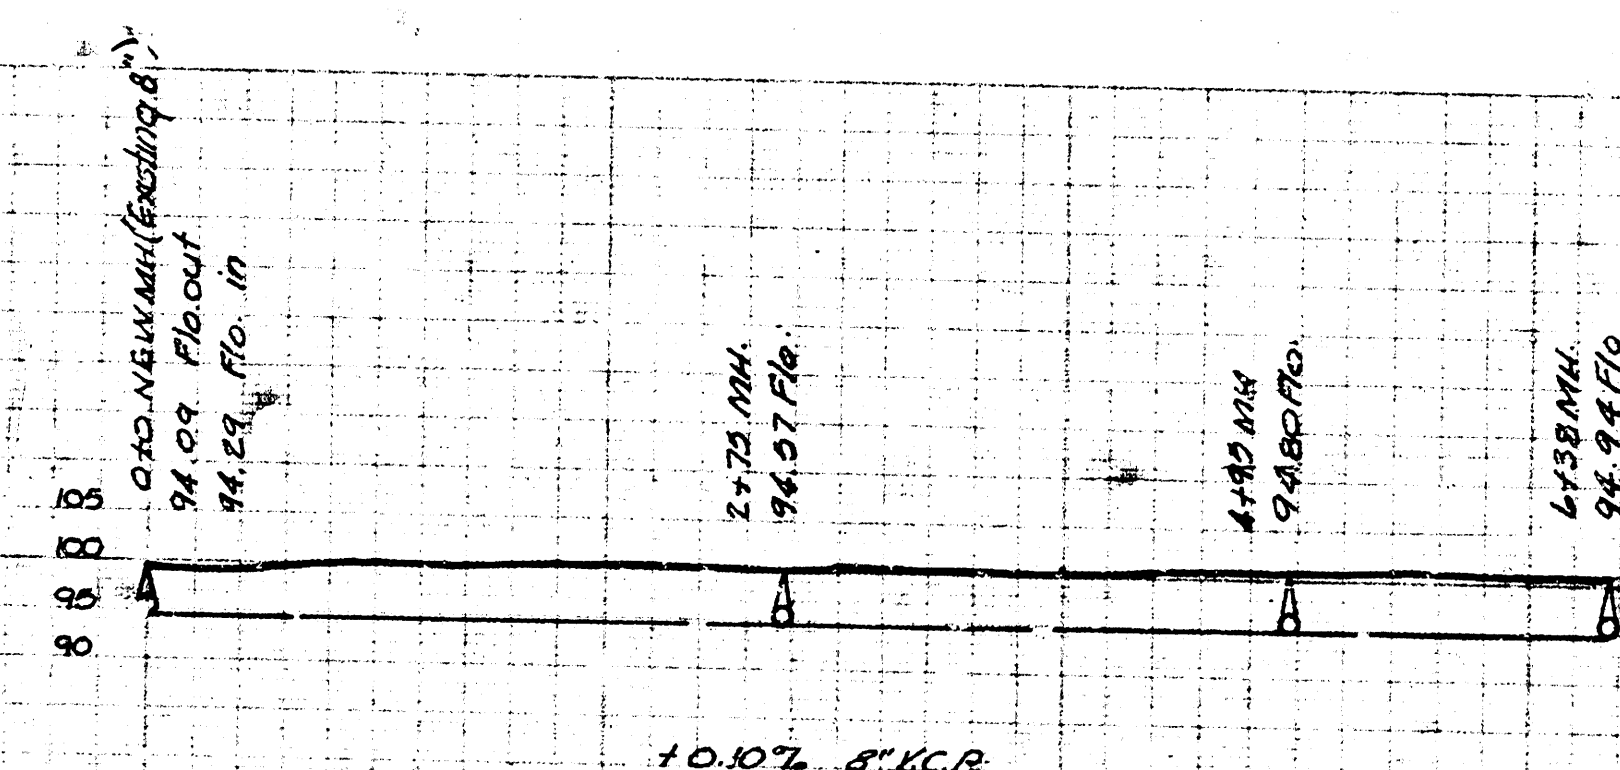

LAT. 5, DIST. 35, MAIN 12
 CITY OF WICHITA, KANSAS
 L. L. WHITE City Engineer
 Date: March, 1949 Proj. No. C28-41