

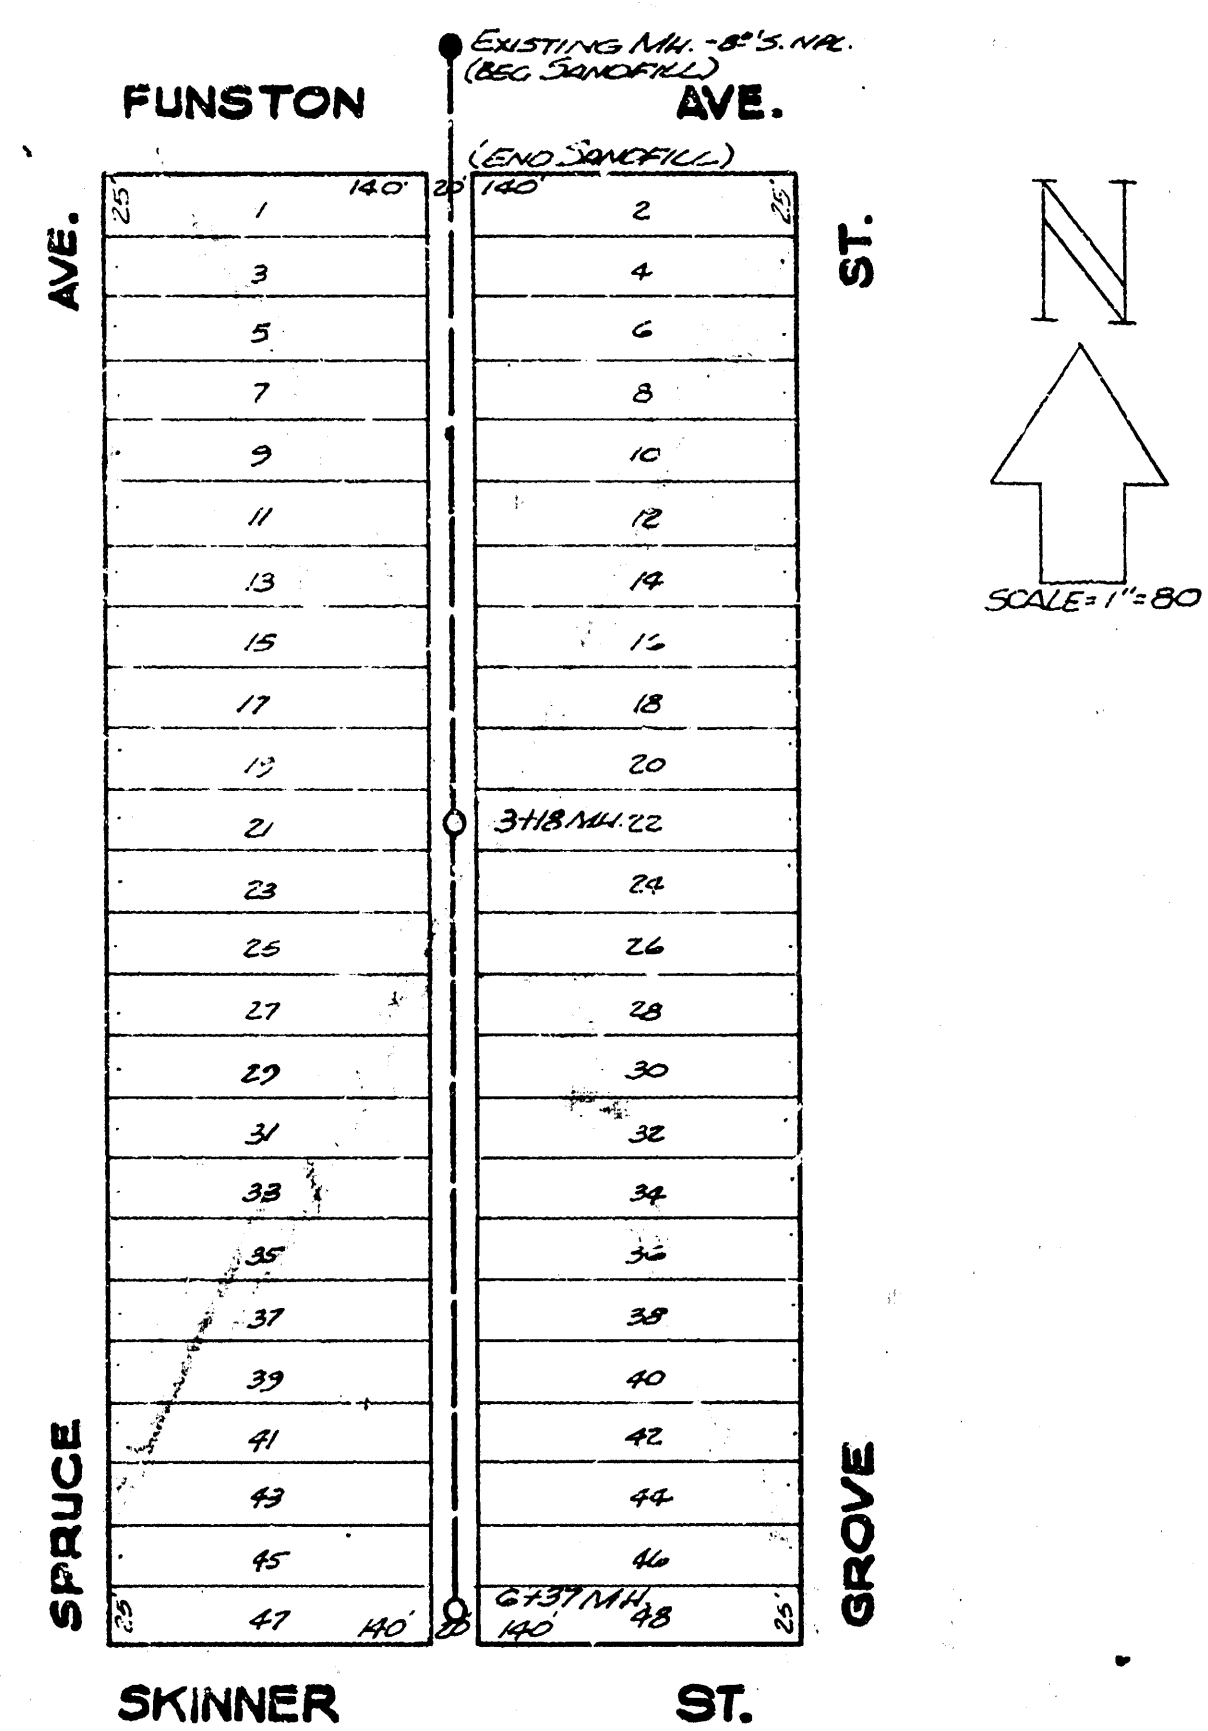


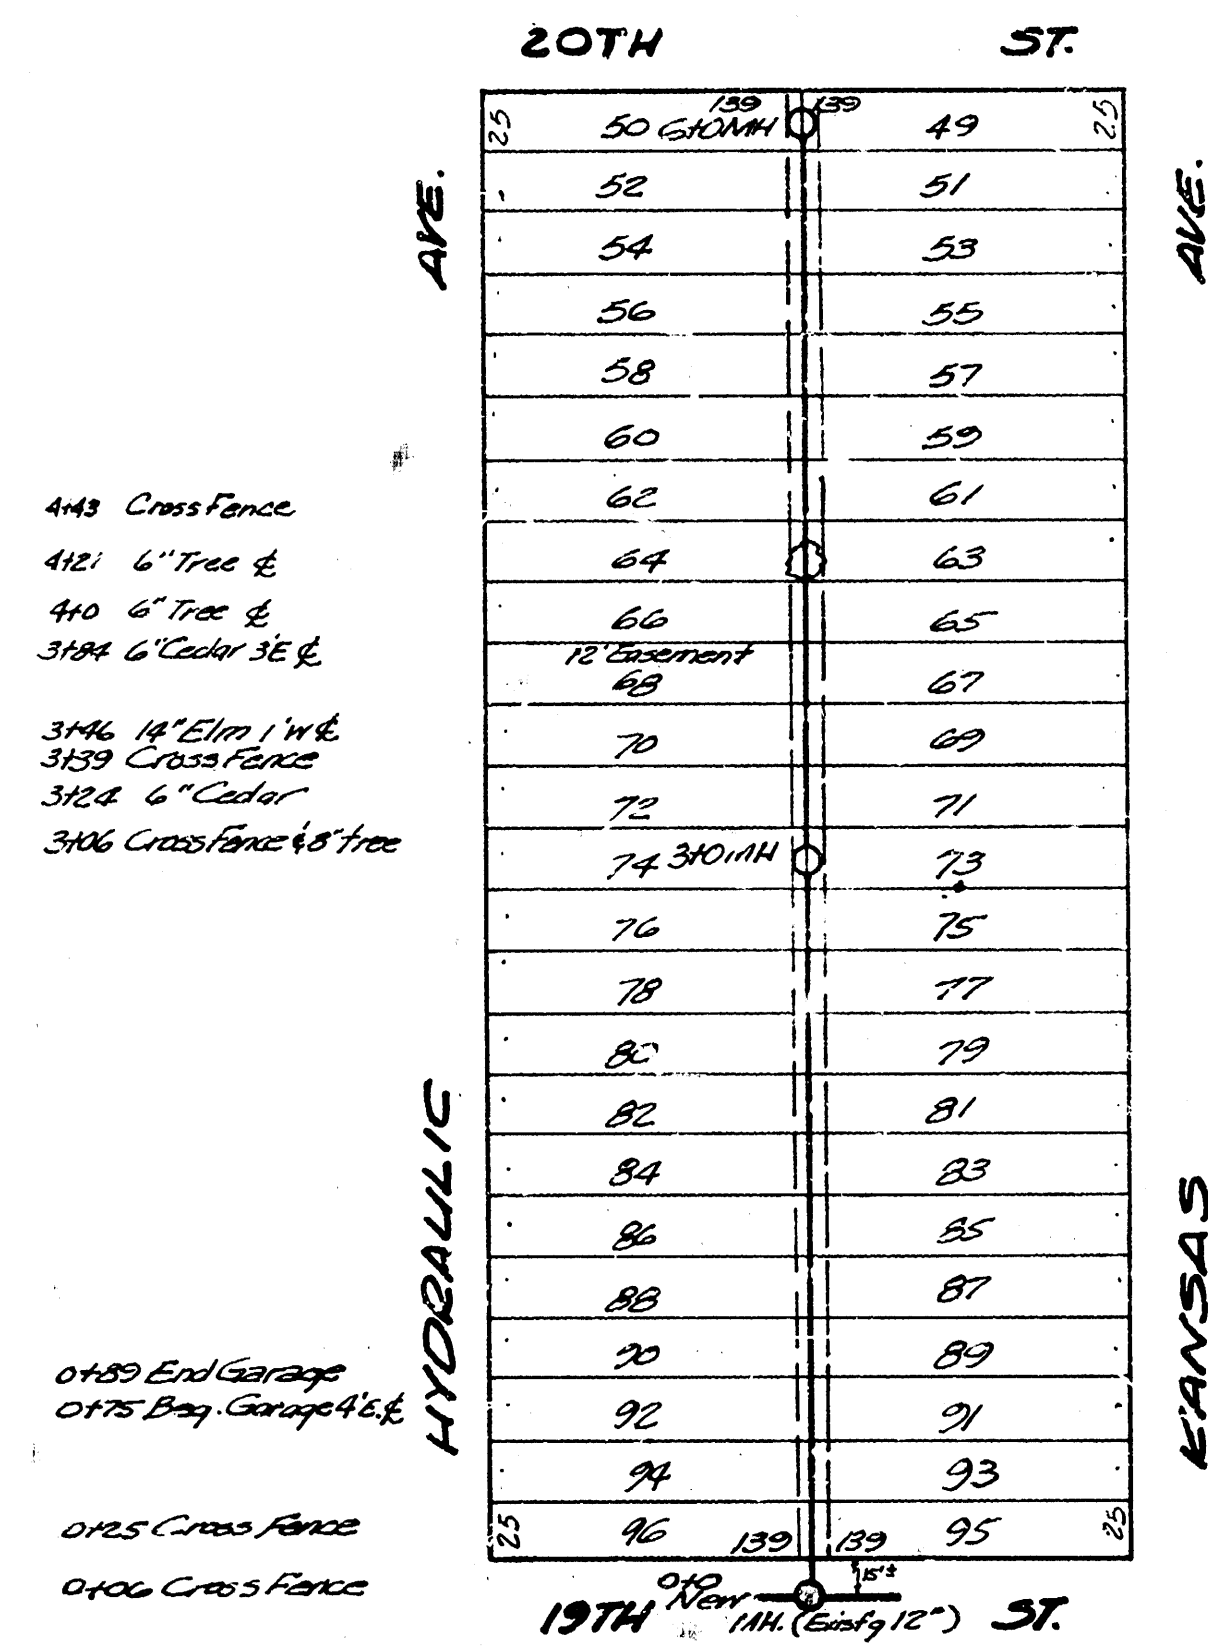


LAT. 9, DIST. AS, SS#12

BM. 99.33 "G" IN GLOBE S END WEST CURB Spruce & Funston

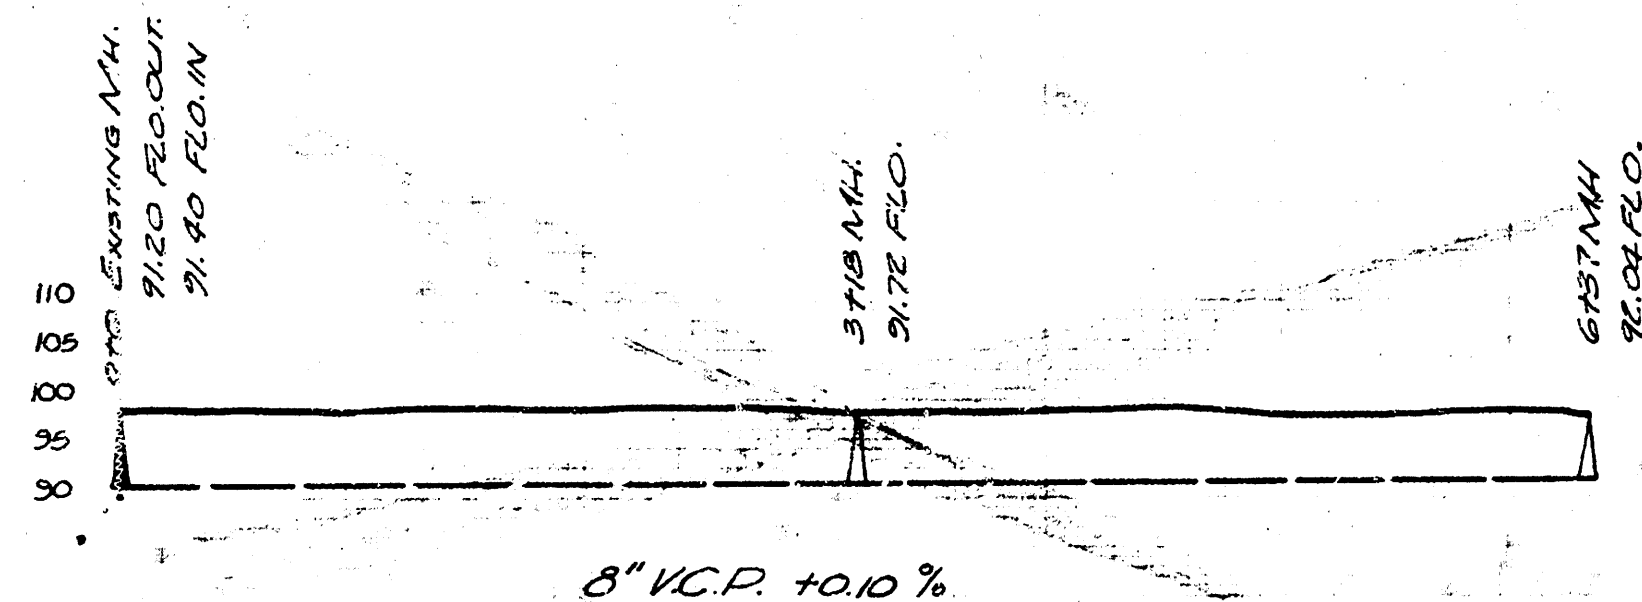


LAT. 19, DIST. T, SS#12

BM. 120.23 No. Rim of Sa. Spindle 19th & Hydraulic

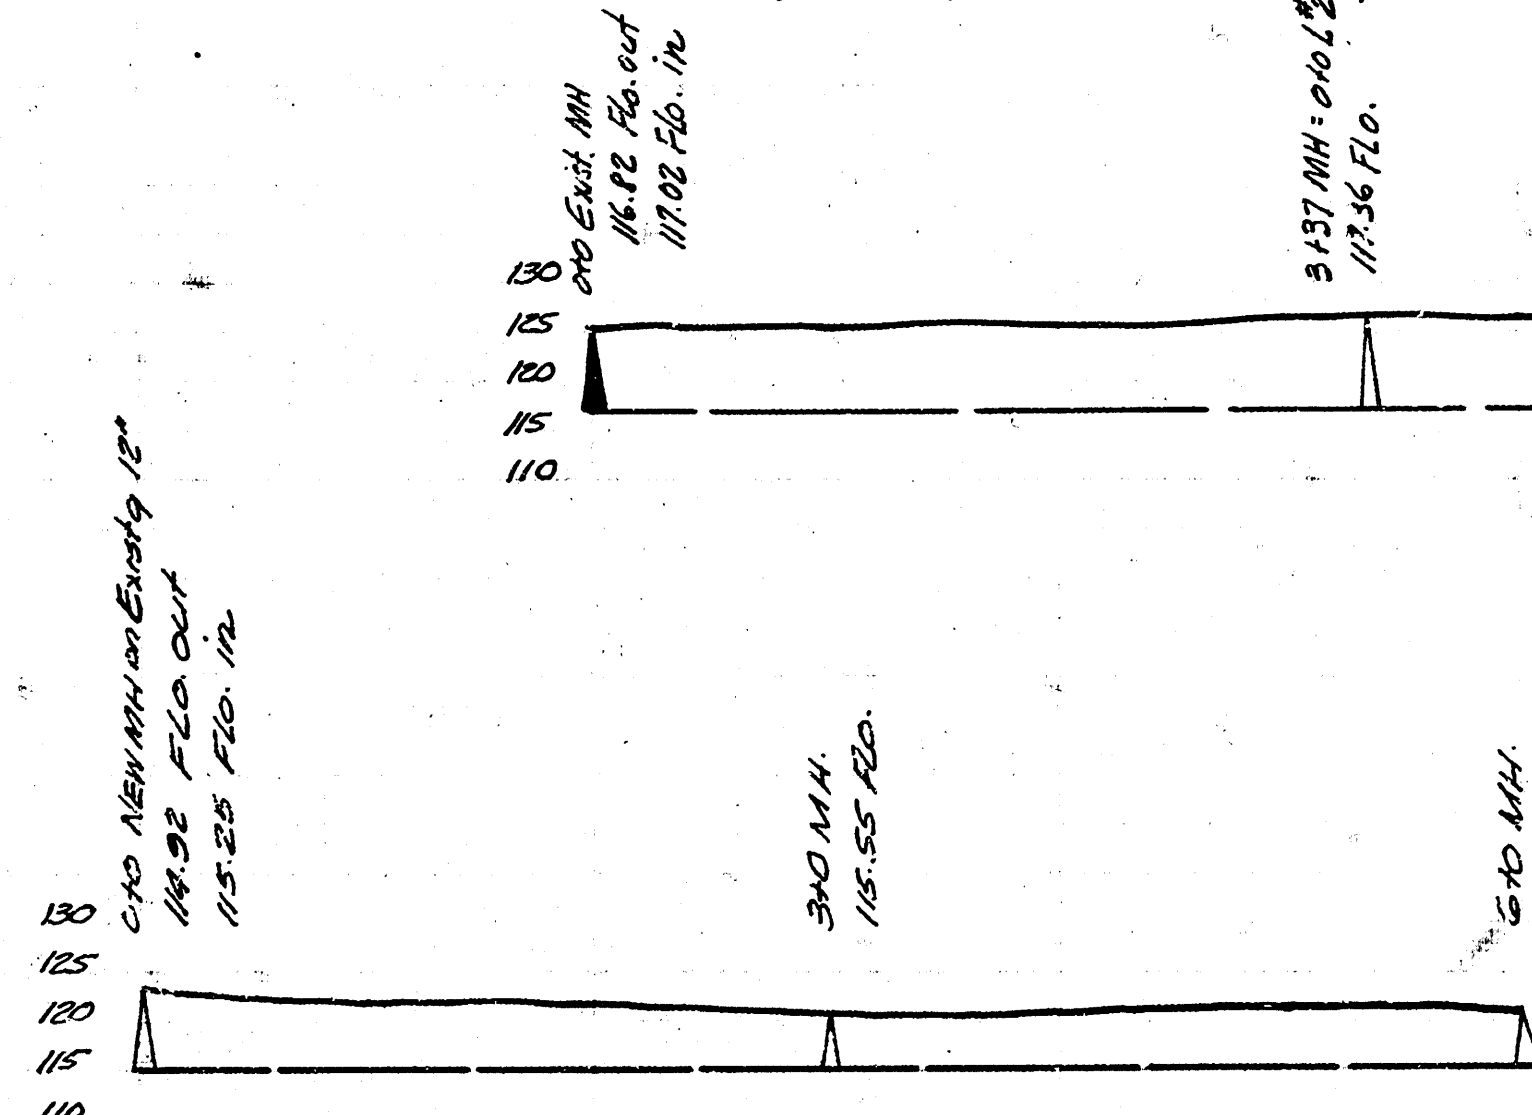


LAT. 19, DIST. T, SS#12

Scale 1"=80'

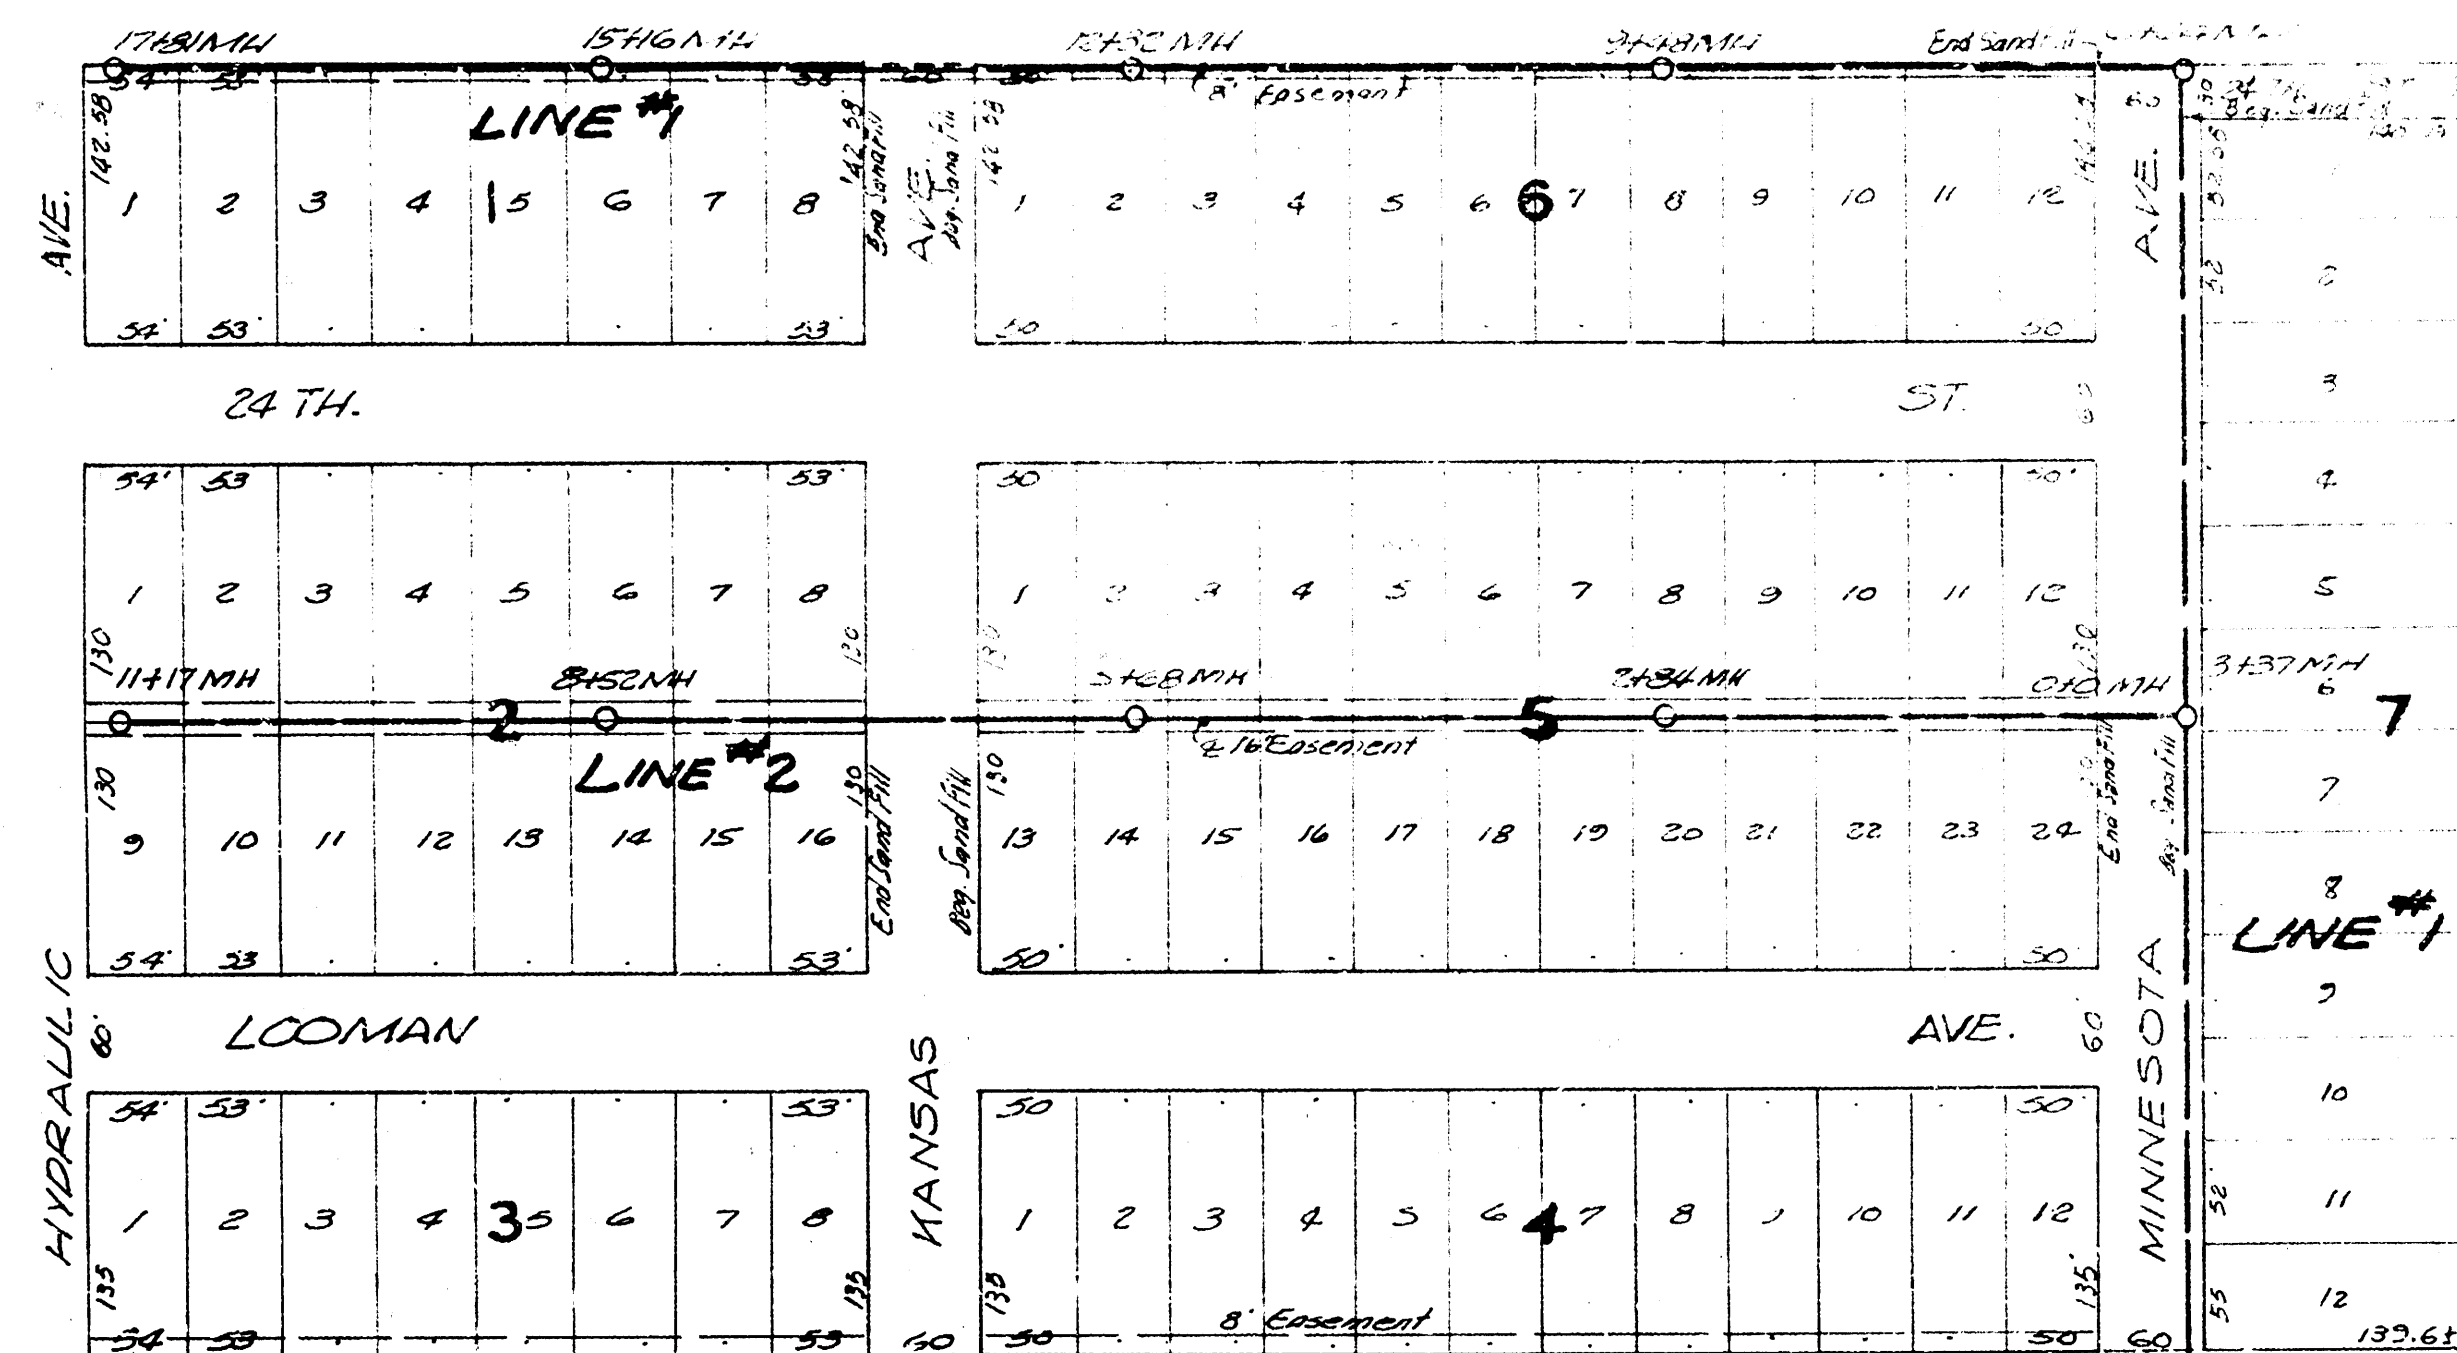

LAT. 18, DIST. T, SS#12

BM. 121.46 "G" in Globe End of cl. East Side Minnesota N.E. Millier Add.

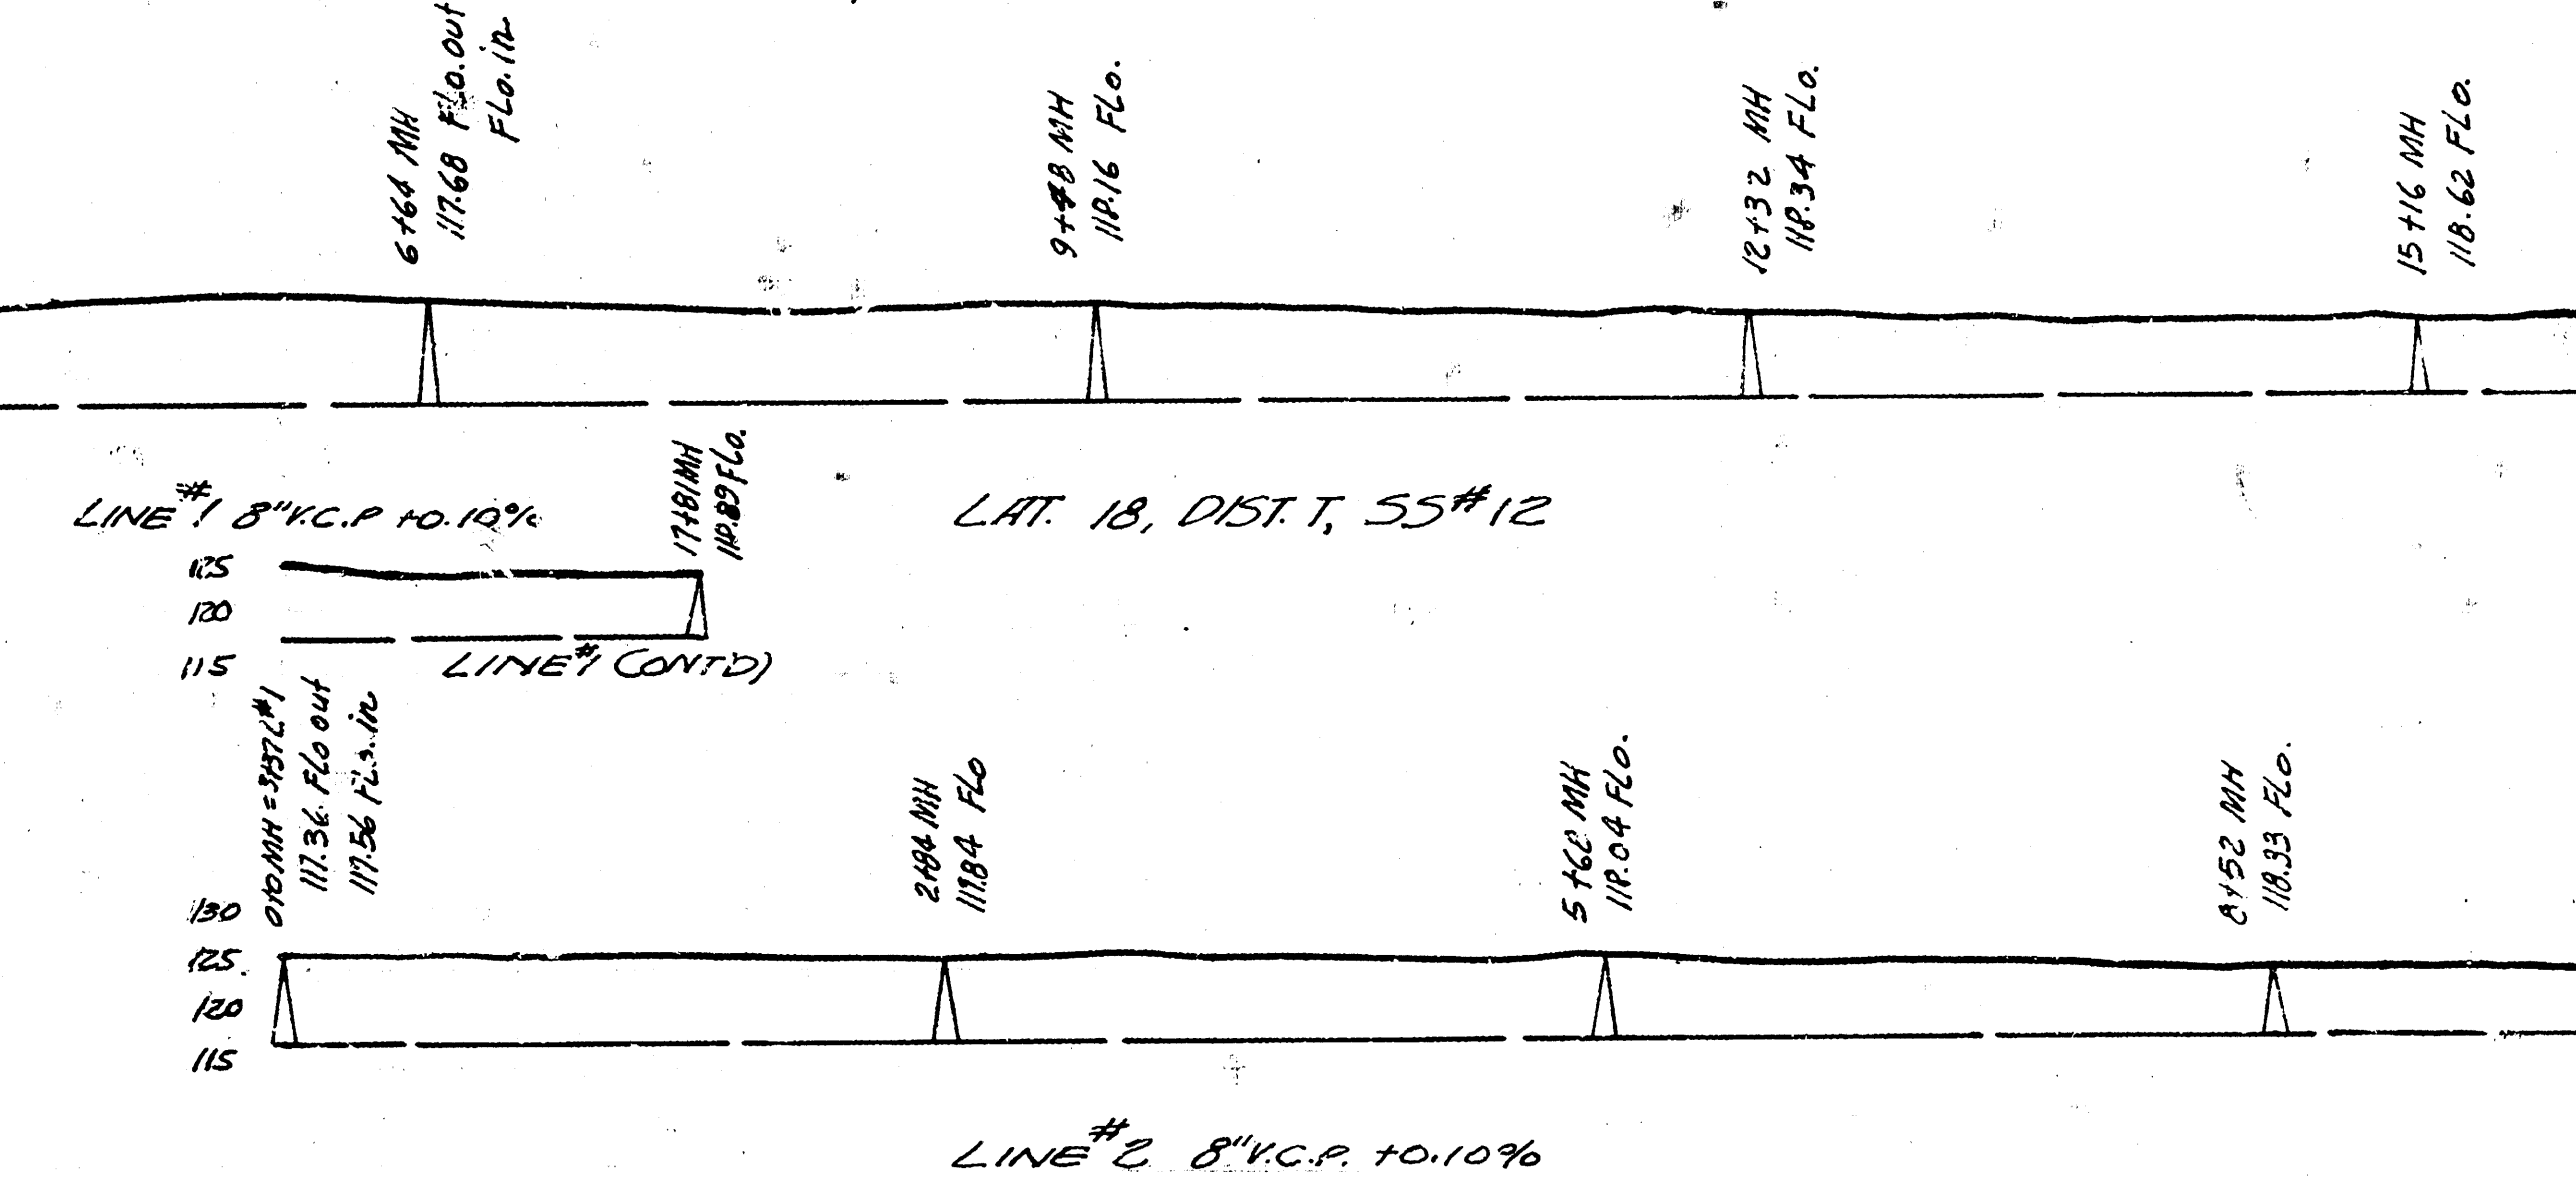

LAT. 18, DIST. T, SS#12
 LAT. 19, DIST. T, SS#12
 LAT. 9, DIST. AS, SS#12

CITY OF WICHITA, KANSAS

L.R. WHITE CITY ENGINEER

DATE 1-6-19 PROJ. NO. C28-6R