



Scale: 1" = 50'

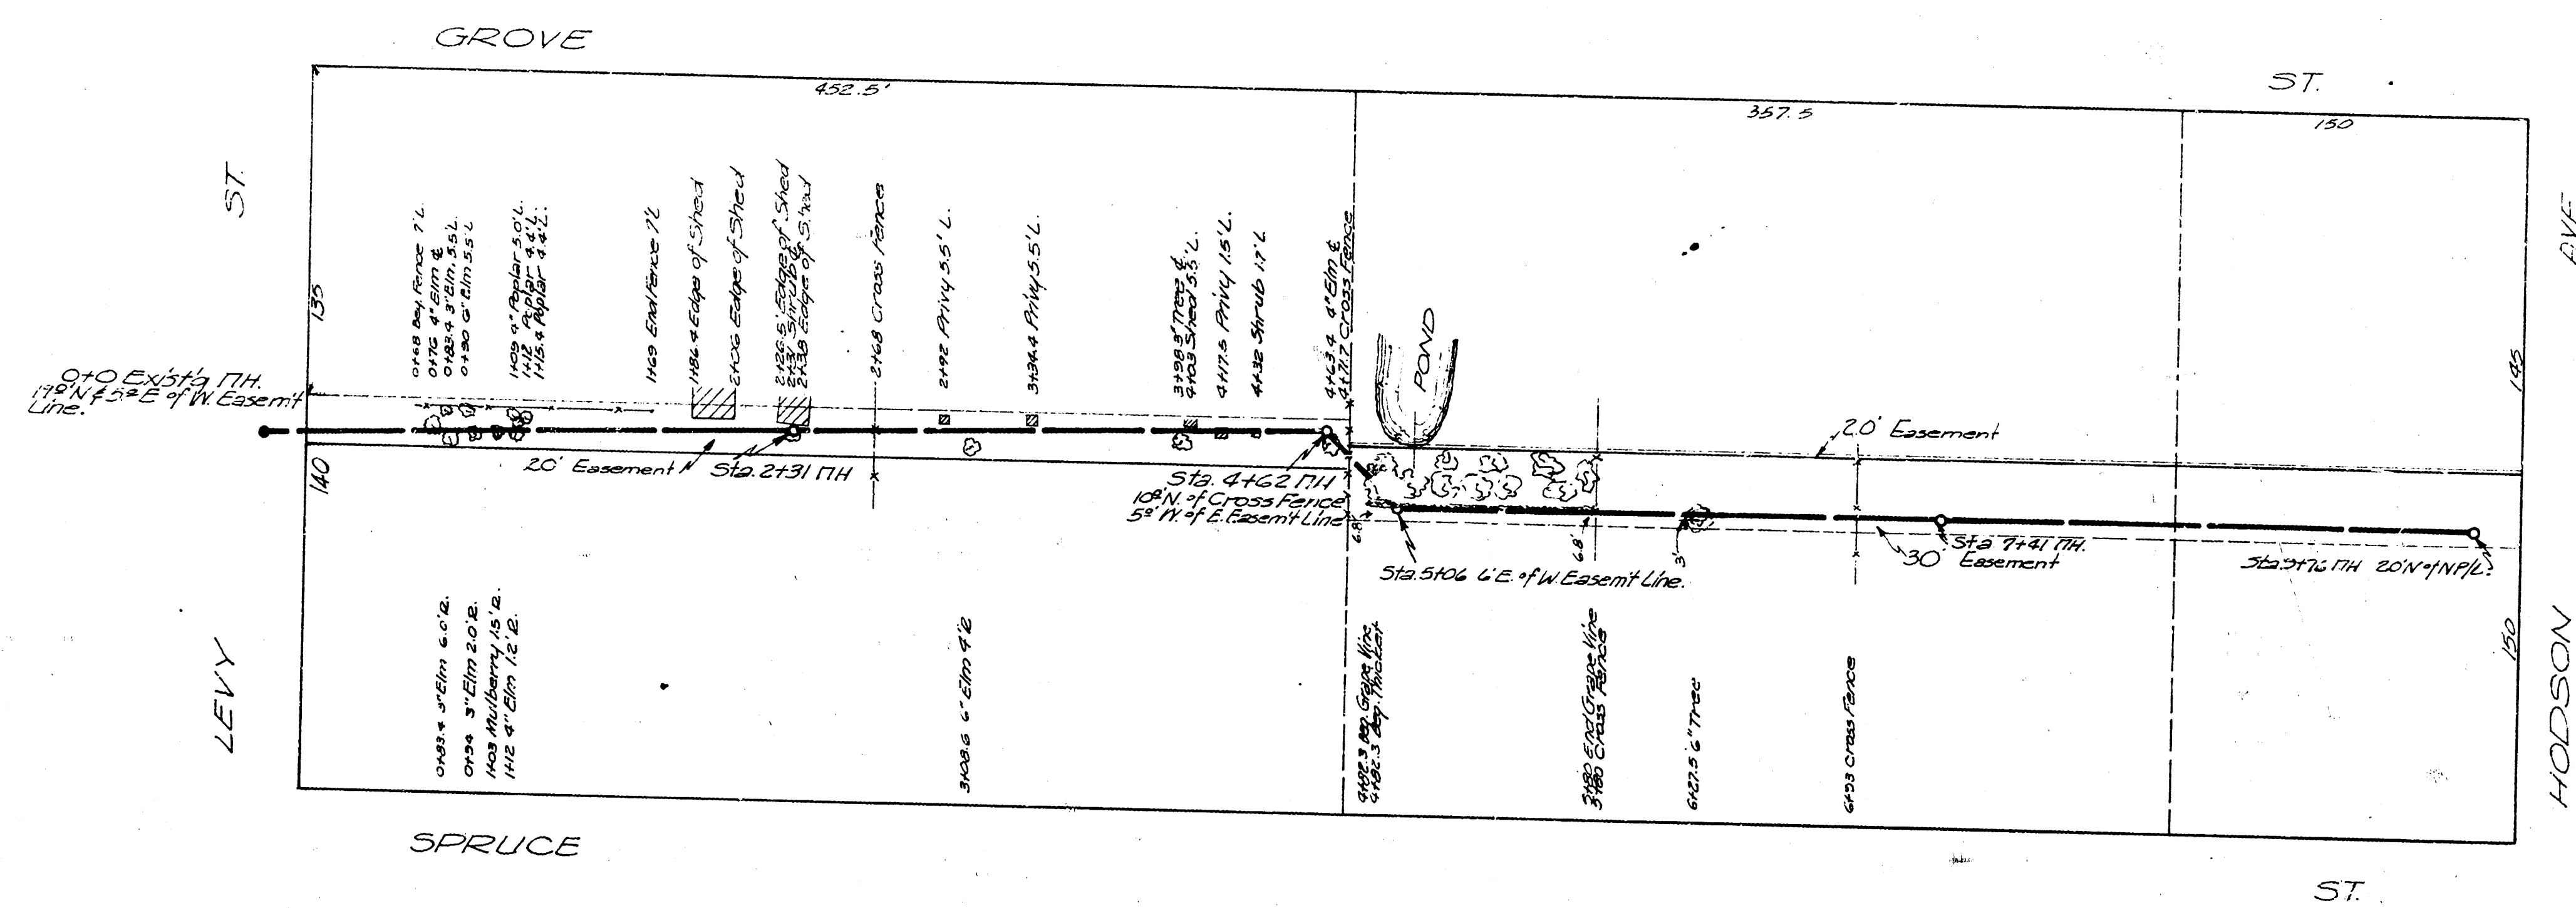

5.17. 78.32 W. 12.11 M Sta. 010

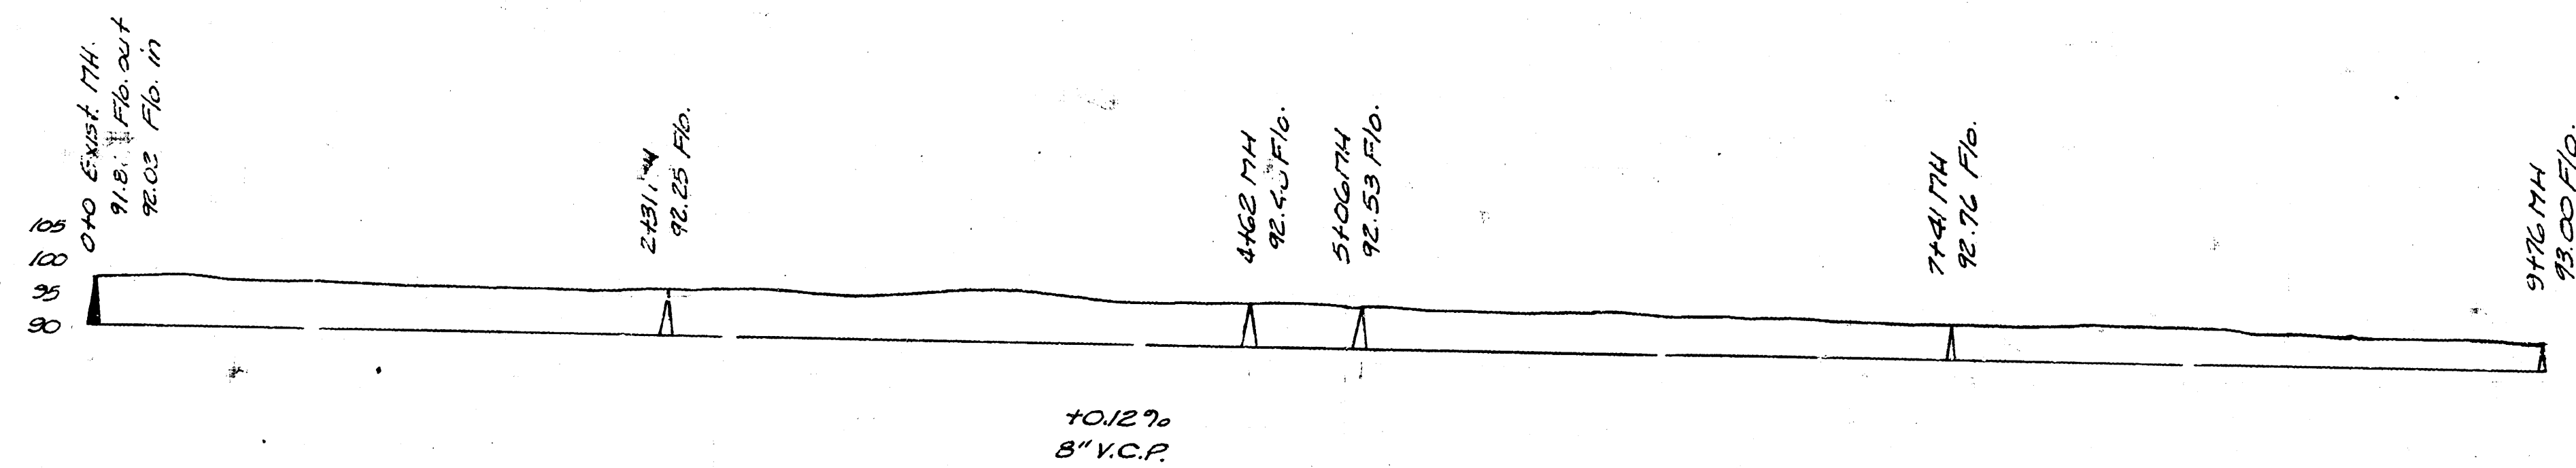

"SEWER PROFILED TO EXAGGERATED SCALE HORIZONTALLY"

LAT. 11, DIST. A.S., S.S.#12
City of Wichita, Kansas
L.K. White ~ City Engineer
Date: 2-24-50 Proj. No. C29-58