




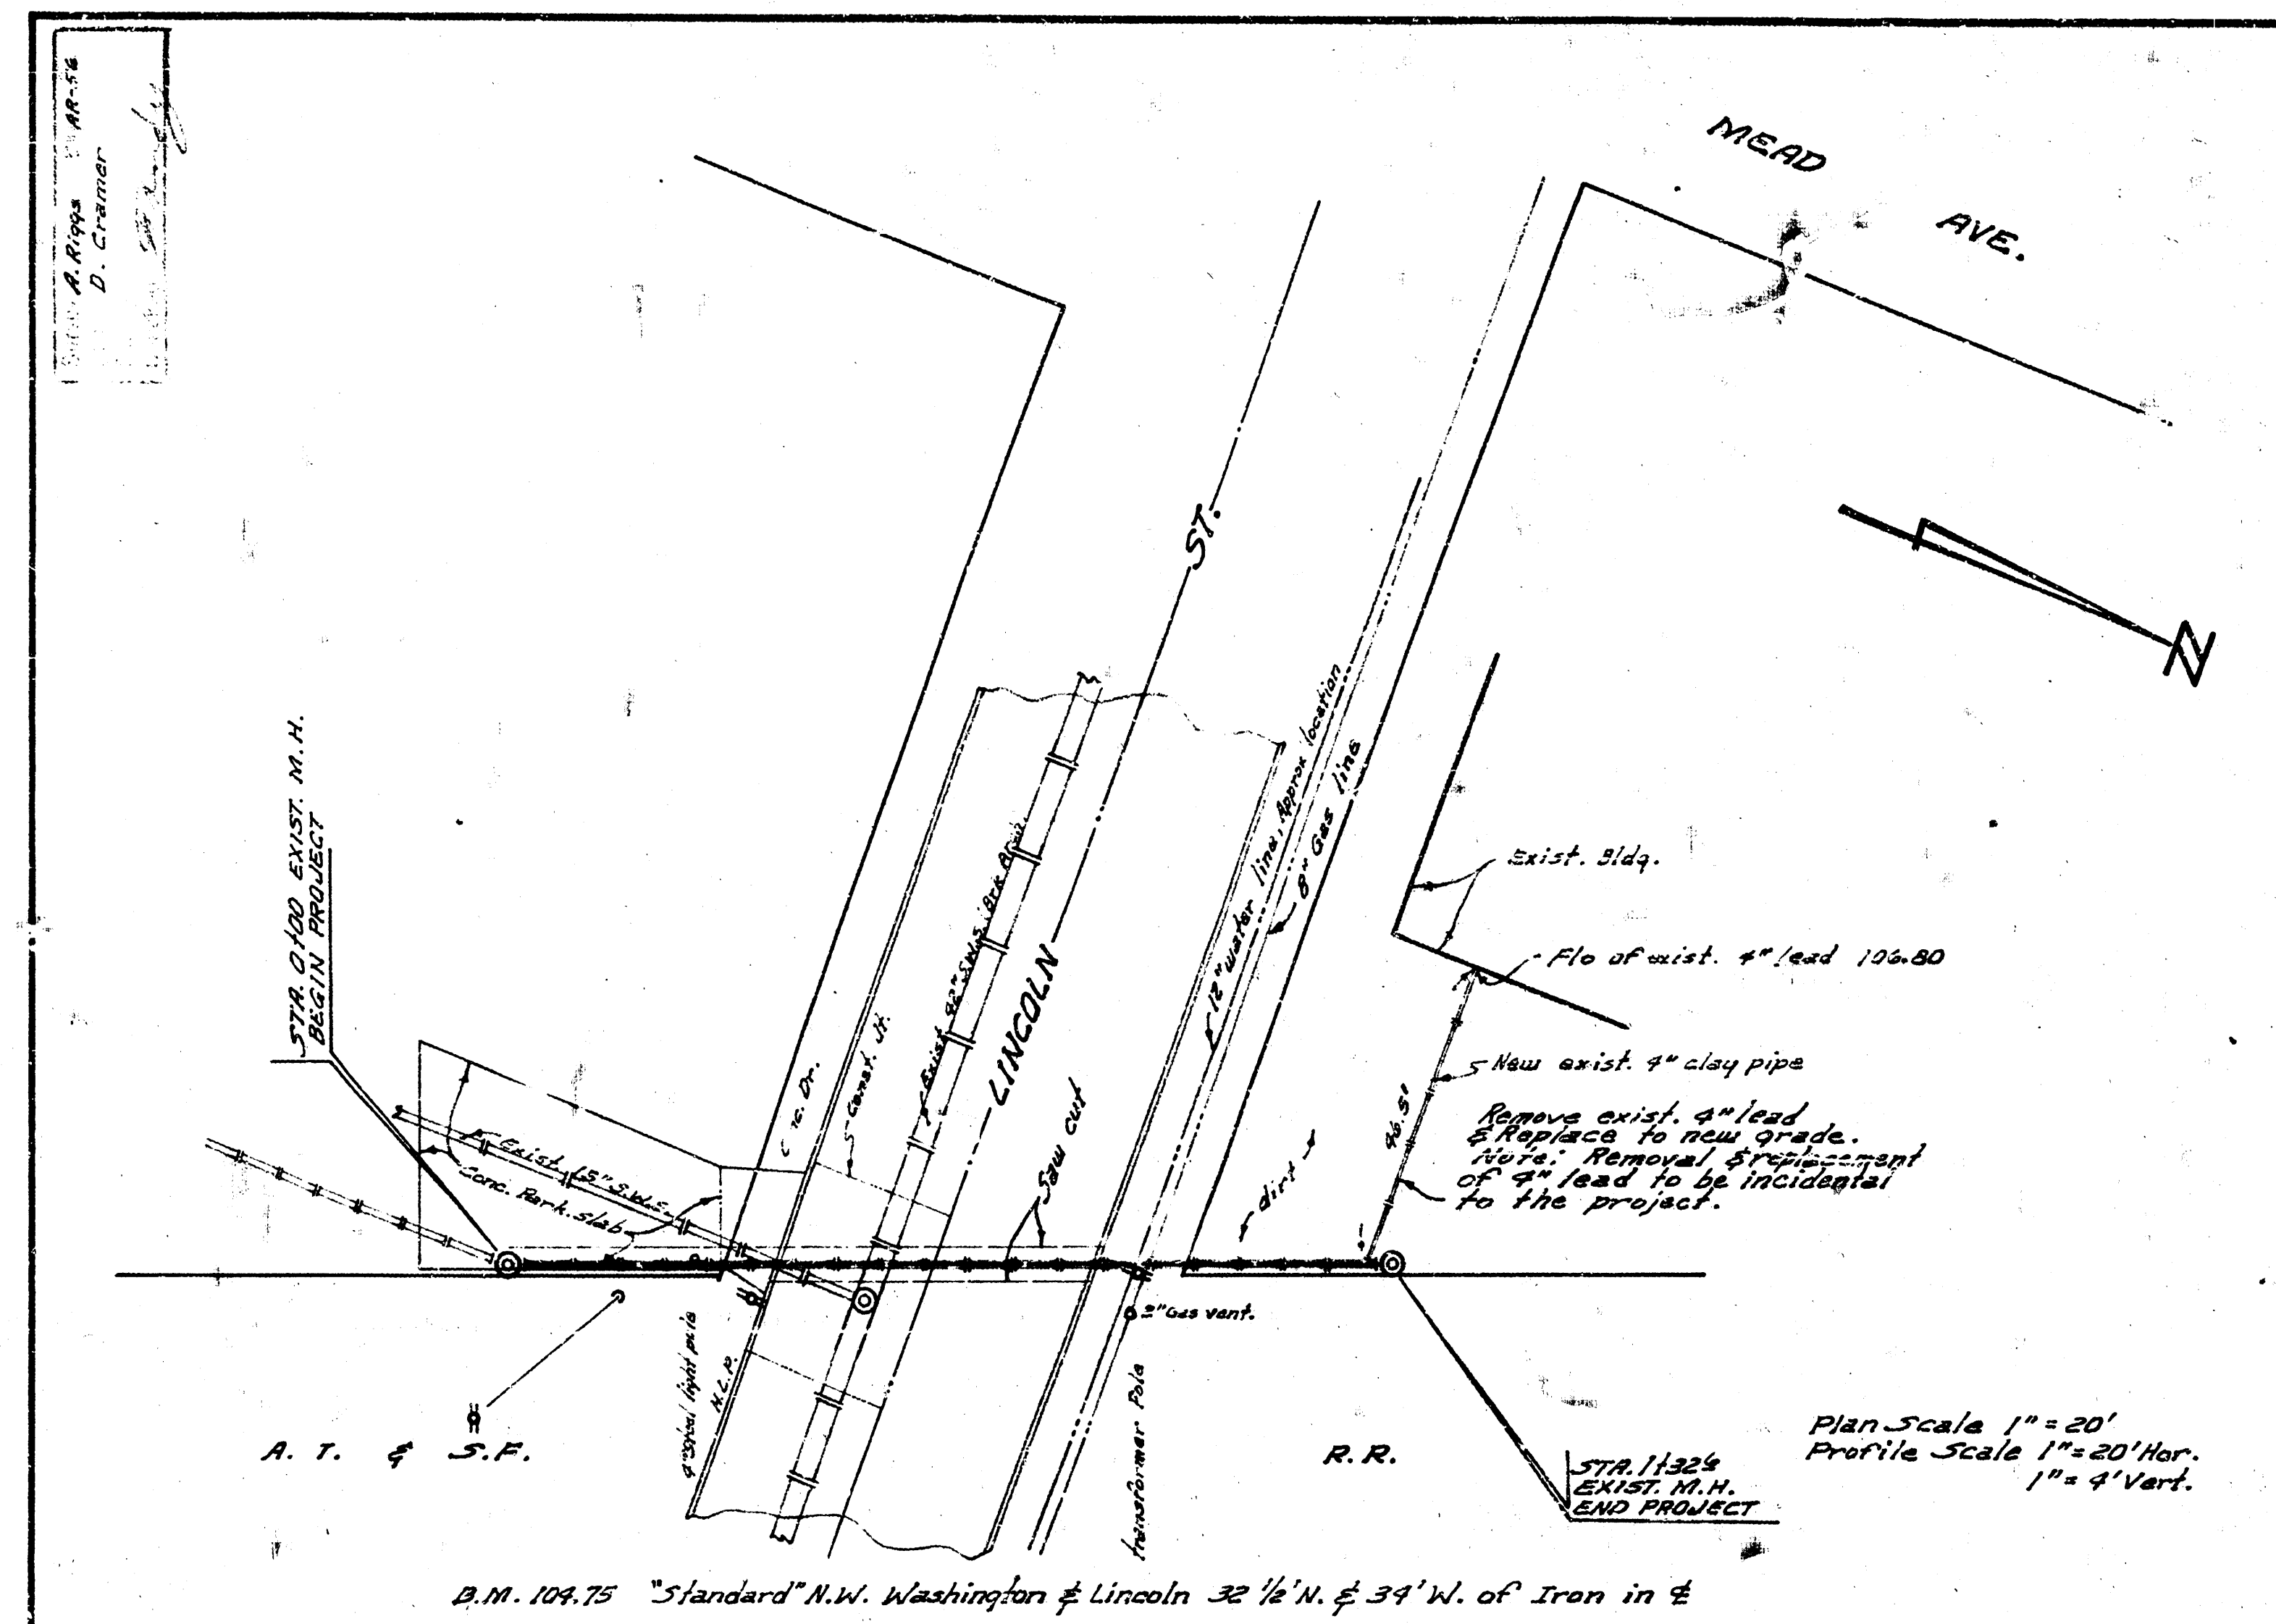



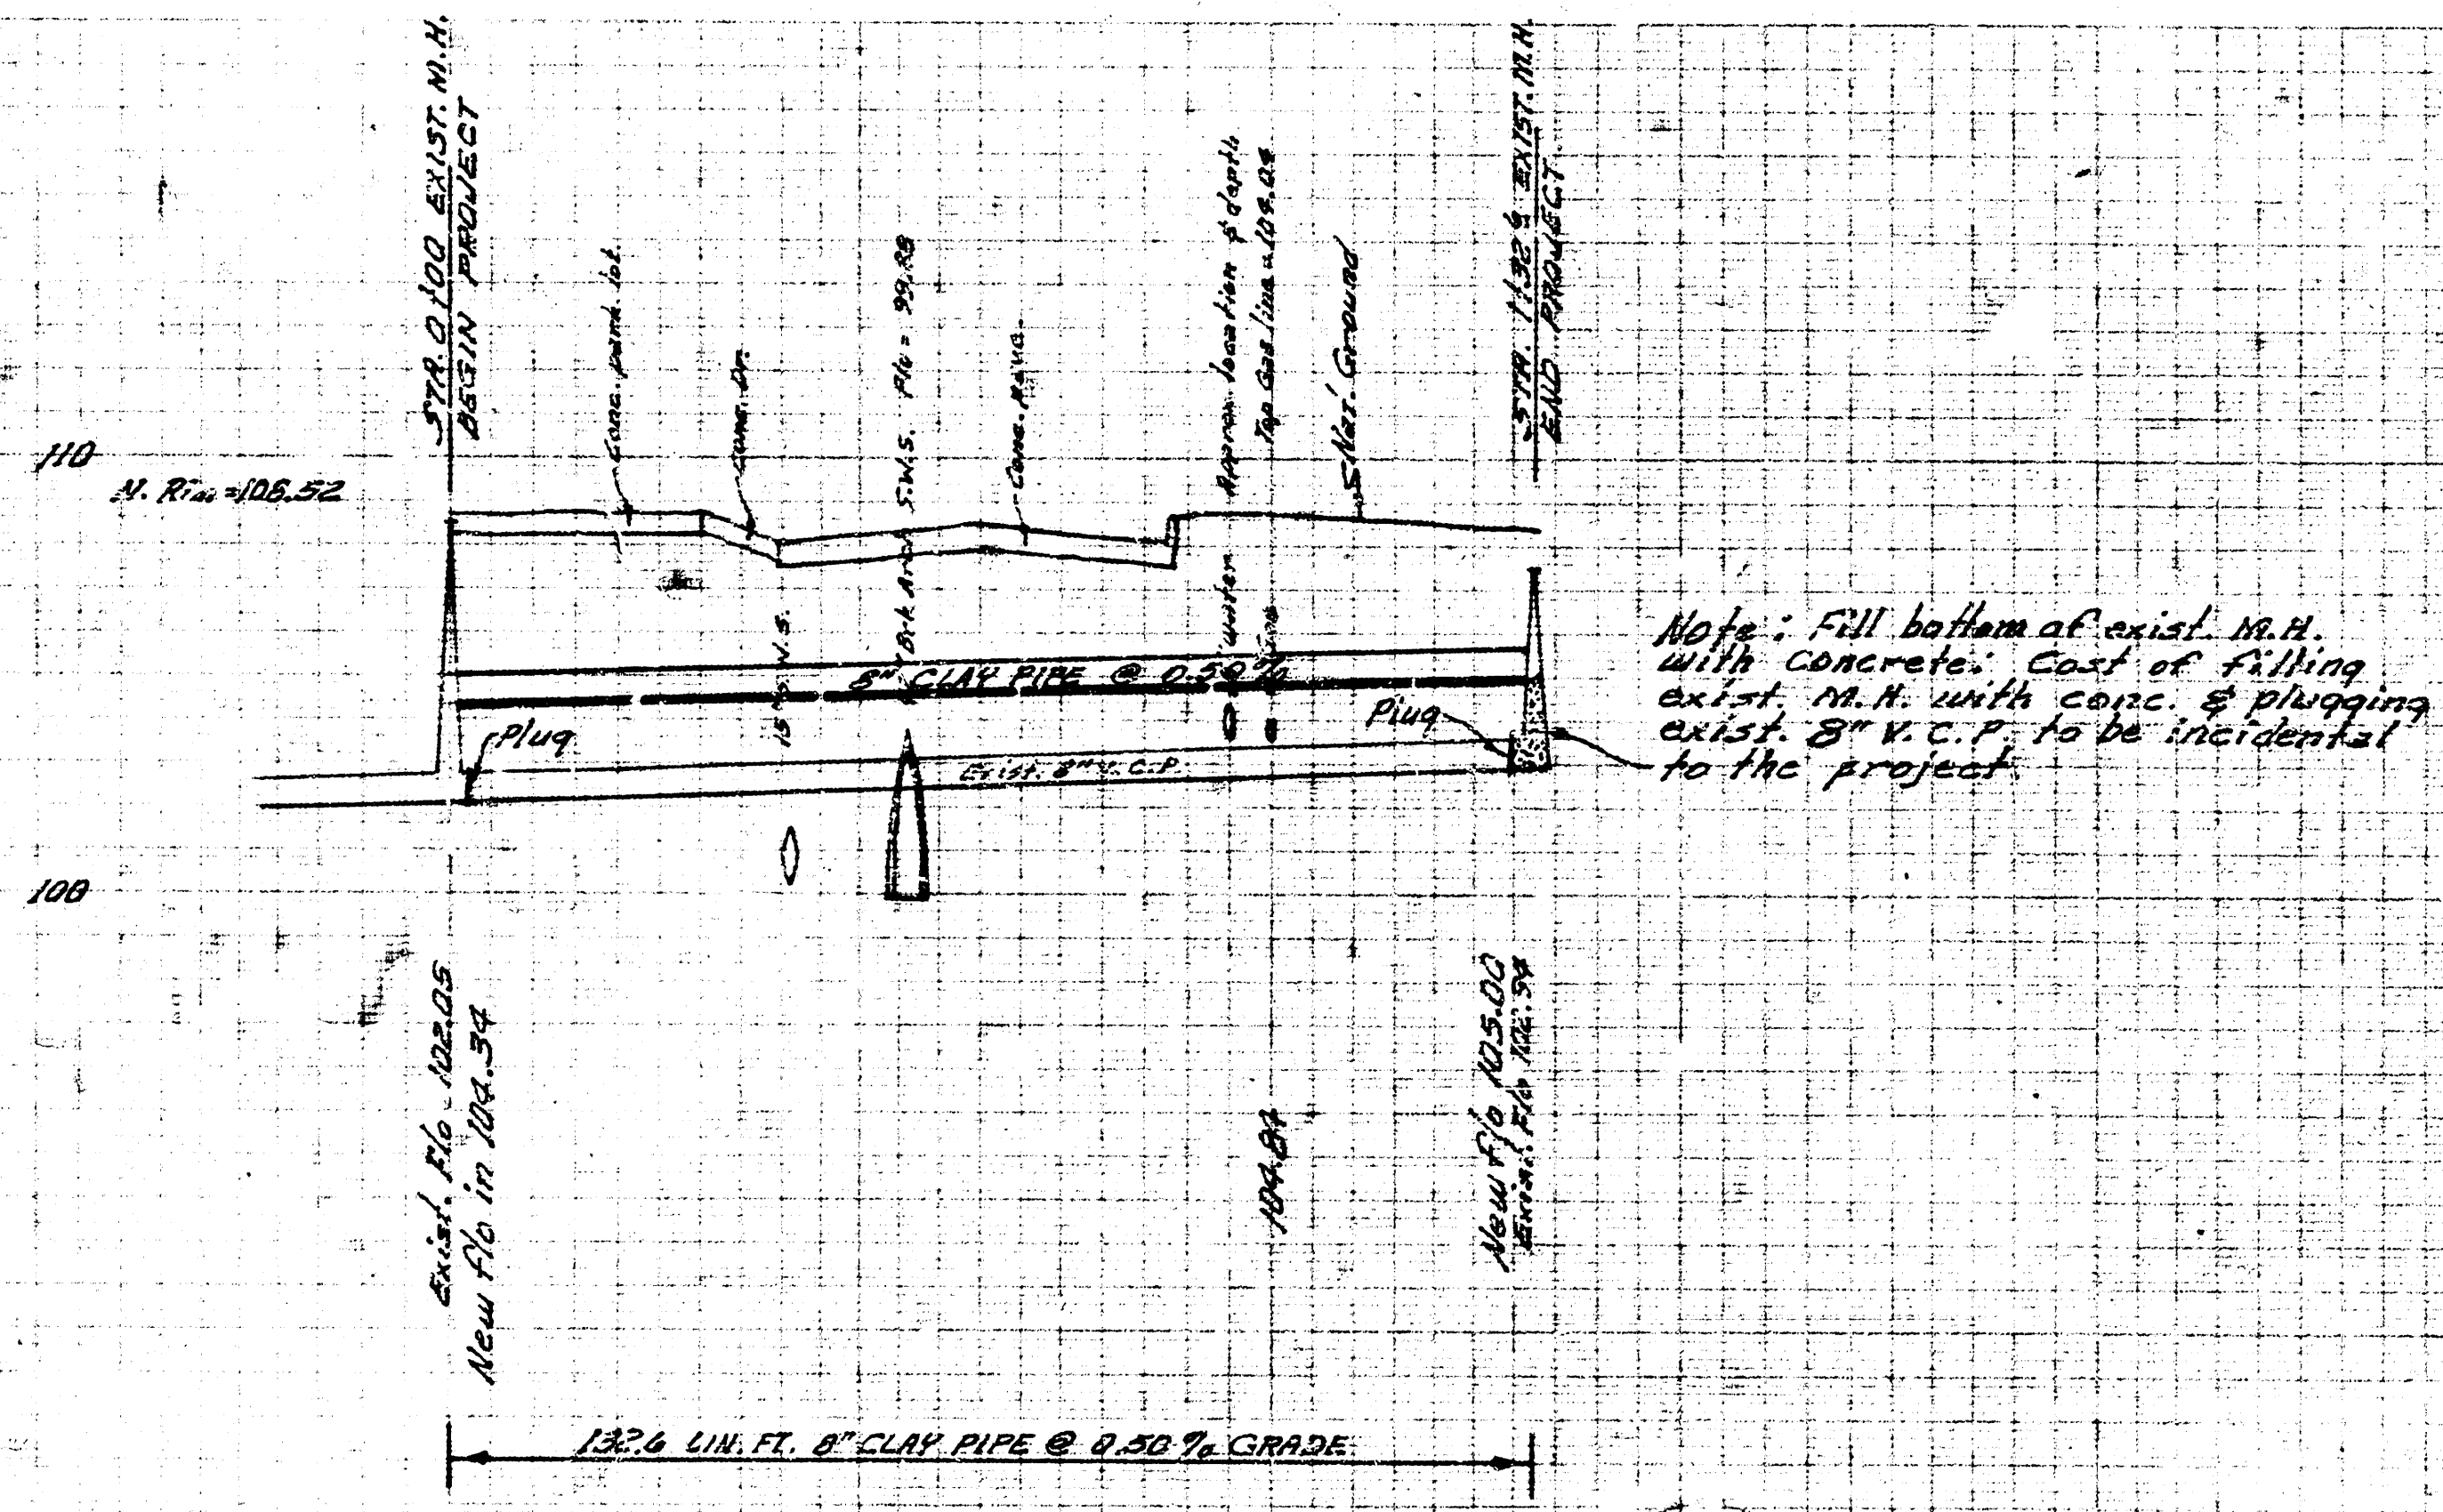

REPAIR OF LAT. N. W. SUB-MAIN "D"
SAN. SEWER NO. 1
CITY OF WICHITA, KANSAS
B. E. SMITH, CITY ENGINEER
PROJ. NO. U32
DATE: FEB. 1970

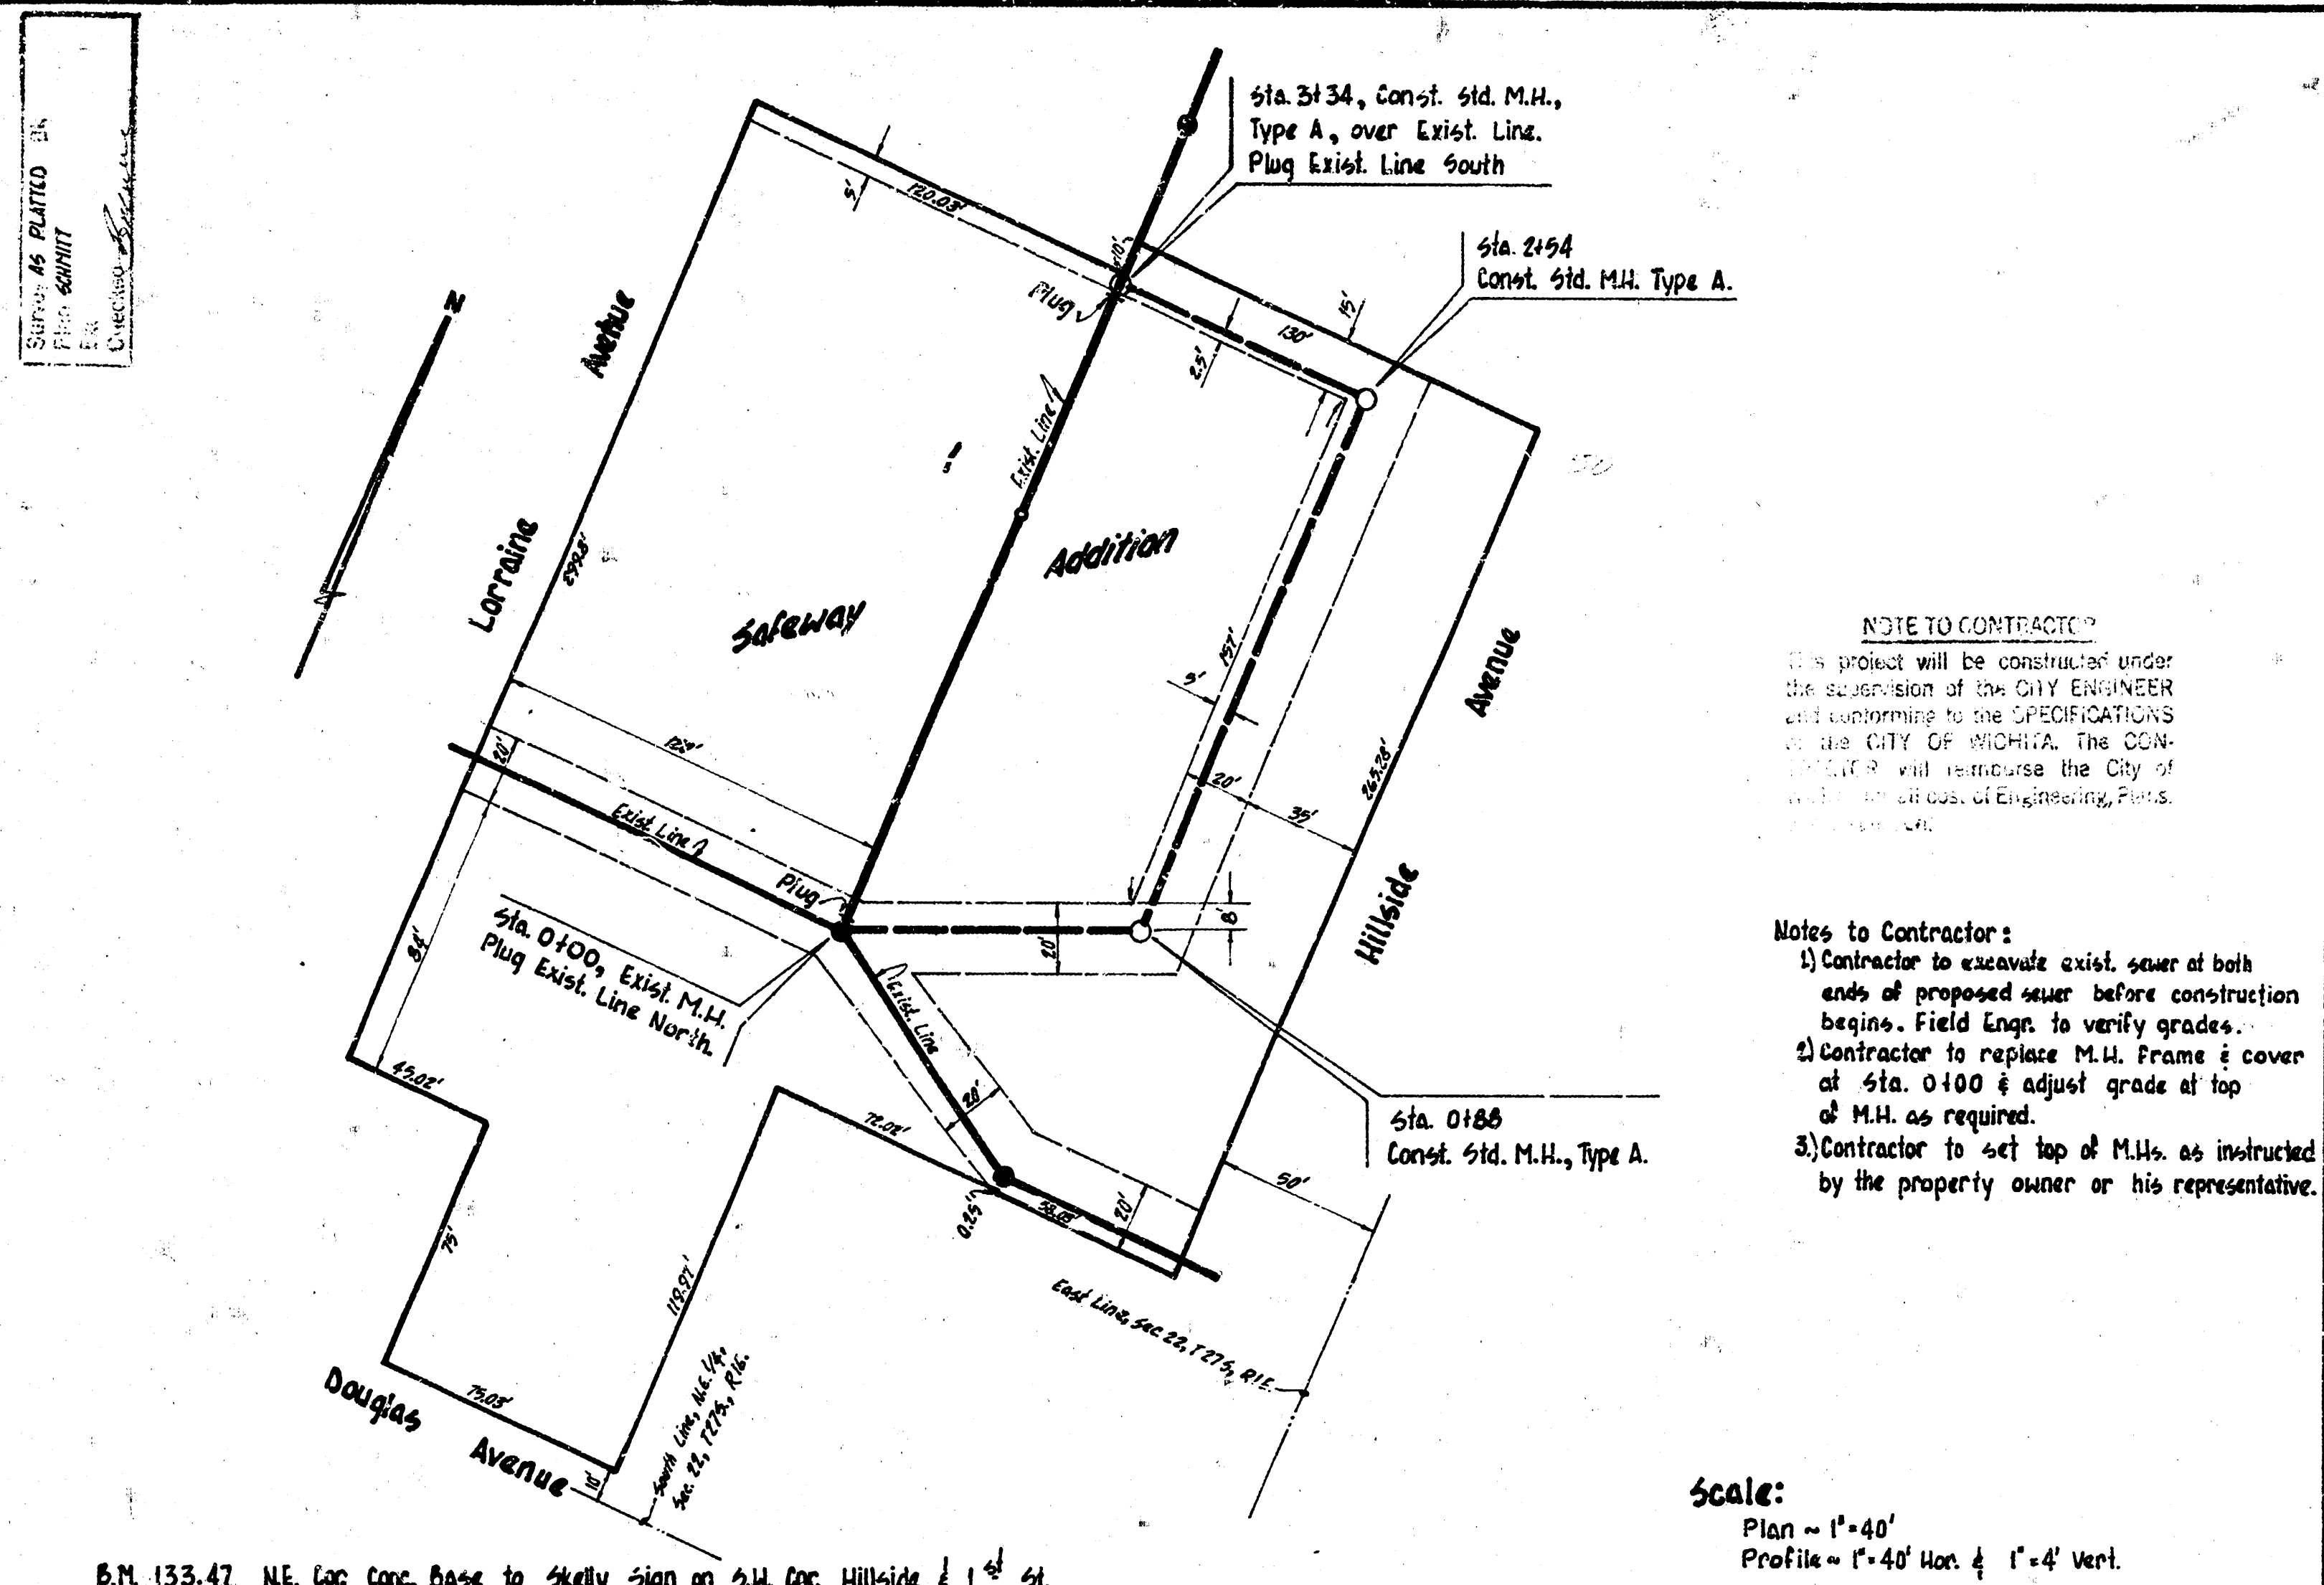

Scale:
Plan - 1"=40'

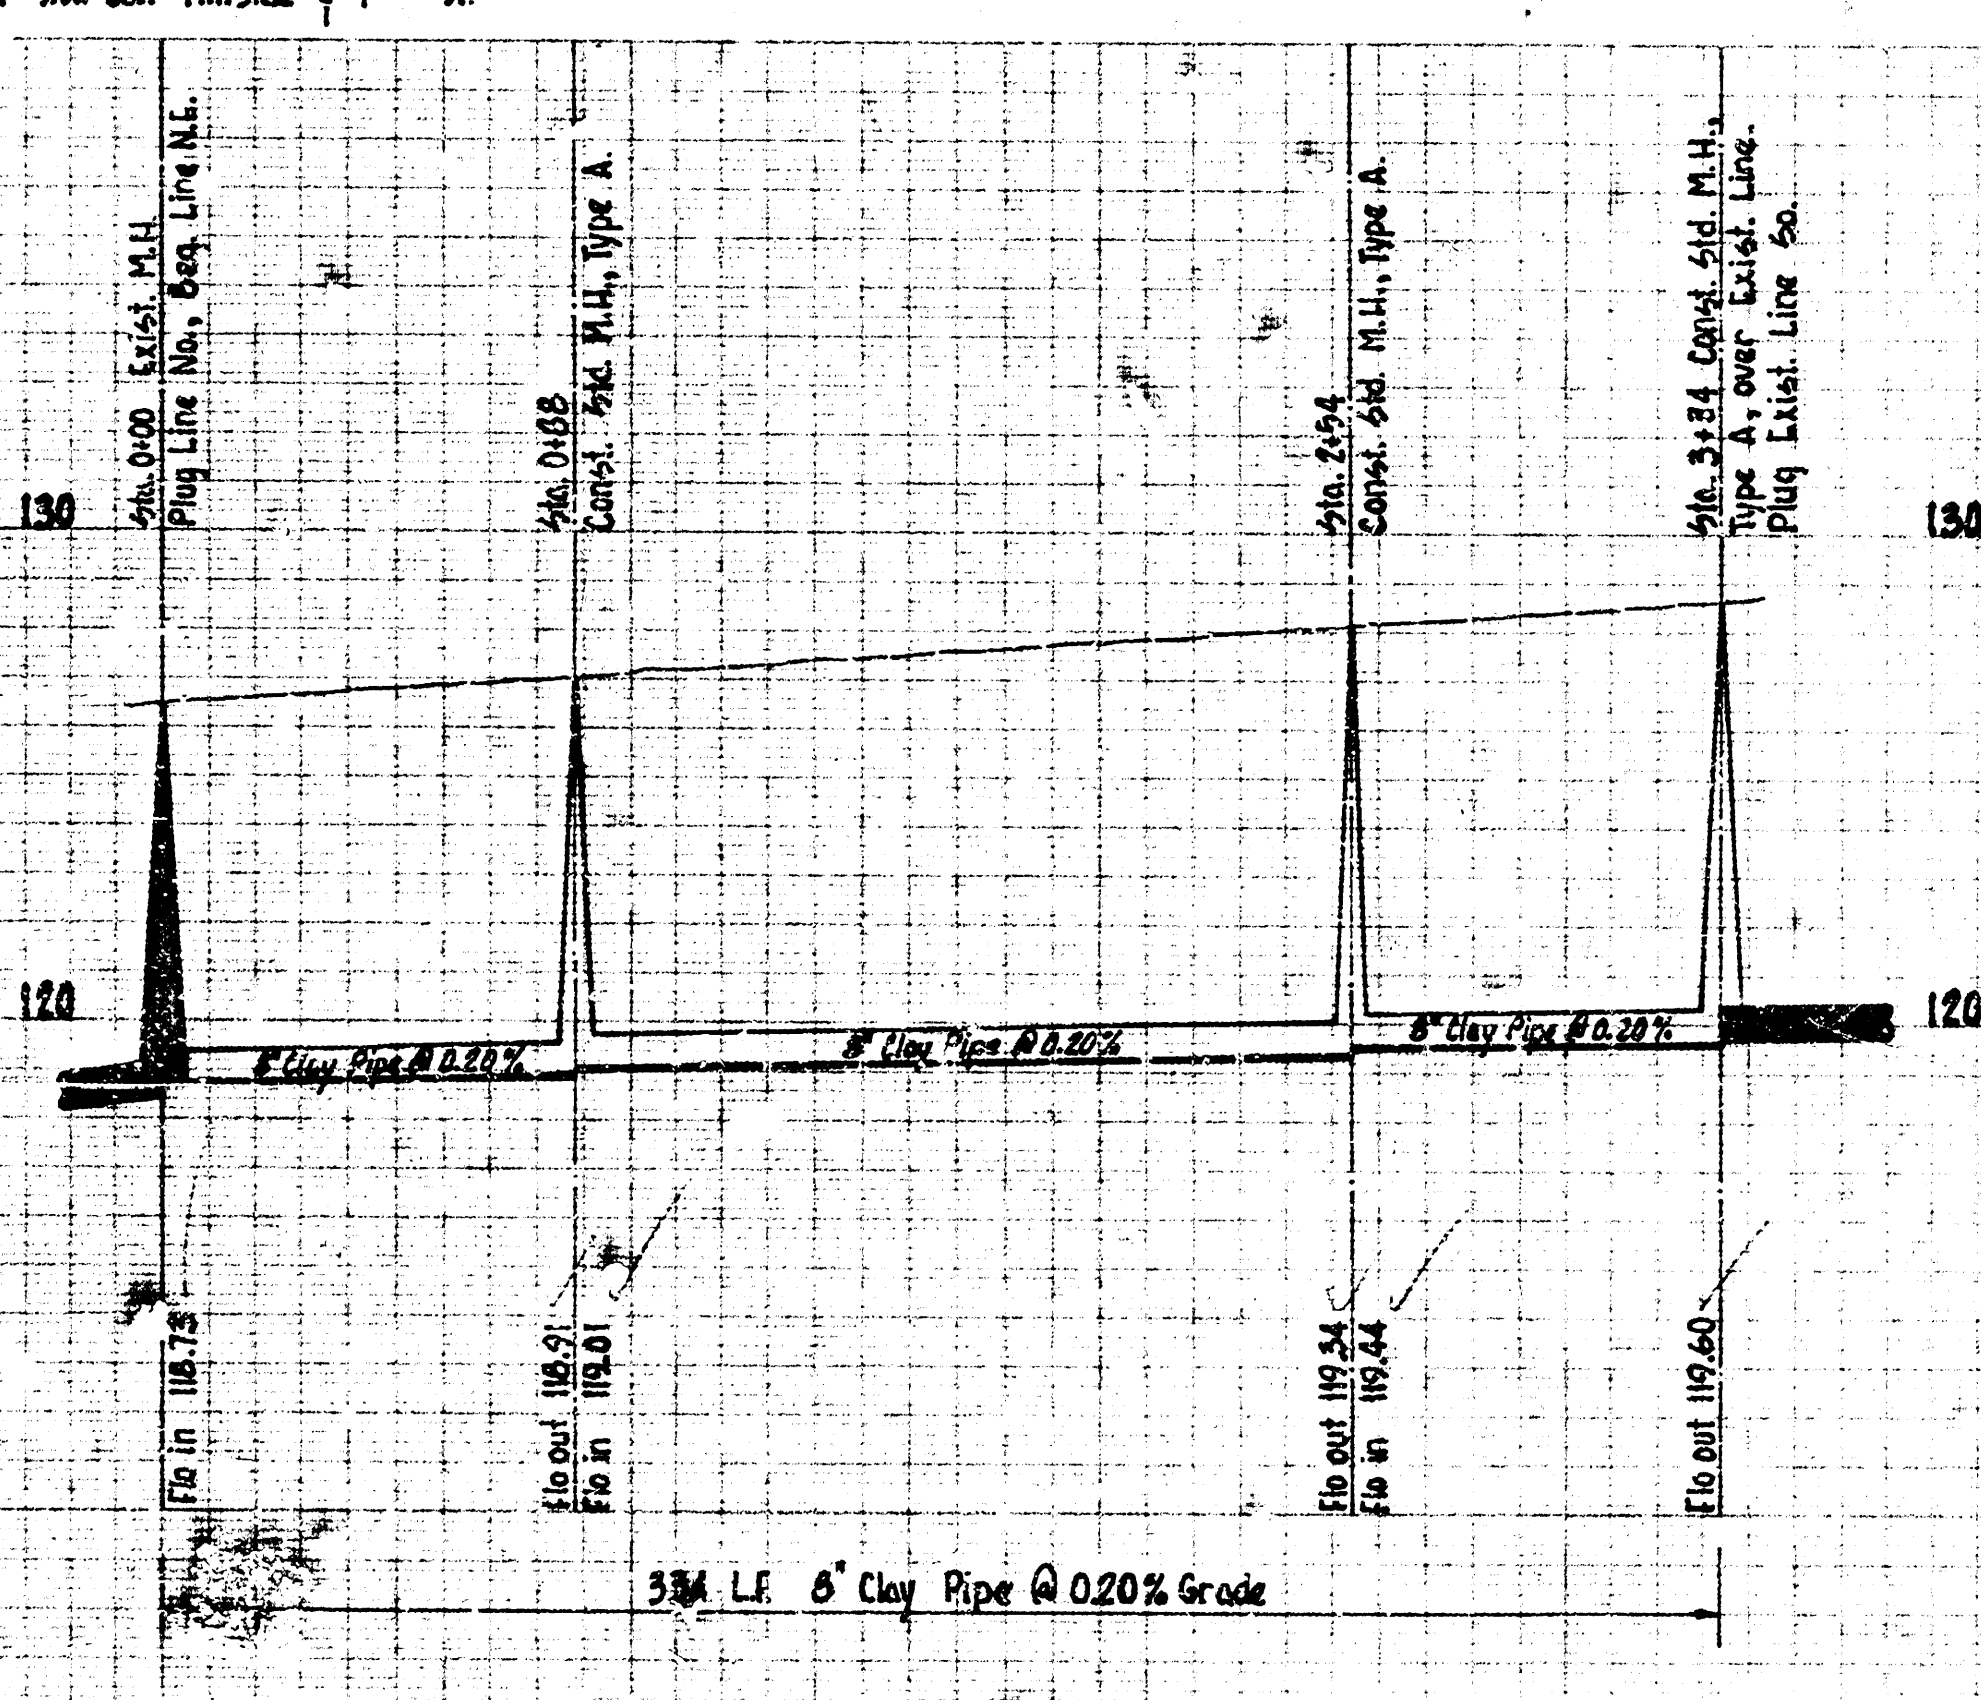

Relocation of Part of Dist. B, 3.5" 12
for the Safety Addn.
City of Wichita, Kansas.
B. E. Smith, City Engineer
Private Project
Date: Feb. 1970

NOTE TO CONTRACTOR:
This project will be constructed under the supervision of the CITY ENGINEER and conforming to the SPECIFICATIONS of the CITY OF WICHITA. The CONTRACTOR will reimburse the City of Wichita for the cost of Engineering Fees.

Notes to Contractor:
1) Contractor to excavate exist. sewer at both ends of proposed sewer before construction begins. Field Engr. to verify grades.
2) Contractor to replace M.H. frame & cover at Sta. 0100 & adjust grade at top of M.H. as required.
3) Contractor to set top of M.H.s. as instructed by the property owner or his representative.