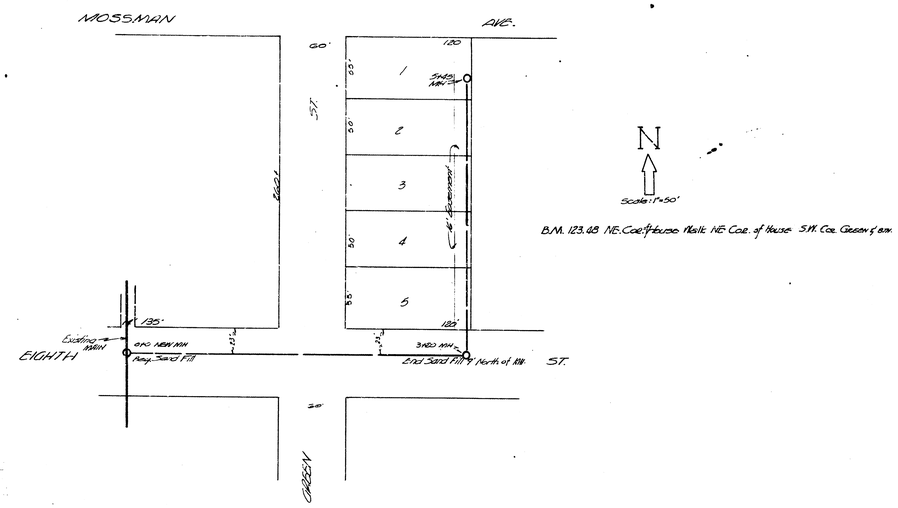


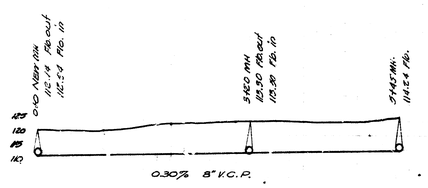


LAT. 7 DIST. E MAIN 12

CITY OF WICHITA, KANSAS

L.K. WHITE CITY ENGINEER

DATE: JAN. 1949 PROJ. NO. C28-33