



Lot 12, Dist. A, SS# 20

871 1214 N.E. Kirkald & Main
871 1214 N.E. Water

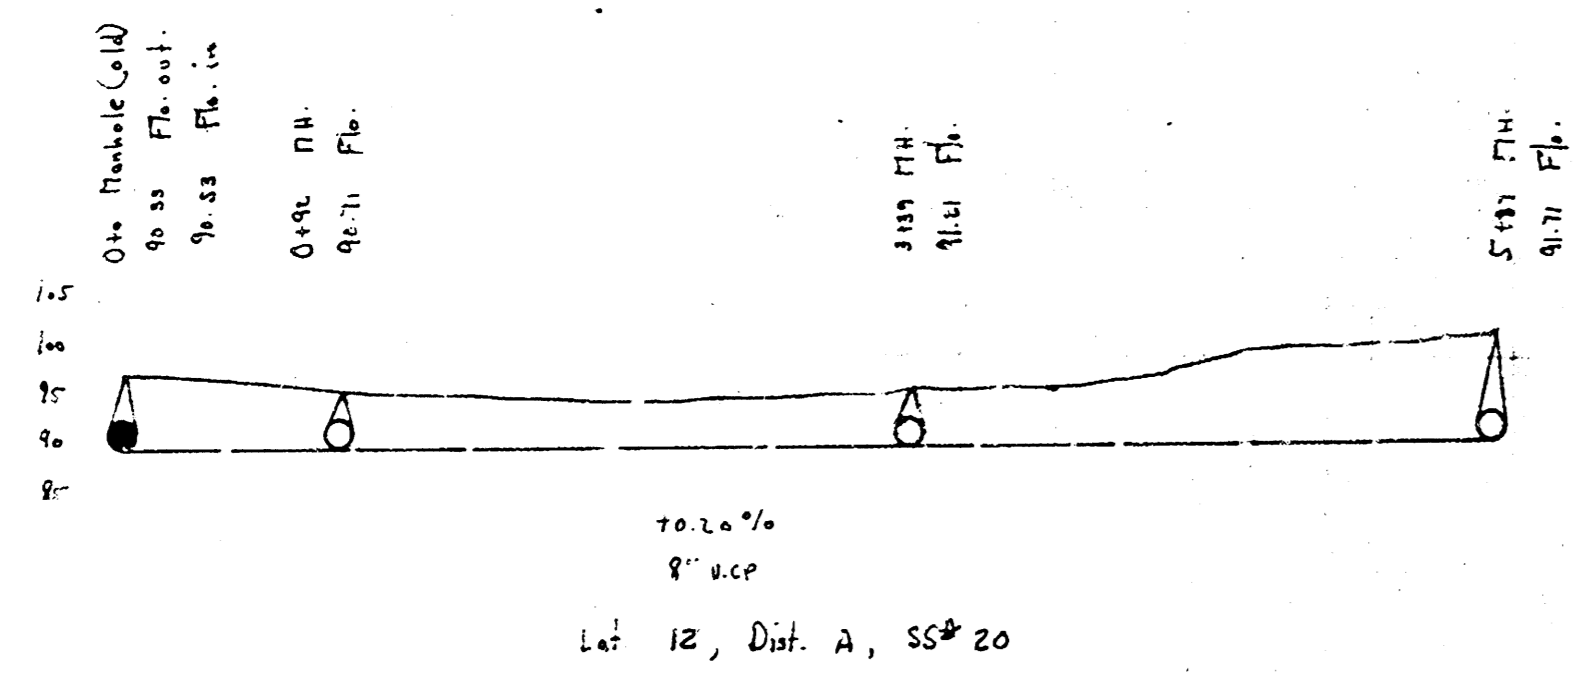


Lot 12, Dist. A, SS# 20

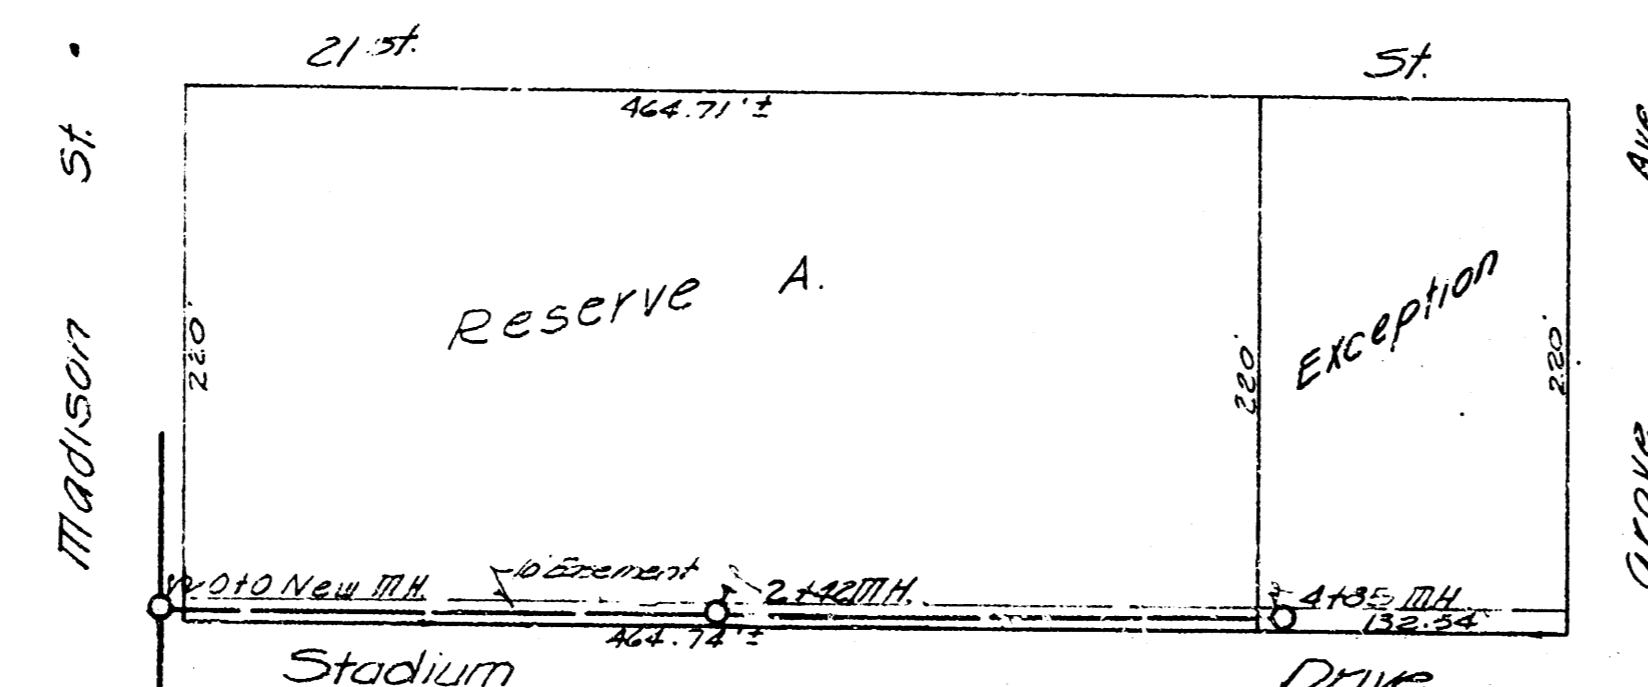


Lot 9, Dist. E, SS# 12


871 1214 N.E. Cor. Stage, Park, No. 2207 Stadium
871 'G' in Globe on lot 1214 Dr. # 2207 Stadium Eas. 1214, 22

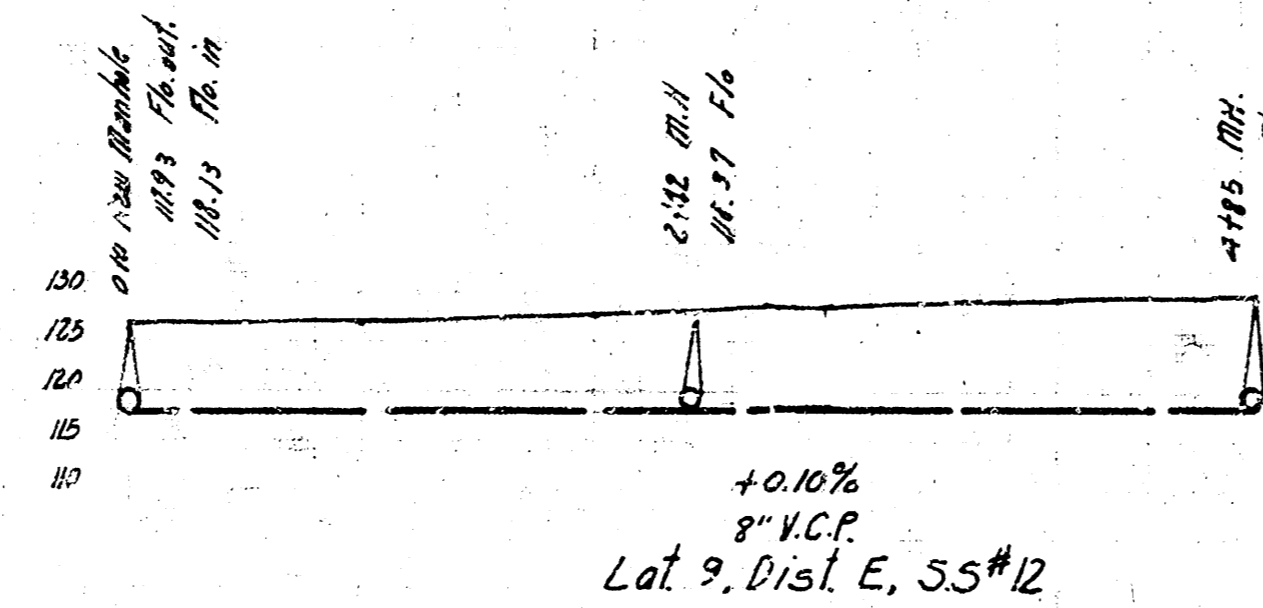

Lot 9, Dist. E, SS# 12

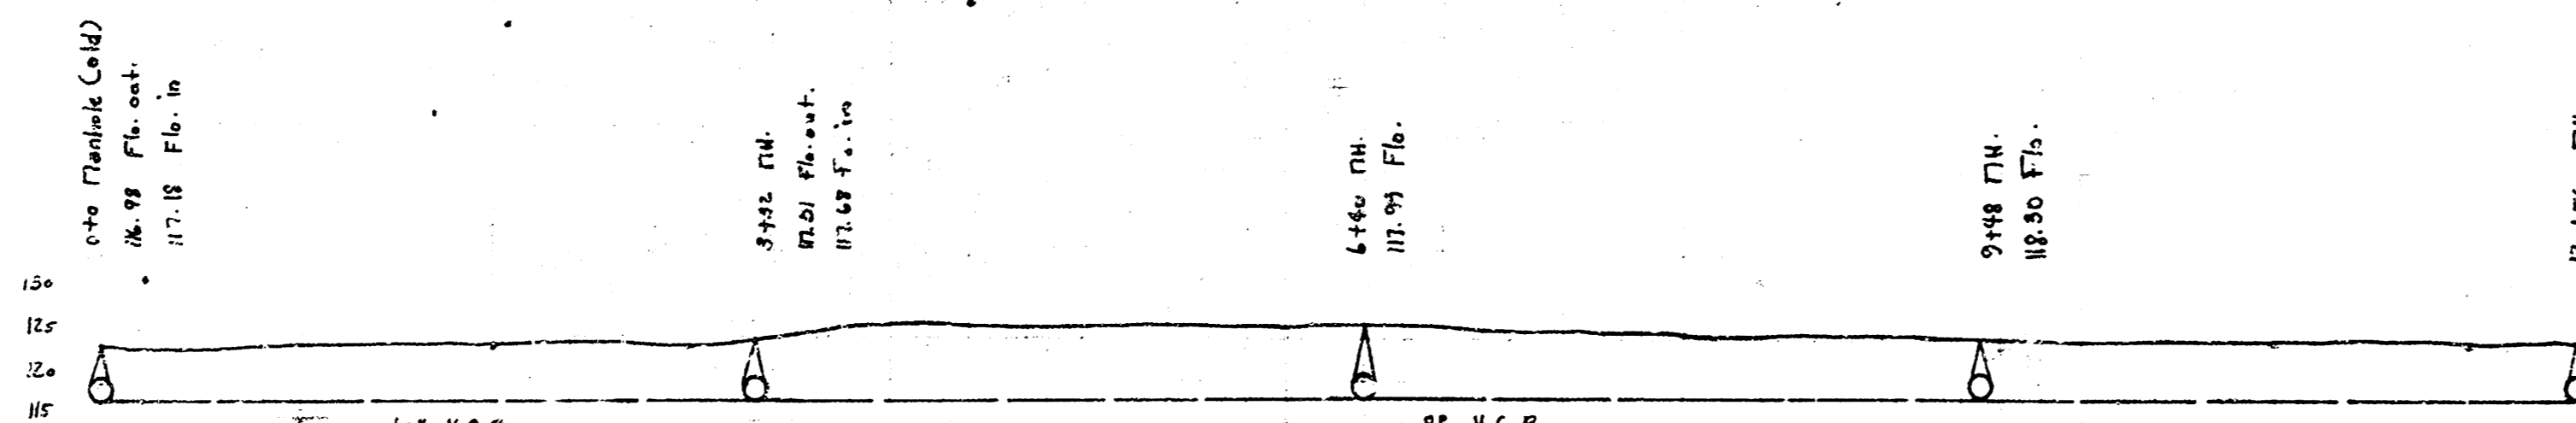


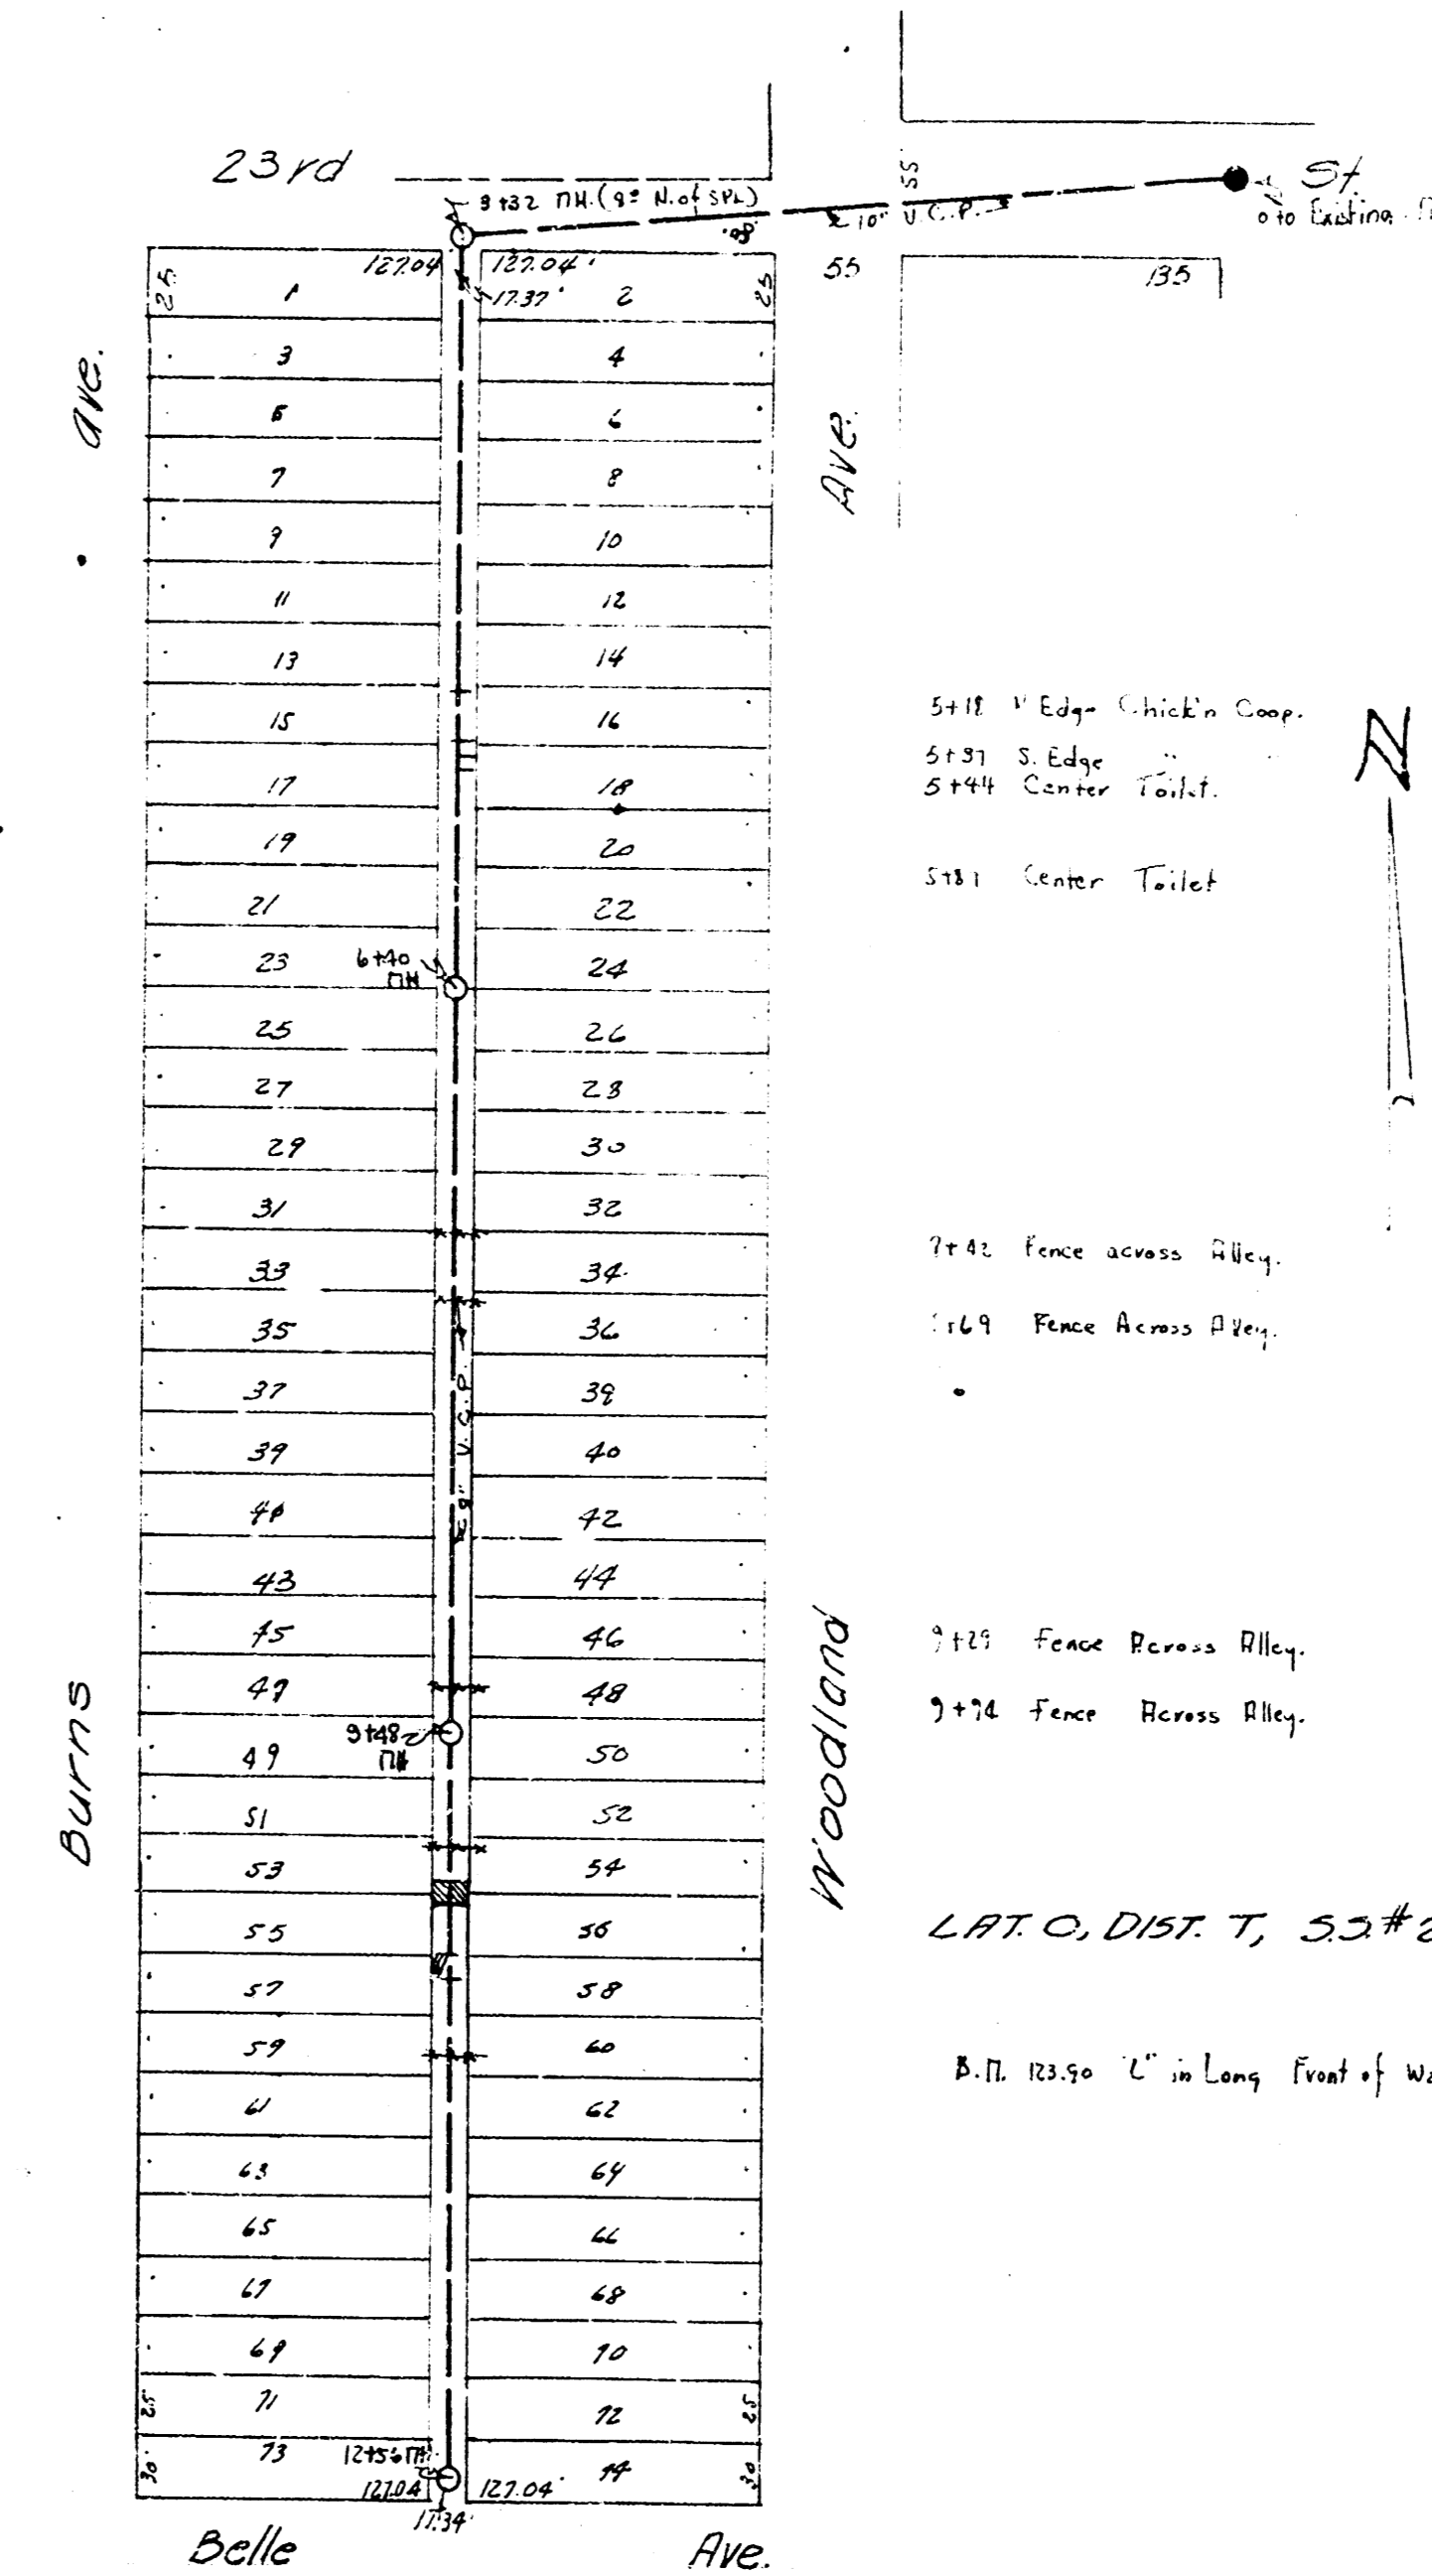




Lot 9, Dist. T, SS# 20

City of Wichita, Kansas
L. E. White City Engineer

177-1948

