



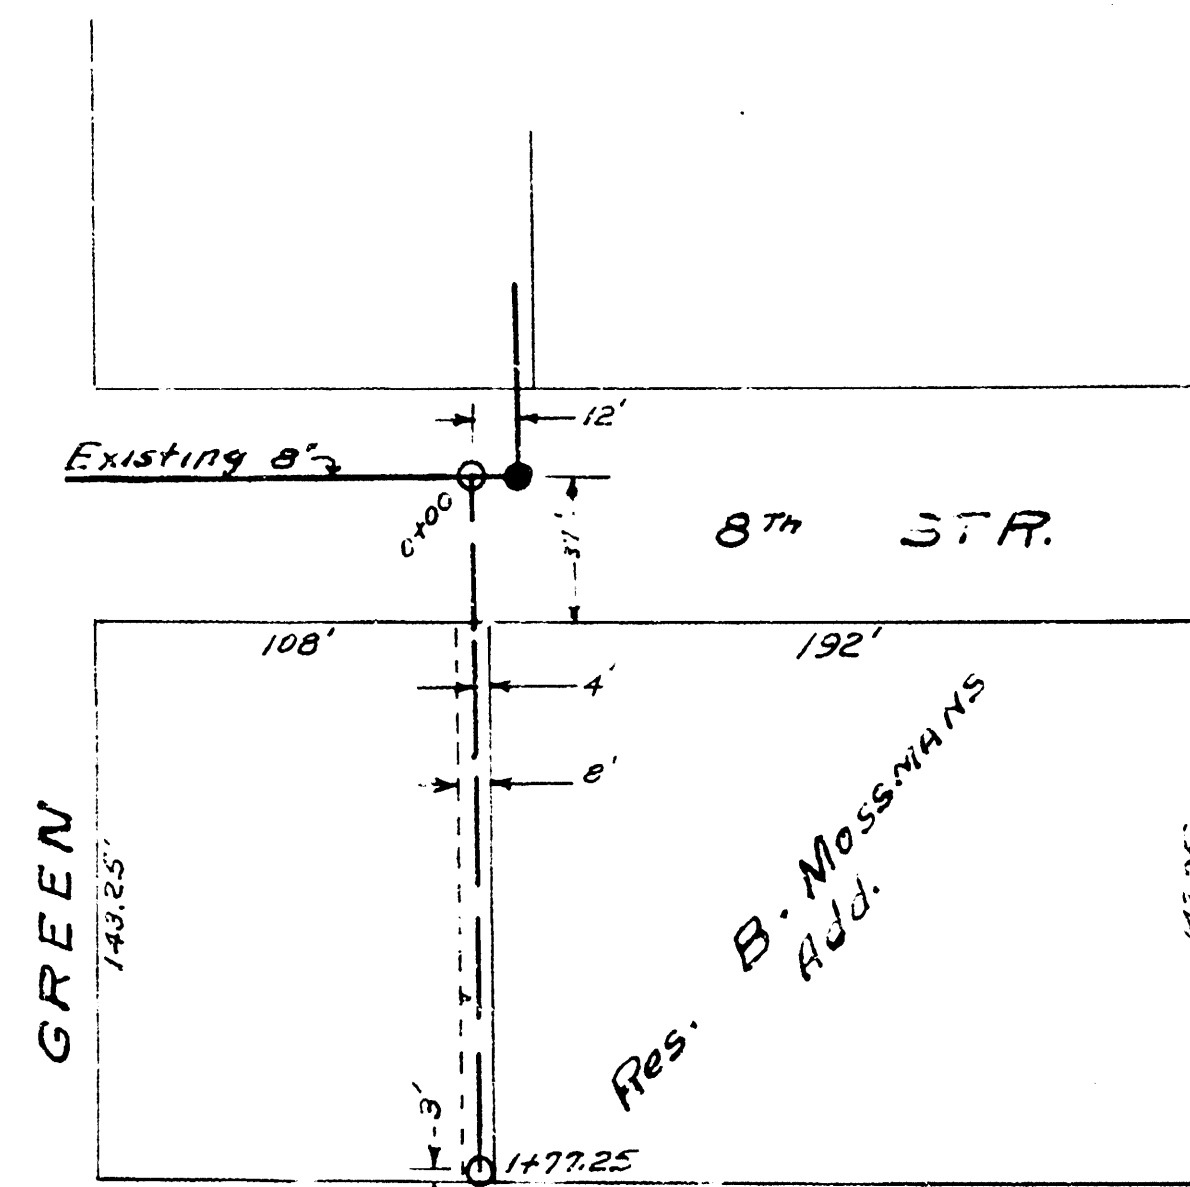

Scale: 1"=50'


NOTE: Sand fill from Sta 0+00 to Sta 0+25

BM 123.48 NE Cor. Conc. wh. @ NE Cor. Ho. SW. 8th & Grove.

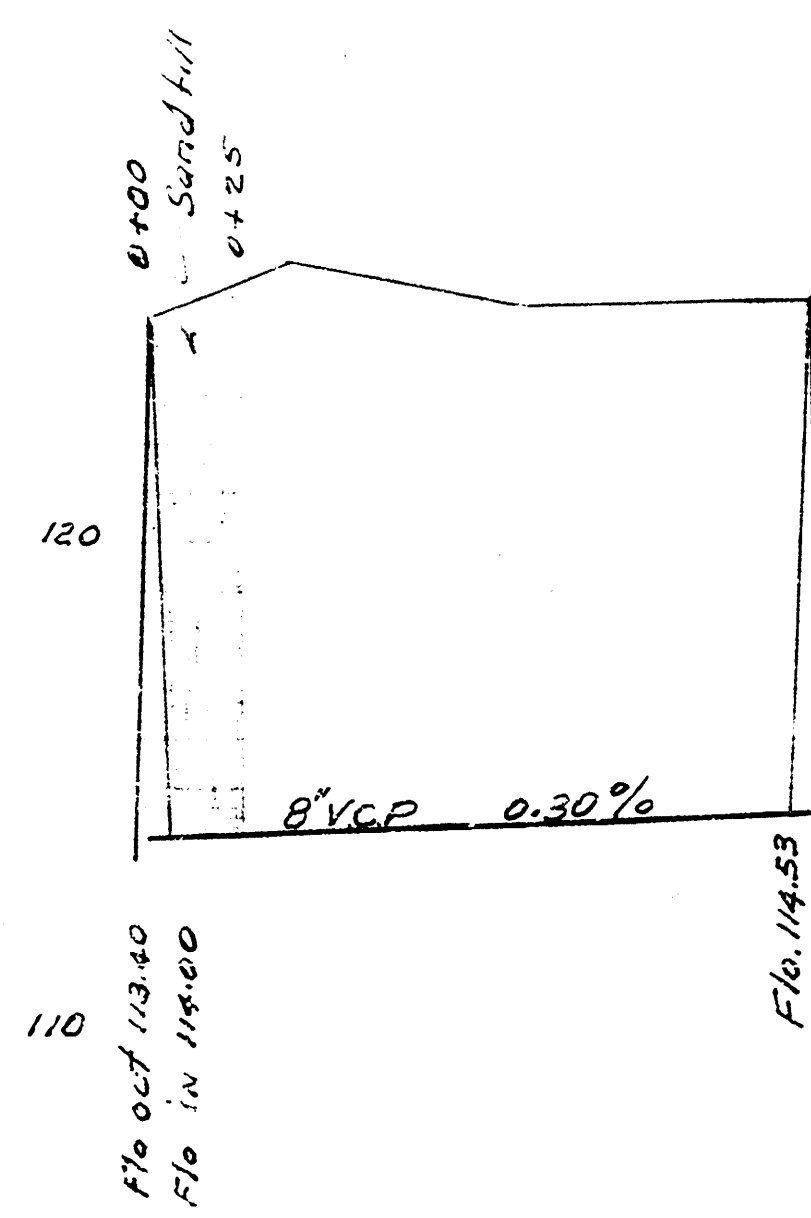


Scale: 1"=50' Horiz. 1"=4' Vert.

LAT. 22 DIST. E. MAIN 12
CITY OF WICHITA KANSAS
L.K. WHITE CITY ENGINEER
Proj. No. C-21-21
REVISED: 1-25-52

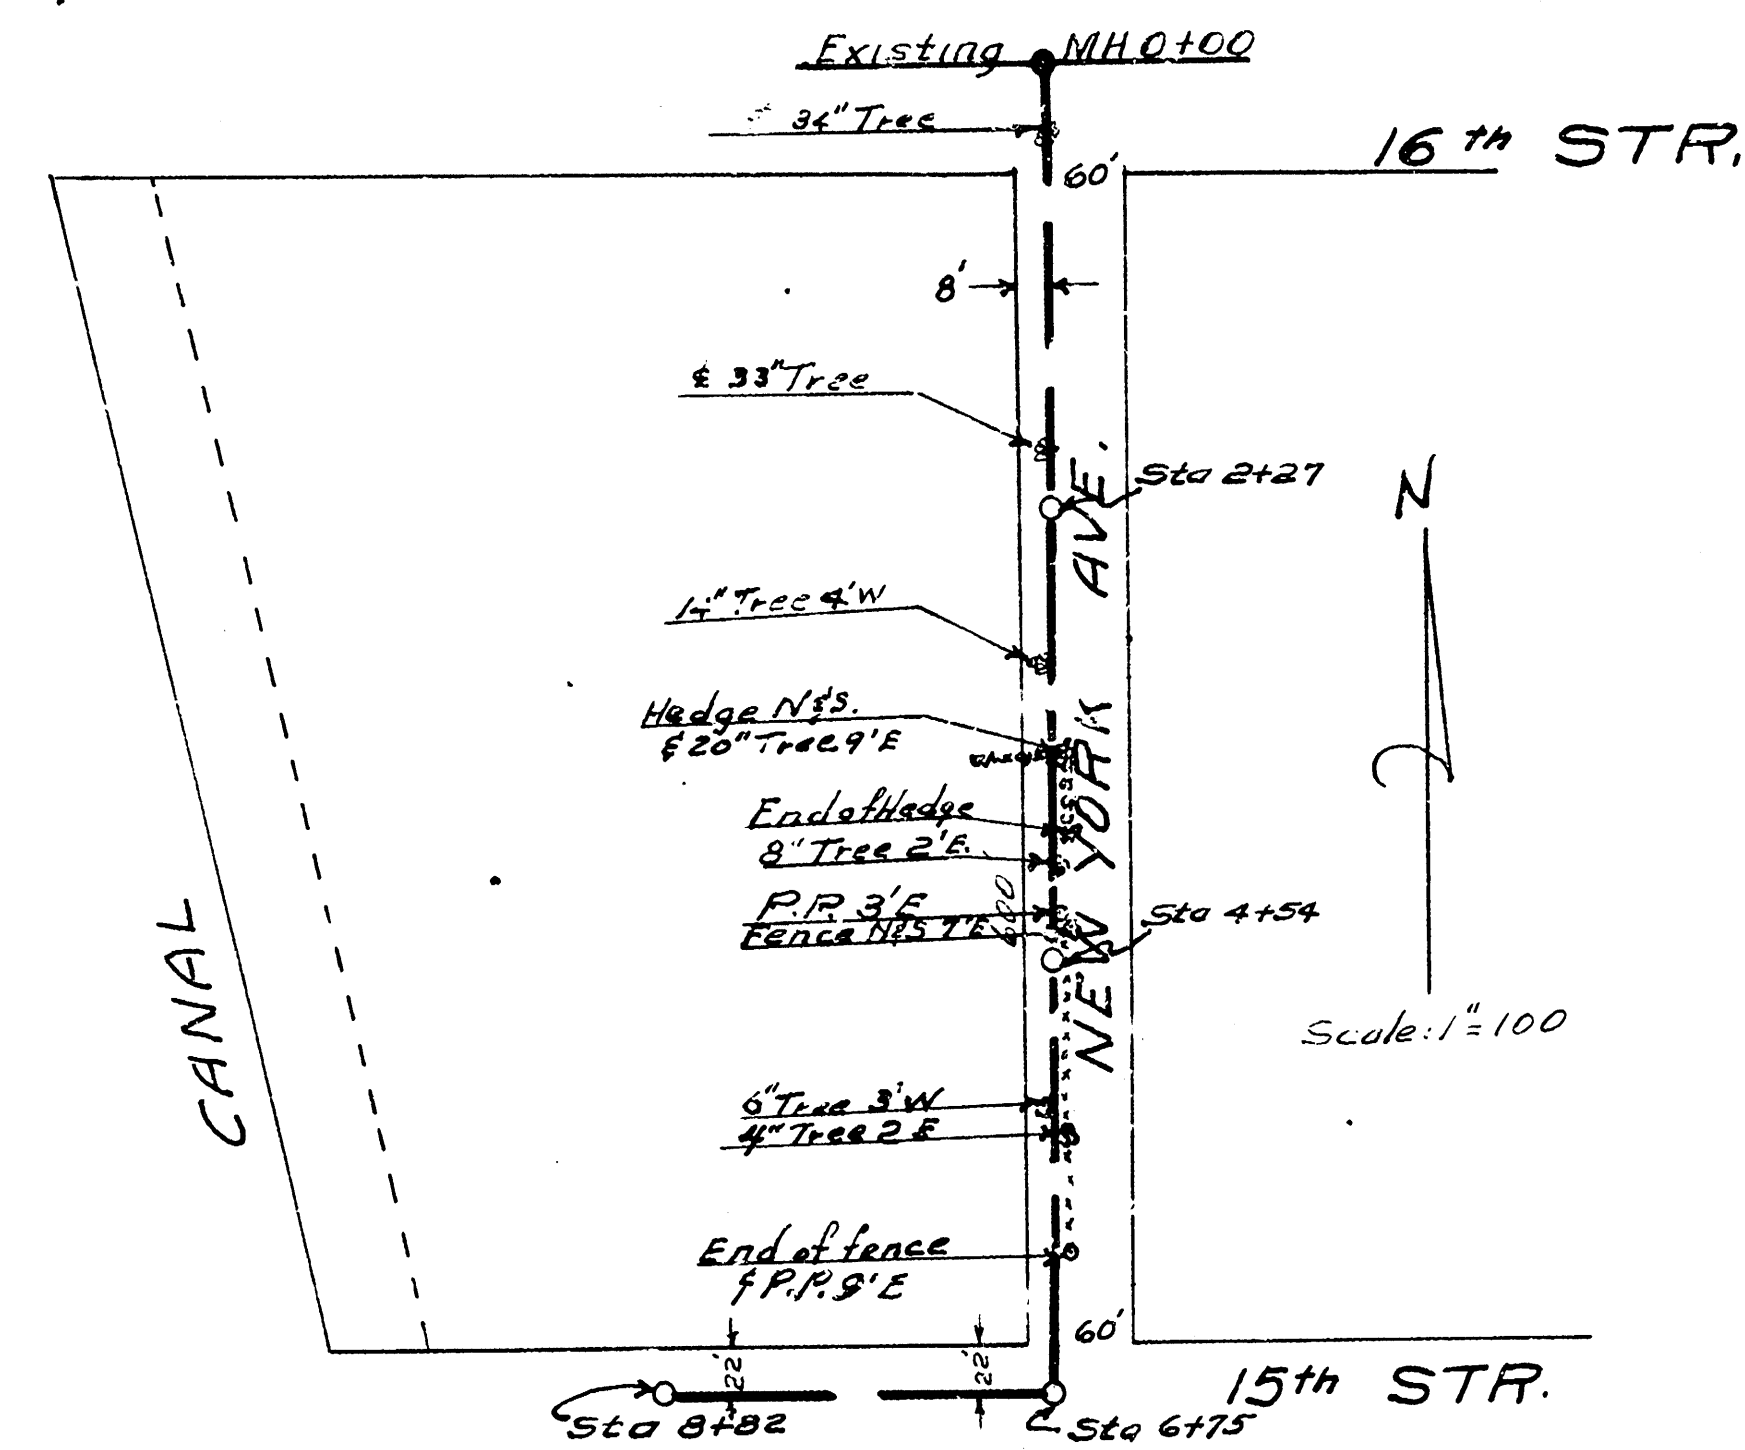

Scale: 1"=100'

BM 116.91 No Rim of Thimble 16th & Hydraulic

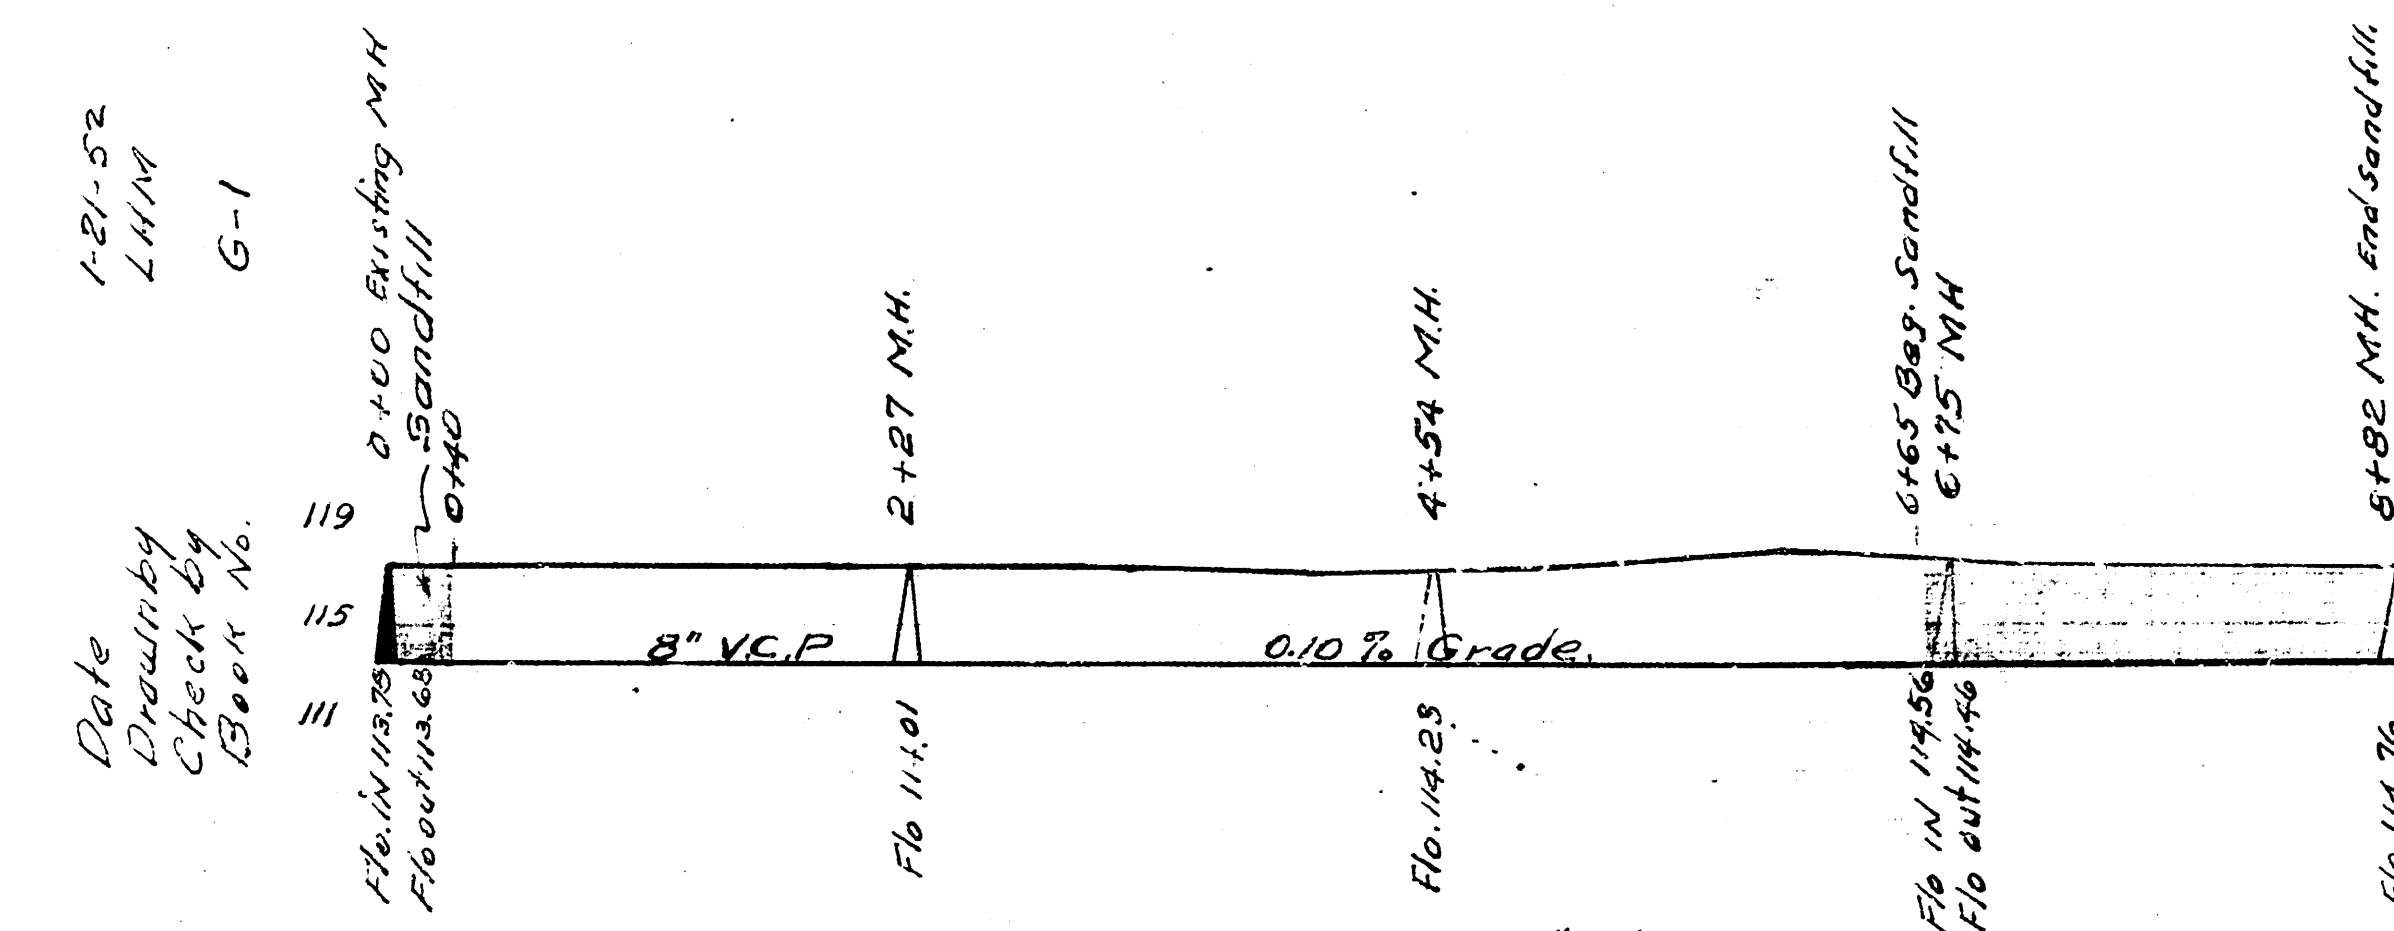

Scale: 1"=8' Vert. 1"=80' Horiz.

LAT. 1 DIST. Y 55#12
CITY OF WICHITA KANSAS
L.K. WHITE CITY ENGINEER
Proj. No. C-20-22

Date: 1-8-52
Drawn by: L.H.M.
Checked by: C.M.T.
Spec. No.

Date: 1-21-52
Drawn by: L.H.M.
Checked by: G-1
Spec. No.