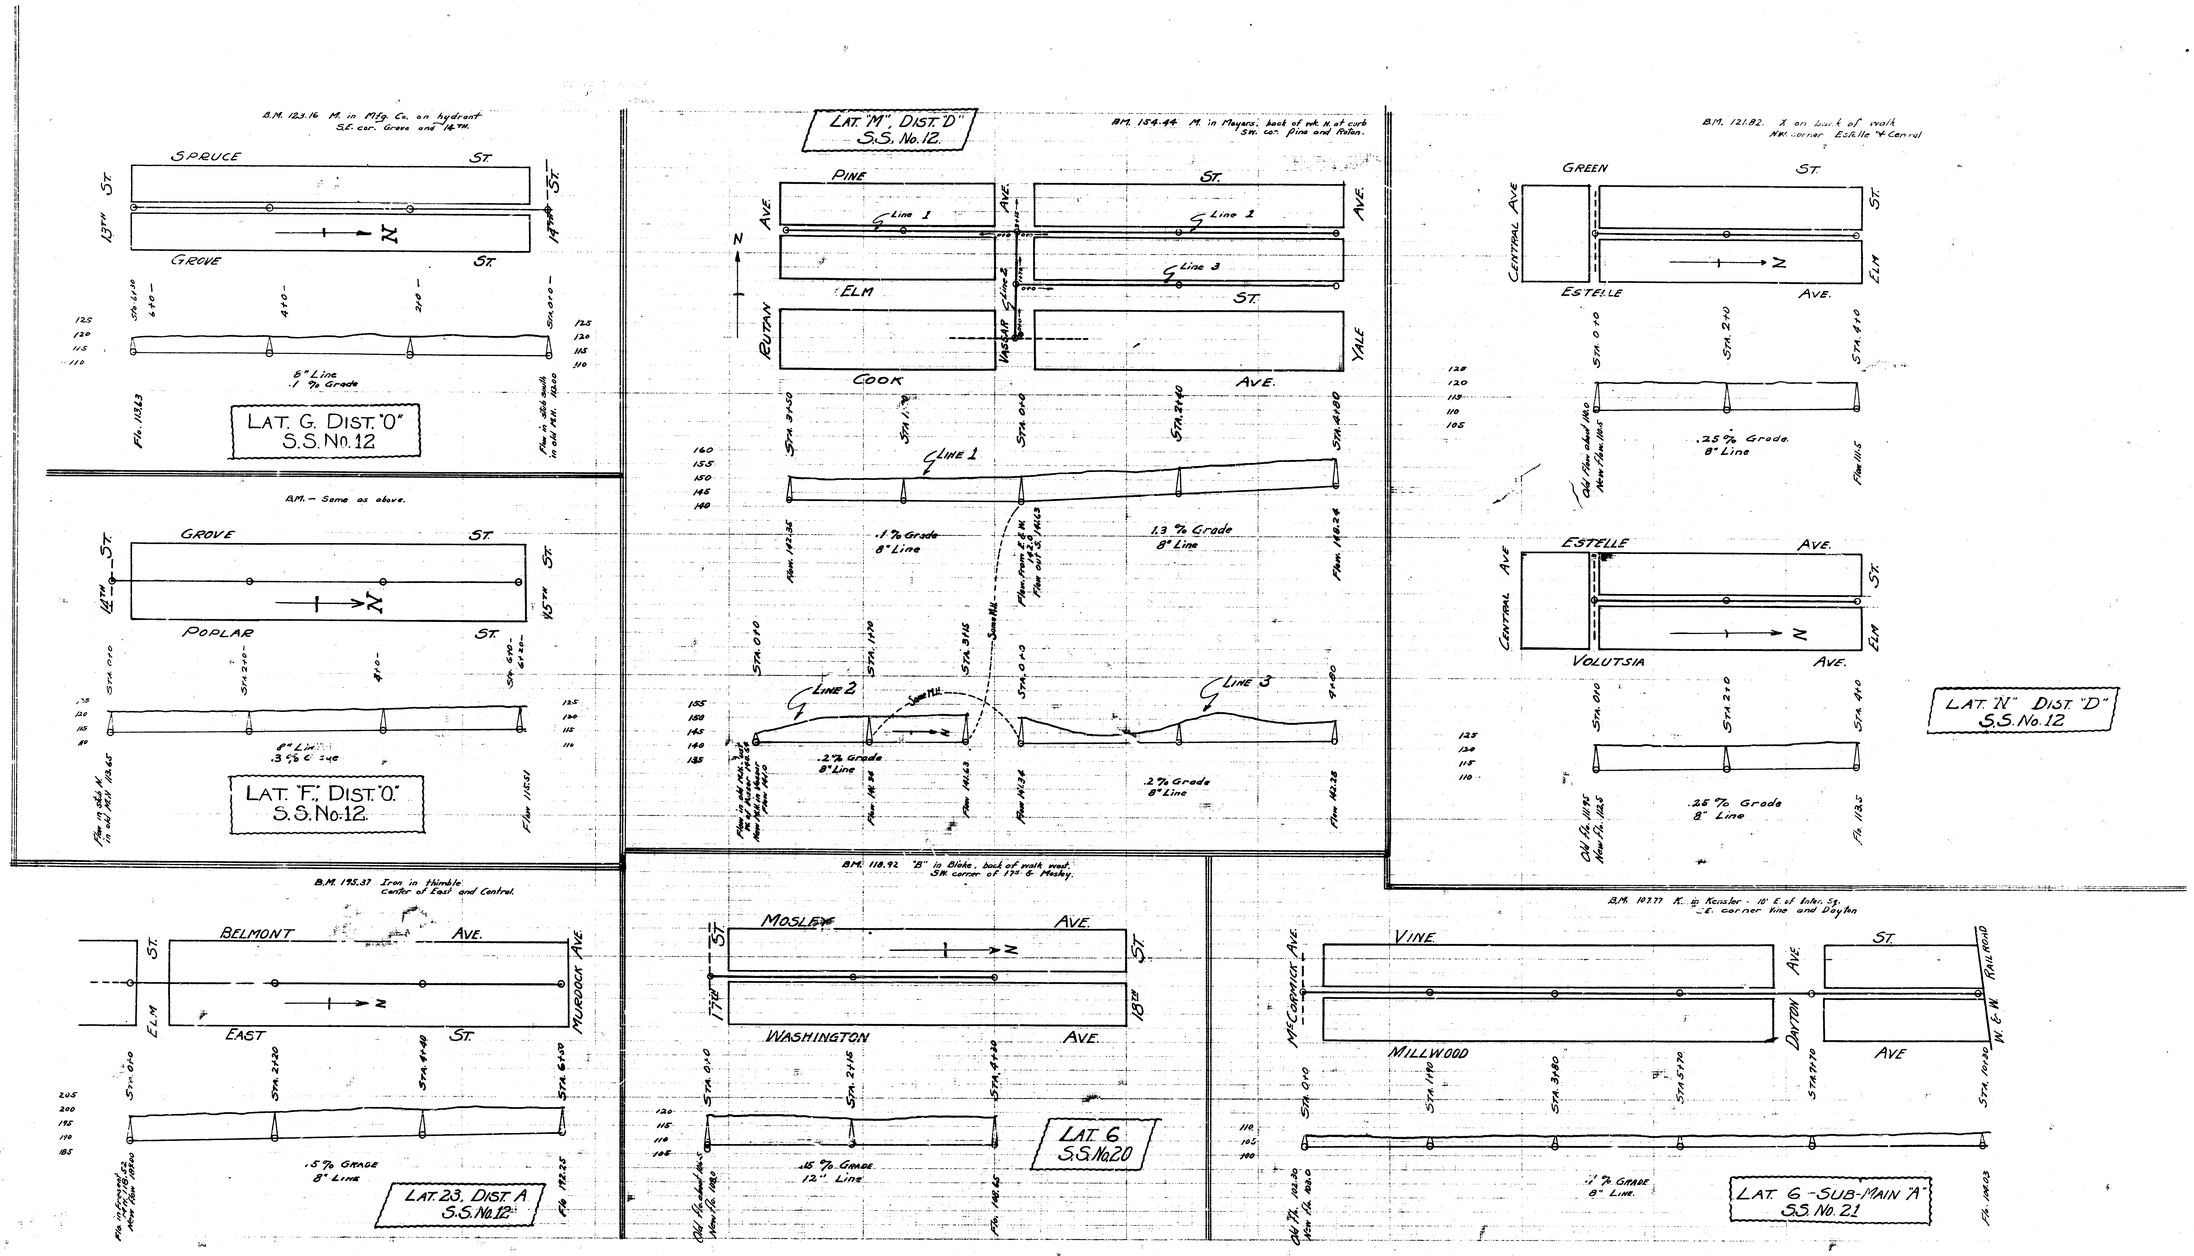
B.M. 123.16 M. in Mfg. Co. on hydrant S.E. cor. Grove and 14th.
SPRUCE ST.
13TH ST.
14TH ST.
GROVE ST.
N
8" Line
.1 % Grade
Flow 113.23
LAT. G. DIST. "O"
S.S. No. 12
B.M. – Same as above.
GROVE ST.
14TH ST.
15TH ST.
POPLAR ST.
8" Line
.3 % Grade
Flow 115.51
LAT. "F." DIST. "O."
S.S. No. 12.
LAT. "M", DIST. "D"
S.S. No. 12.
B.M. 154.44 M. in Playerc, back of wk. N. of curb S.W. cor. Pine and Relan.
PINE ST.
AVE.
Line 1
Line 2
Line 3
ELM ST.
RUTAN
YALE
COOK AVE.
VAGHAR
LINE 1
.1 % Grade
8" Line
1.3 % Grade
8" Line
LINE 2
.2 % Grade
8" Line
LINE 3
.2 % Grade
8" Line
B.M. 121.82 X on back of walk NW. corner Estelle & Central
GREEN ST.
CENTRAL AVE
ESTELLE AVE.
ELM ST.
.25 % Grade.
8" Line
ESTELLE AVE.
VOLUTSIA AVE.
.25 % Grade
8" Line
LAT. "N" DIST. "D"
S.S. No. 12
B.M. 195.37 Iron in thimble center of East and Central.
BELMONT AVE.
MURDOCK AVE.
ELM ST.
EAST ST.
.5 % GRADE
8" Line
LAT. 23. DIST. A
S.S. No. 12.
B.M. 118.92 "B" in Blake, back of walk west S.W. corner of 17th & Mosby.
MOSLEY AVE.
17TH ST.
18TH ST.
WASHINGTON AVE.
.15 % GRADE
12" Line
LAT. 6
S.S. No. 20
B.M. 107.77 K. in Keasler - 10' E. of Inter. Sq. S.E. corner Vine and Dayton
VINE AVE.
McCORMICK AVE.
DAYTON AVE
MILLWOOD AVE
W. & W. RAILROAD
.1 % GRADE
8" Line.
LAT. 6 - SUB-MAIN "A"
S.S. No. 21