

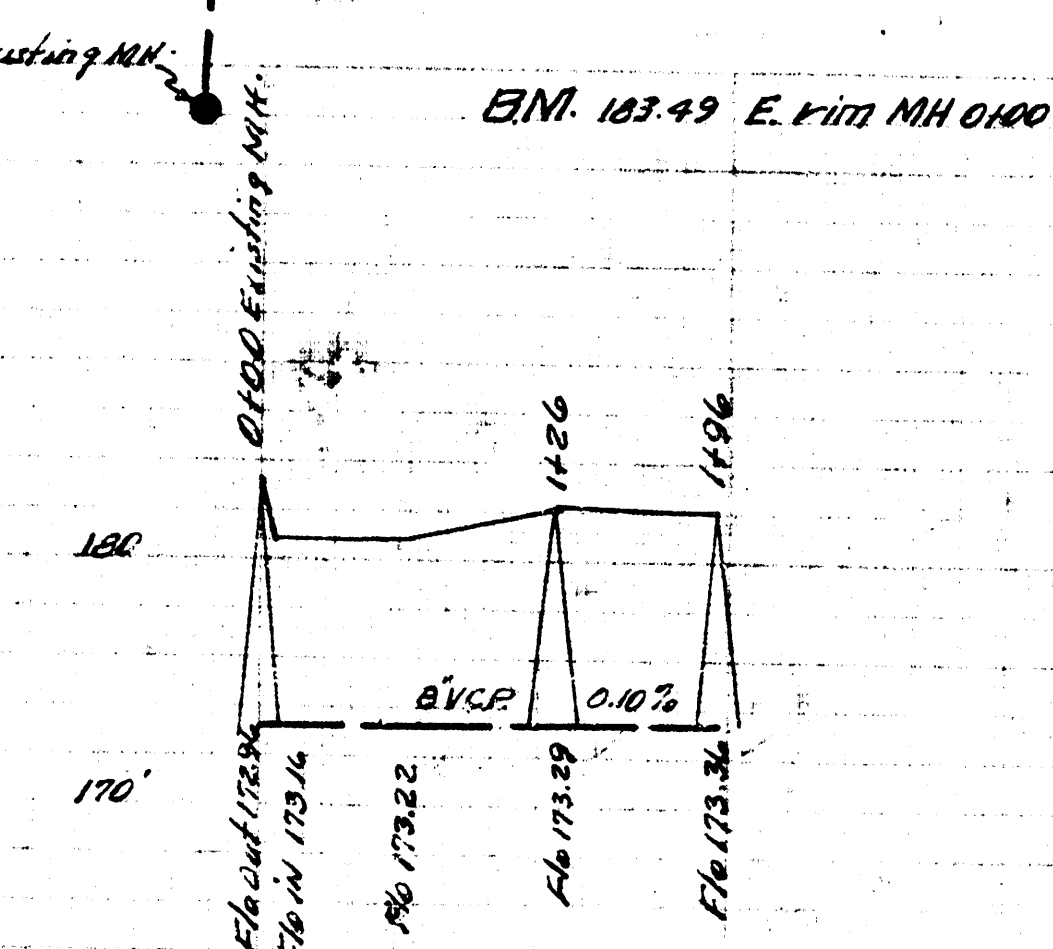
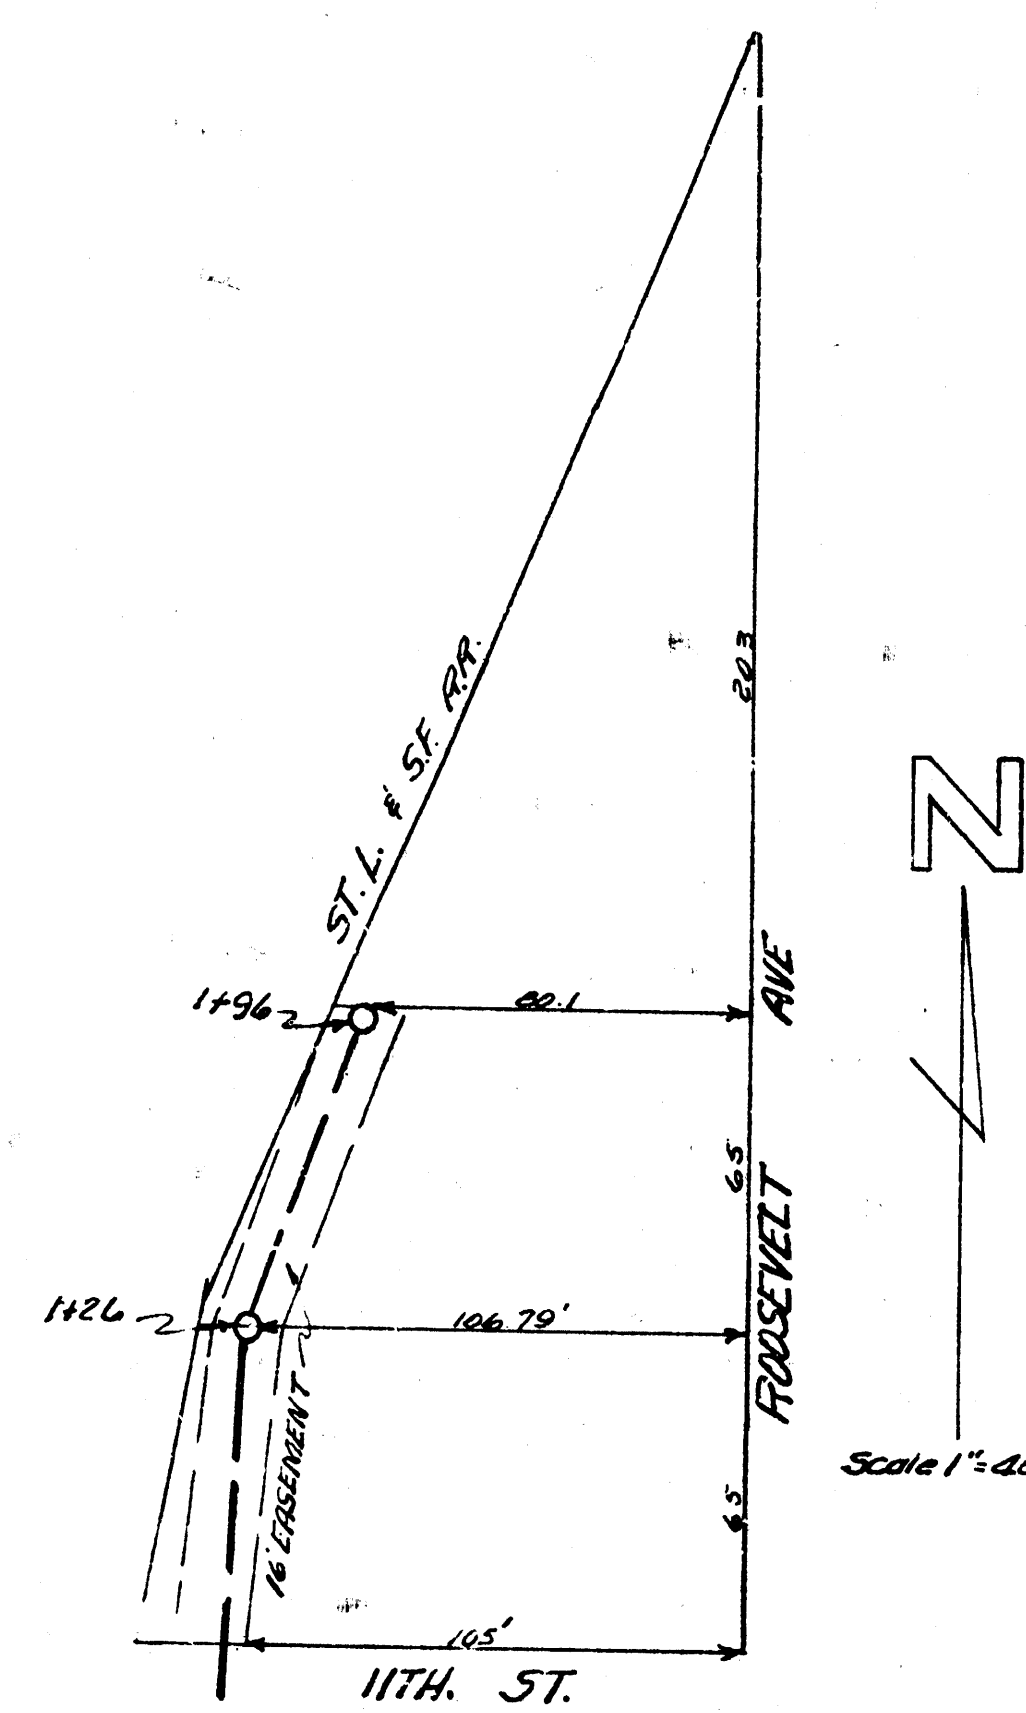


2-2-93
 Drawn by
 Checked by
 G.S.

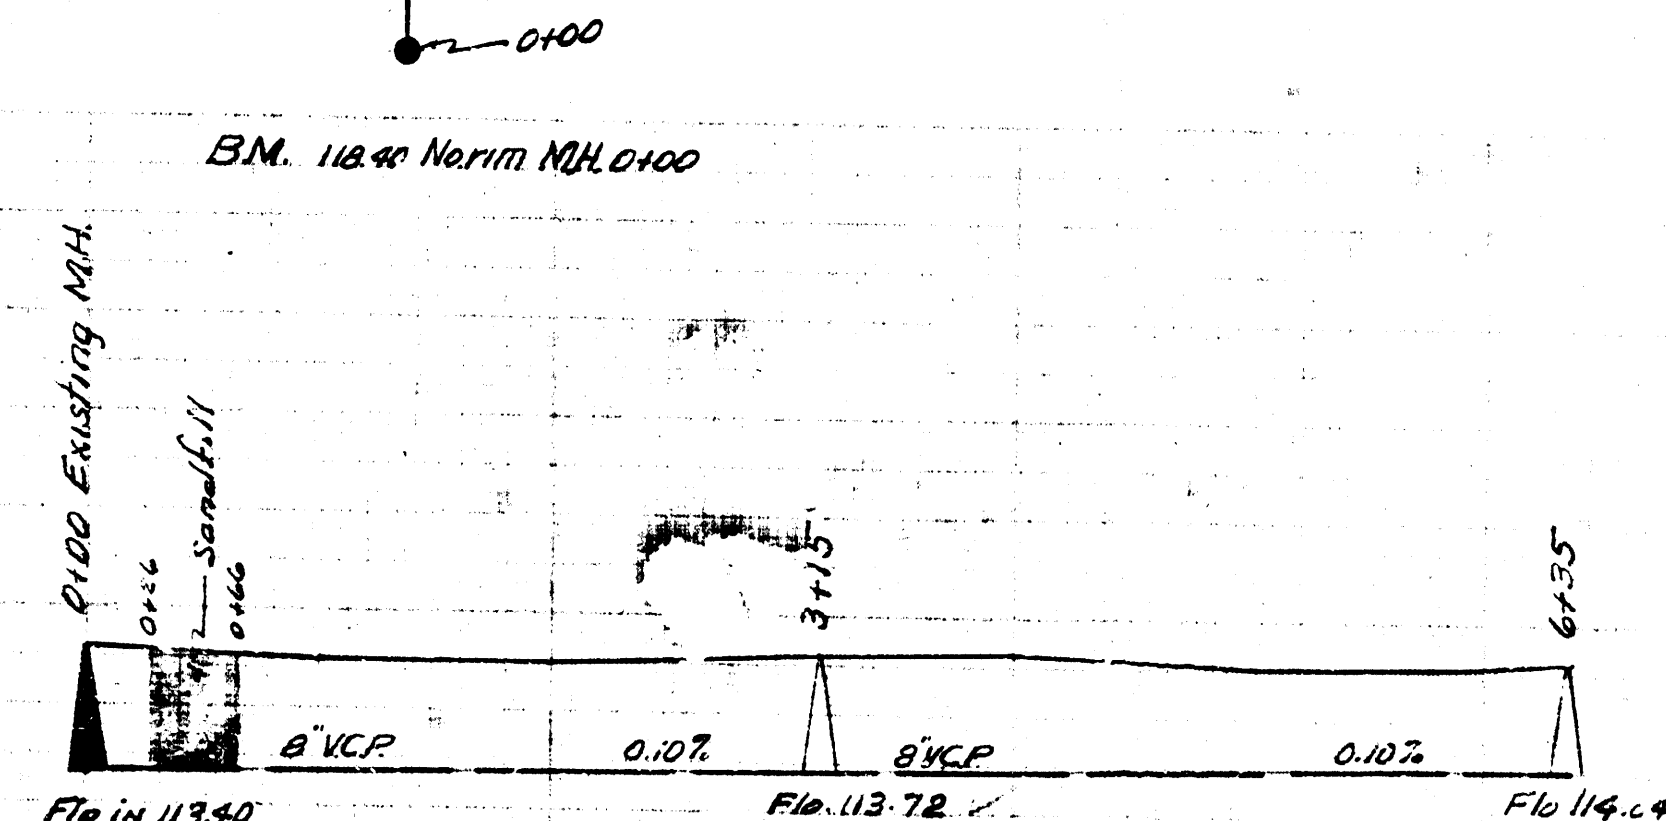

LAT. 14 DIST. 0 SS. 12
 CITY OF WICHITA KANSAS
 B.E. SMITH CITY ENGINEER
 Proj. No. C-22-94

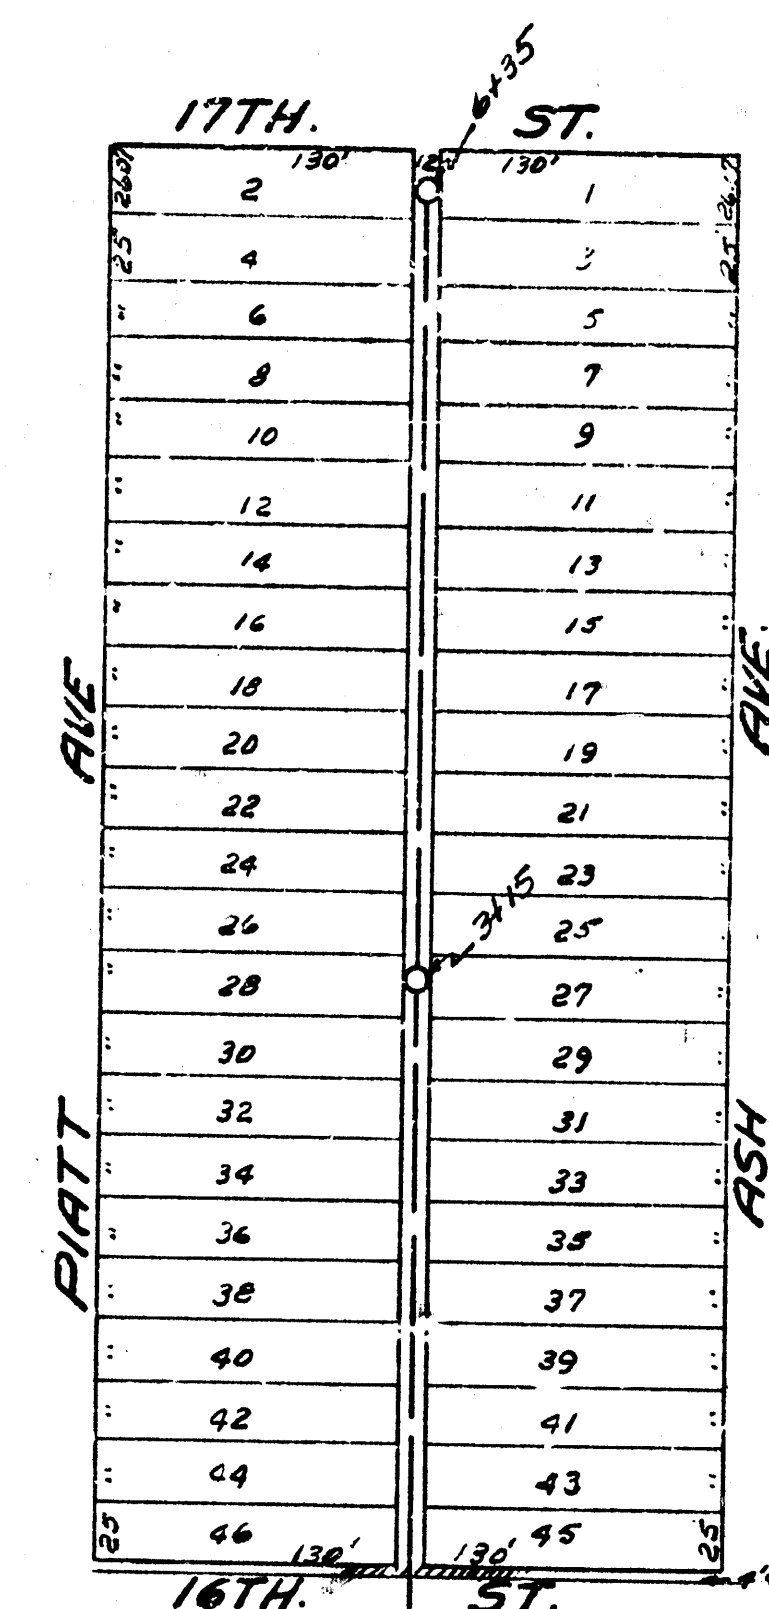

LAT. 14 DIST. 0 SS. 12
 CITY OF WICHITA KANSAS
 B.E. SMITH CITY ENGINEER
 Proj. No. C-23-6

