

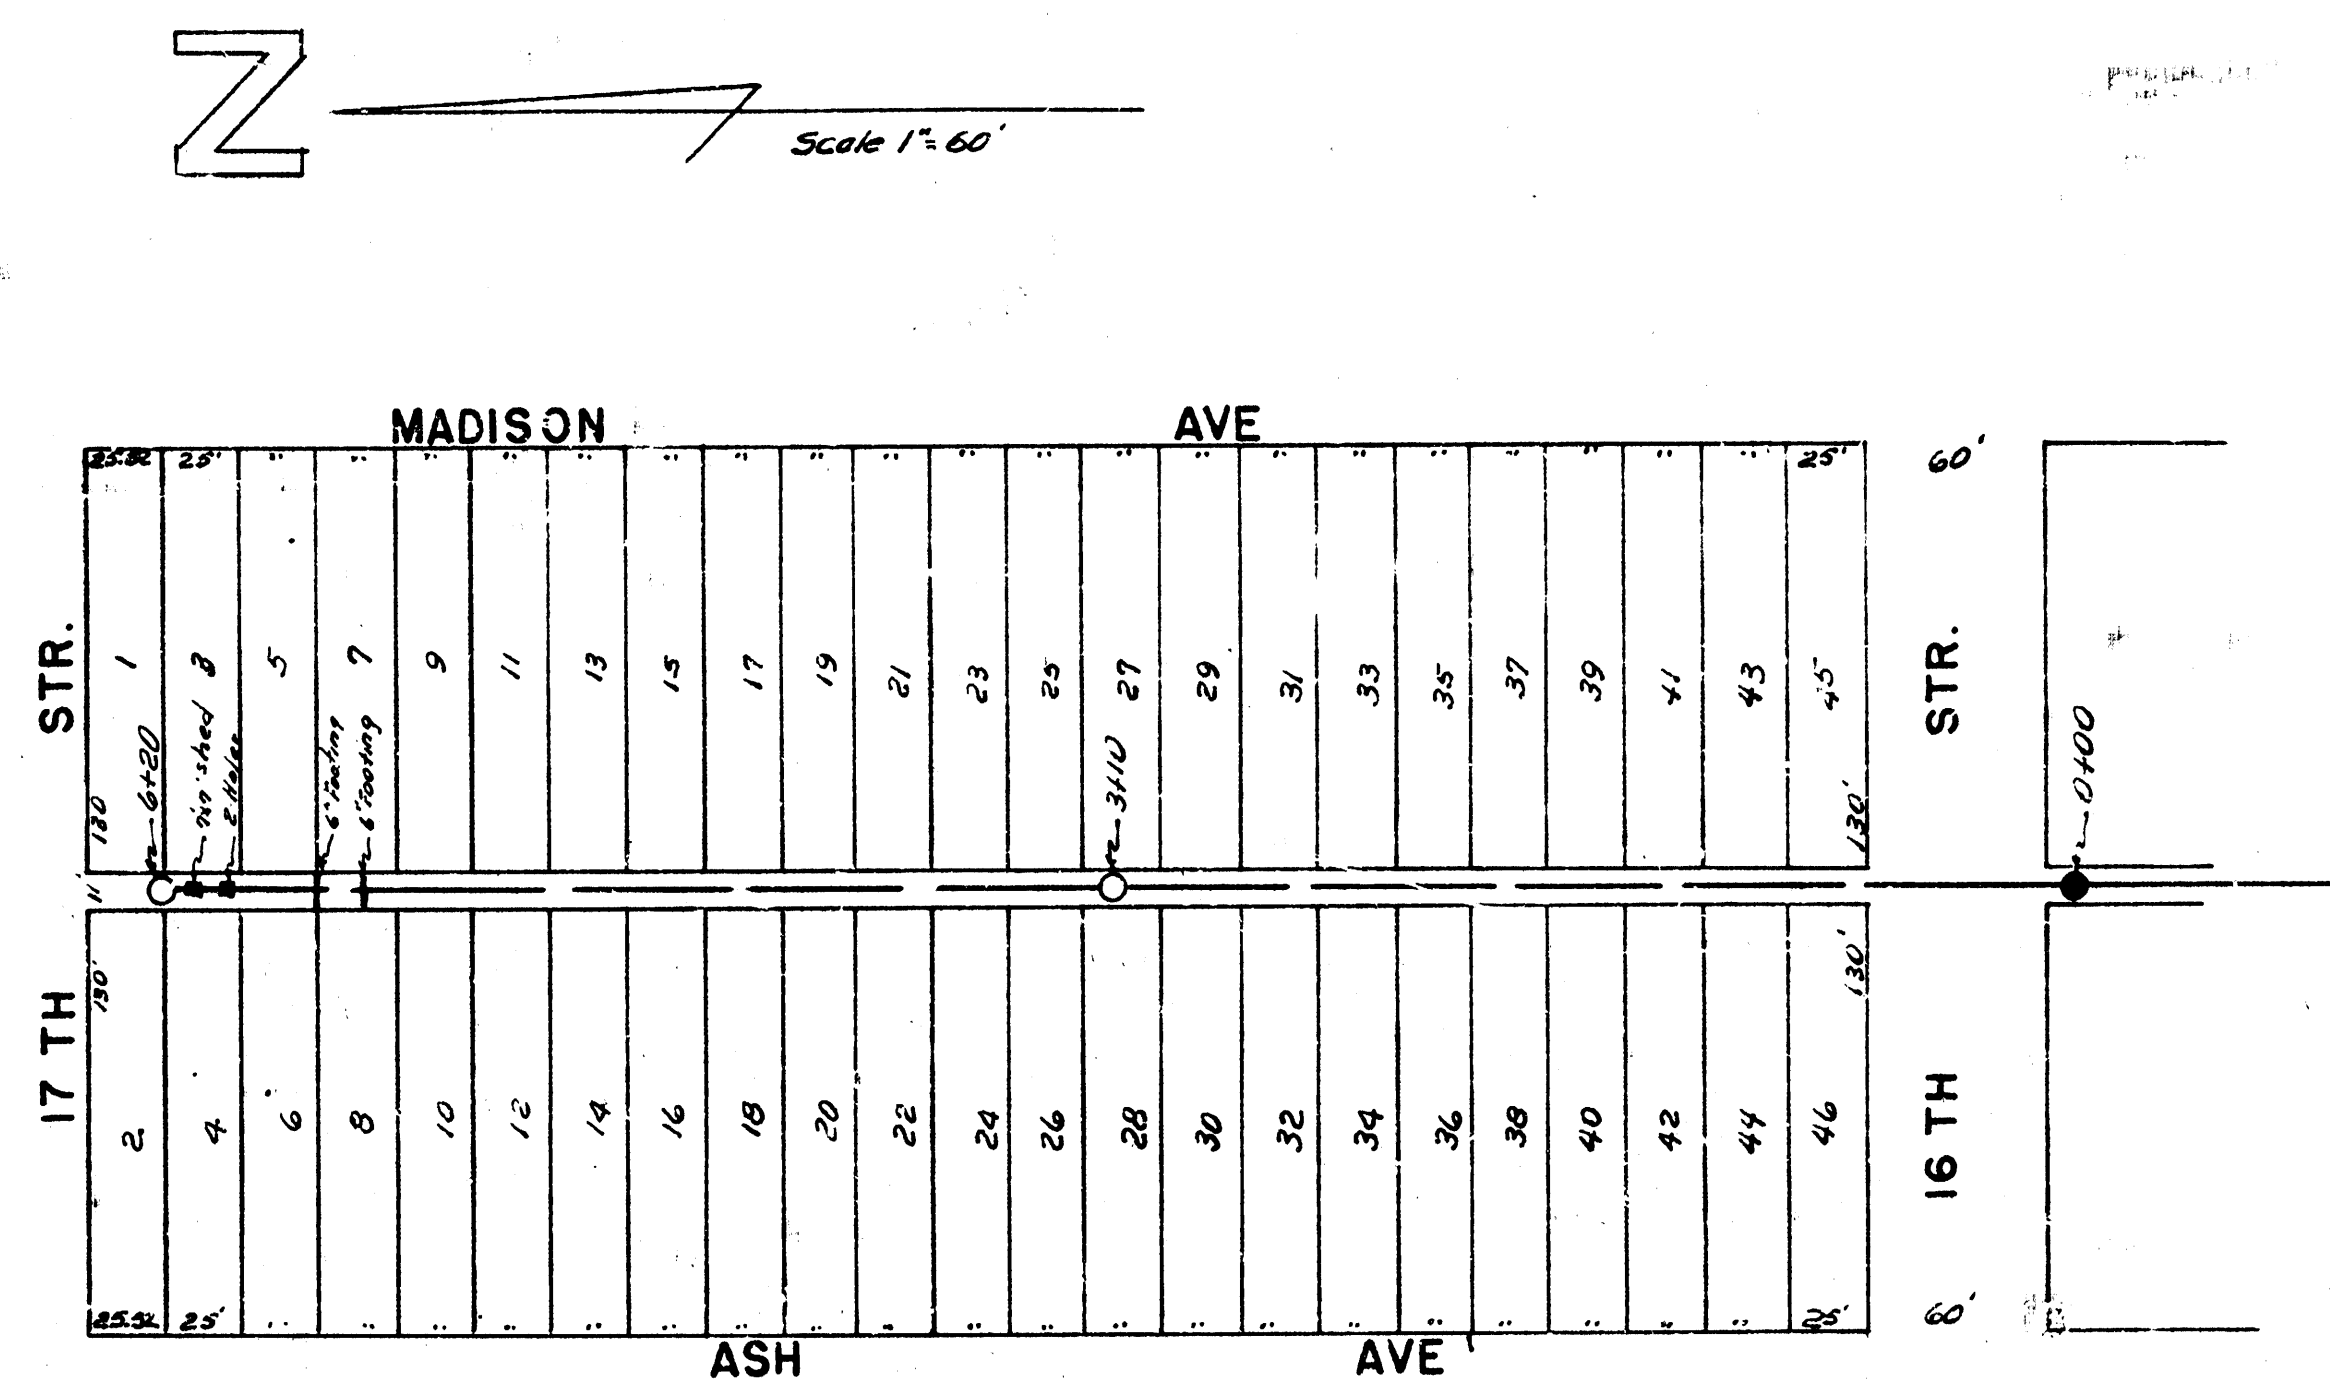
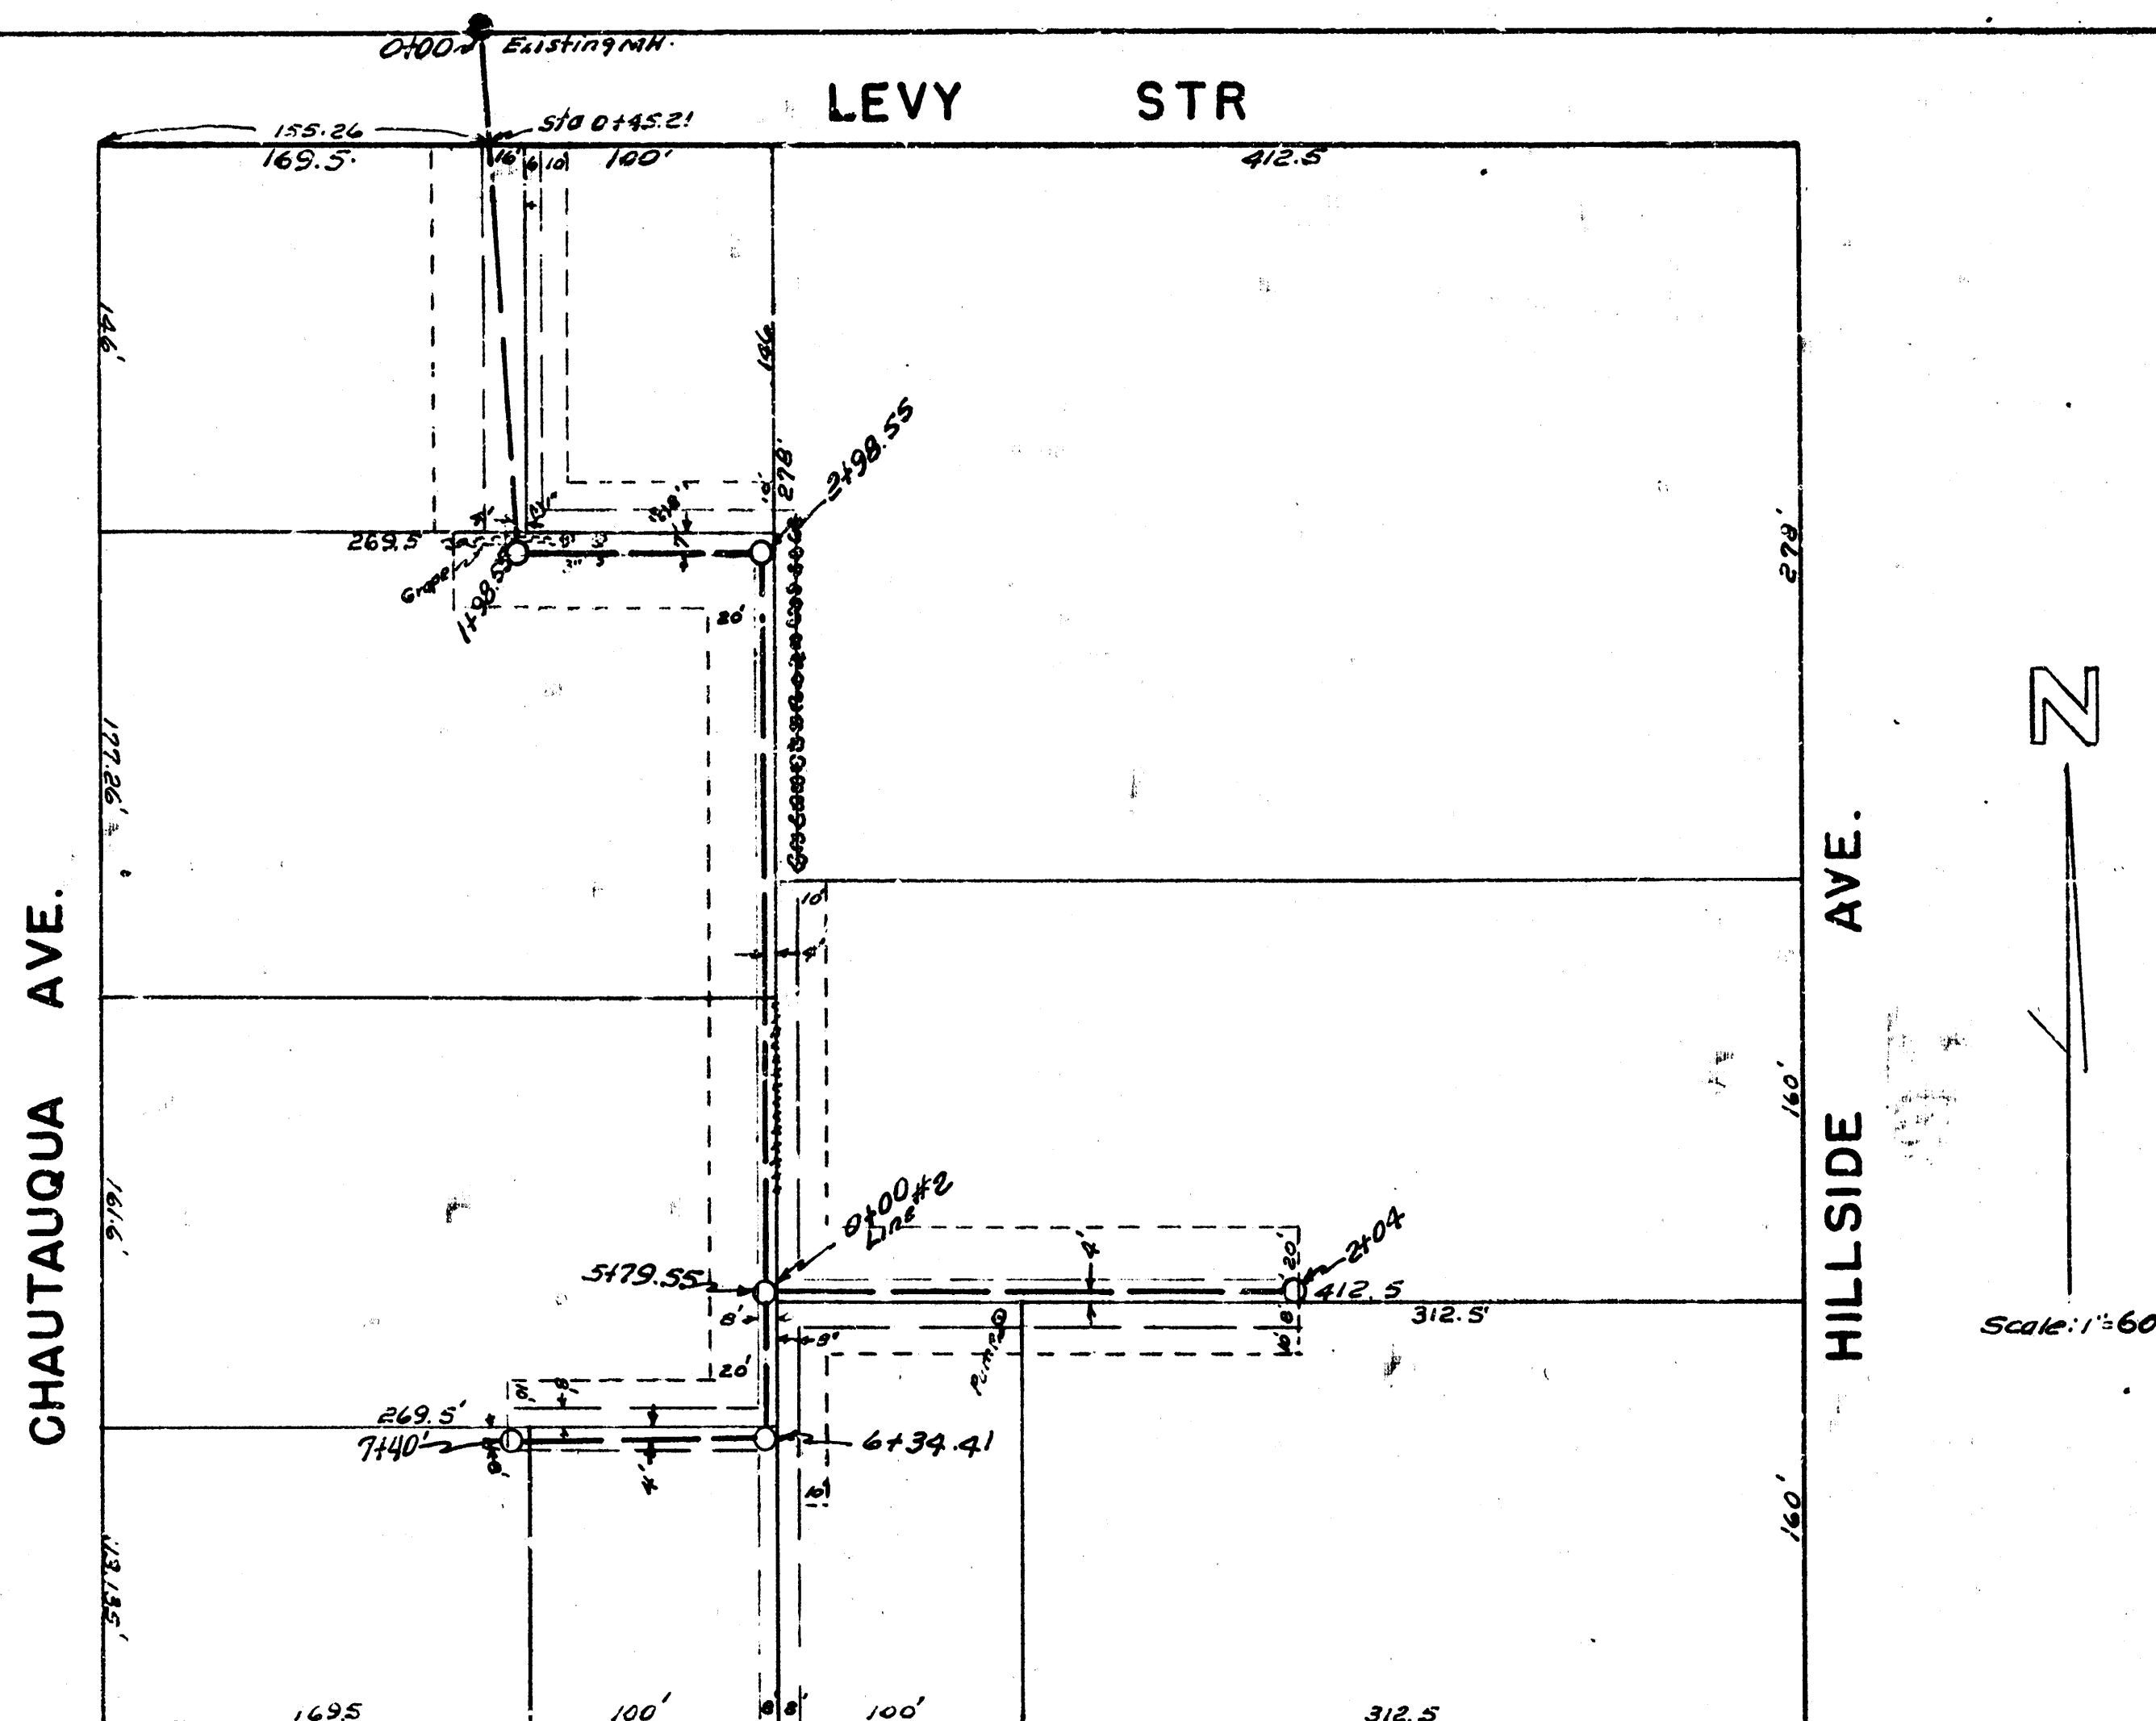


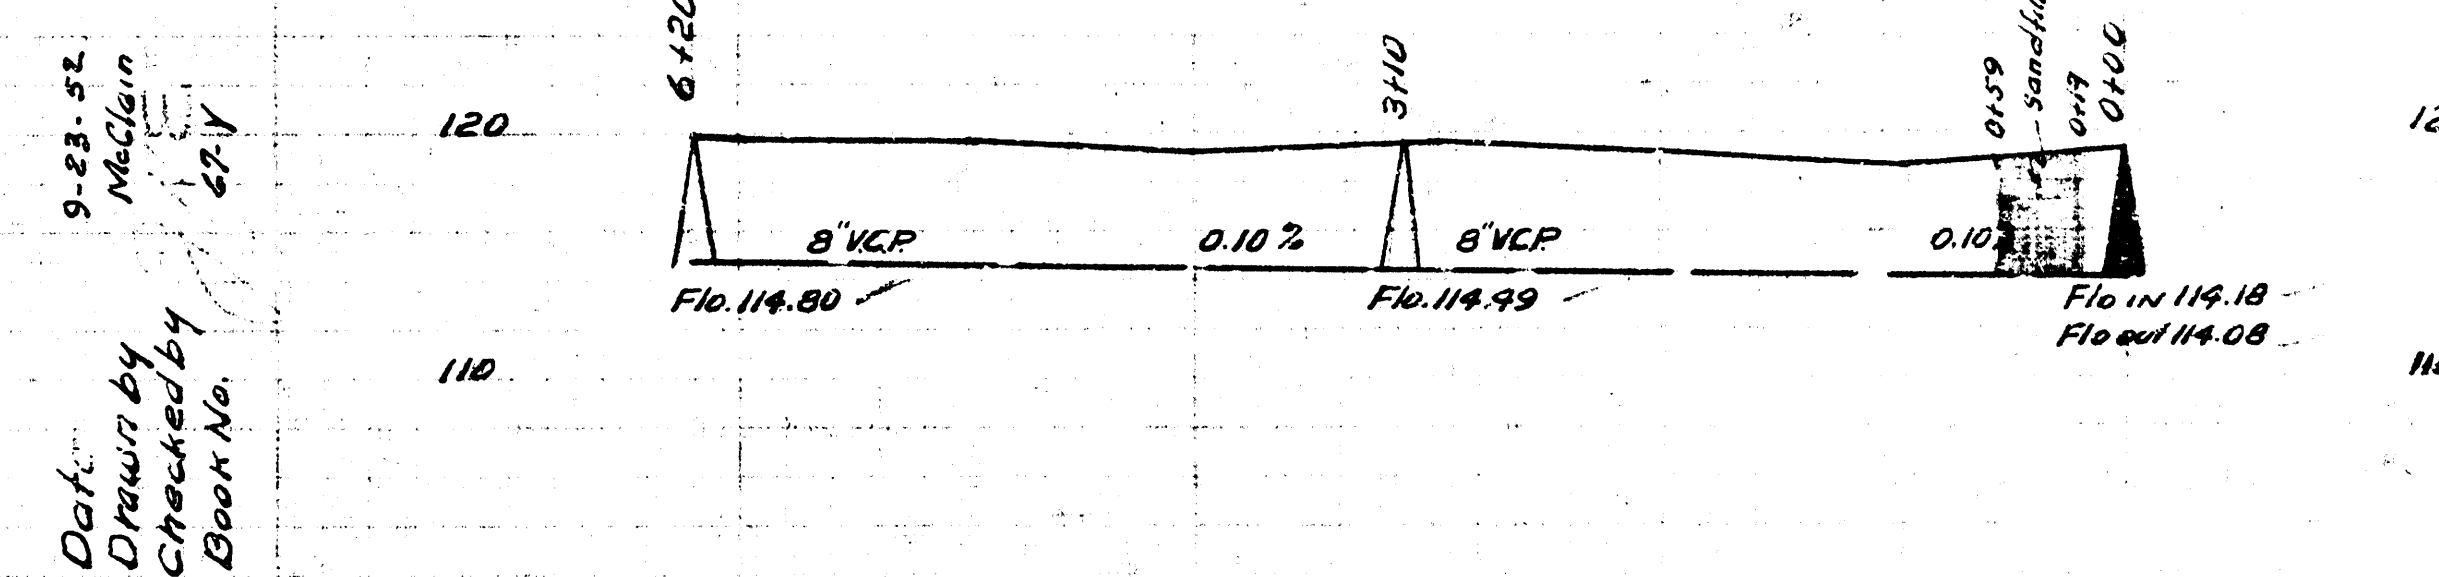


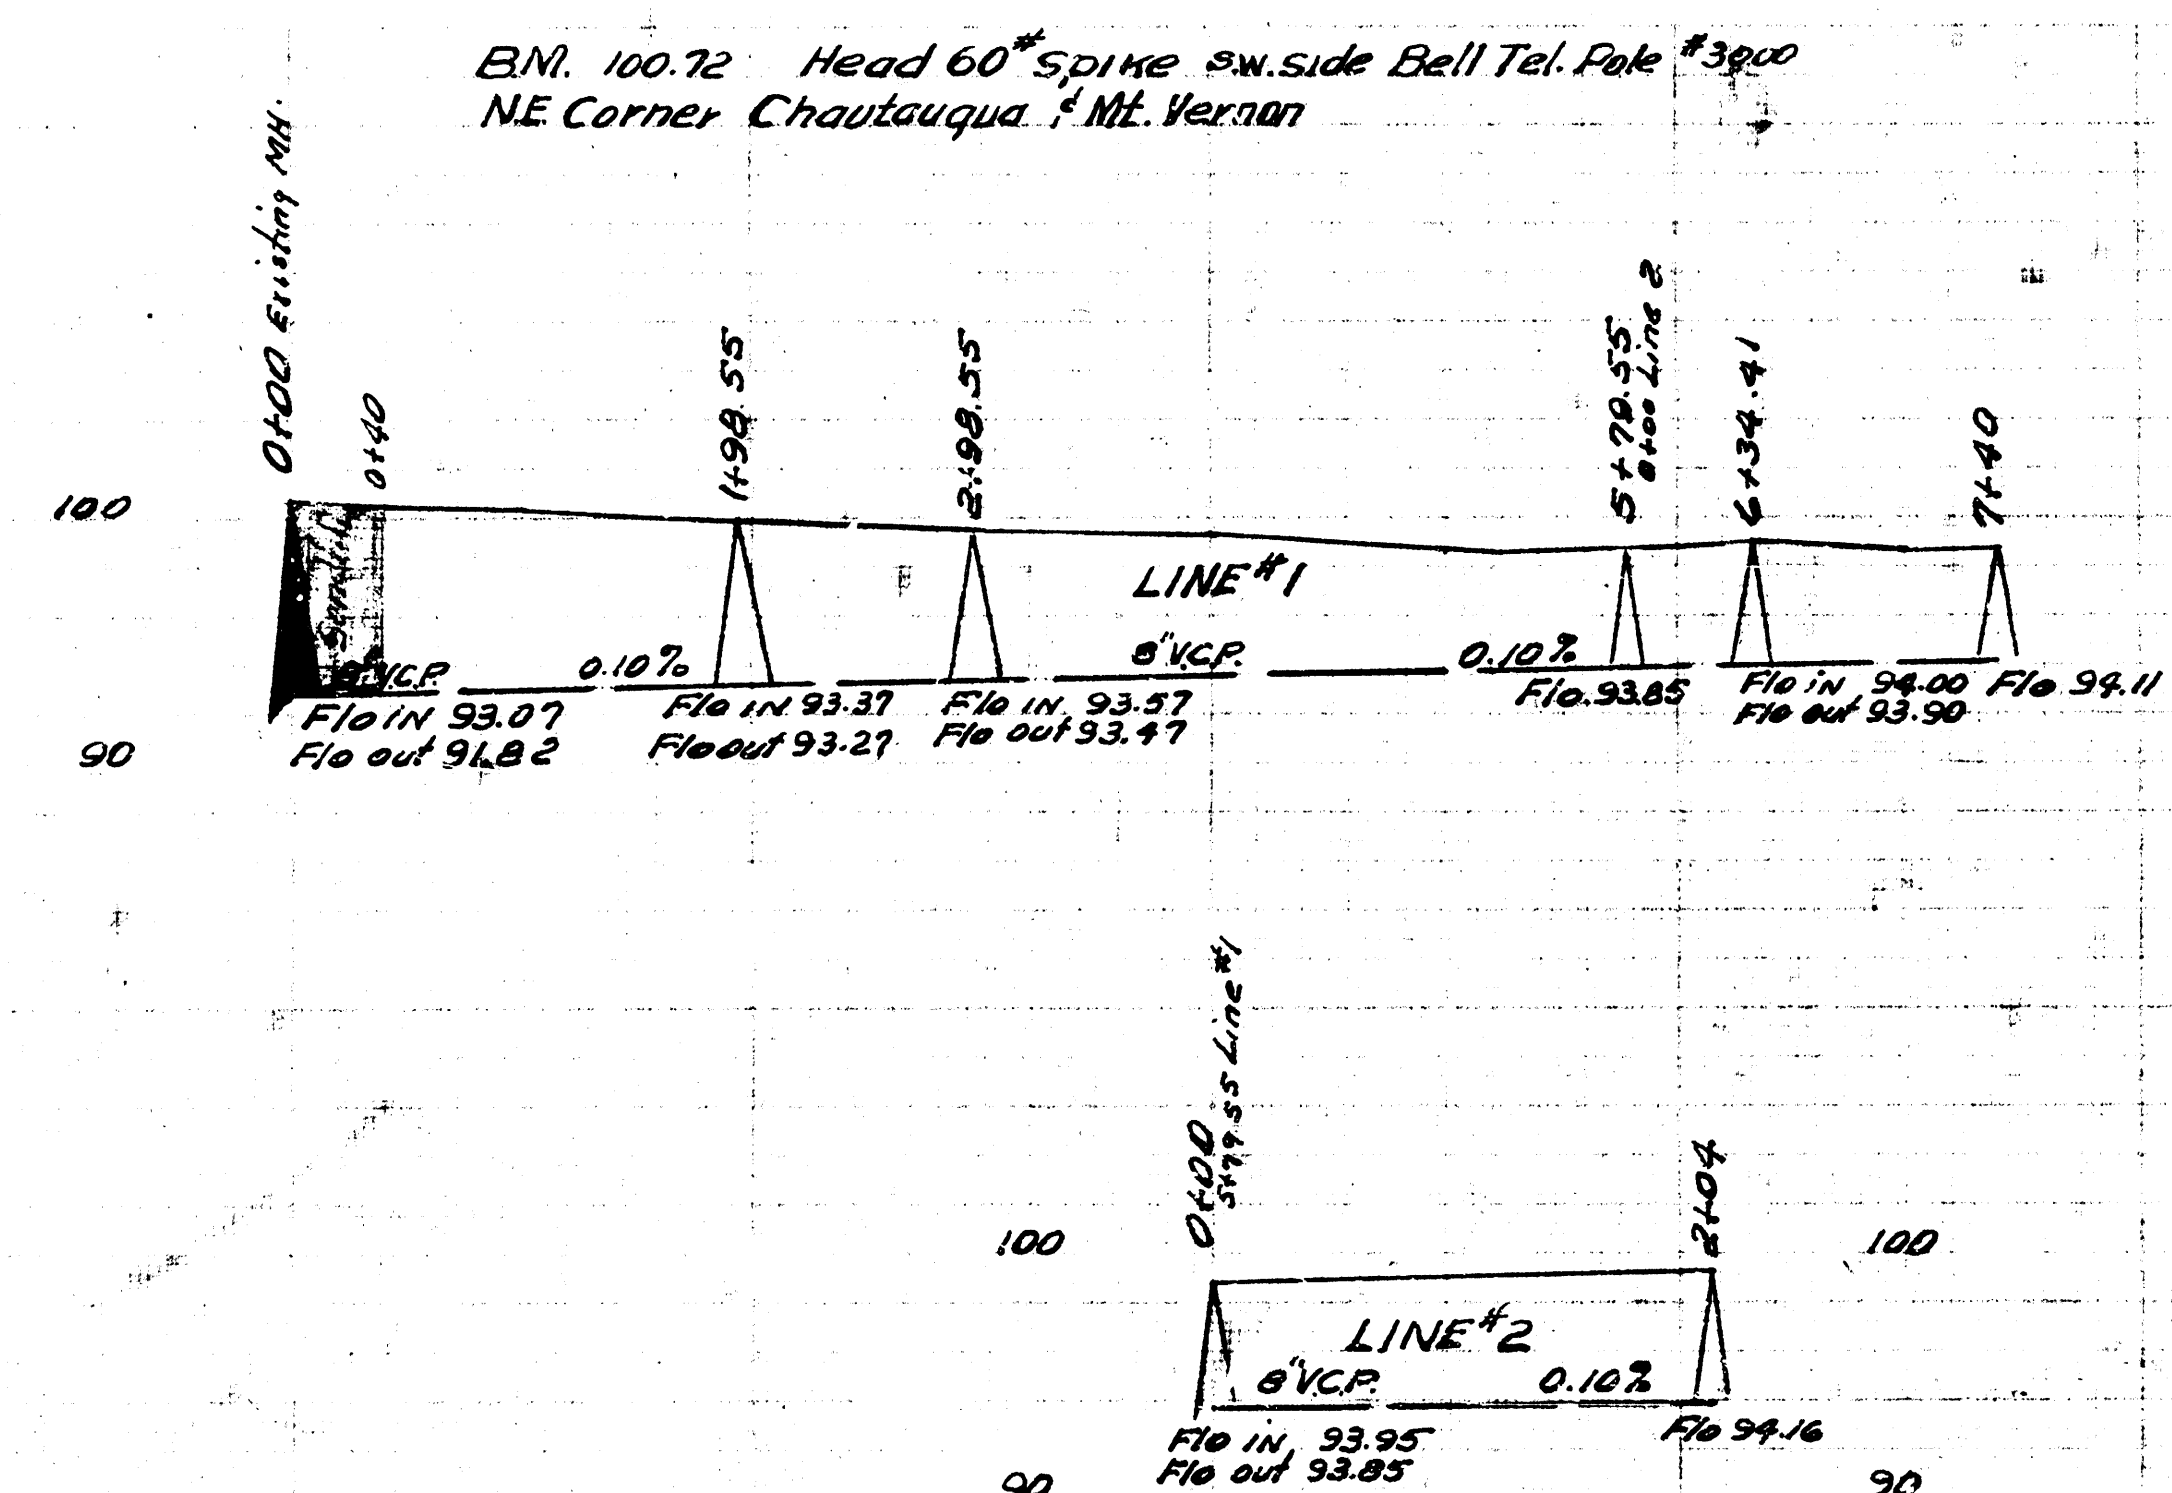

LAT 13 DCS 2 5512
CITY OF WICHITA KANSAS
LKW WHITE CITY ENGINEER
Proj No. C-22-79

LAT. Q DIST. D 5512
CITY OF WICHITA KANSAS
LKW WHITE CITY ENGINEER
Proj No. C-22-79

