

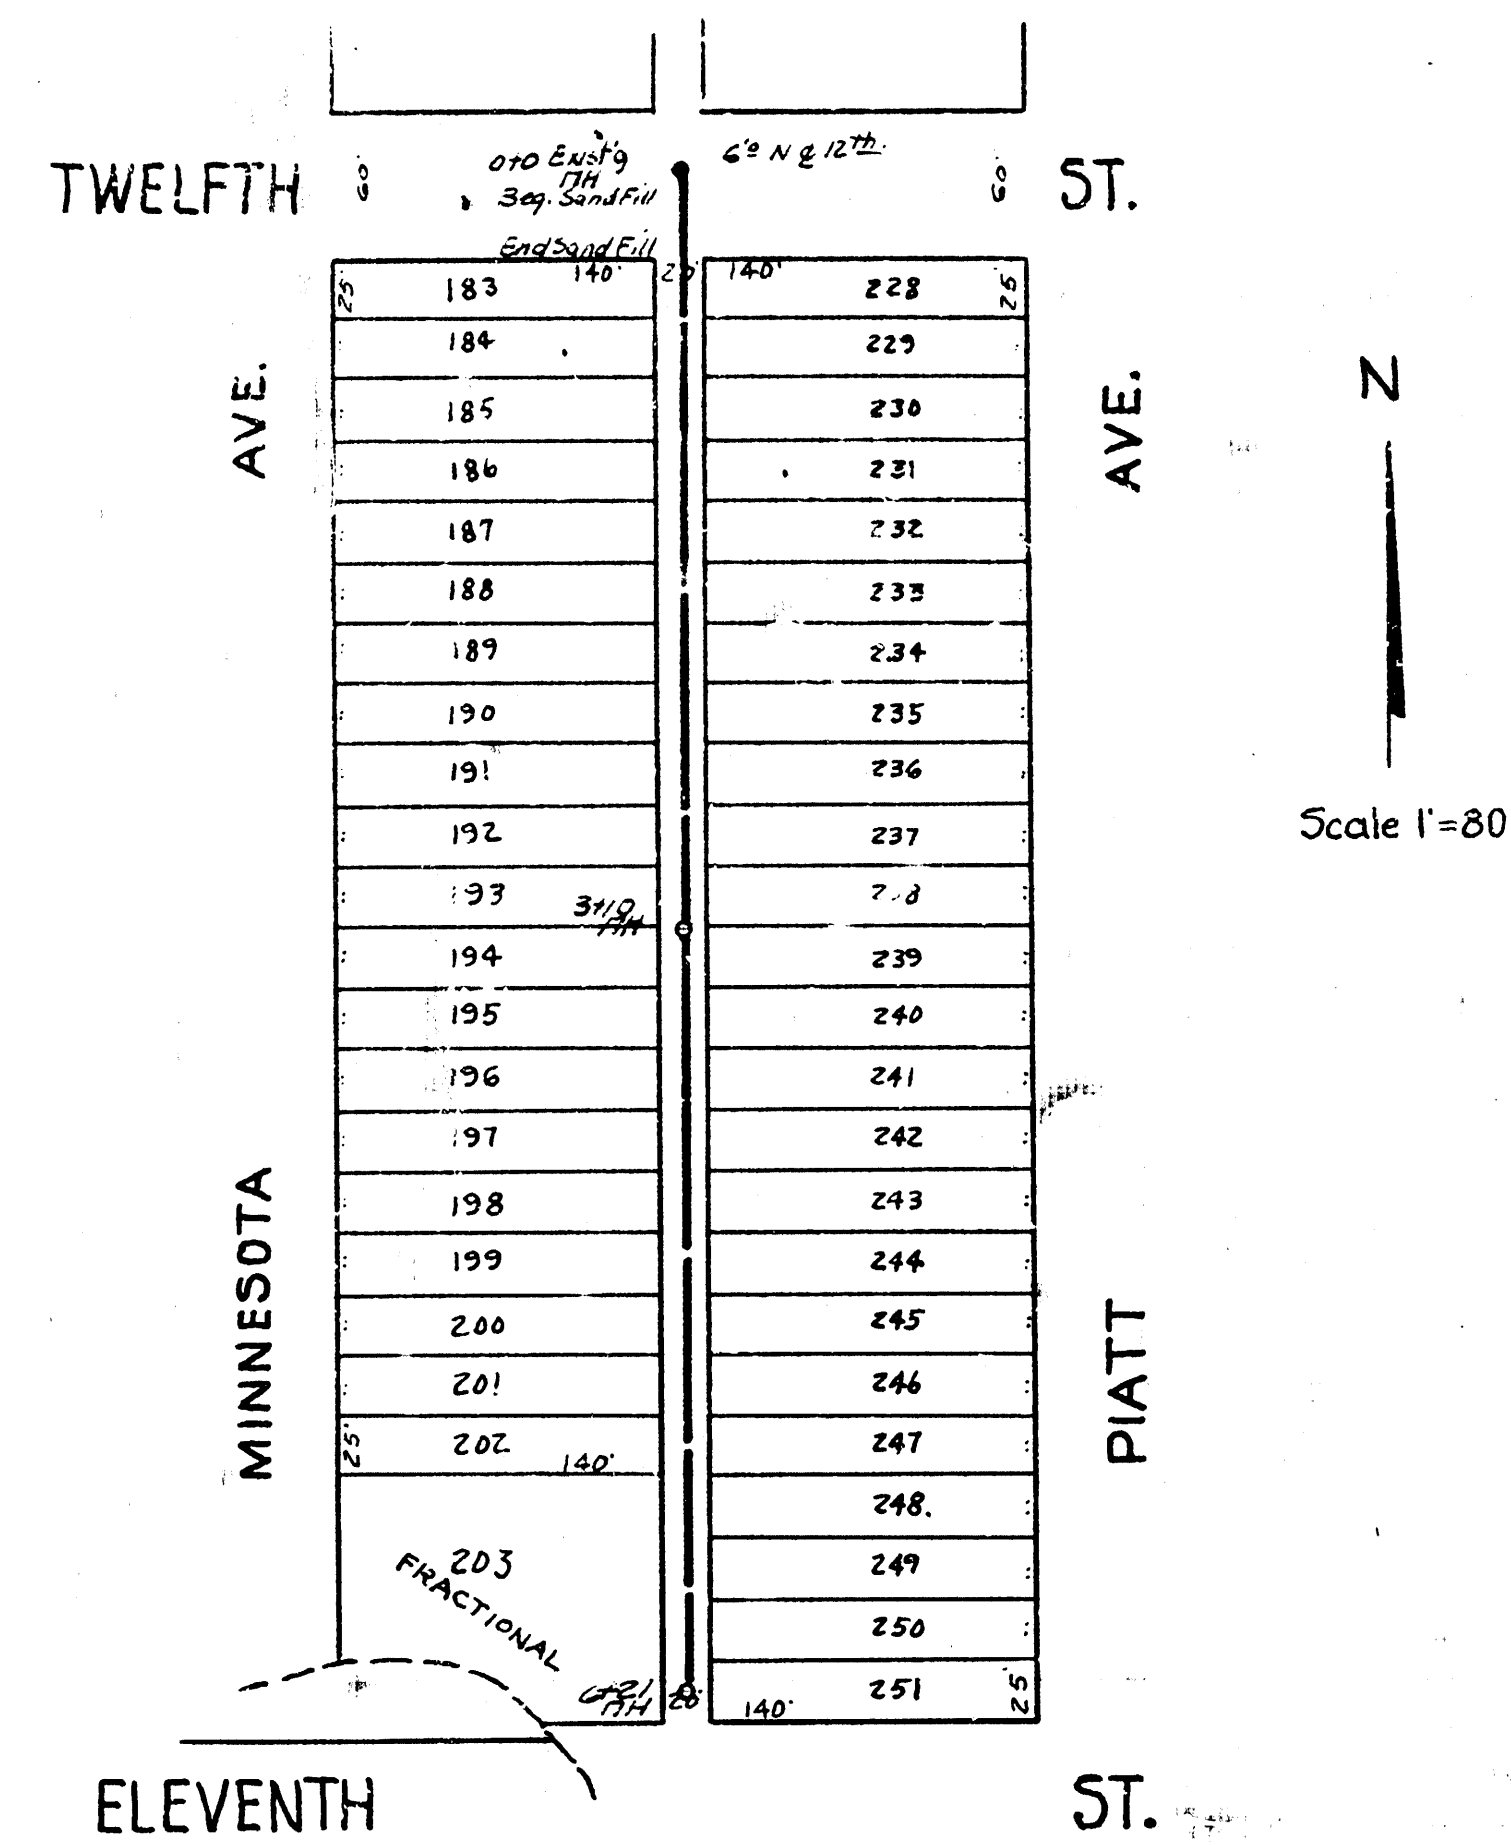
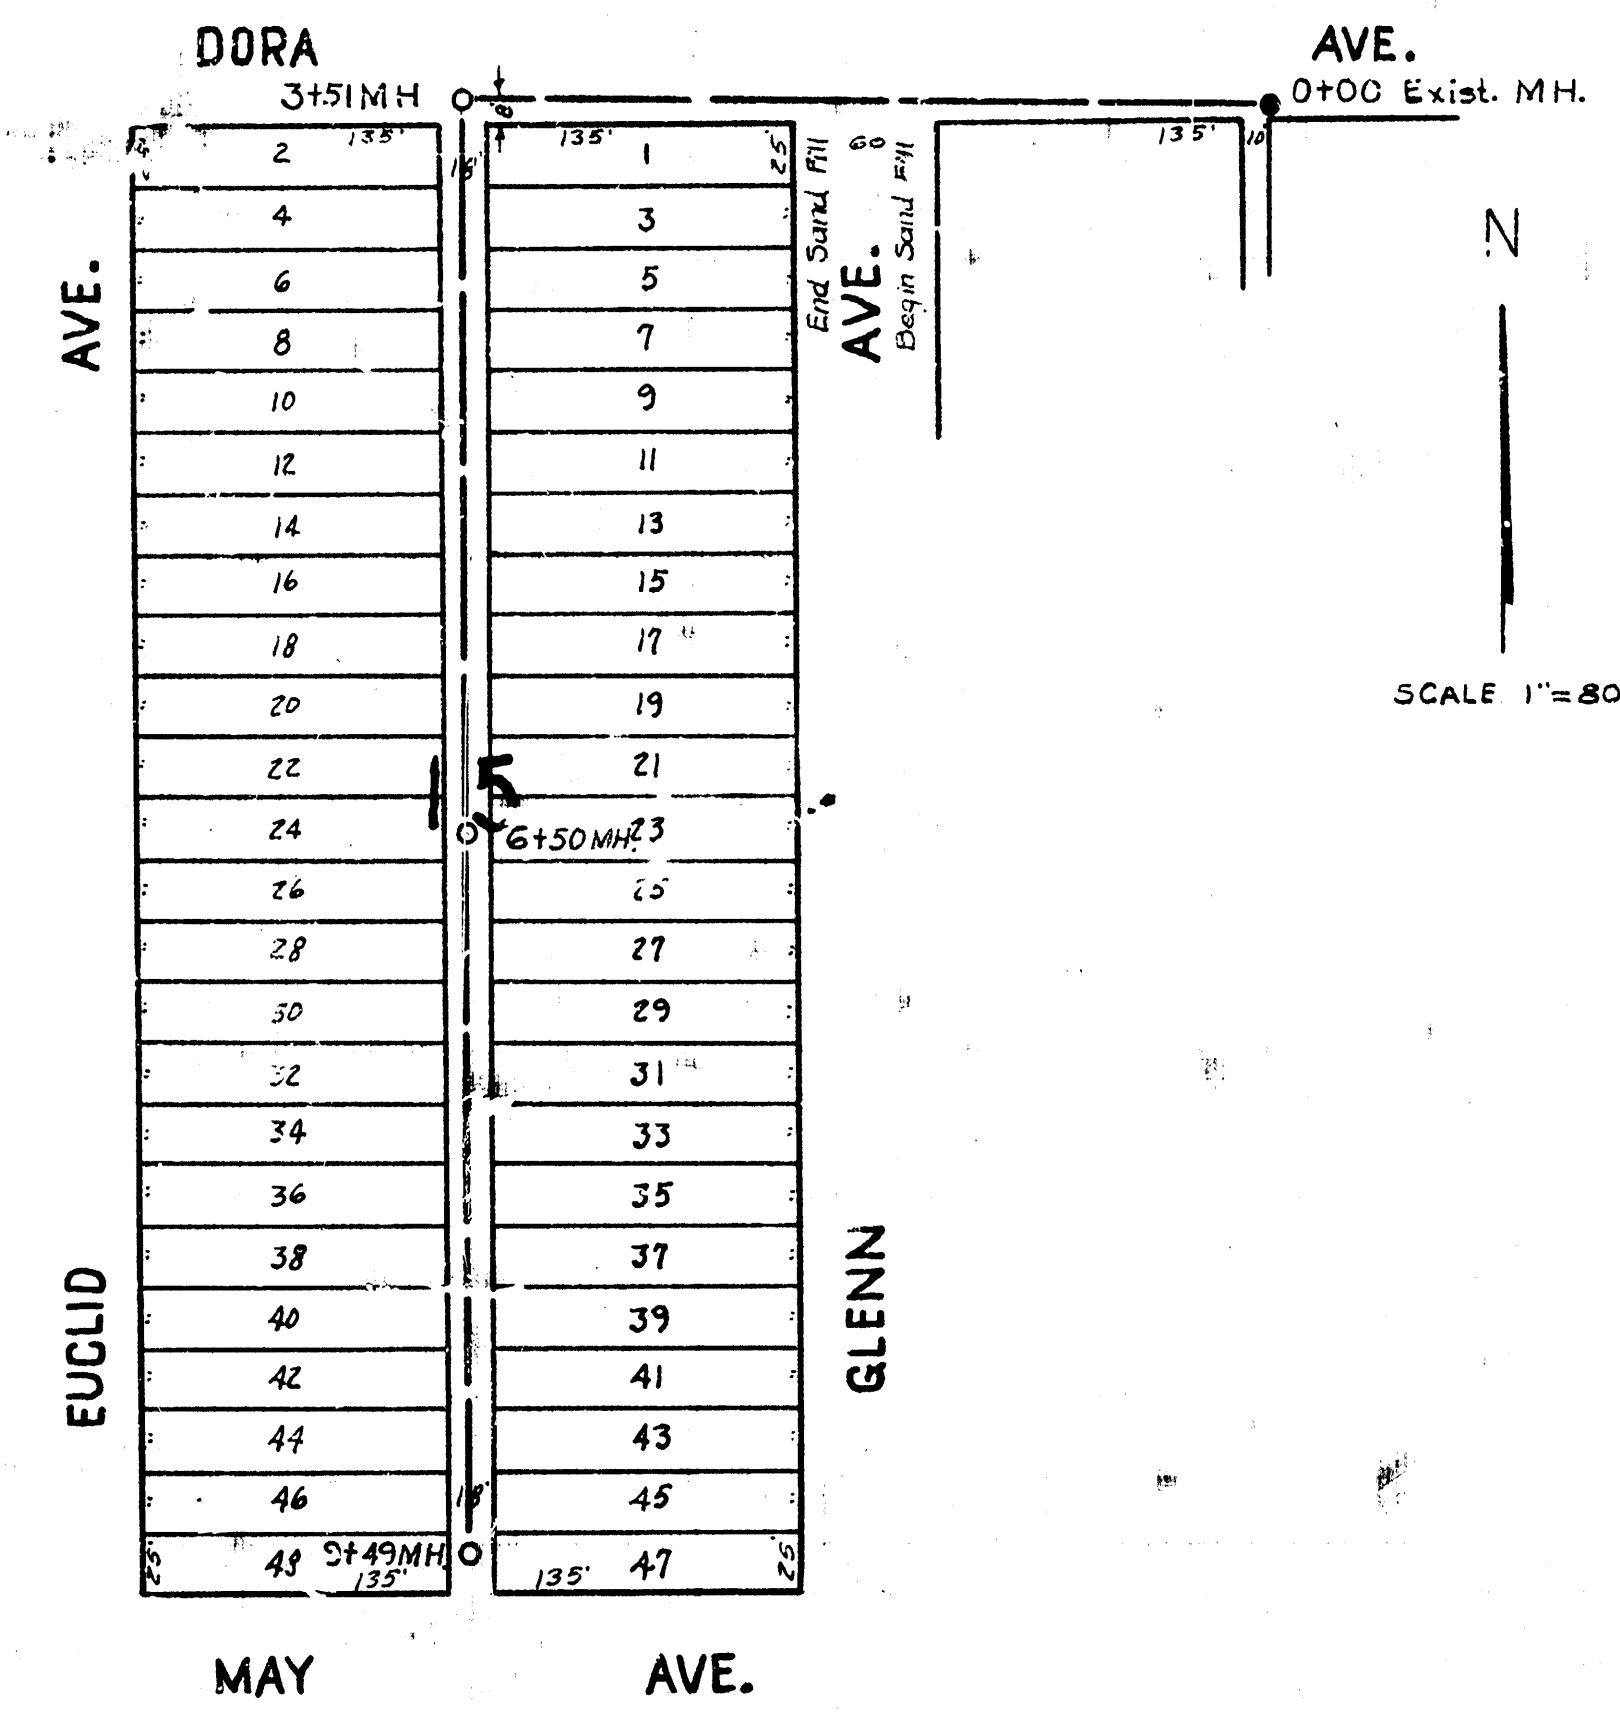


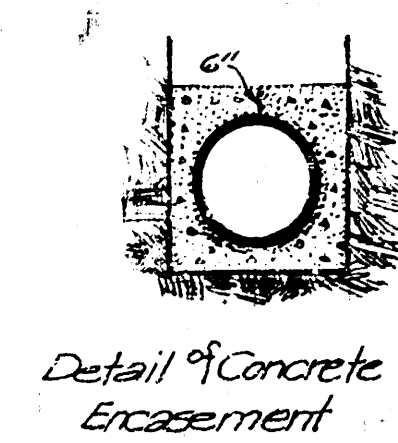



LAT. 1, DIST. Q, S.S. #12
PROJECT NO. C 20-17

B.M. 118.97 N.W. Cor. Conc. Porch Ho. # 1114 N. Ash.
B.M. 115.83 East Rim M.H. at Sta. 0+00.

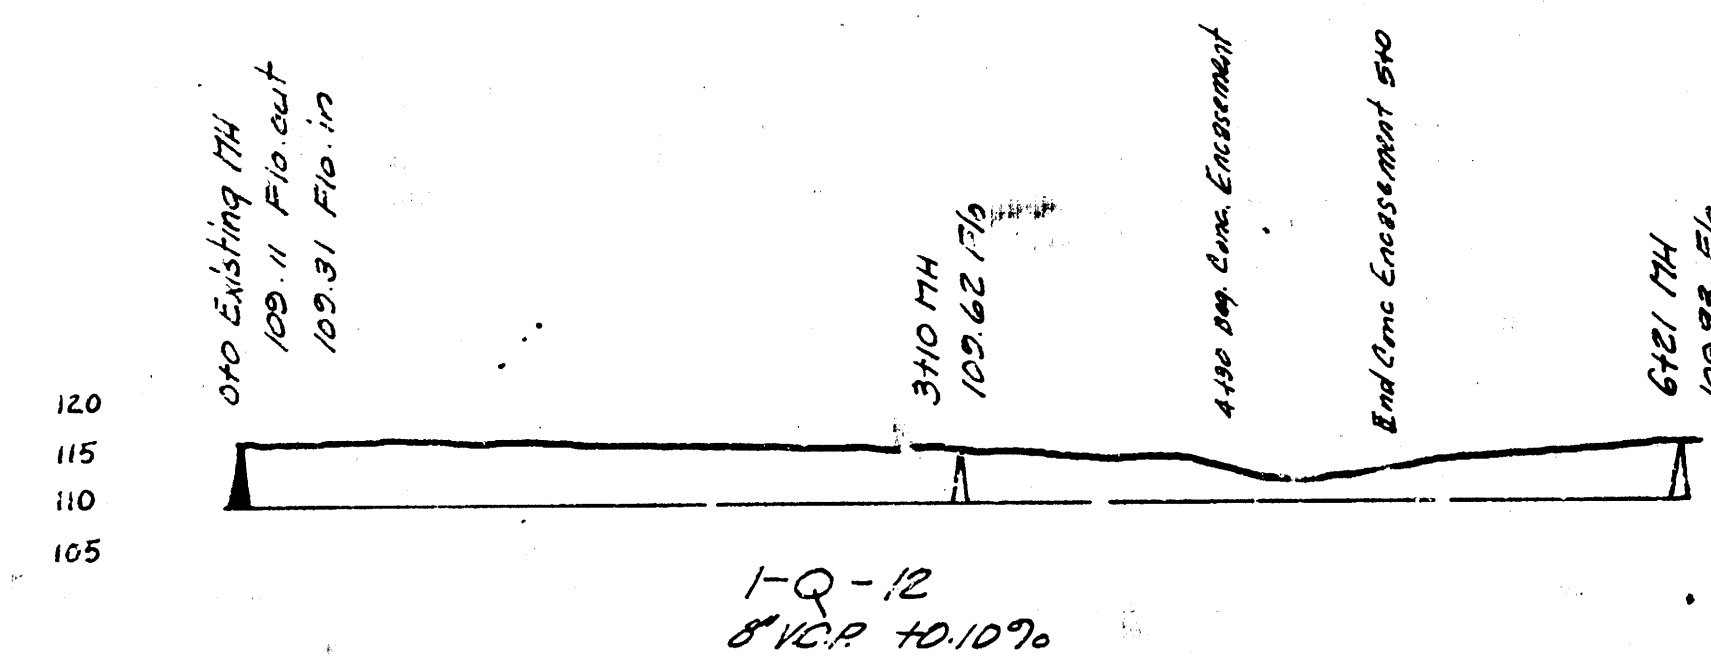

LAT. K, DIST. E, S.S. #21
PROJECT NO. C 20-14

B.M. 103.02 "G" in Globe E. cb. Vine N.L. Hwy.

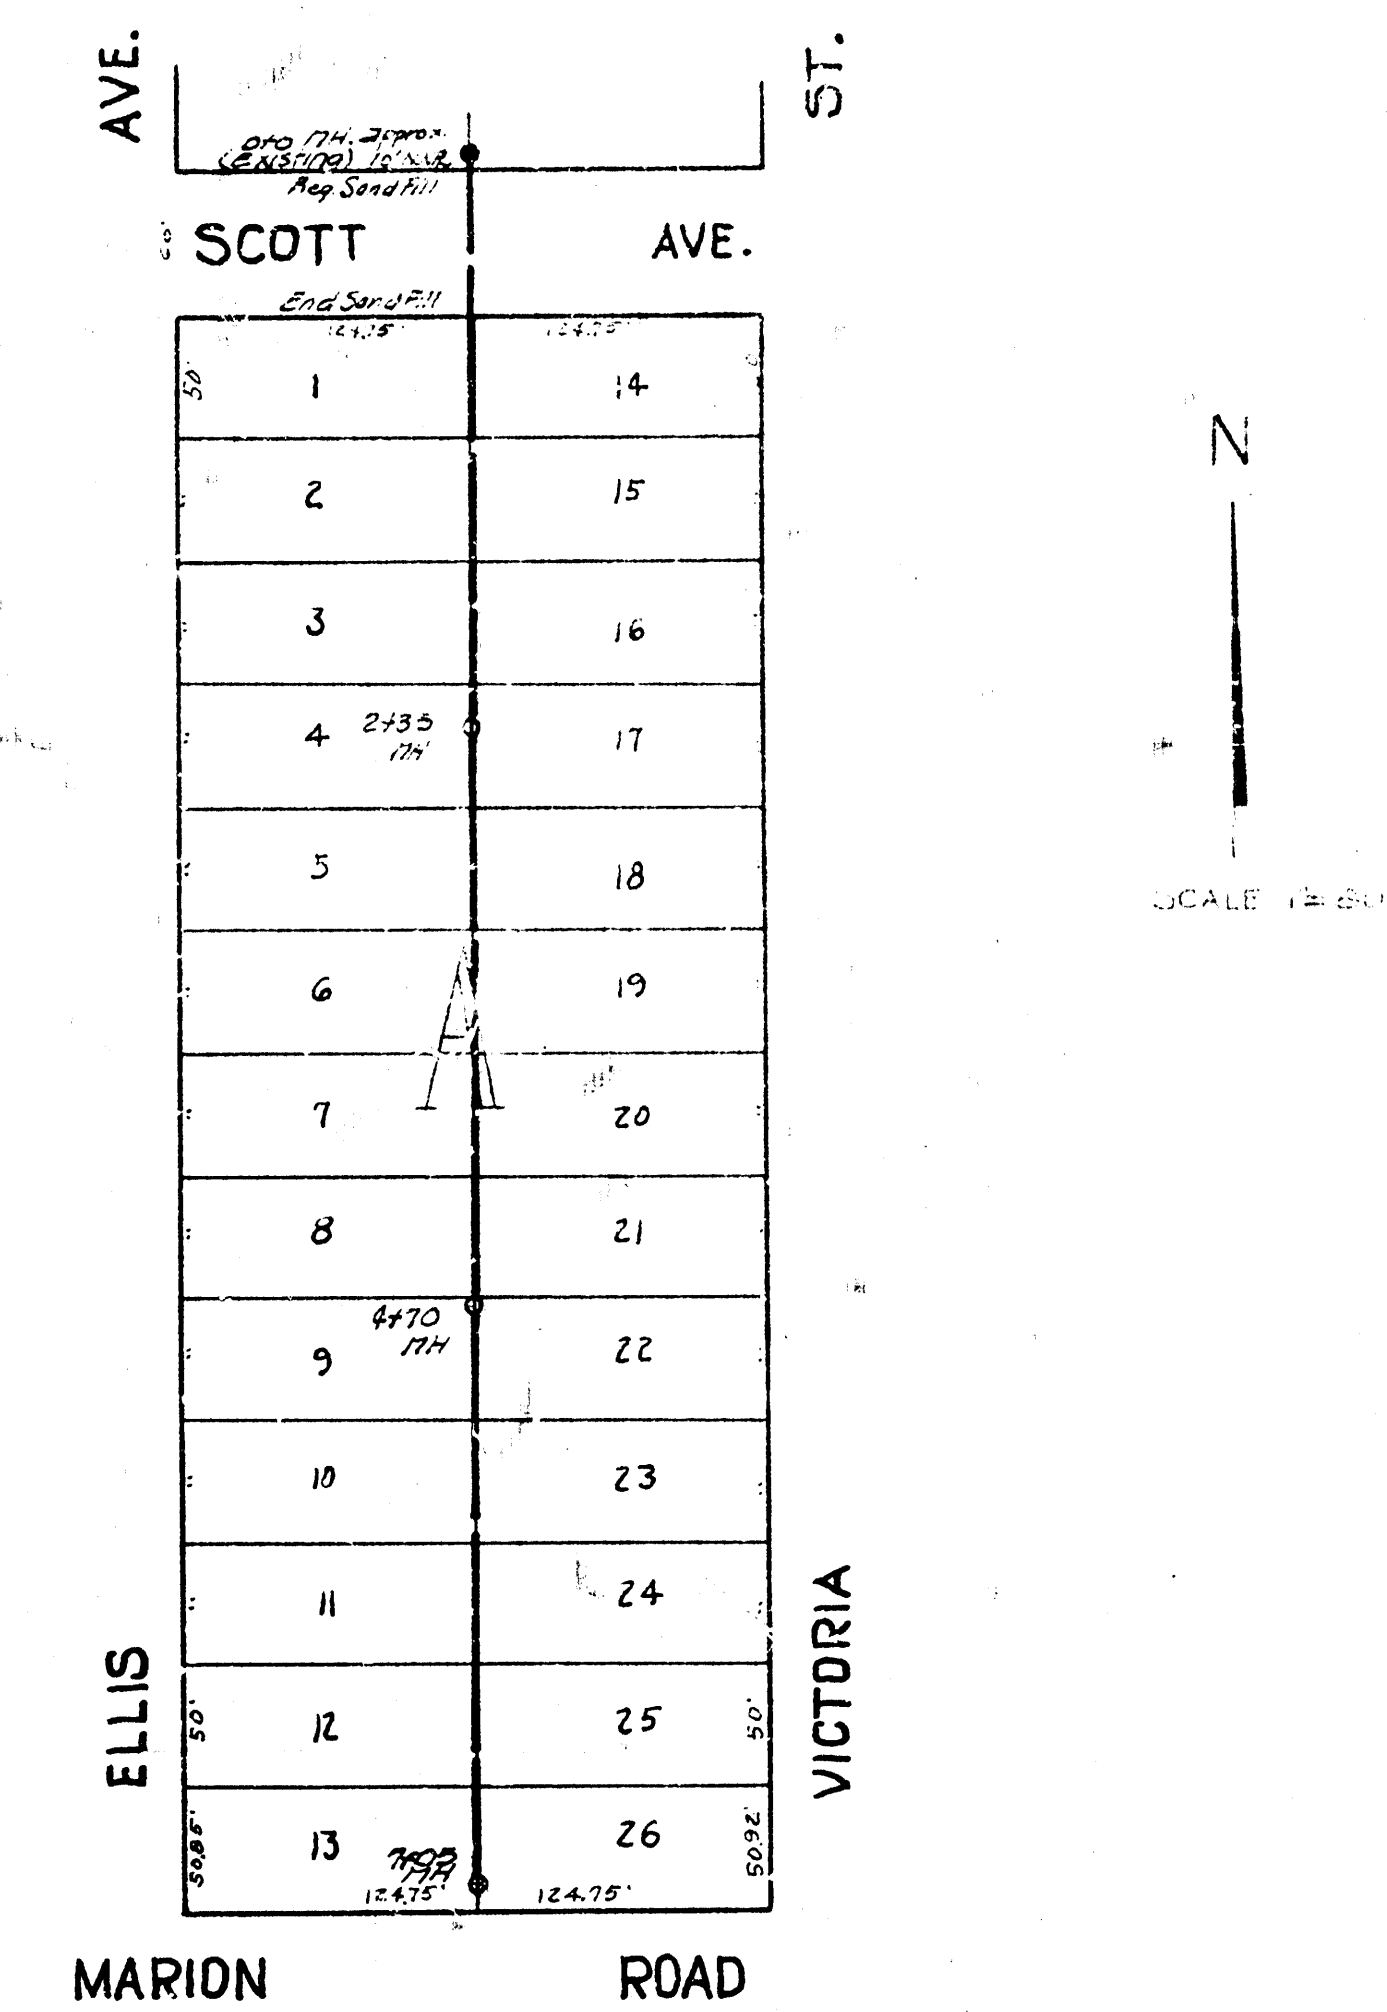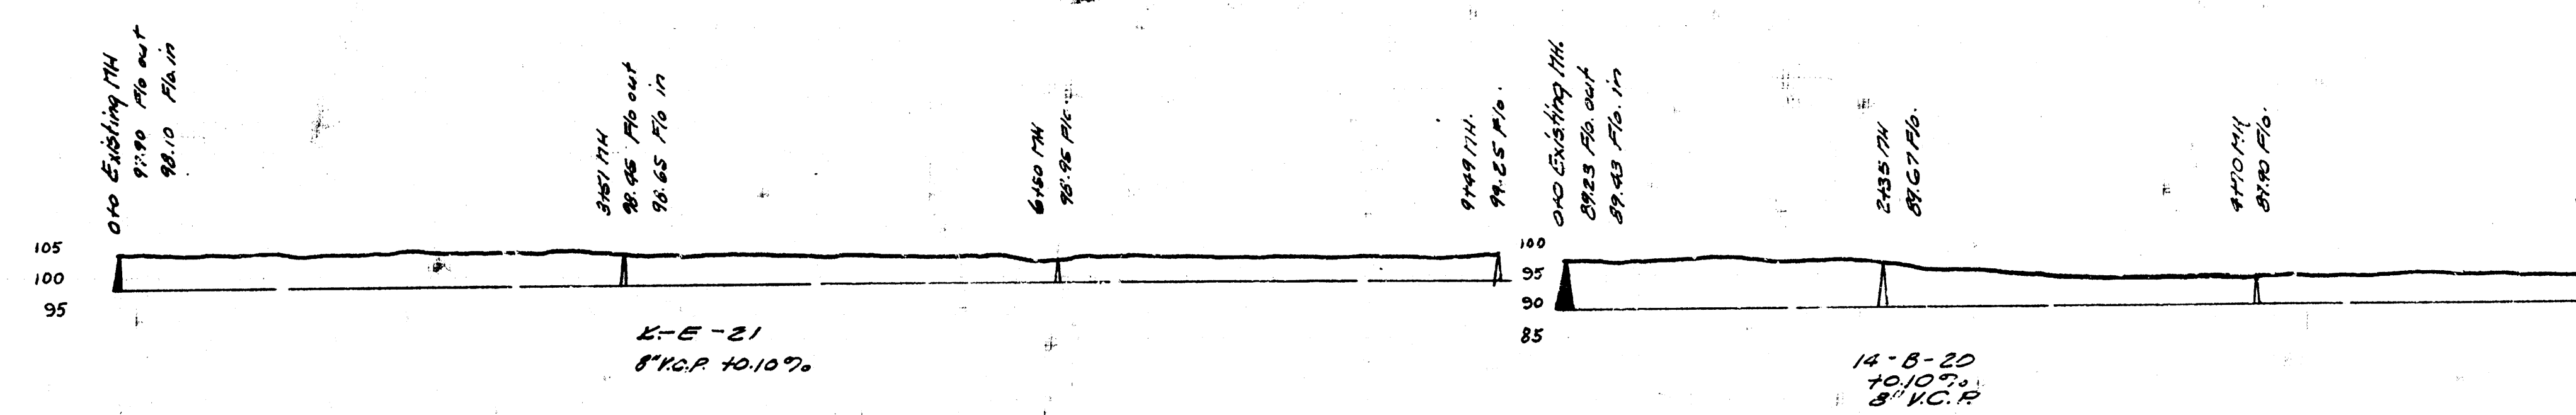

LAT. 14, DIST. B, S.S. #20
PROJECT NO. C 29-63

B.M. 99.63 T in F.R. Greenwood & Pawnee.
B.M. 97.26 No. Rim M.H. at Sta. 0+00.

LAT. 1, DIST. Q, S.S. #12 - LAT. K, DIST. E, S.S. #21
LAT. 14, DIST. B, S.S. #20
City of Wichita, Kansas
L.H. White City Engineer
Date 3-27-50 Proj. Nos. C 20-17
C 20-14
C 29-63