

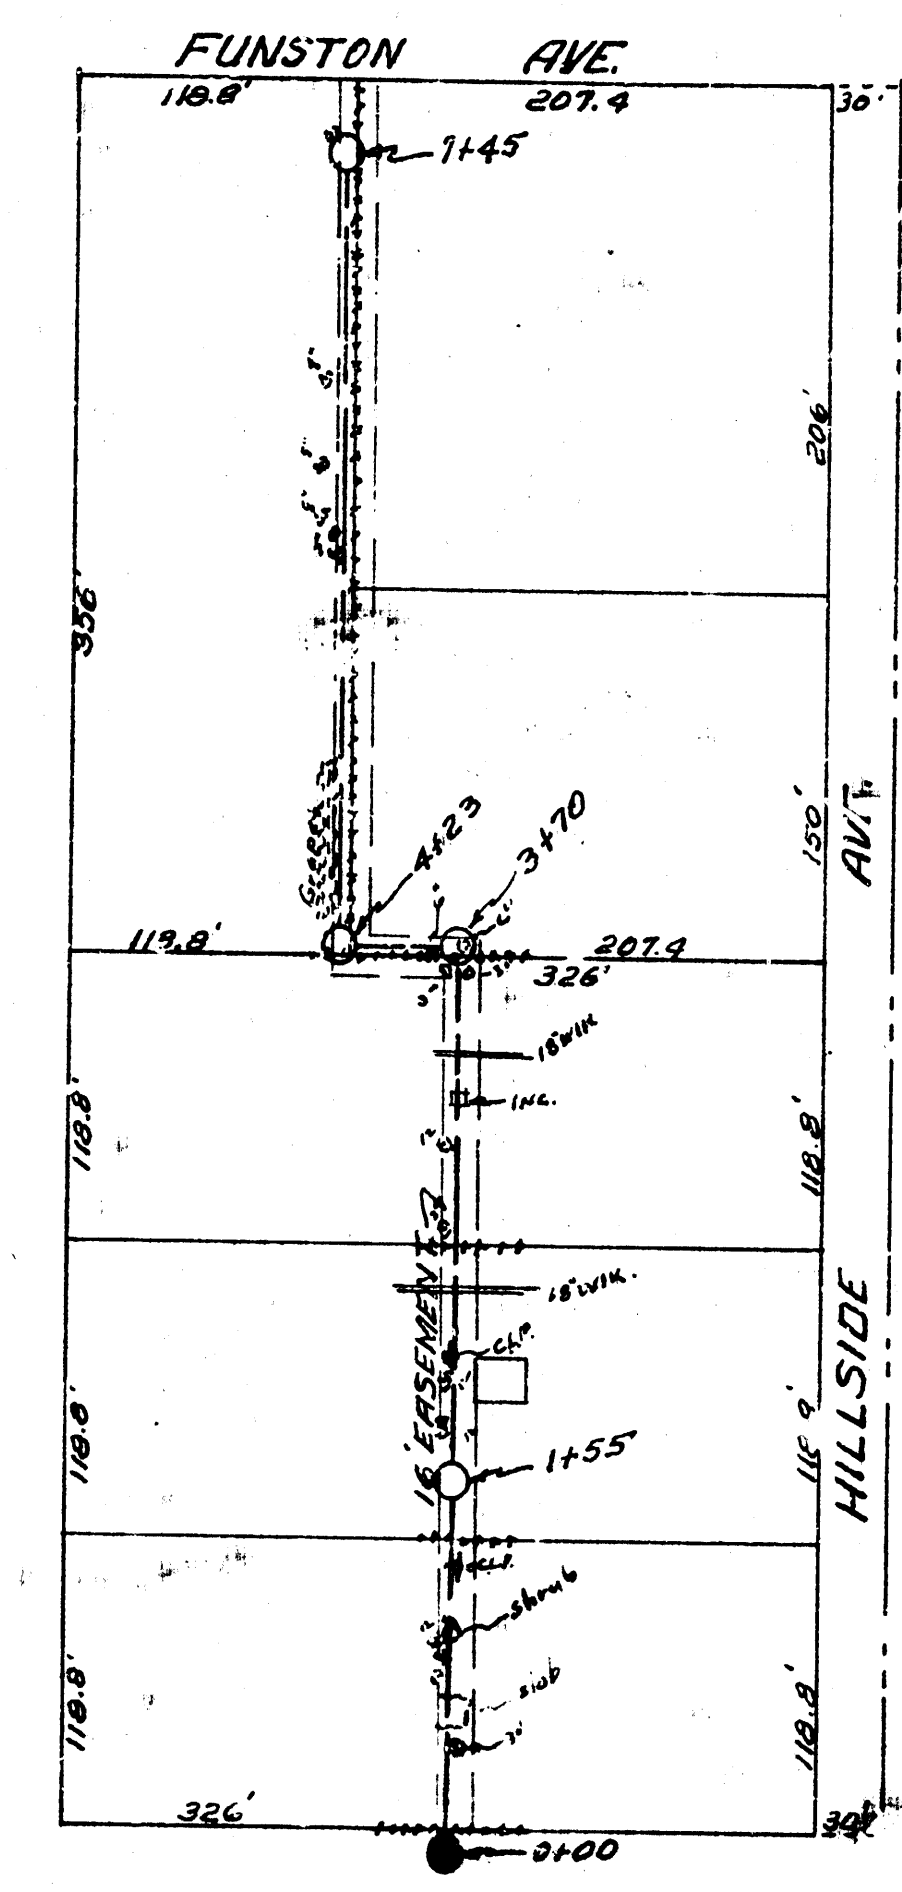
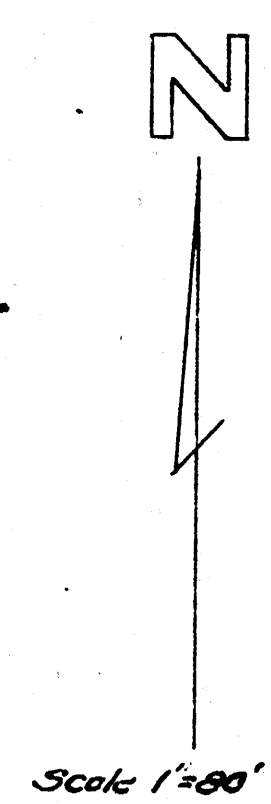


**BLOCK 5 KANSAS ADD.**

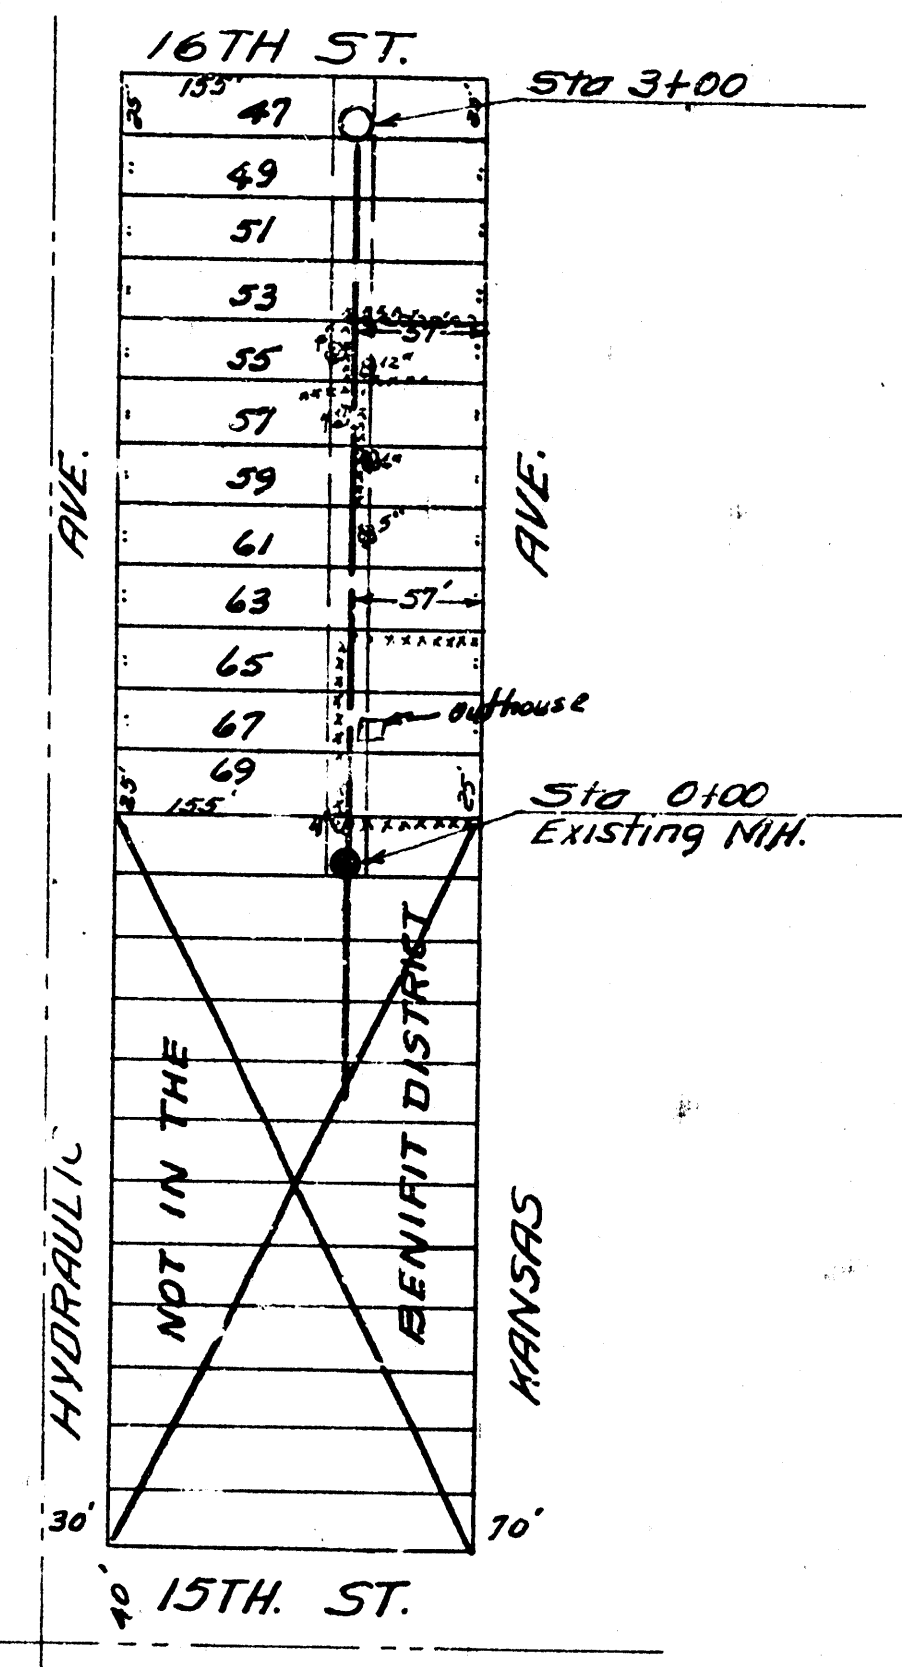


9-1-53  
Drawn by  
Checked by  
Date

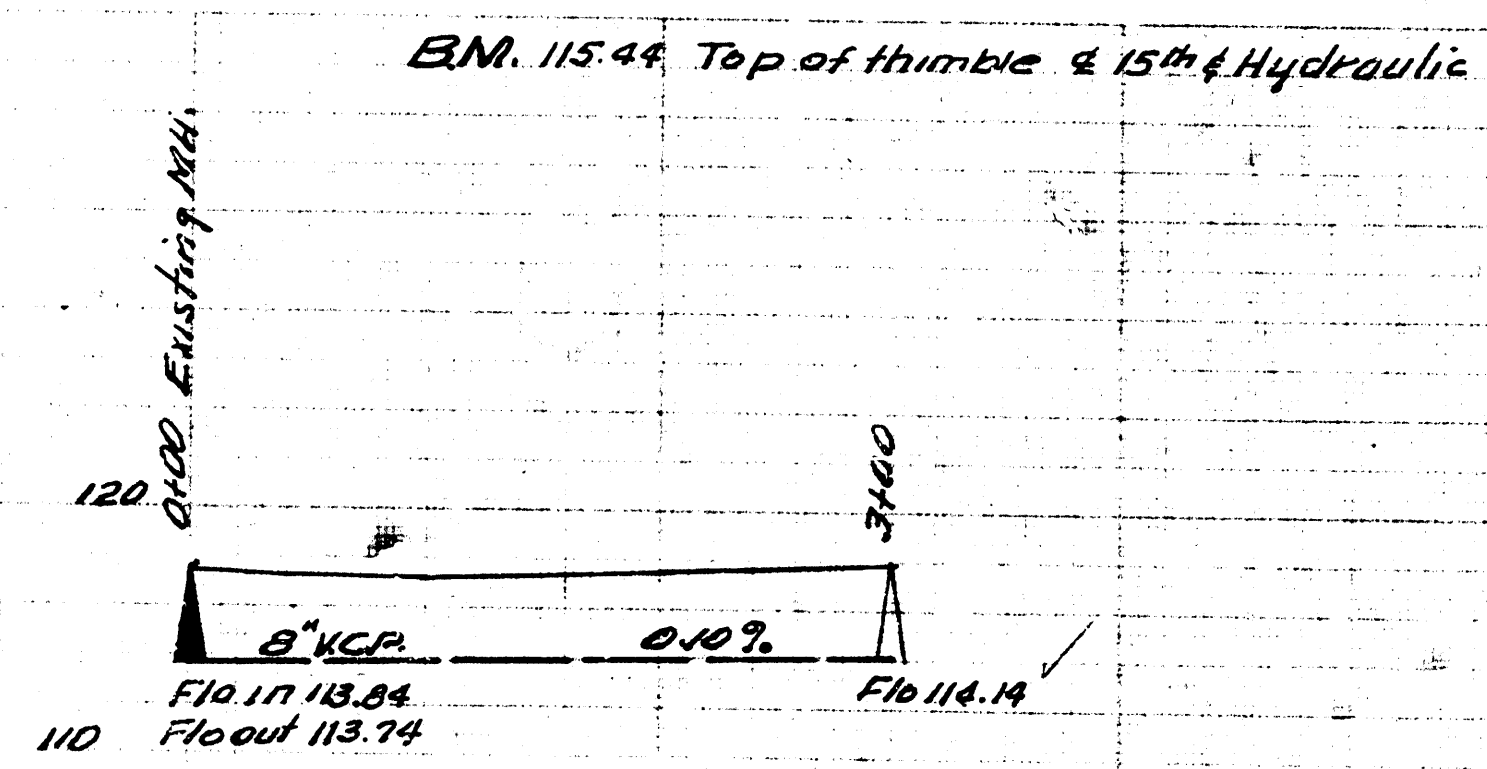

LAT. 6 DIST. R SS. 12  
CITY OF WICHITA KANSAS  
BE SMITH CITY ENGINEER  
Proj. No. C-22-95

9-1-53  
Drawn by  
Checked by  
Date

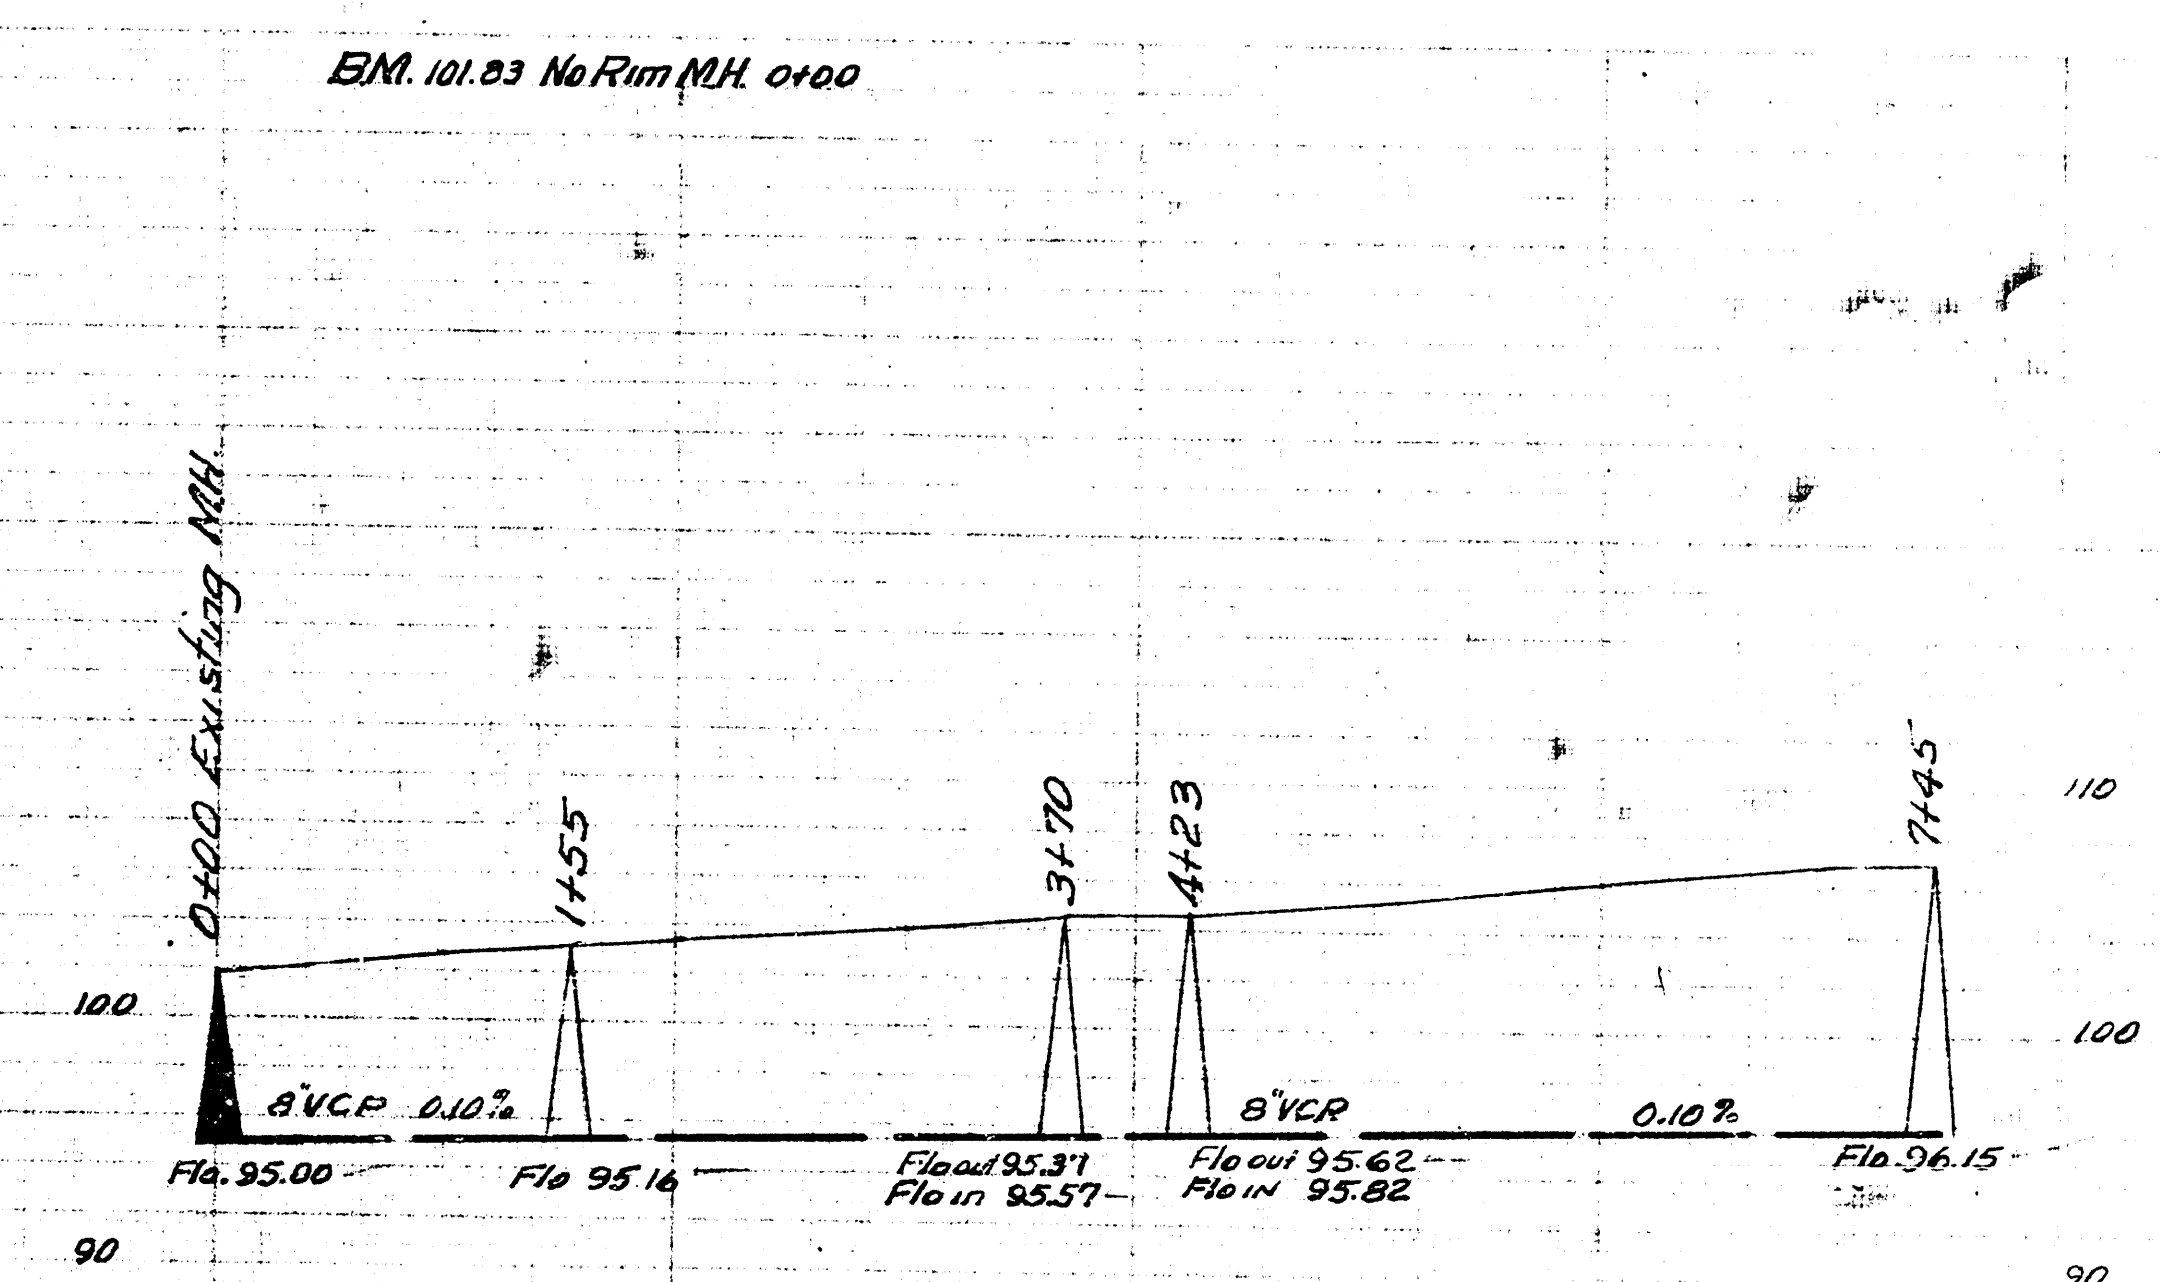

LAT. 26 DIST. 2 SS. 12  
CITY OF WICHITA KANSAS  
BE SMITH CITY ENGINEER  
Proj. No. C-22-81