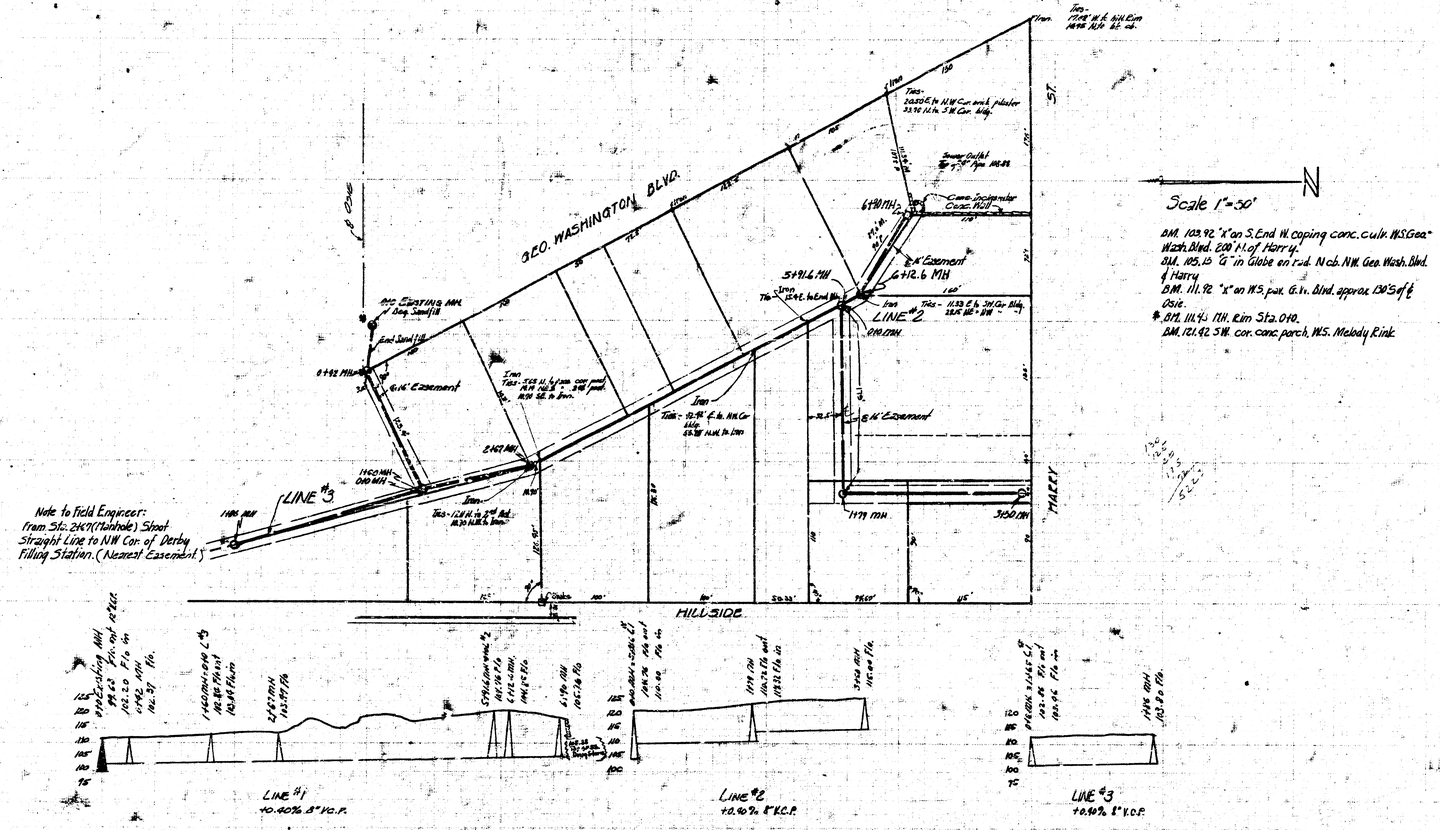

B.M. 103.92 "x" on S. End W. coping conc. culv. W.S. Geo. Wash. Blvd. 200 ft. of Harry.
B.M. 105.13 "G" in Globe on rad. N cb. NW. Geo. Wash. Blvd. & Harry
B.M. 111.92 "x" on W.S. pak. G.v. Blvd. approx. 130 S of ℄ Osie.
* B.M. 111.4 ± Rim Sta. 0+40.
B.M. 121.92 SW. cor. conc. porch, W.S. Melody Rink.

DETAIL OF TAMPED BACK FILL
Tamped back fill to be used in ditch all over 12' in depth.

LATERAL S, ~~DISTRICT~~ W, SANITARY SEWER #12
CITY OF WICHITA, KANSAS
L.B. White .... City Engineer
Date 6-30-50 Proj. No. C20-9

SUB. N

e #0 + (51) 1