

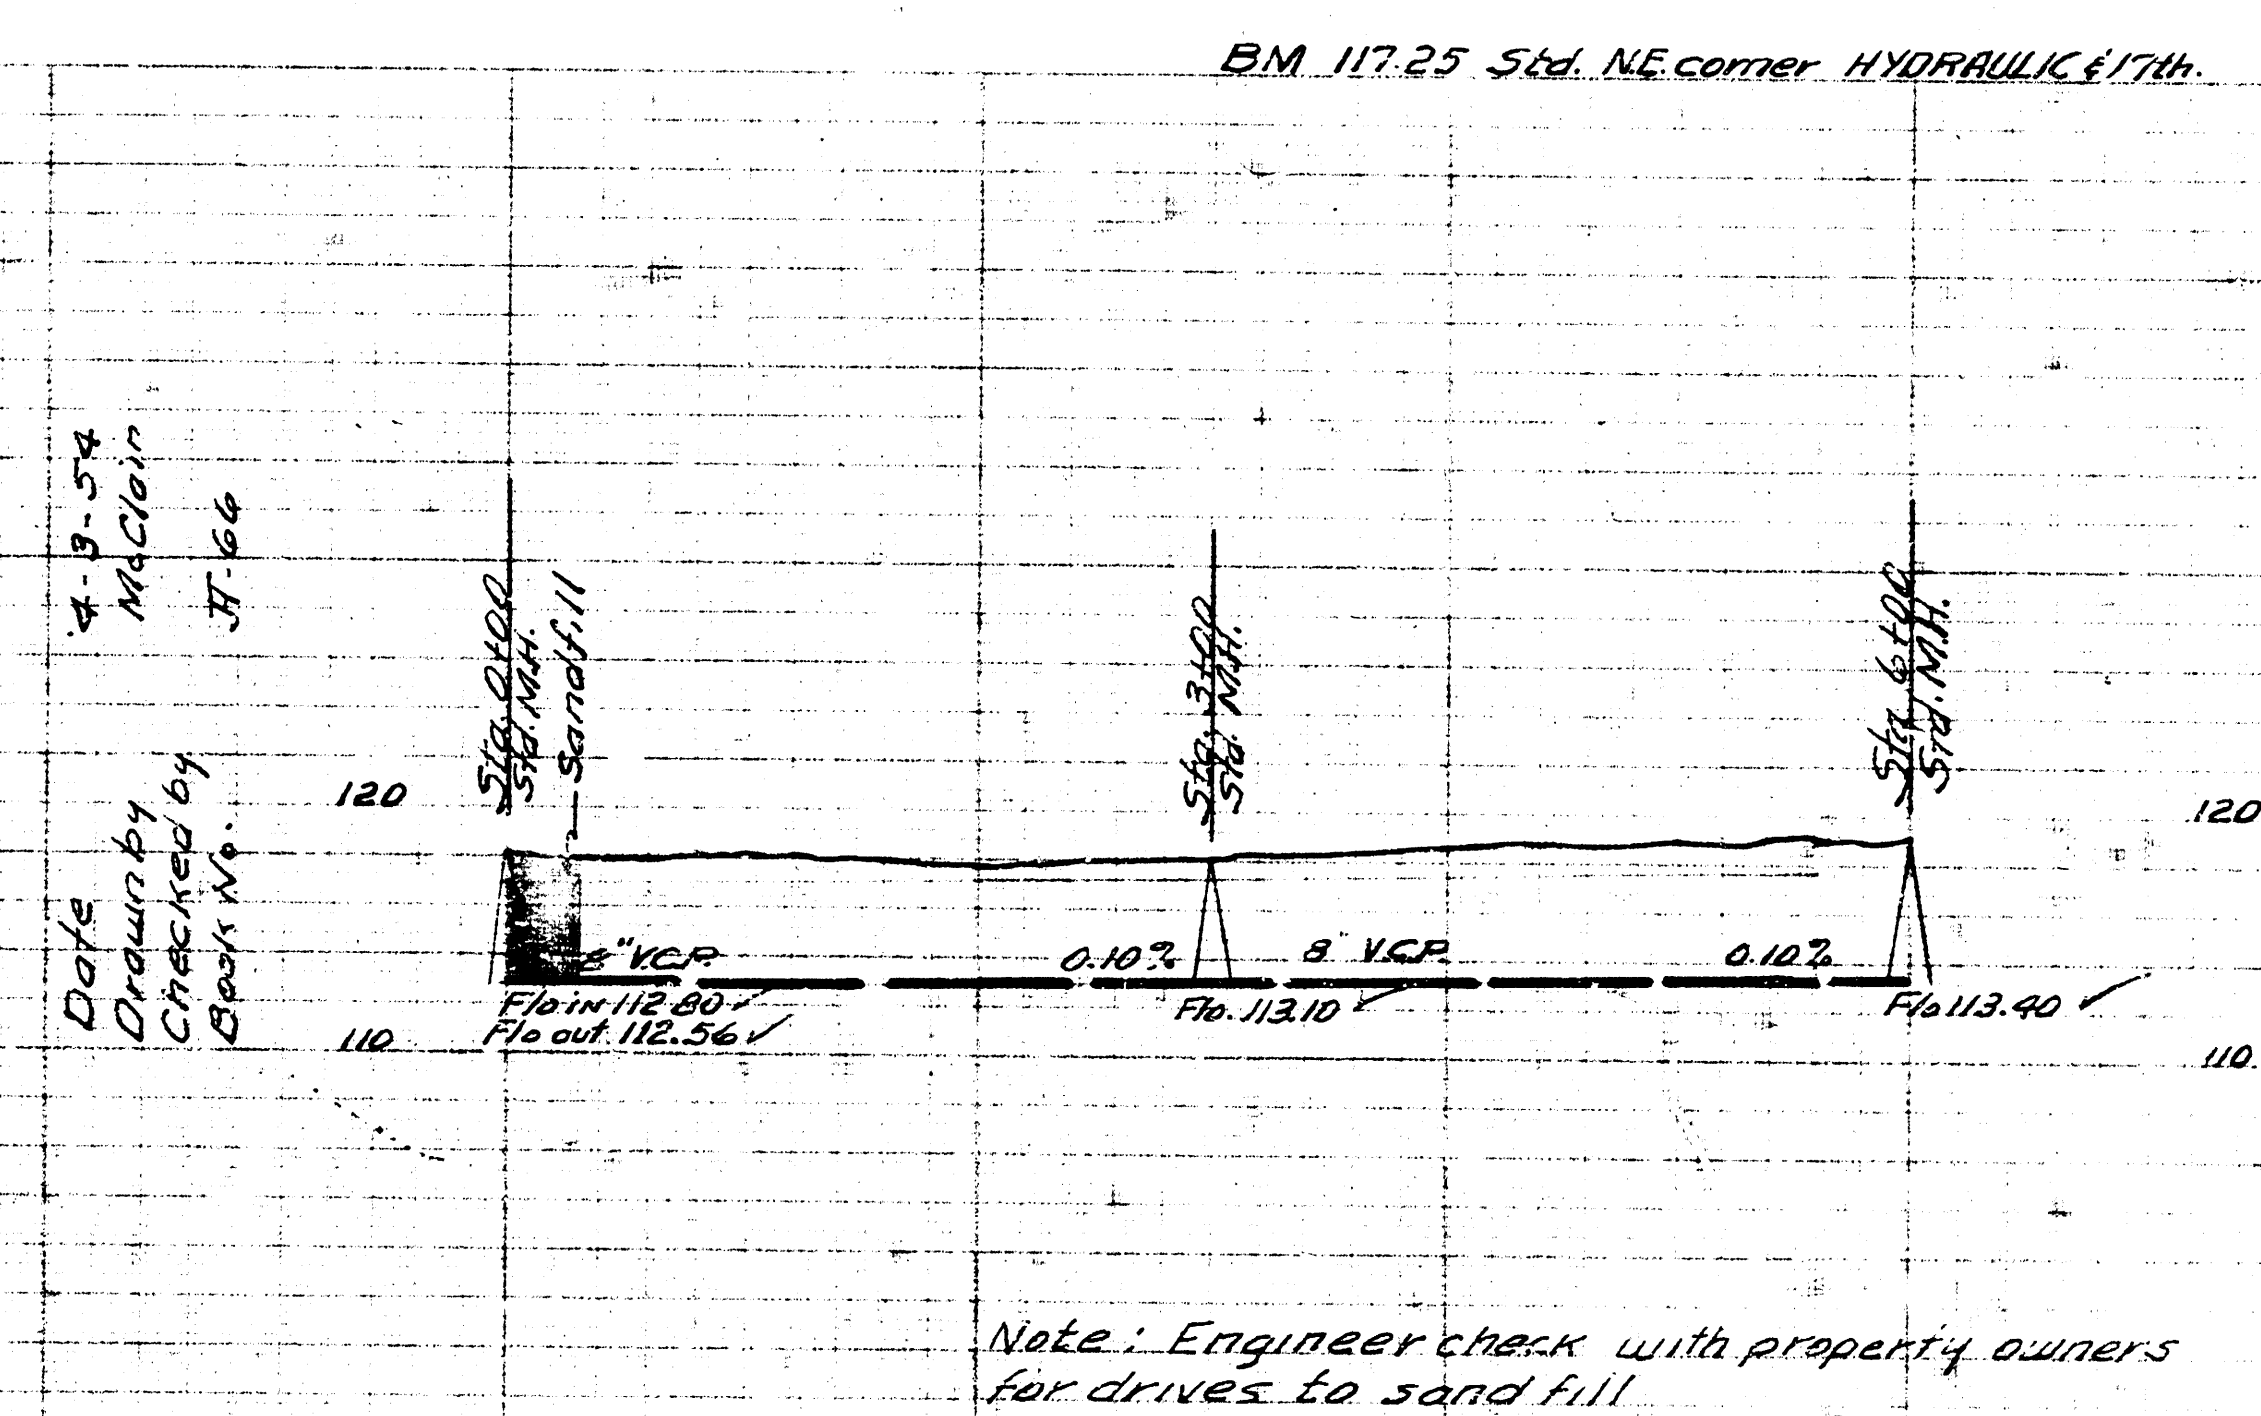


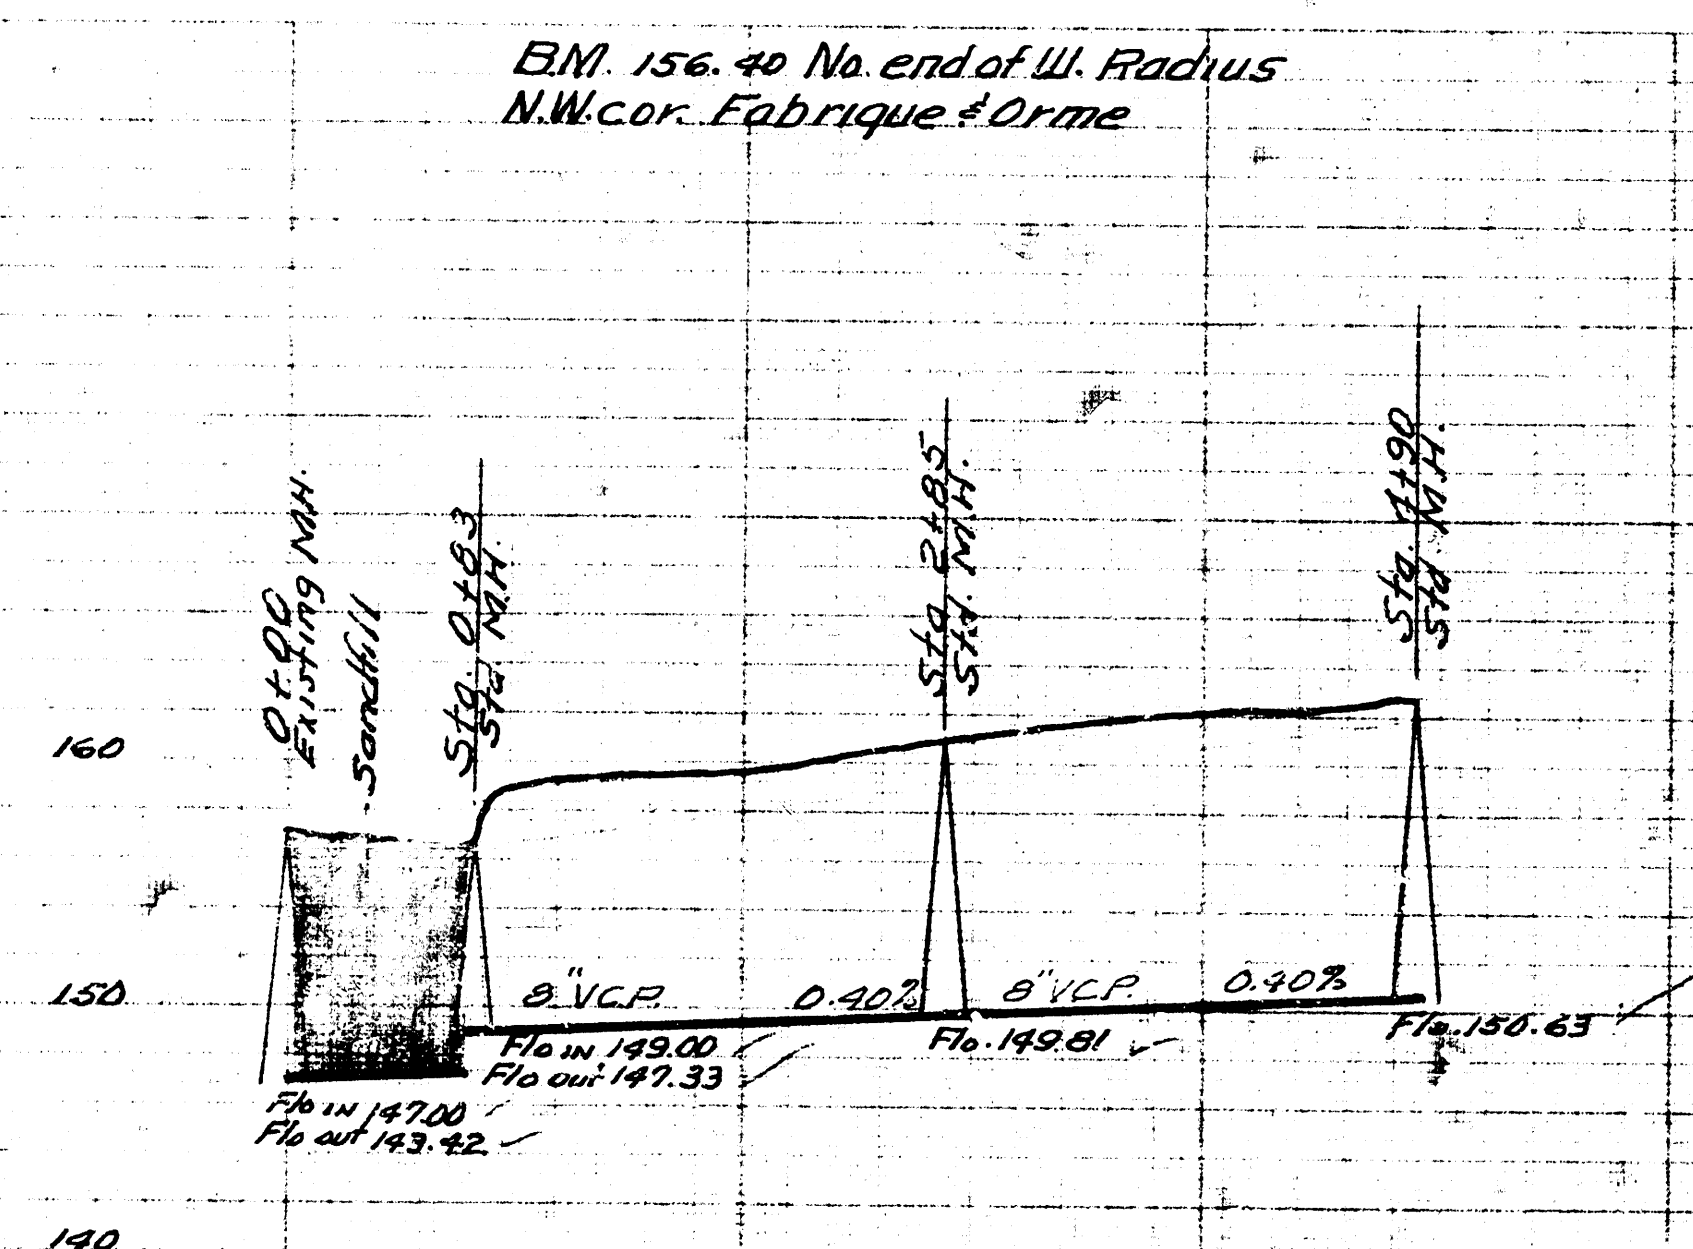

LAT. 12 DIST. Y 55.12
CITY OF WICHITA KANSAS
B.E. SMITH CITY ENGINEER
Proj. No. C24-14

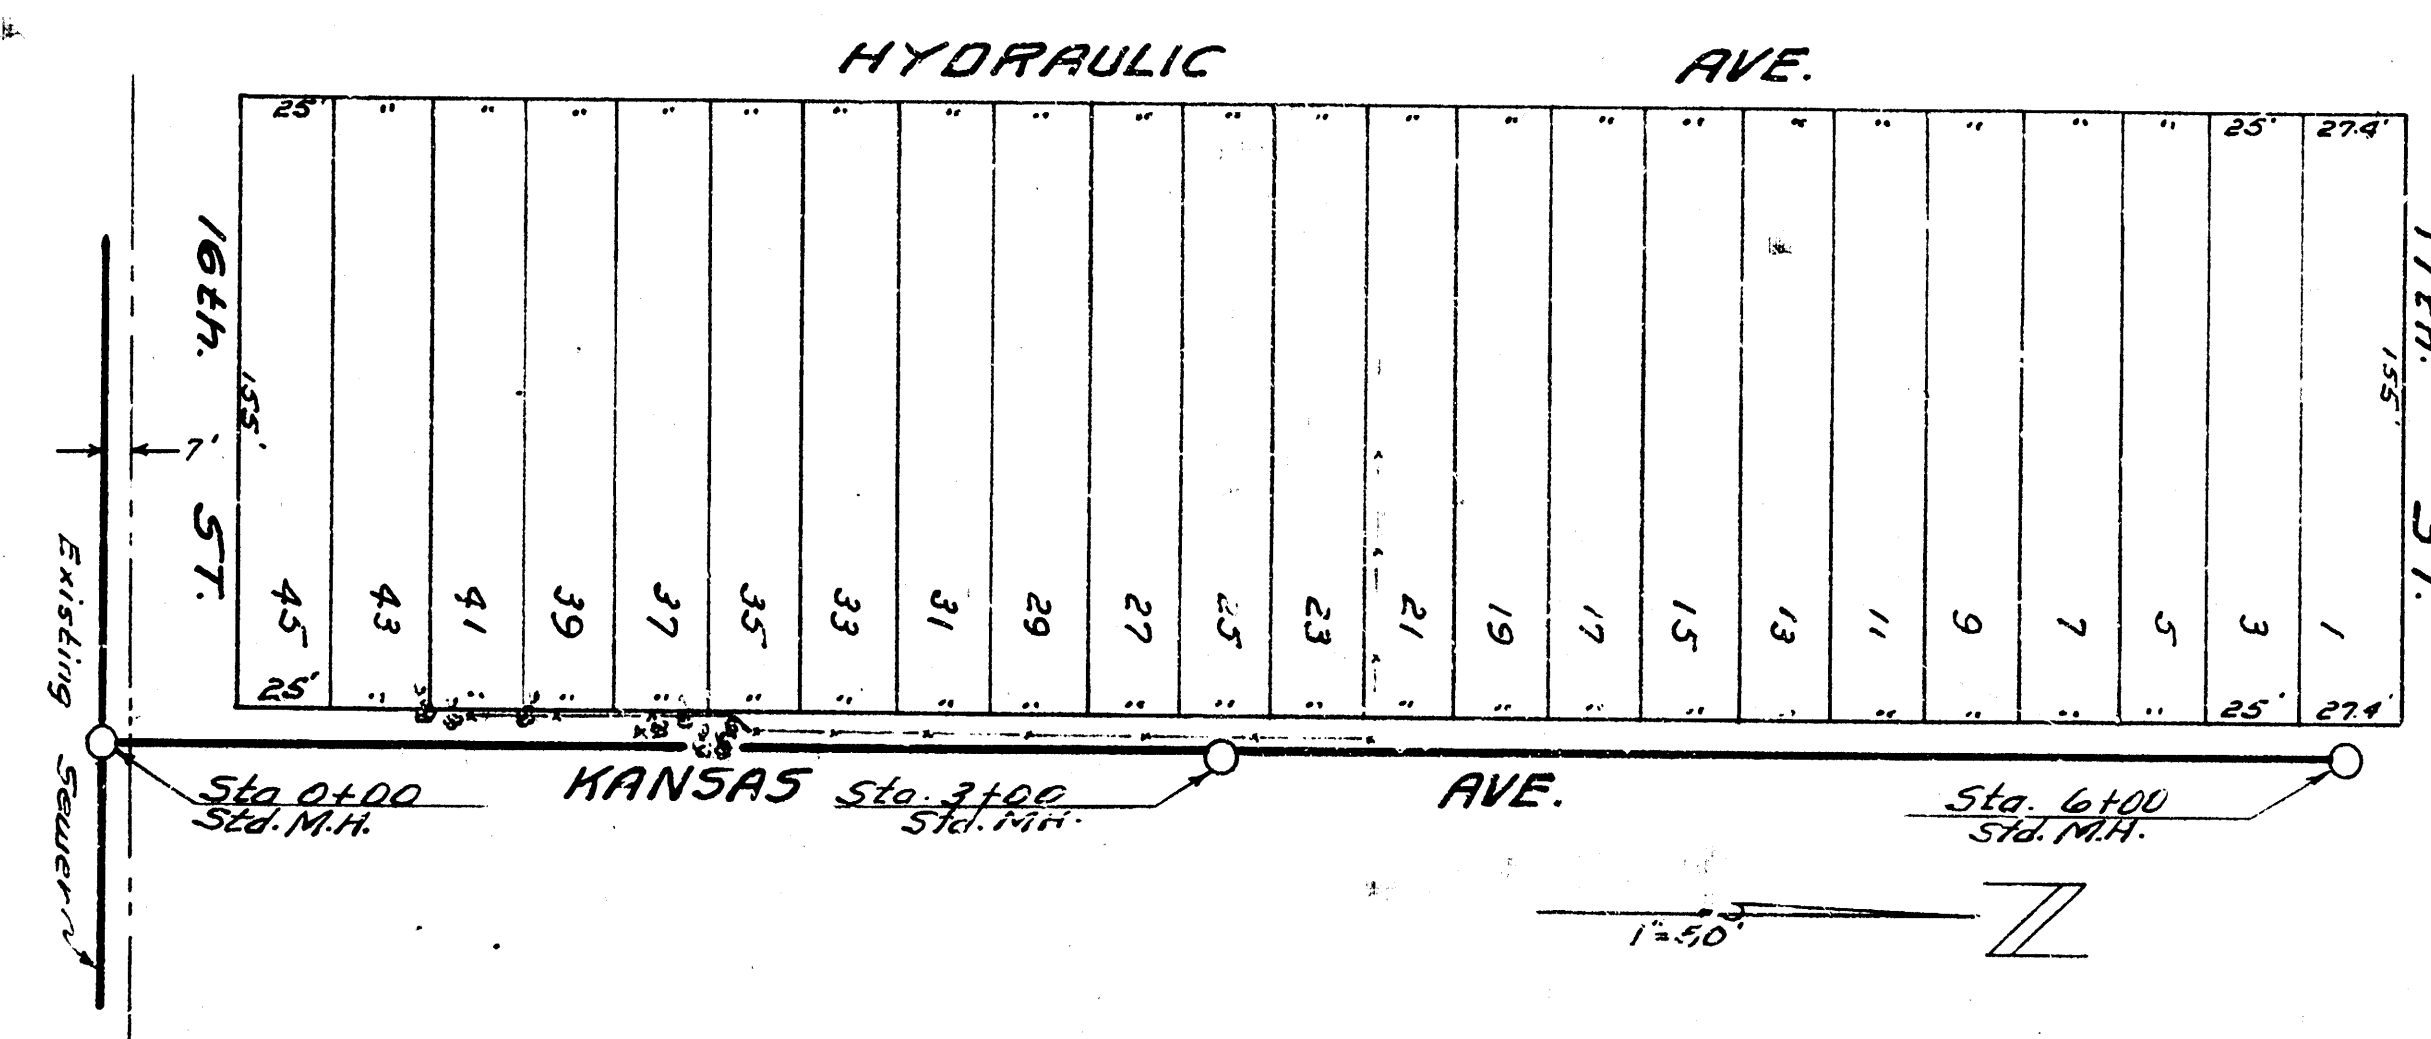