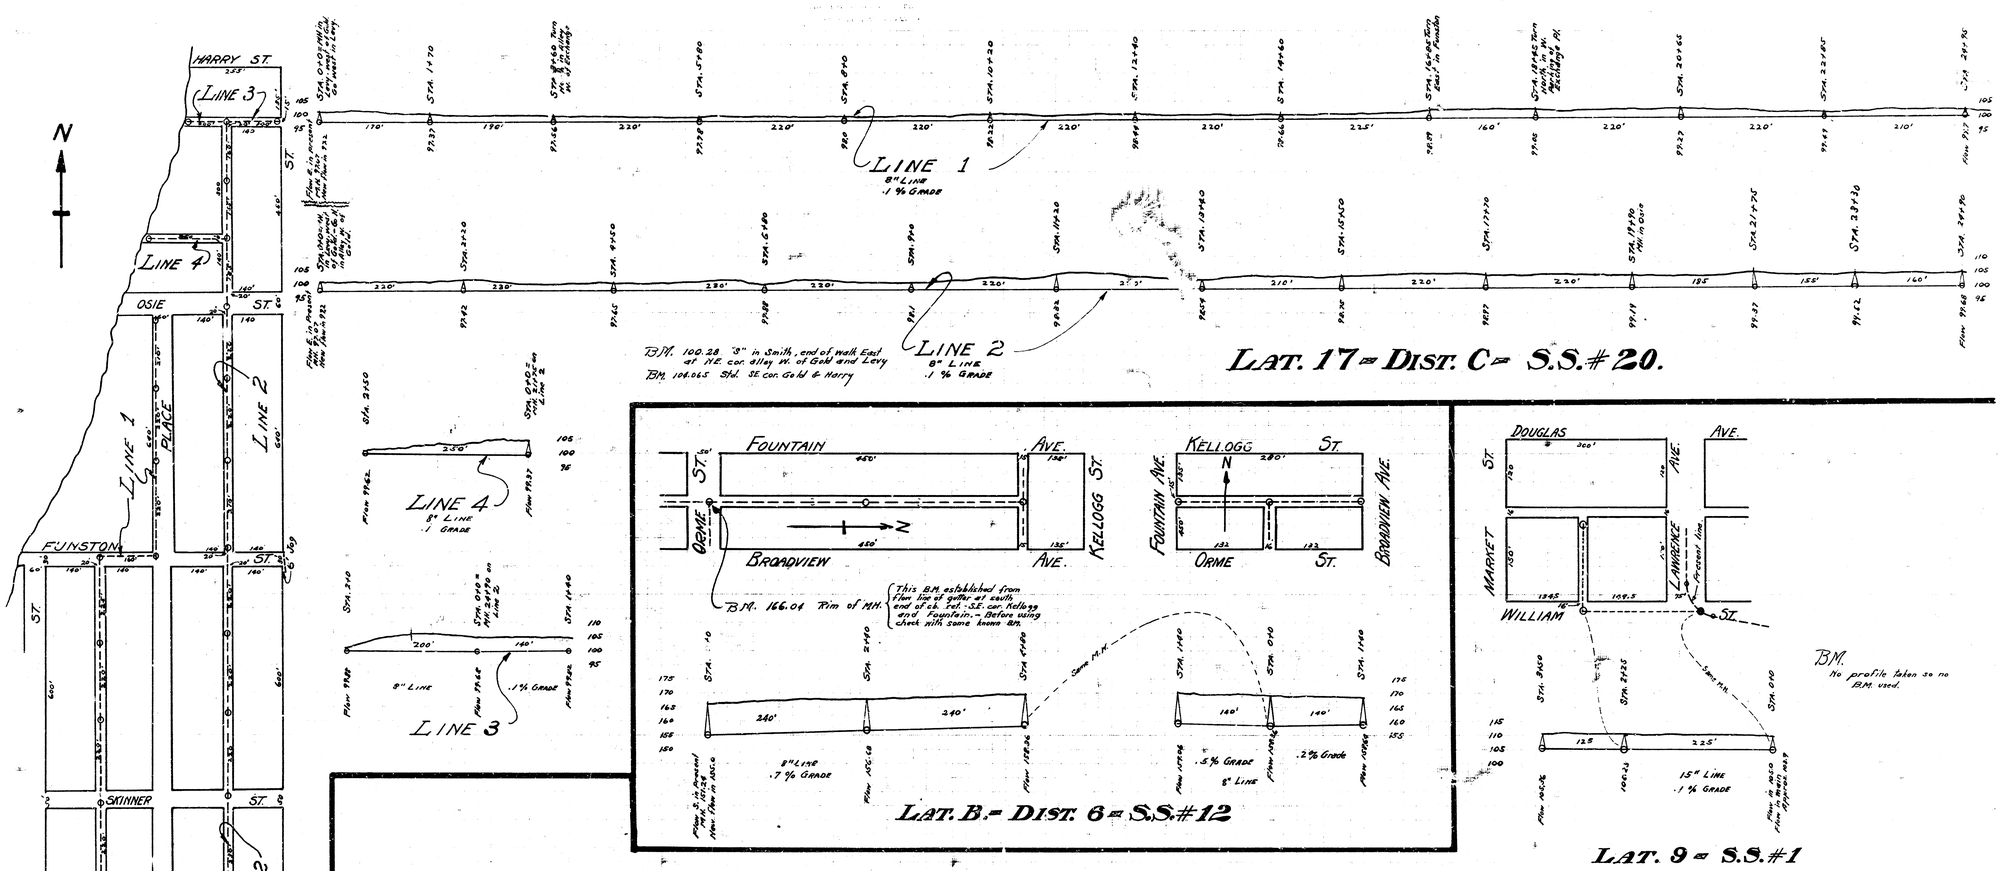
N
HARRY ST.
LINE 3
LINE 4
OSIE ST.
LINE 1
PLACE
LINE 2
FUNSTON ST.
SKINNER ST.
SILVER
LINE 1
EXCHANGE
LINE 2
GOLD
LEVY ST.
LINE 1
8" LINE
.1 % GRADE
LINE 2
8" LINE
.1 % GRADE
B.M. 100.28 "3" in Smith, end of walk East at N.E. cor. Alley W. of Gold and Levy
B.M. 108.065 Std. SE cor. Gold & Harry
LAT. 17 = DIST. C = S.S.# 20.
LINE 4
8" LINE
.1 GRADE
LINE 3
8" LINE
.1% GRADE
FOUNTAIN AVE.
BROADVIEW AVE.
ORME ST.
KELLOGG ST.
B.M. 166.04 Rim of MH.
This B.M. established from Flow line of gutter at south end of cb. rel. S.E. cor. Kellogg and Fountain. - Before using check with some known B.M.
8" LINE
.7 % GRADE
.5% GRADE
8" LINE
.2% Grade
LAT. B. = DIST. 6 = S.S.# 12
KELLOGG ST.
FOUNTAIN AVE.
ORME ST.
BROADVIEW AVE.
DOUGLAS AVE.
MARKET ST.
LAWRENCE ST.
WILLIAM ST.
Present line
B.M.
No profile taken so no B.M. used.
15" LINE
.1 % GRADE
LAT. 9 = S.S.#1