

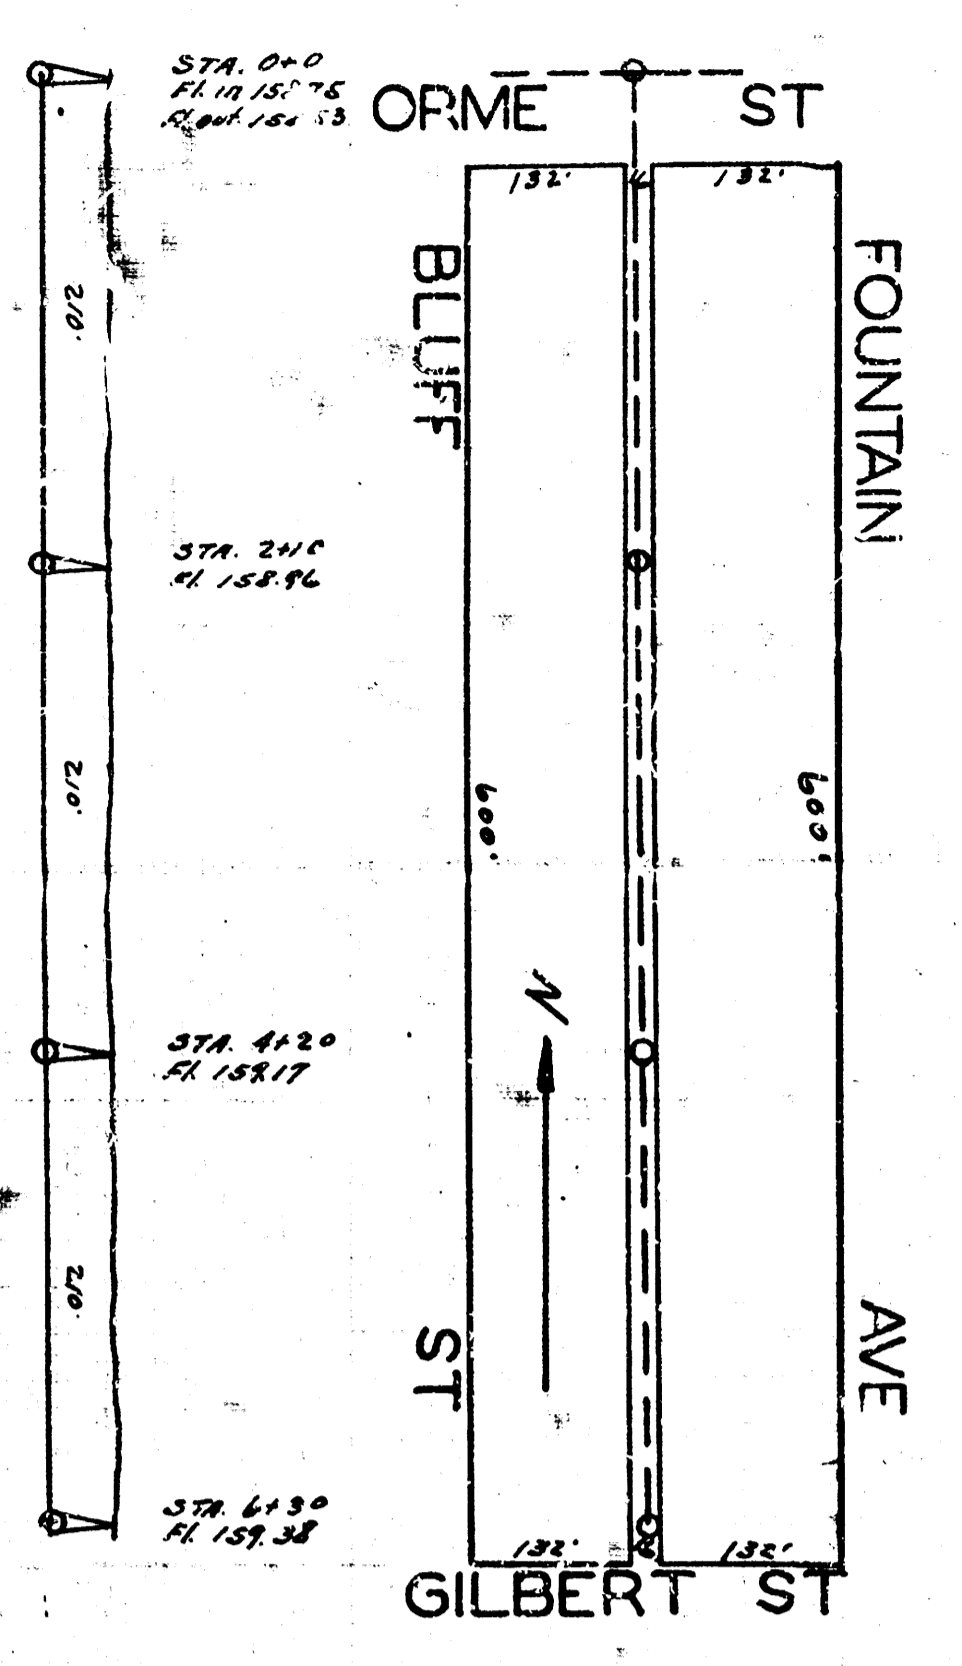


1/2" = 100' (Vertical Scale)  
 1/4" = 100' (Horizontal Scale)





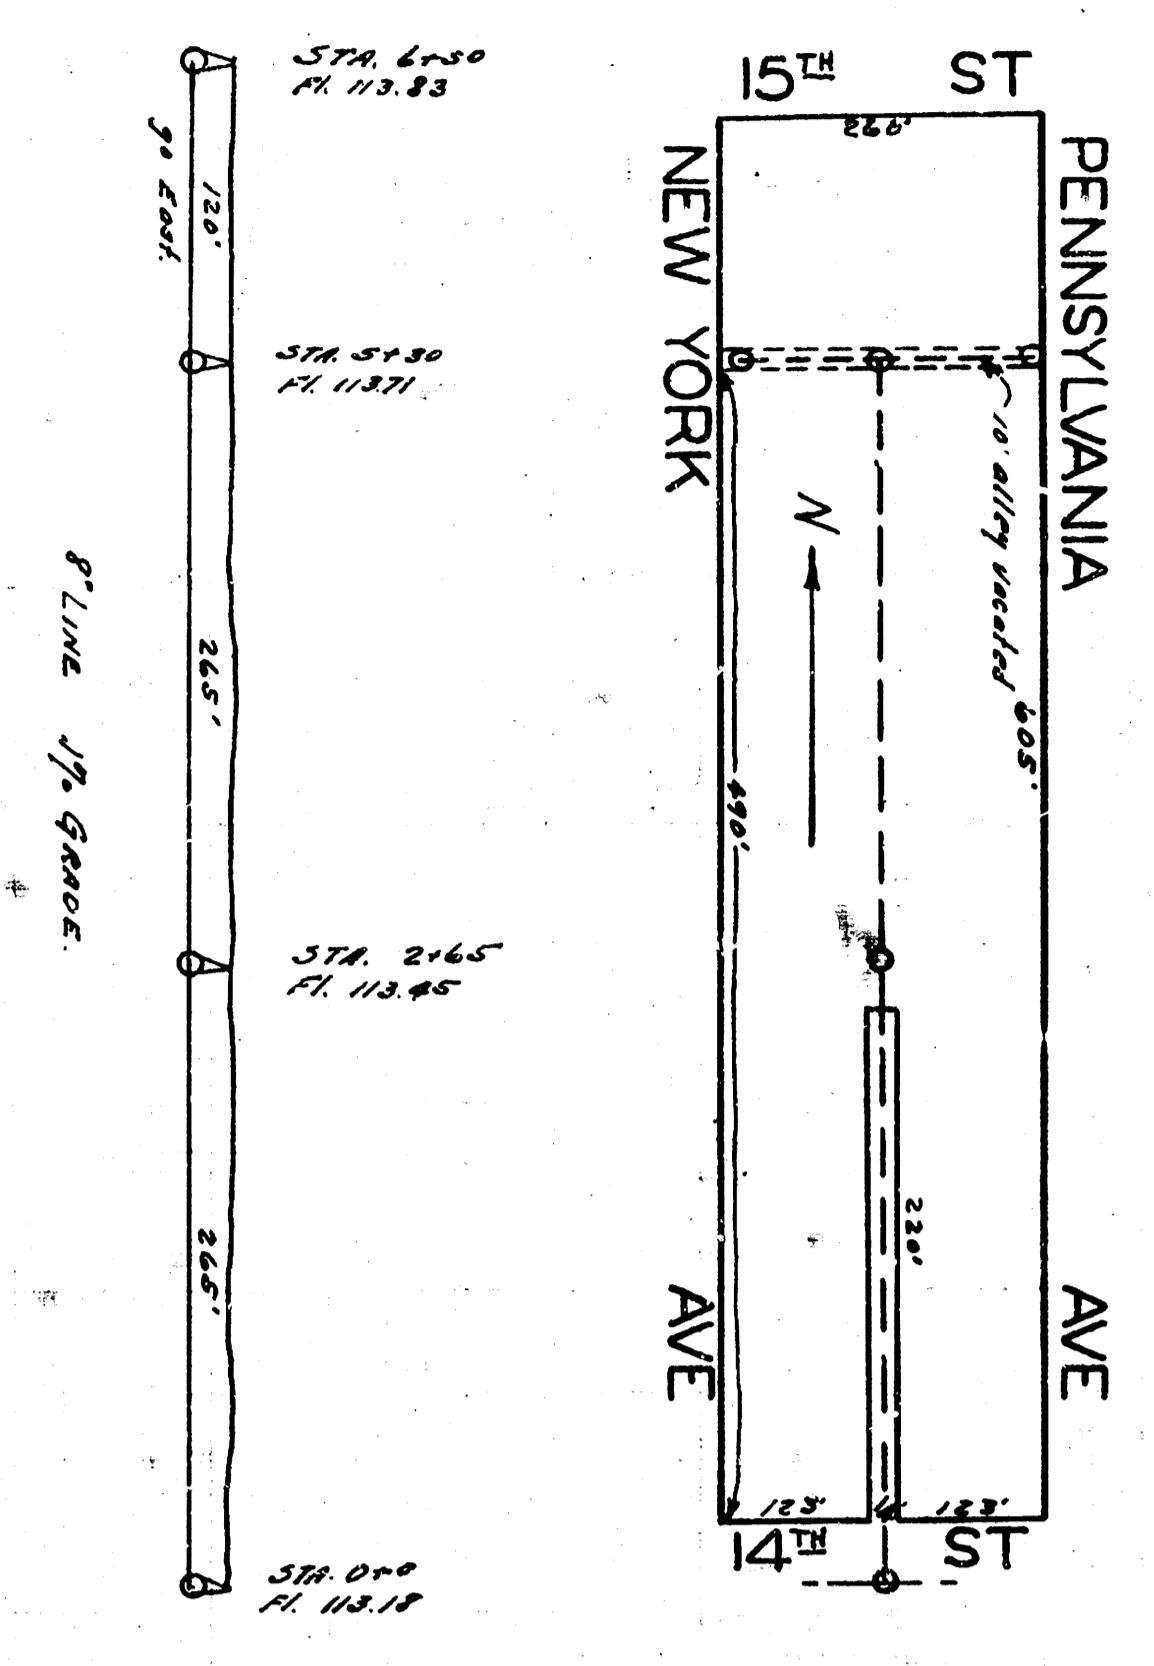


LAT. H, DIST. 6,  
 S.S. 12.

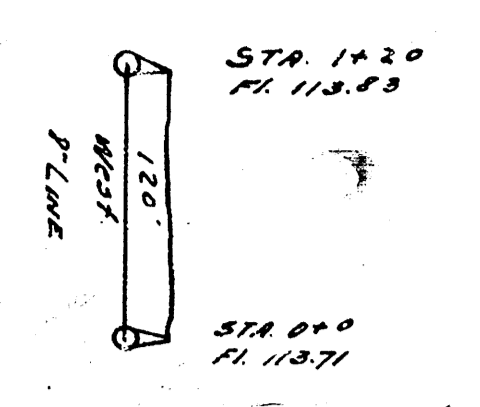

LAT. C, DIST. R, S.S. 12.

8" LINE 1/8" GRADE  
 8" LINE 1/8" GRADE

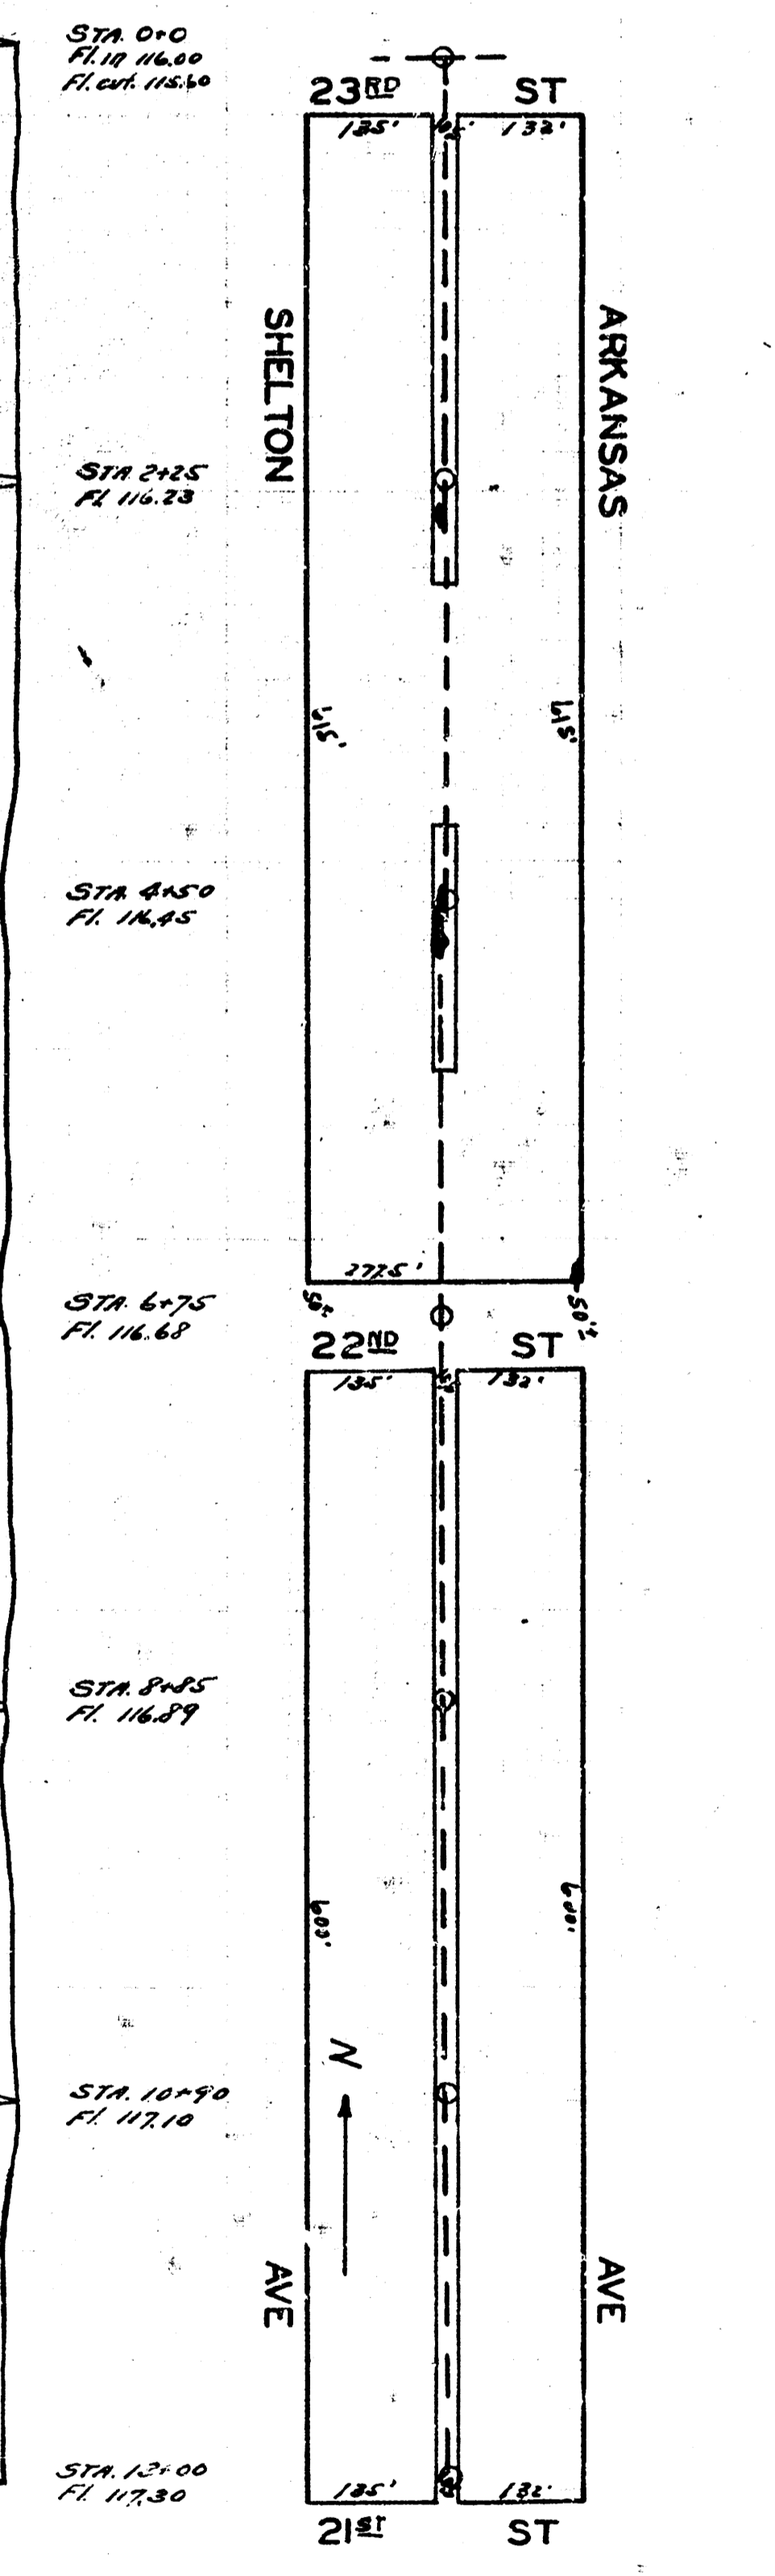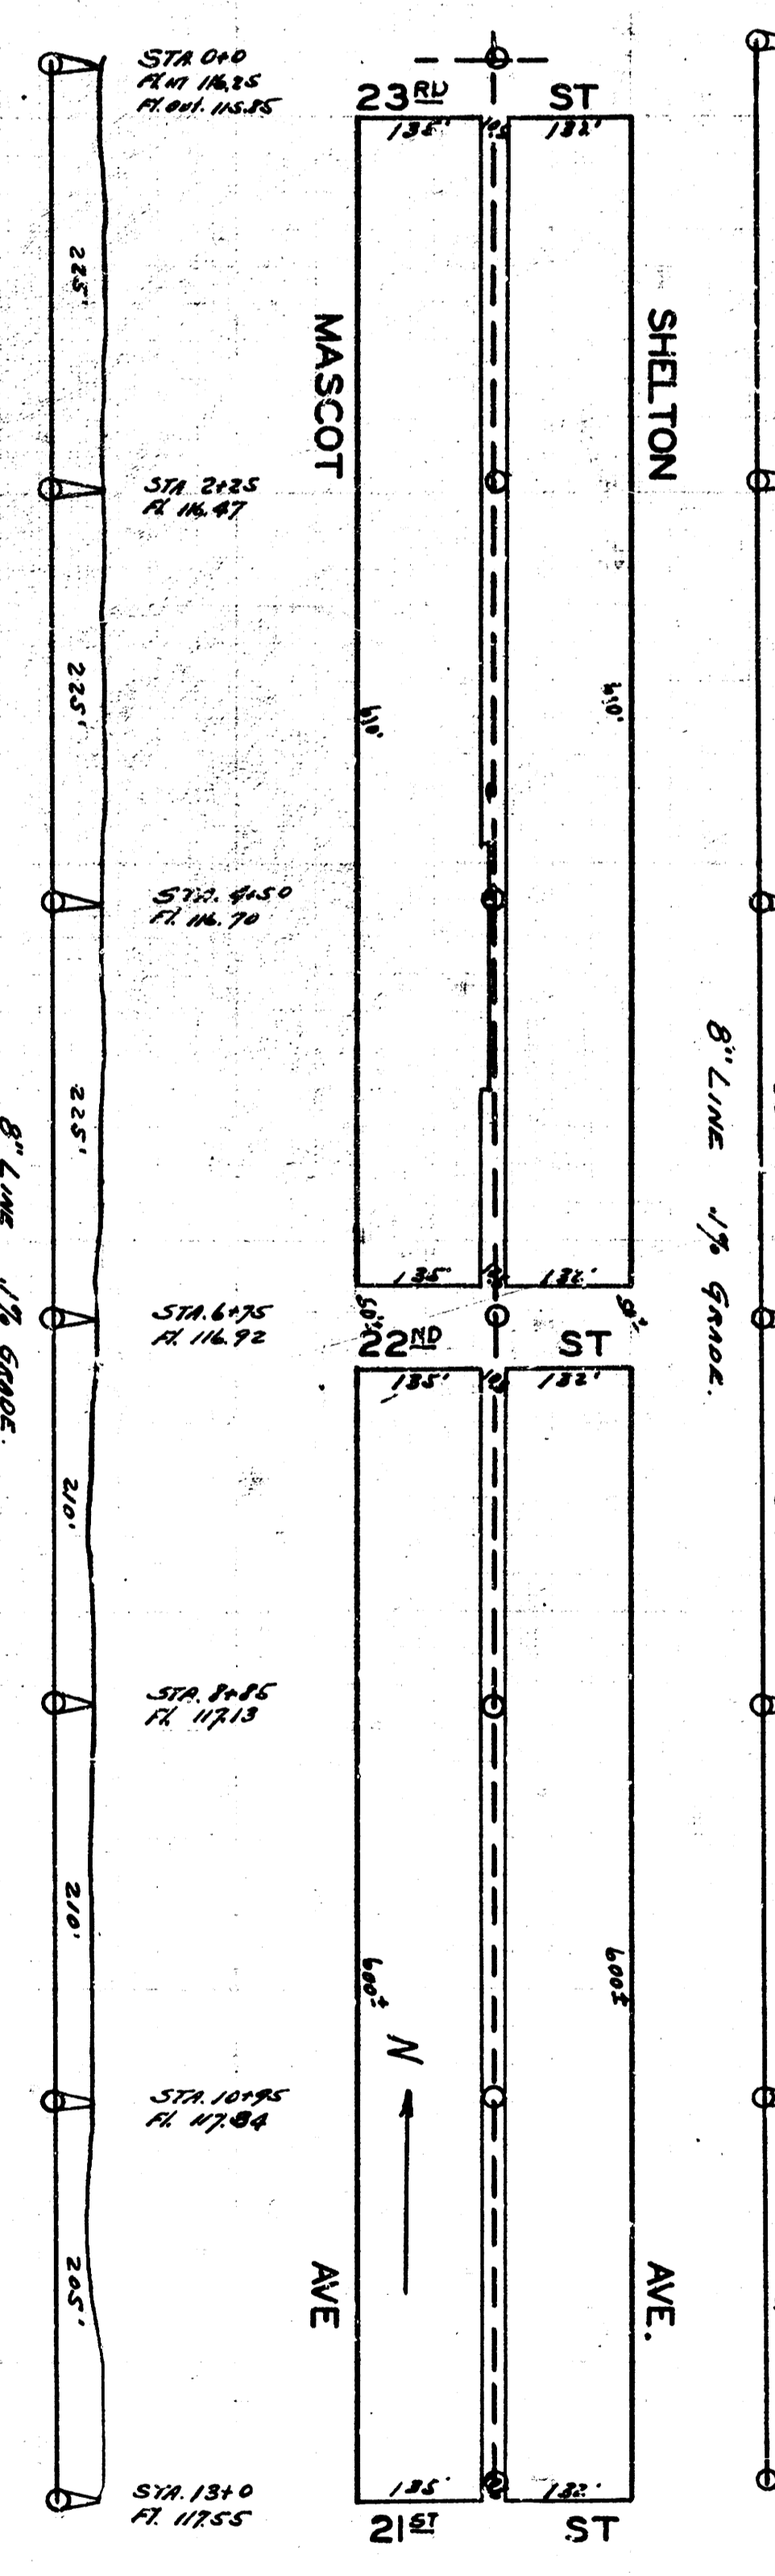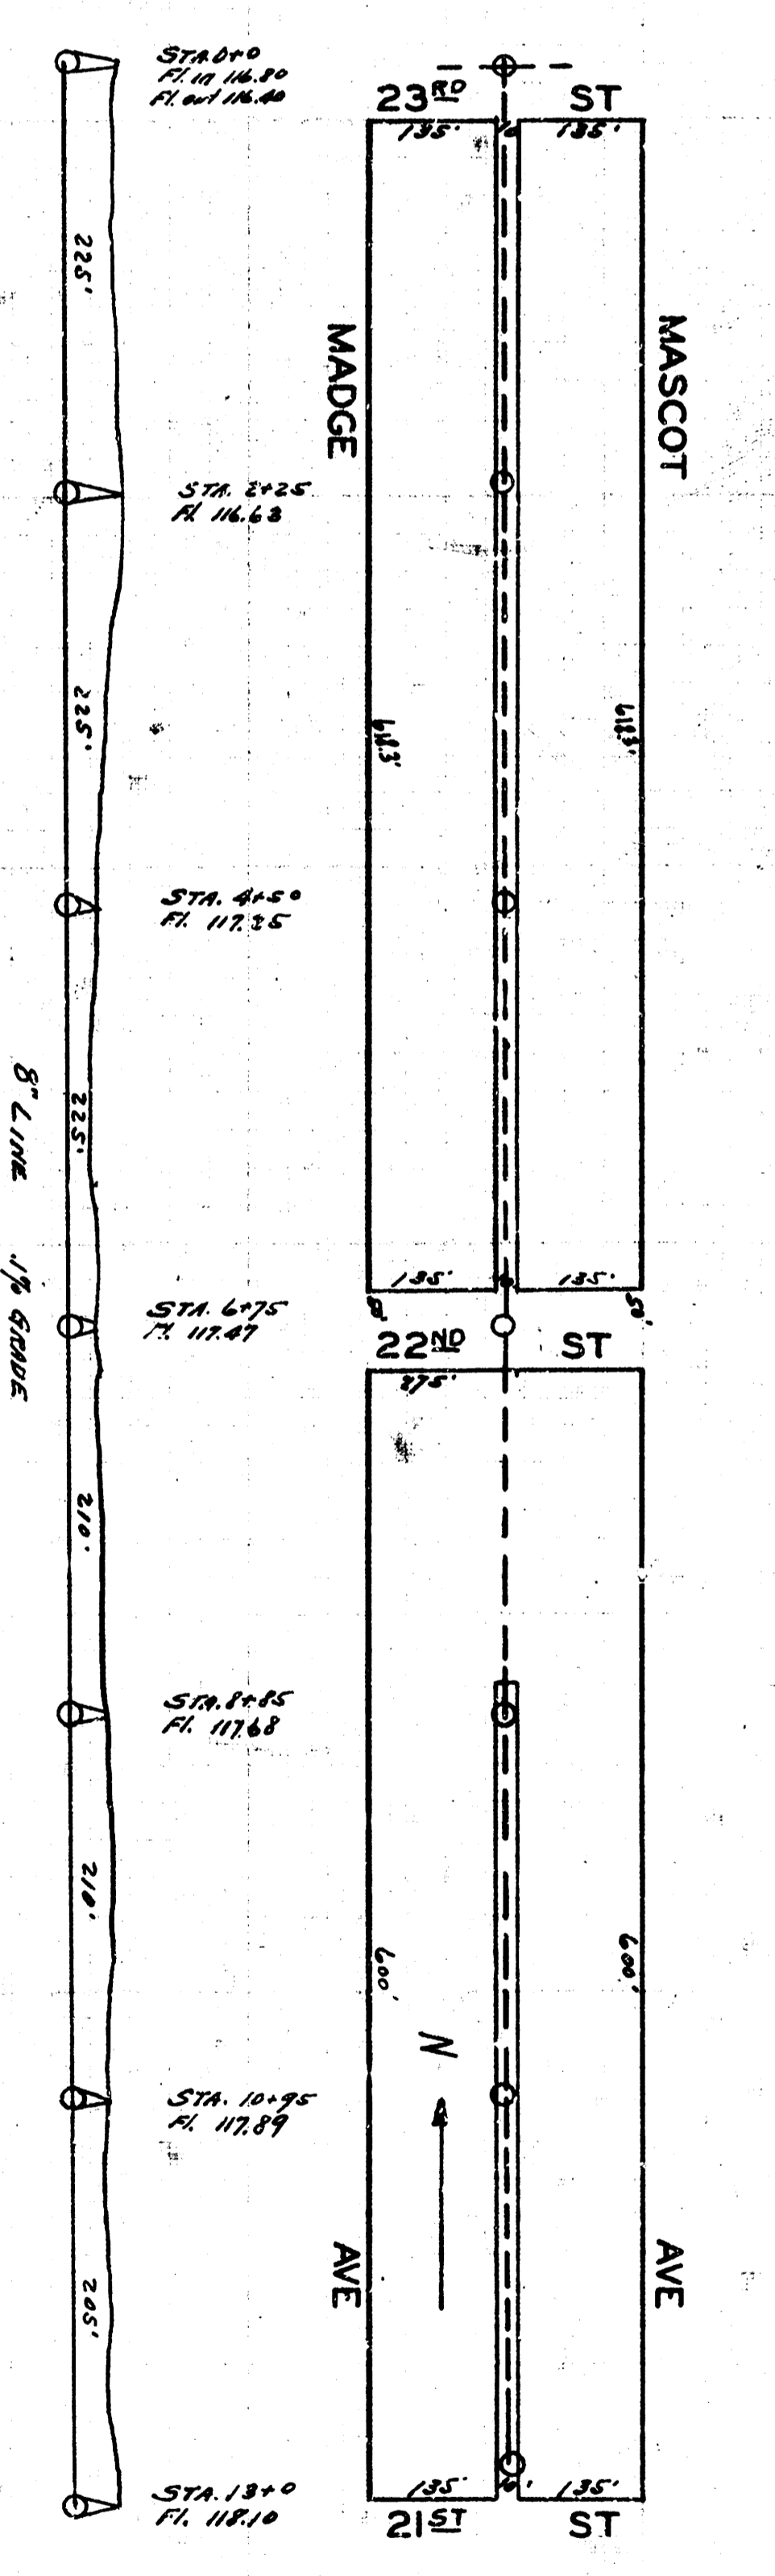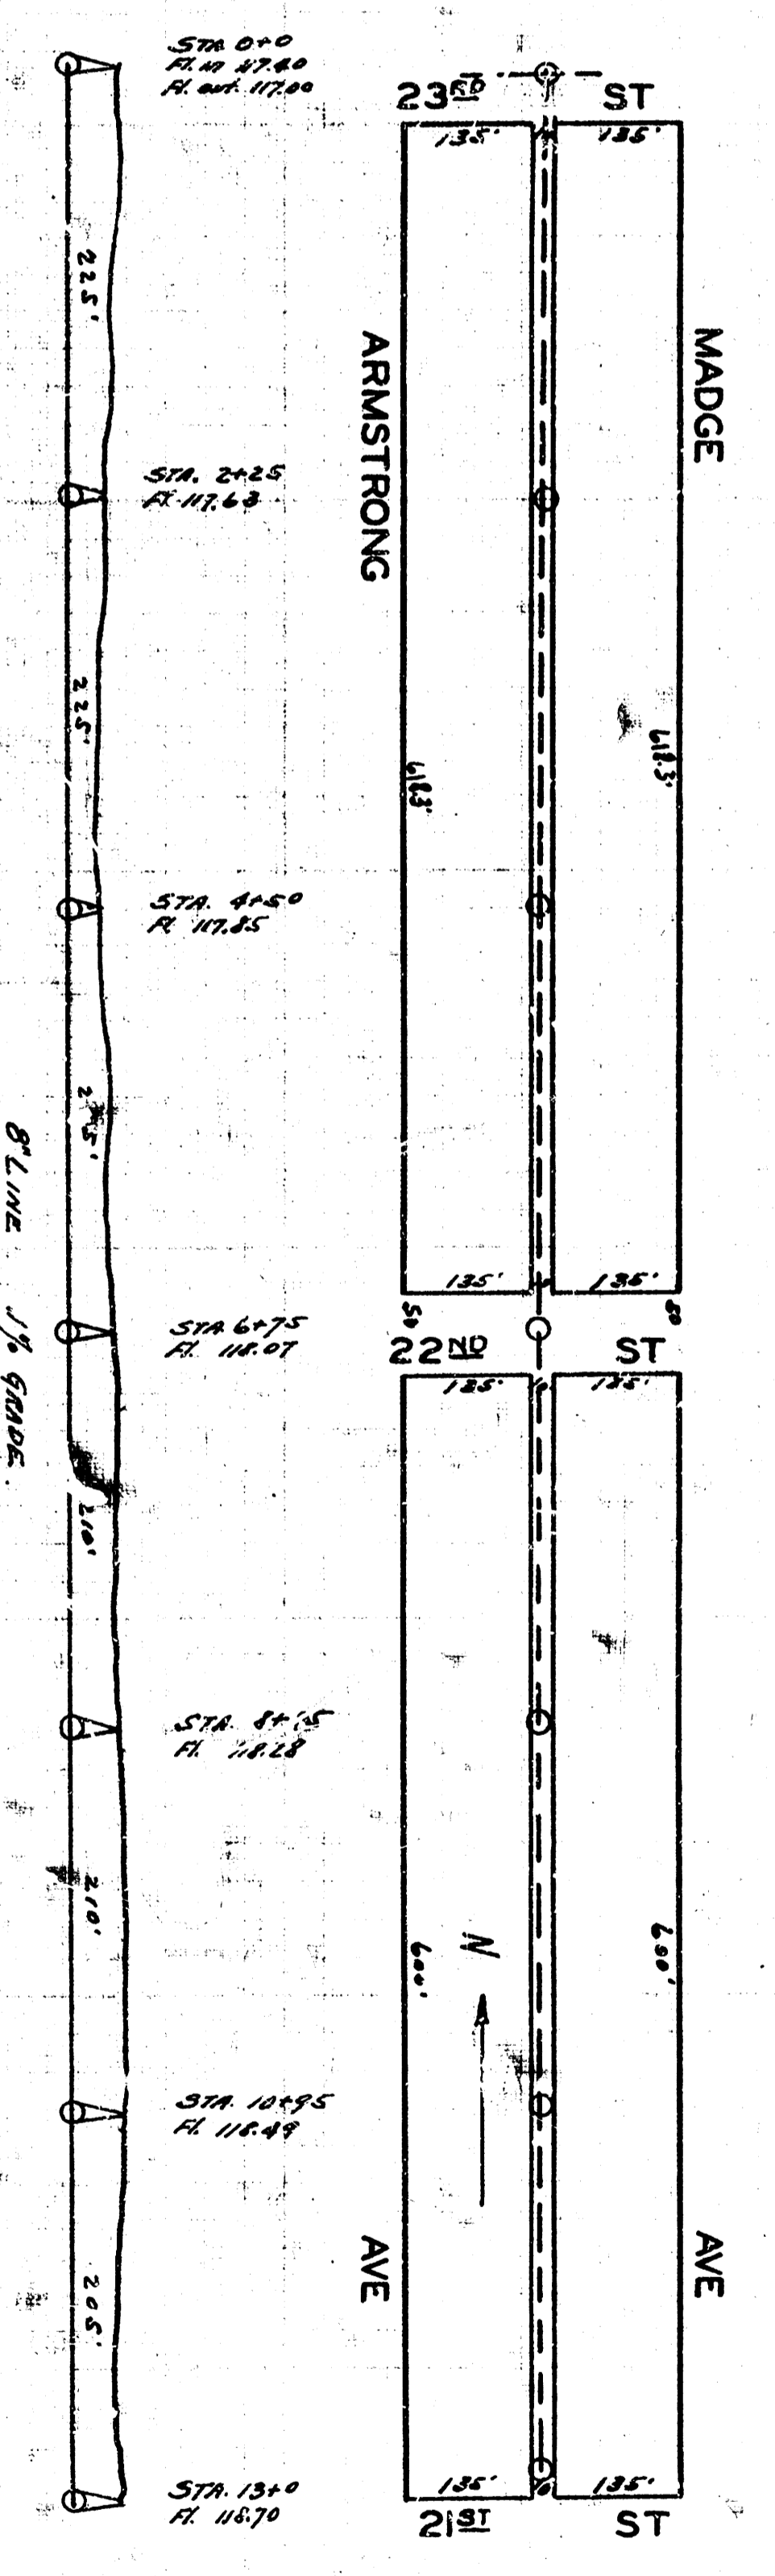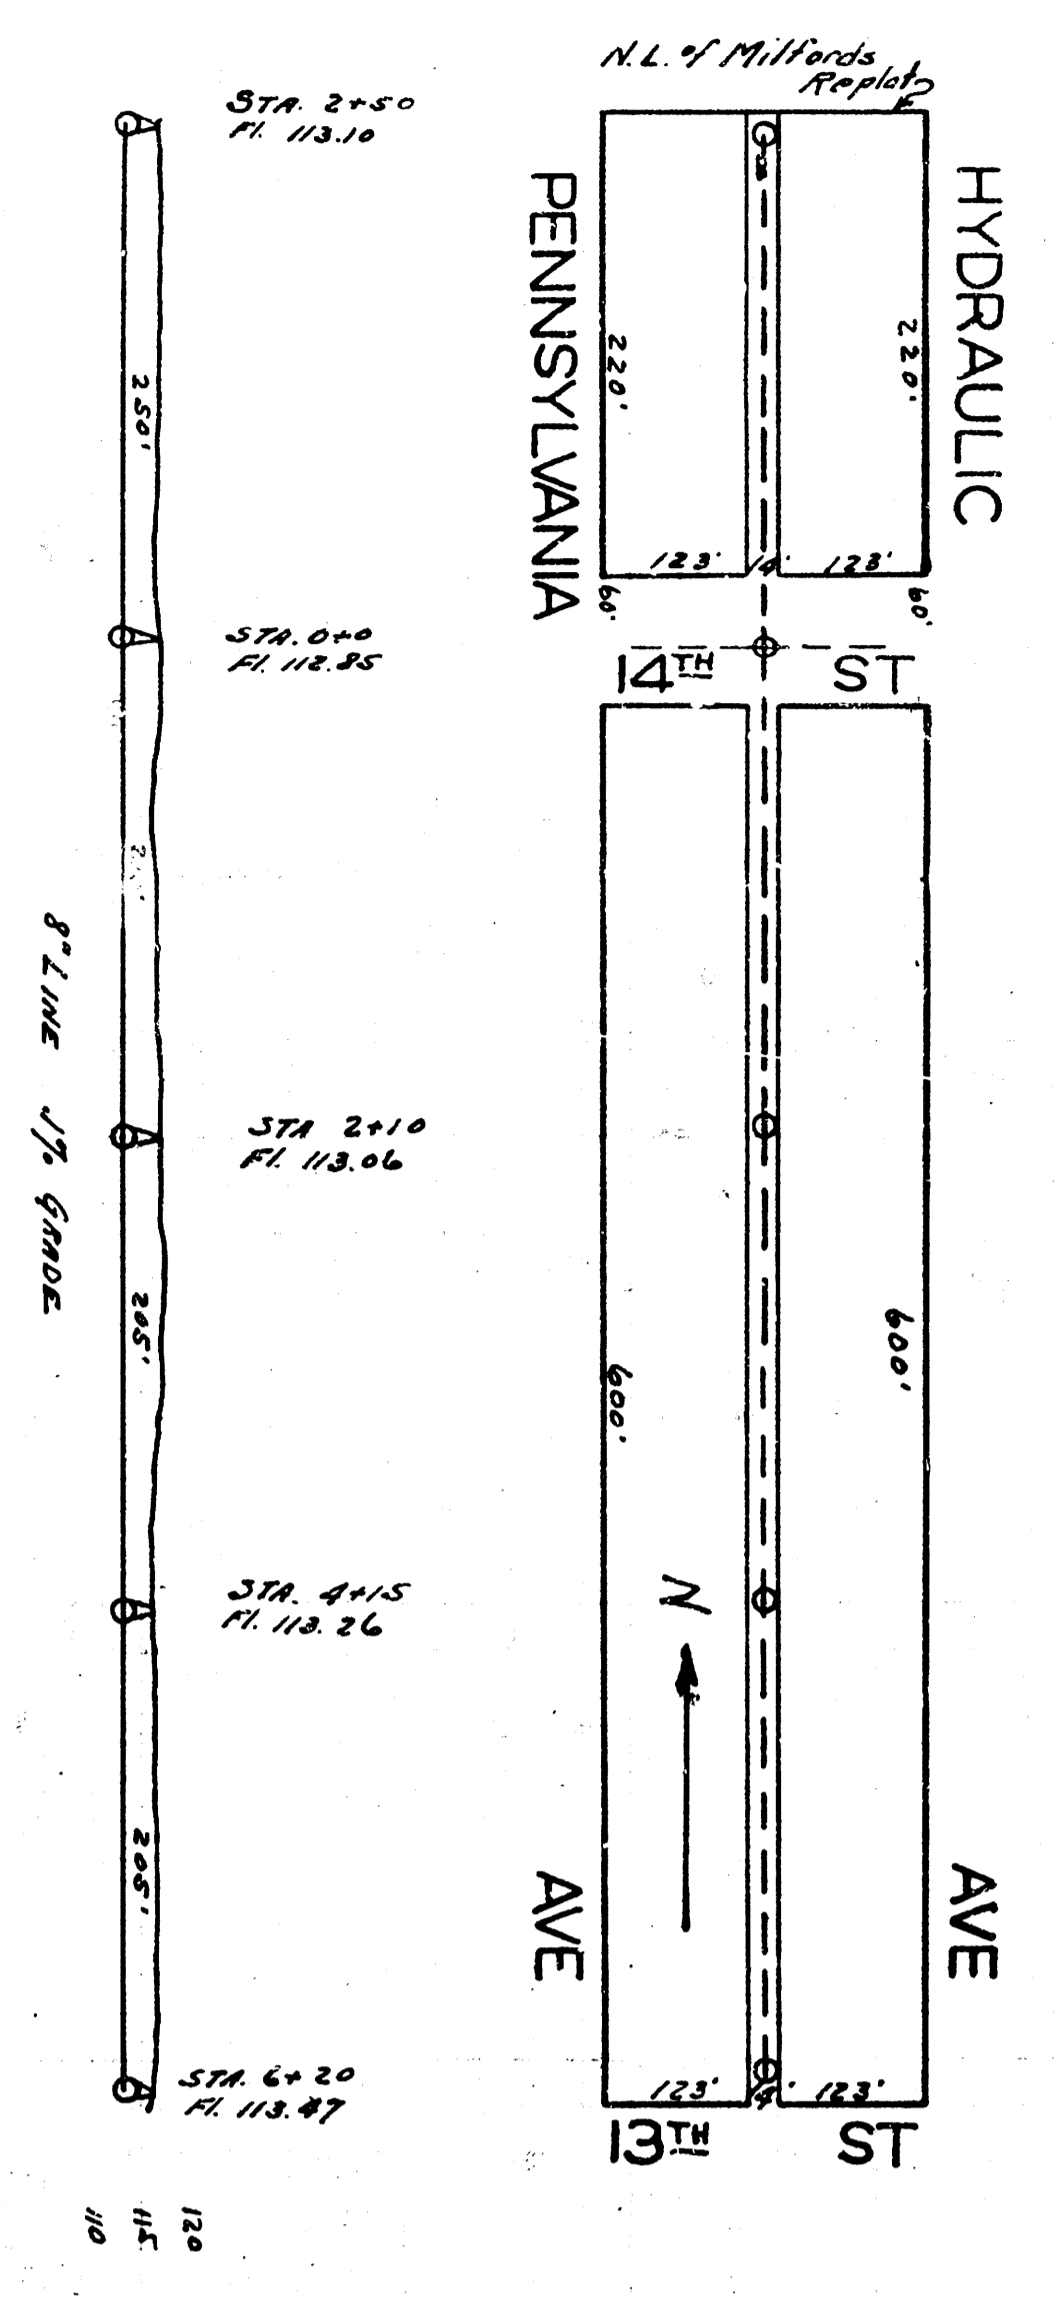

LAT. E, DIST. T, S.S. 20.

8" LINE 1/8" GRADE  
 8" LINE 1/8" GRADE