



GENERAL NOTES
See ATTACHMENT NO. 1 in Spot Elevation Book

GLENDALE AVE.

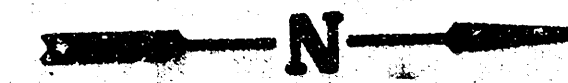


SCALE: 1" = 20' Plan
1" = 5' Profile


Bench Marks: 176.92 - "M" on Fire Hydr. Flange, 3 NW cor.
of Pine and Harding.
174.21 - "X" on Top of N. Side Pine St. @
Approx. 2' Drainage Channel.

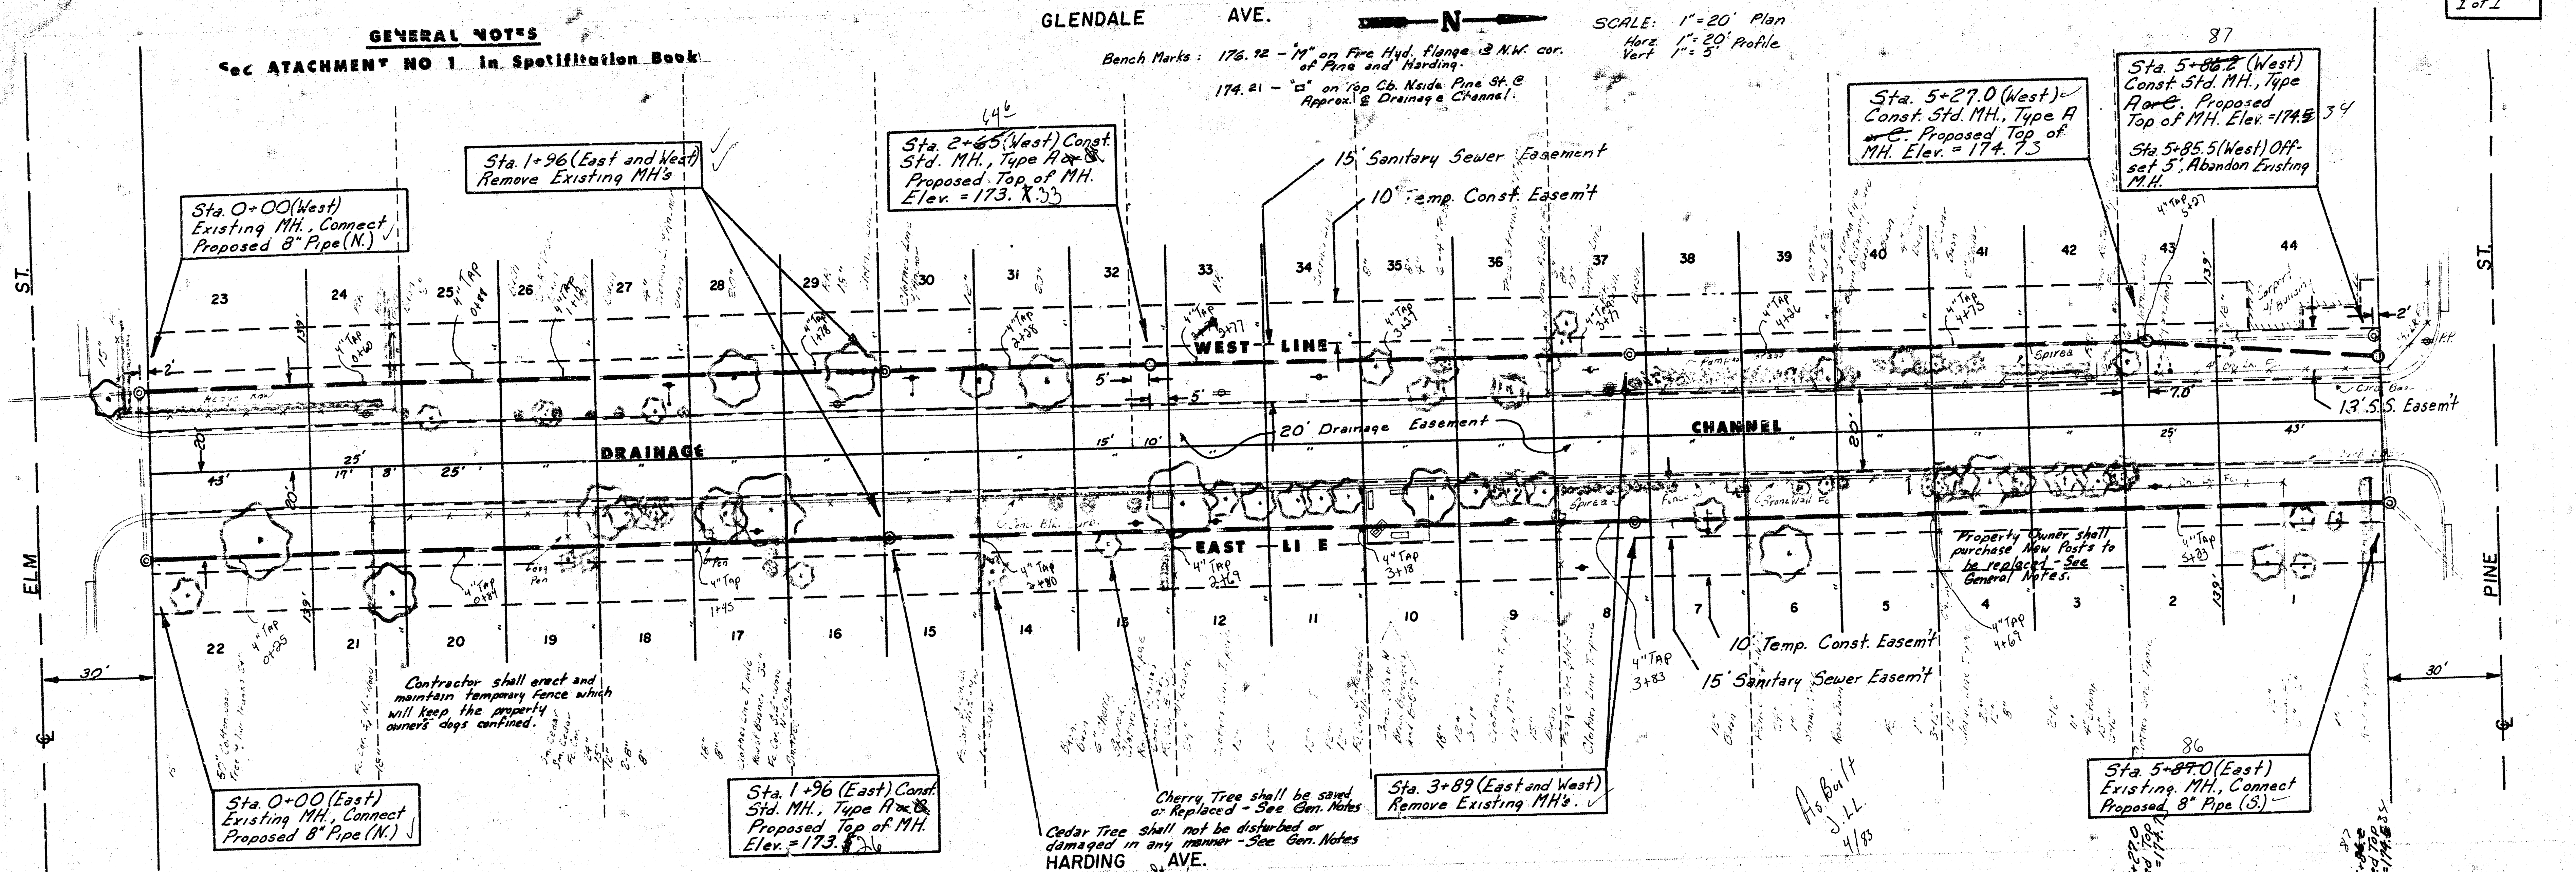

WEST LINE PROFILE

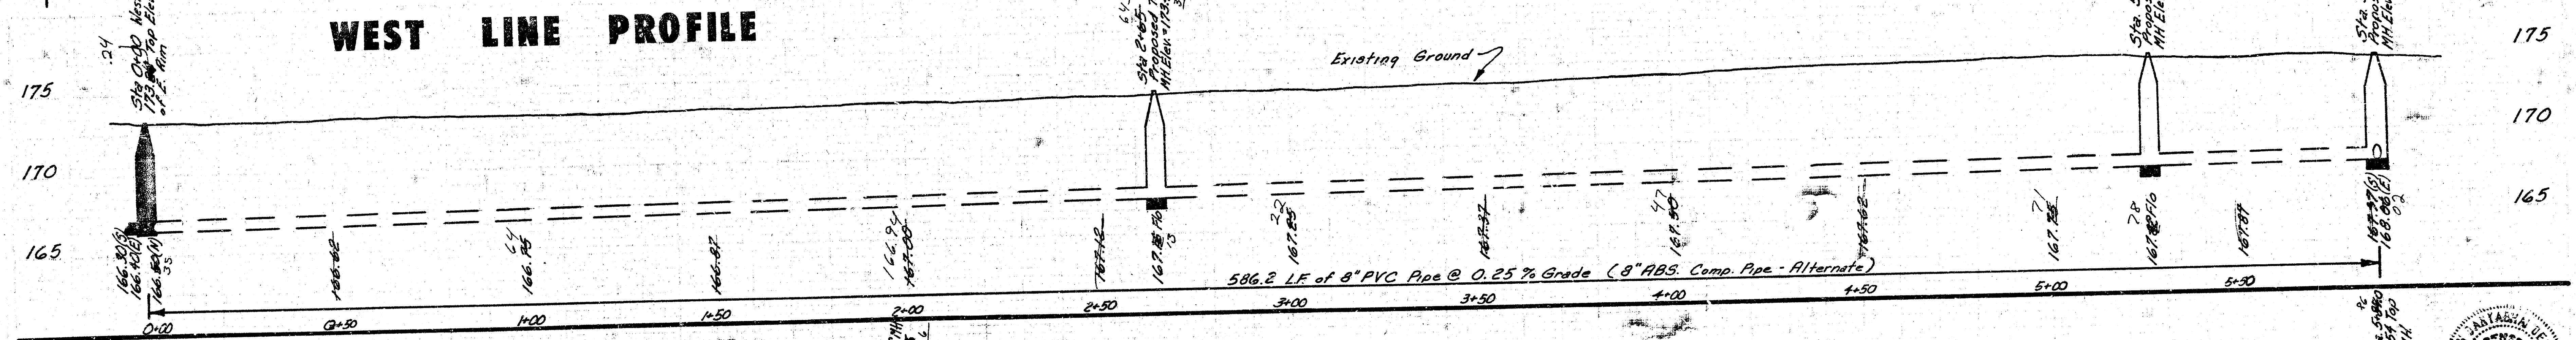

EAST LINE PROFILE

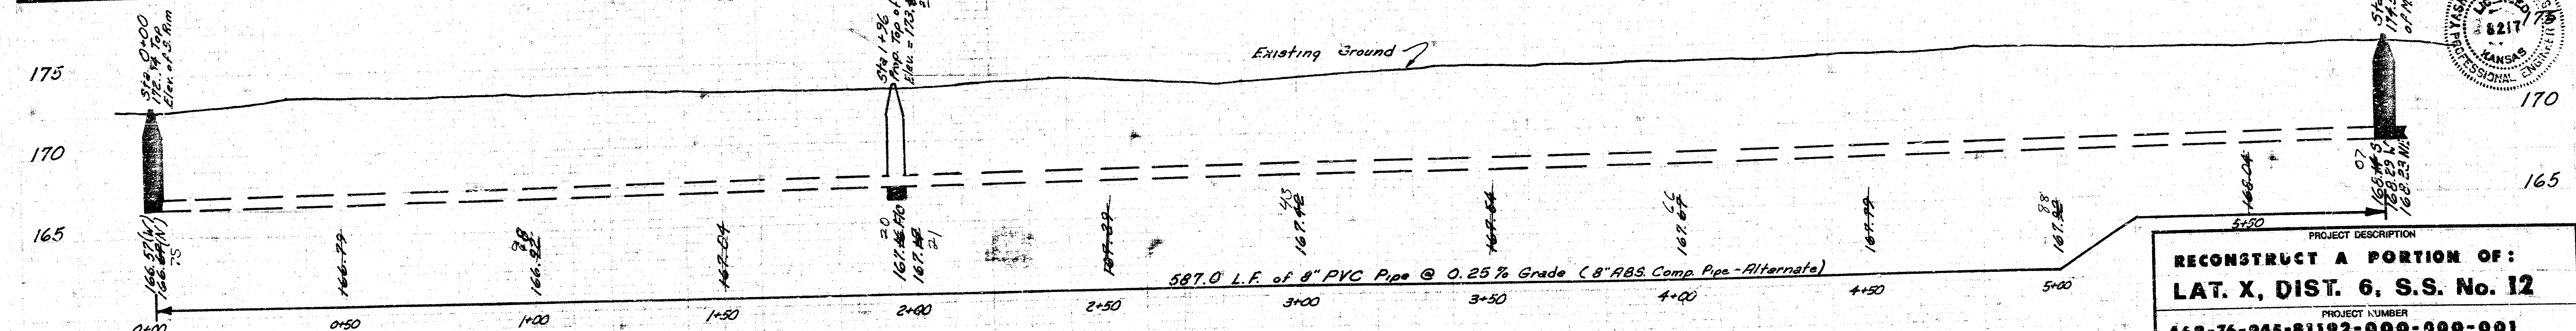

PROJECT DESCRIPTION	
RECONSTRUCT A PORTION OF: LAT. X, DIST. 6, S.S. No. 12	
PROJECT NUMBER 468-76-245-81192-000-000-001	
BOOK NO. DCD-189	APPROVED BY
DRAWN BY LINDSEY	DATE 6/82
CITY OF WICHITA DEPARTMENT OF ENGINEERING	
DIRECTOR OF ENG./CITY ENGINEER R. W. BRUGEMAN	
SCALE 1"	

10 4 3 3