
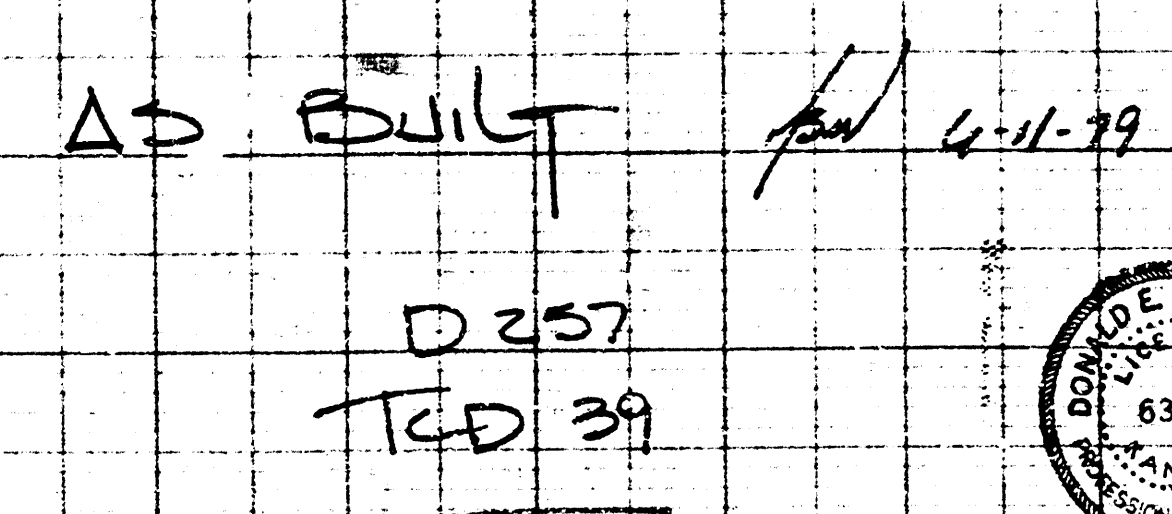


77

PLAN	BY	DATE
NOTED	for	4-22
ALIGNED CHECKED	Franklin	4-23
PI. OF WAY CHECKED		

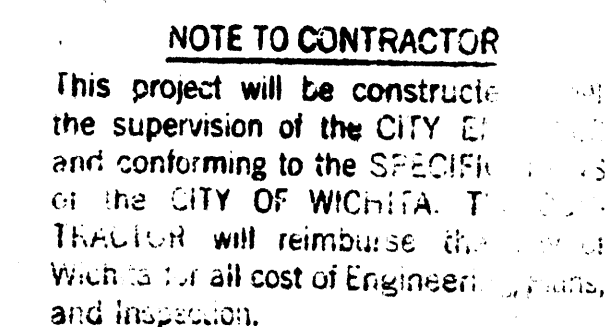

PRIVATE CONTRACT
SANITARY SEWER EXTENSION TO SERVE LOTS 2,4,6,8,
10, AND 12, BLOCK 18, ORIENTA PARK SECOND ADDITION
CITY OF WICHITA, KANSAS
R. W. LINN CITY ENGINEER
DATE: _____ PROJ. NO. 468-76-245-80750-000-000-008

14 e 5 15

FILMED FROM THE BEST