



PLAN	DATE
BY	
CHECKED	
APPROVED	
NO. OF SHEETS	
NO. OF SHEETS	

PROFILE	DATE
BY	
CHECKED	
APPROVED	
NO. OF SHEETS	
NO. OF SHEETS	

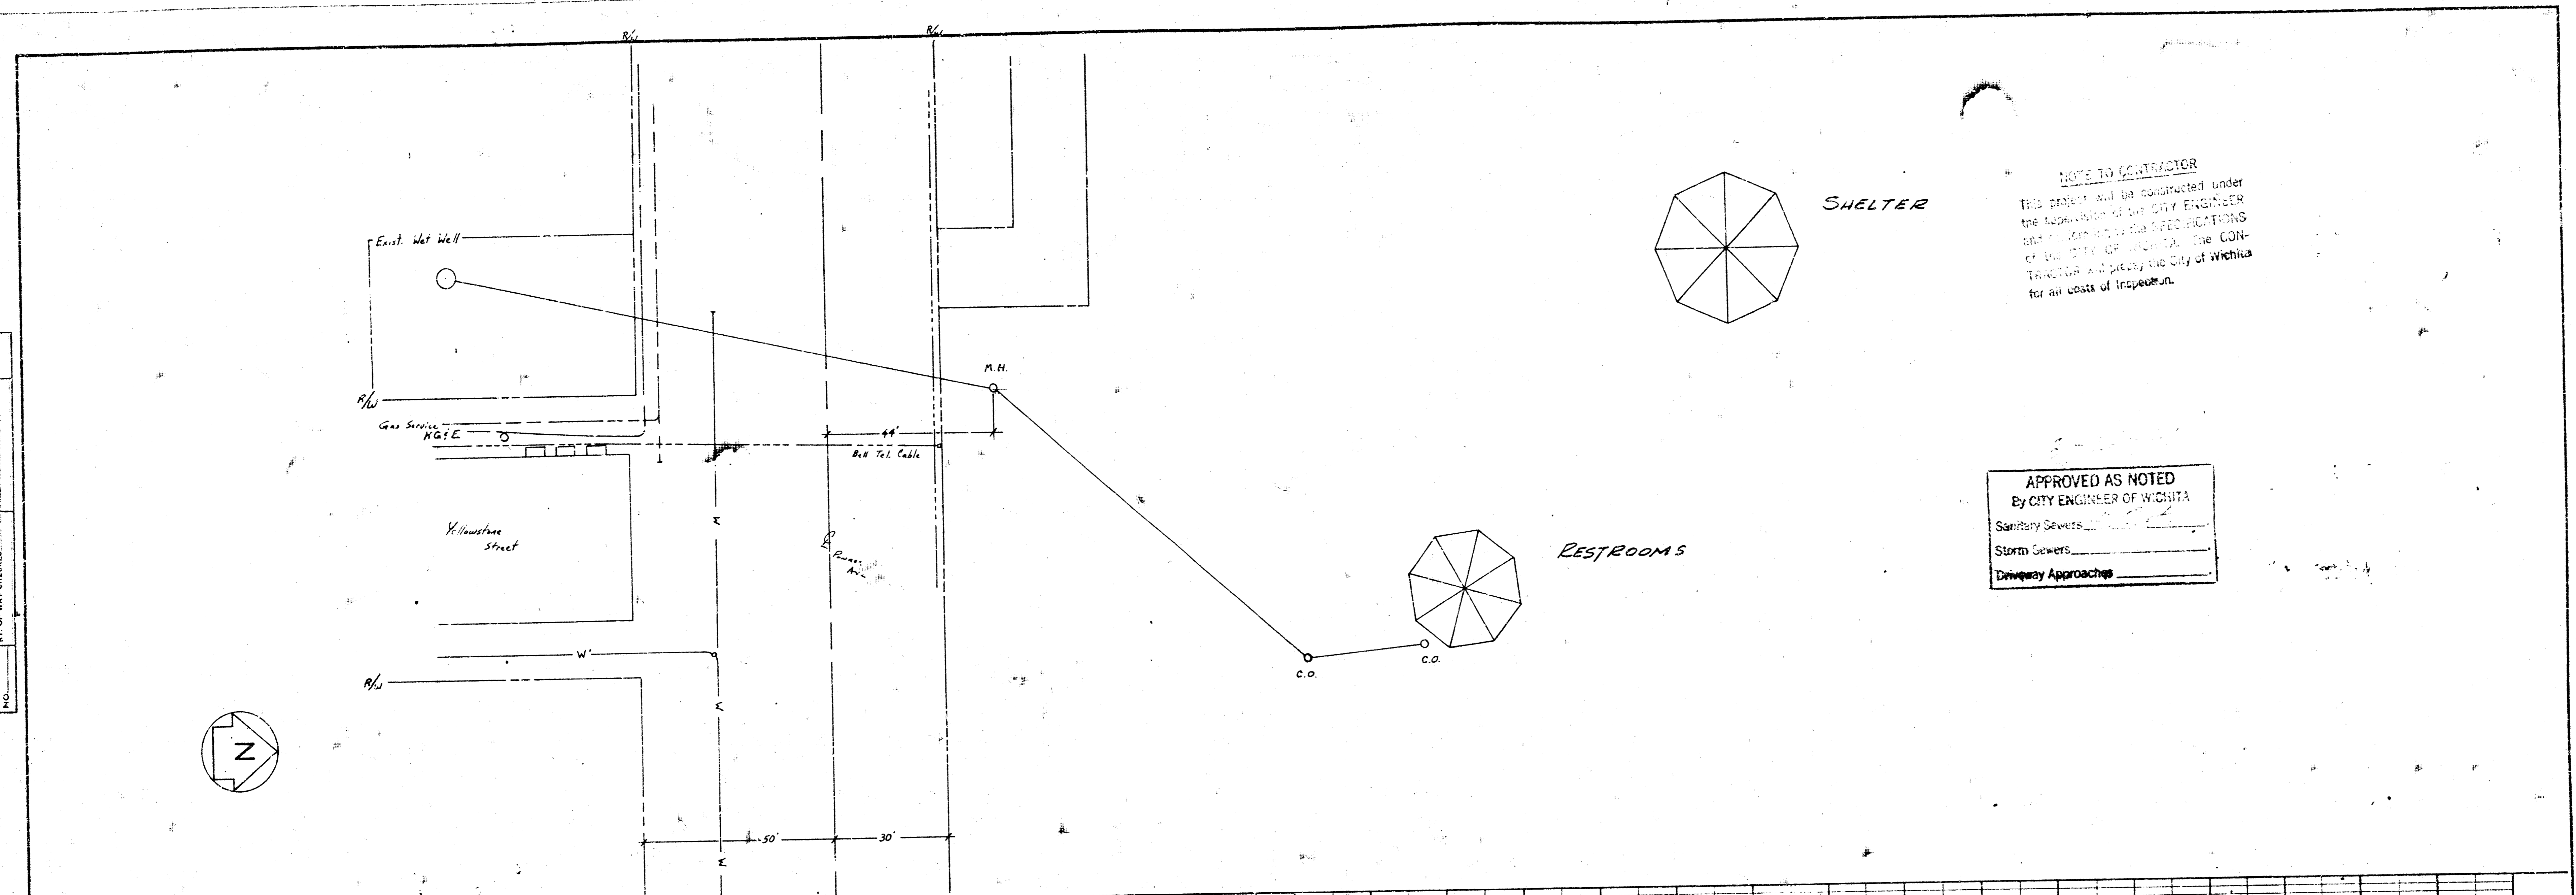

**NOTE TO CONTRACTOR**  
 This project will be constructed under the supervision of the CITY ENGINEER and in accordance with the SPECIFICATIONS of the CITY OF WICHITA. The CONTRACTOR will please the City of Wichita for all costs of inspection.

**APPROVED AS NOTED**  
 By CITY ENGINEER OF WICHITA  
 Sanitary Sewers \_\_\_\_\_  
 Storm Sewers \_\_\_\_\_  
 Driveway Approaches \_\_\_\_\_

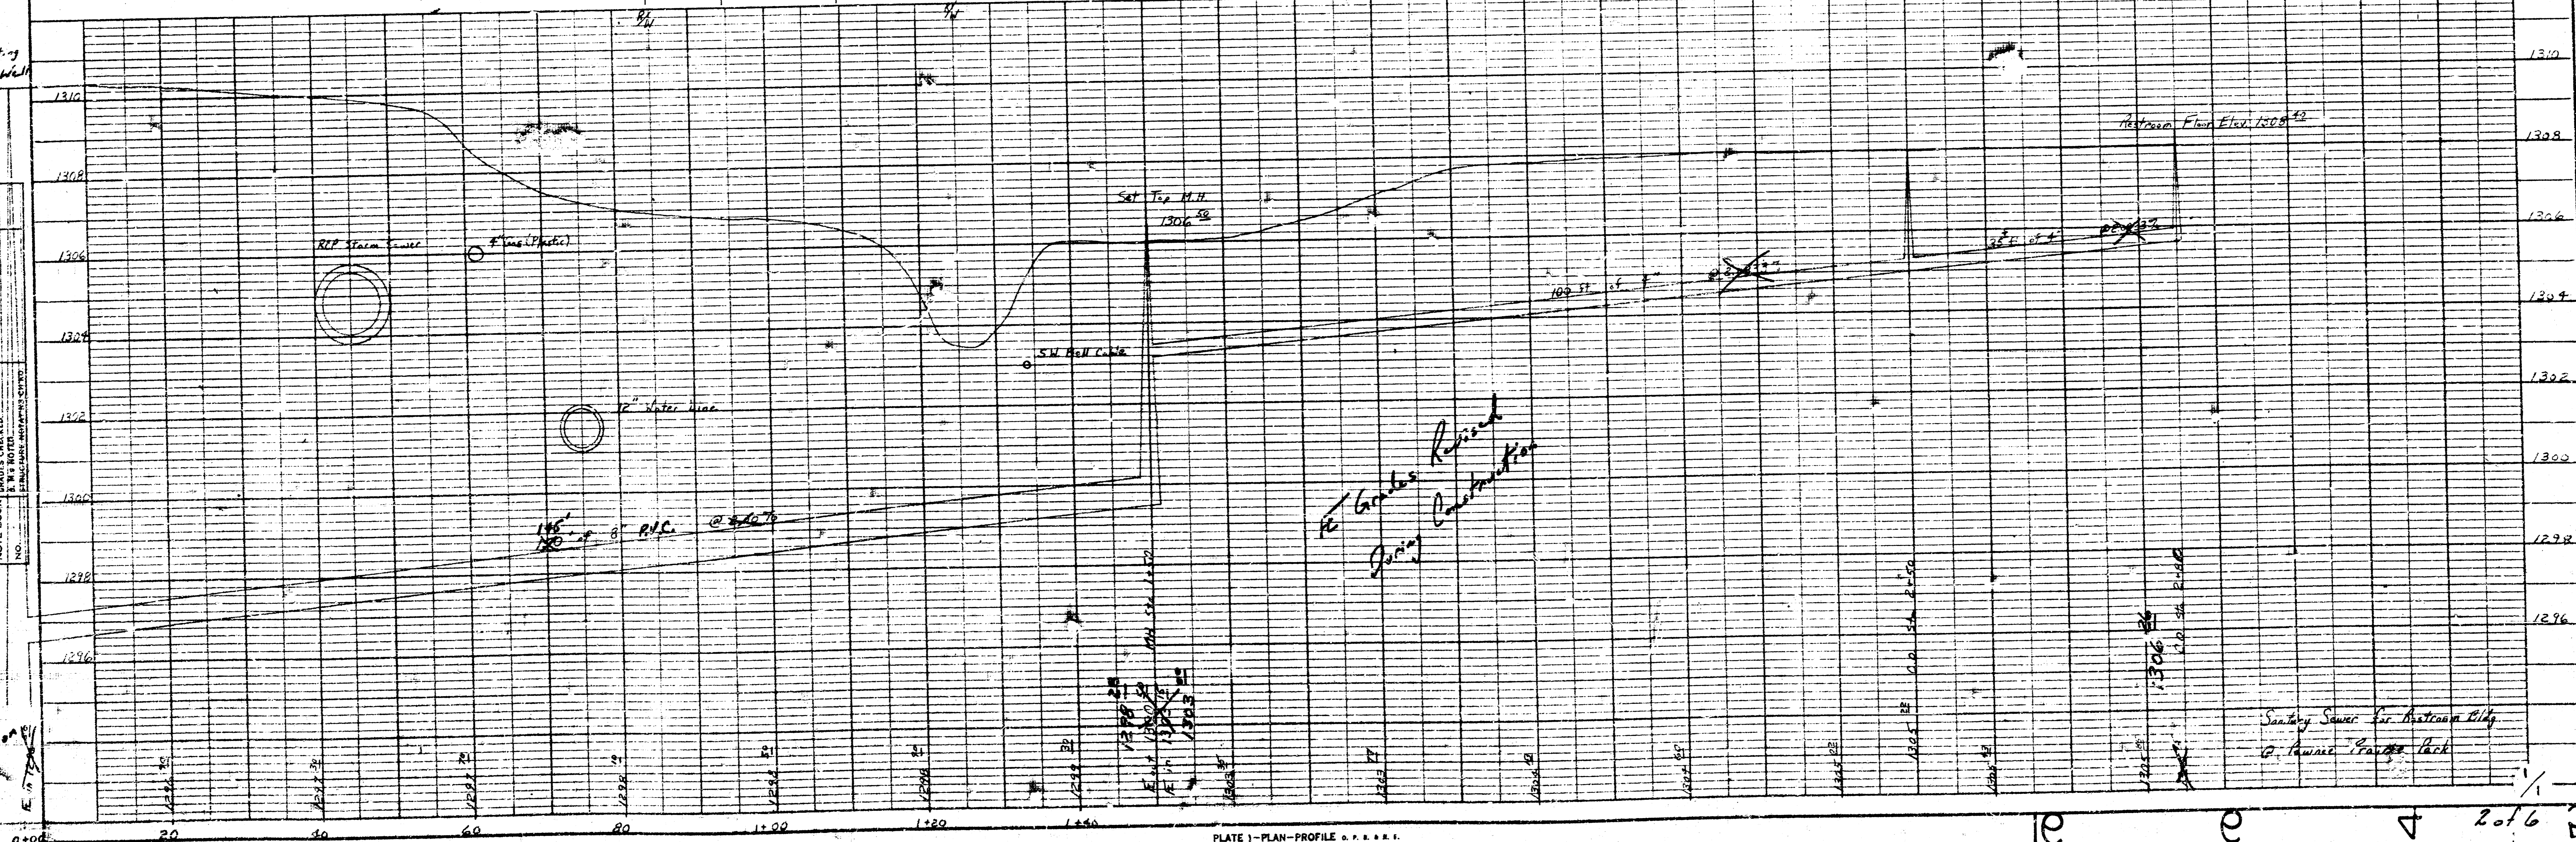

Revised  
 Construction  
 1297