


DATE	
BY	
CHECKED	
DATE	
NO.	
PLAN	
NO.	
DATE	
BY	
CHECKED	
DATE	
NO.	

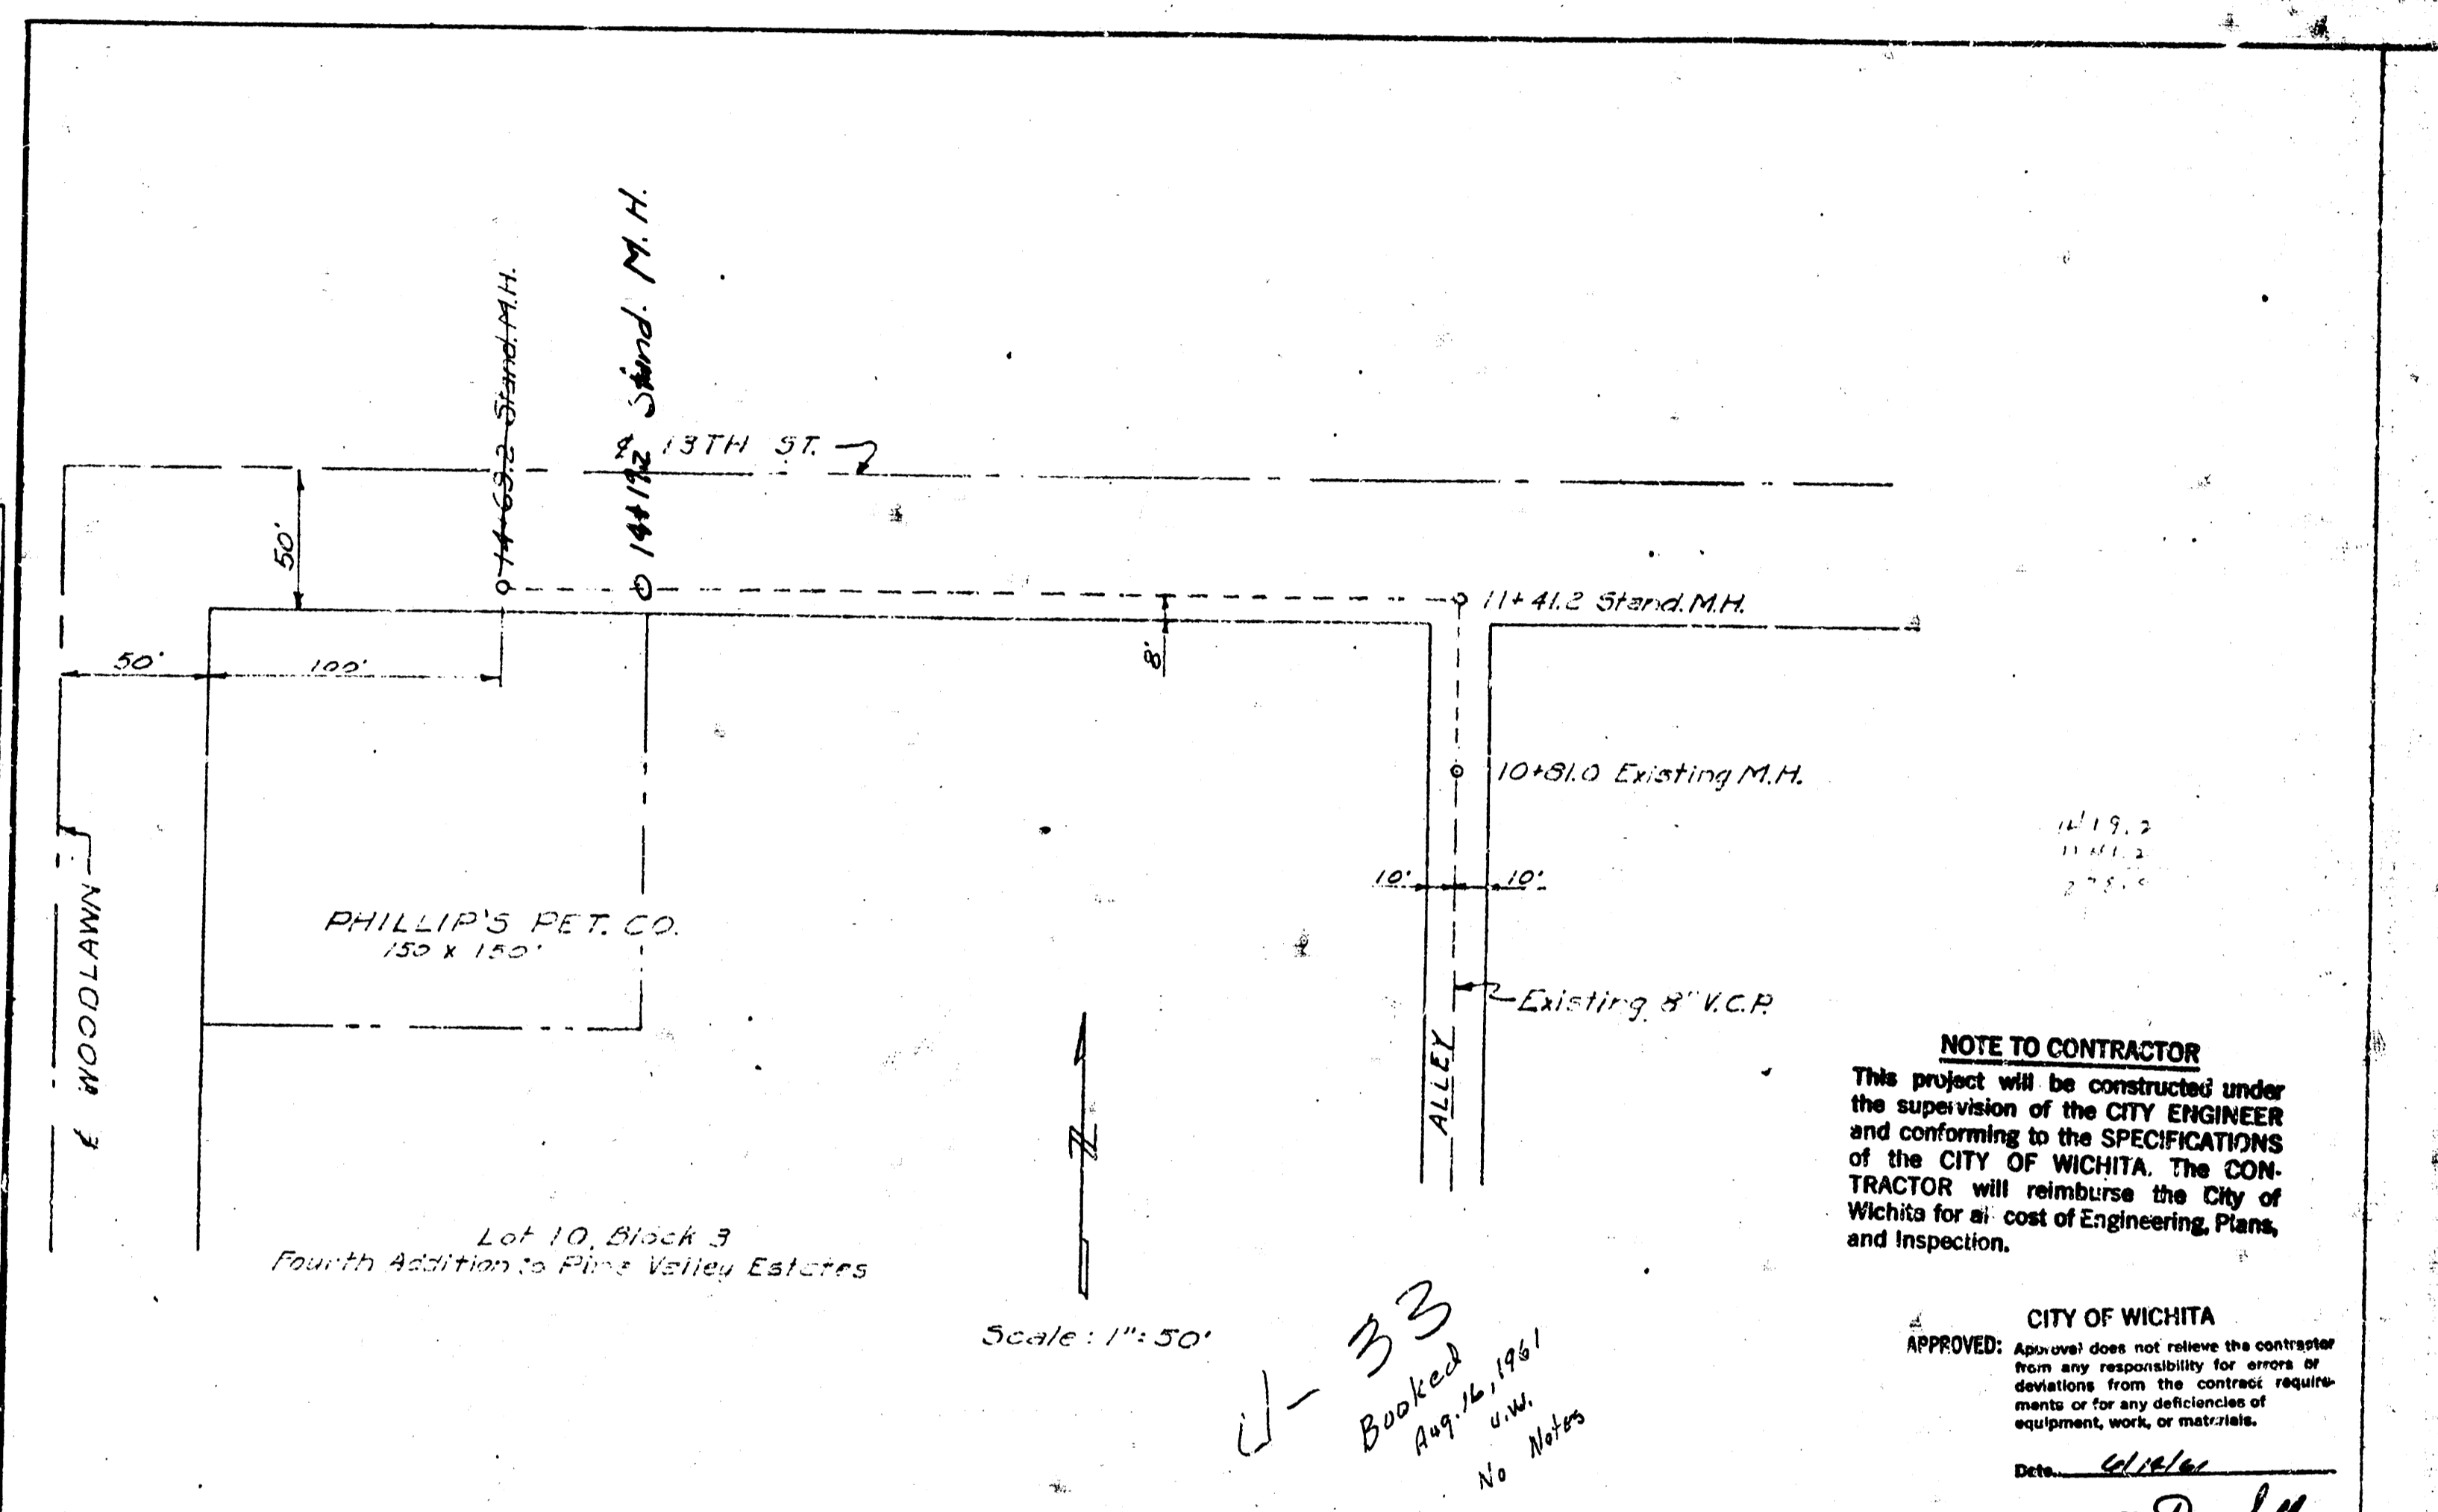


NOTE TO CONTRACTOR
 This project will be constructed under the supervision of the CITY ENGINEER and conforming to the SPECIFICATIONS of the CITY OF WICHITA. The CONTRACTOR will reimburse the City of Wichita for all cost of Engineering, Plans, and Inspection.

CITY OF WICHITA
 APPROVED: _____
 Date: 6/16/61
 Engineering Dr. Dan Sullivan

4-33
 Booked
 Aug. 16, 1961
 u.w.
 No Notes

DATE	
BY	
CHECKED	
DATE	
NO.	
PROFILE	
NO.	
DATE	
BY	
CHECKED	
DATE	
NO.	

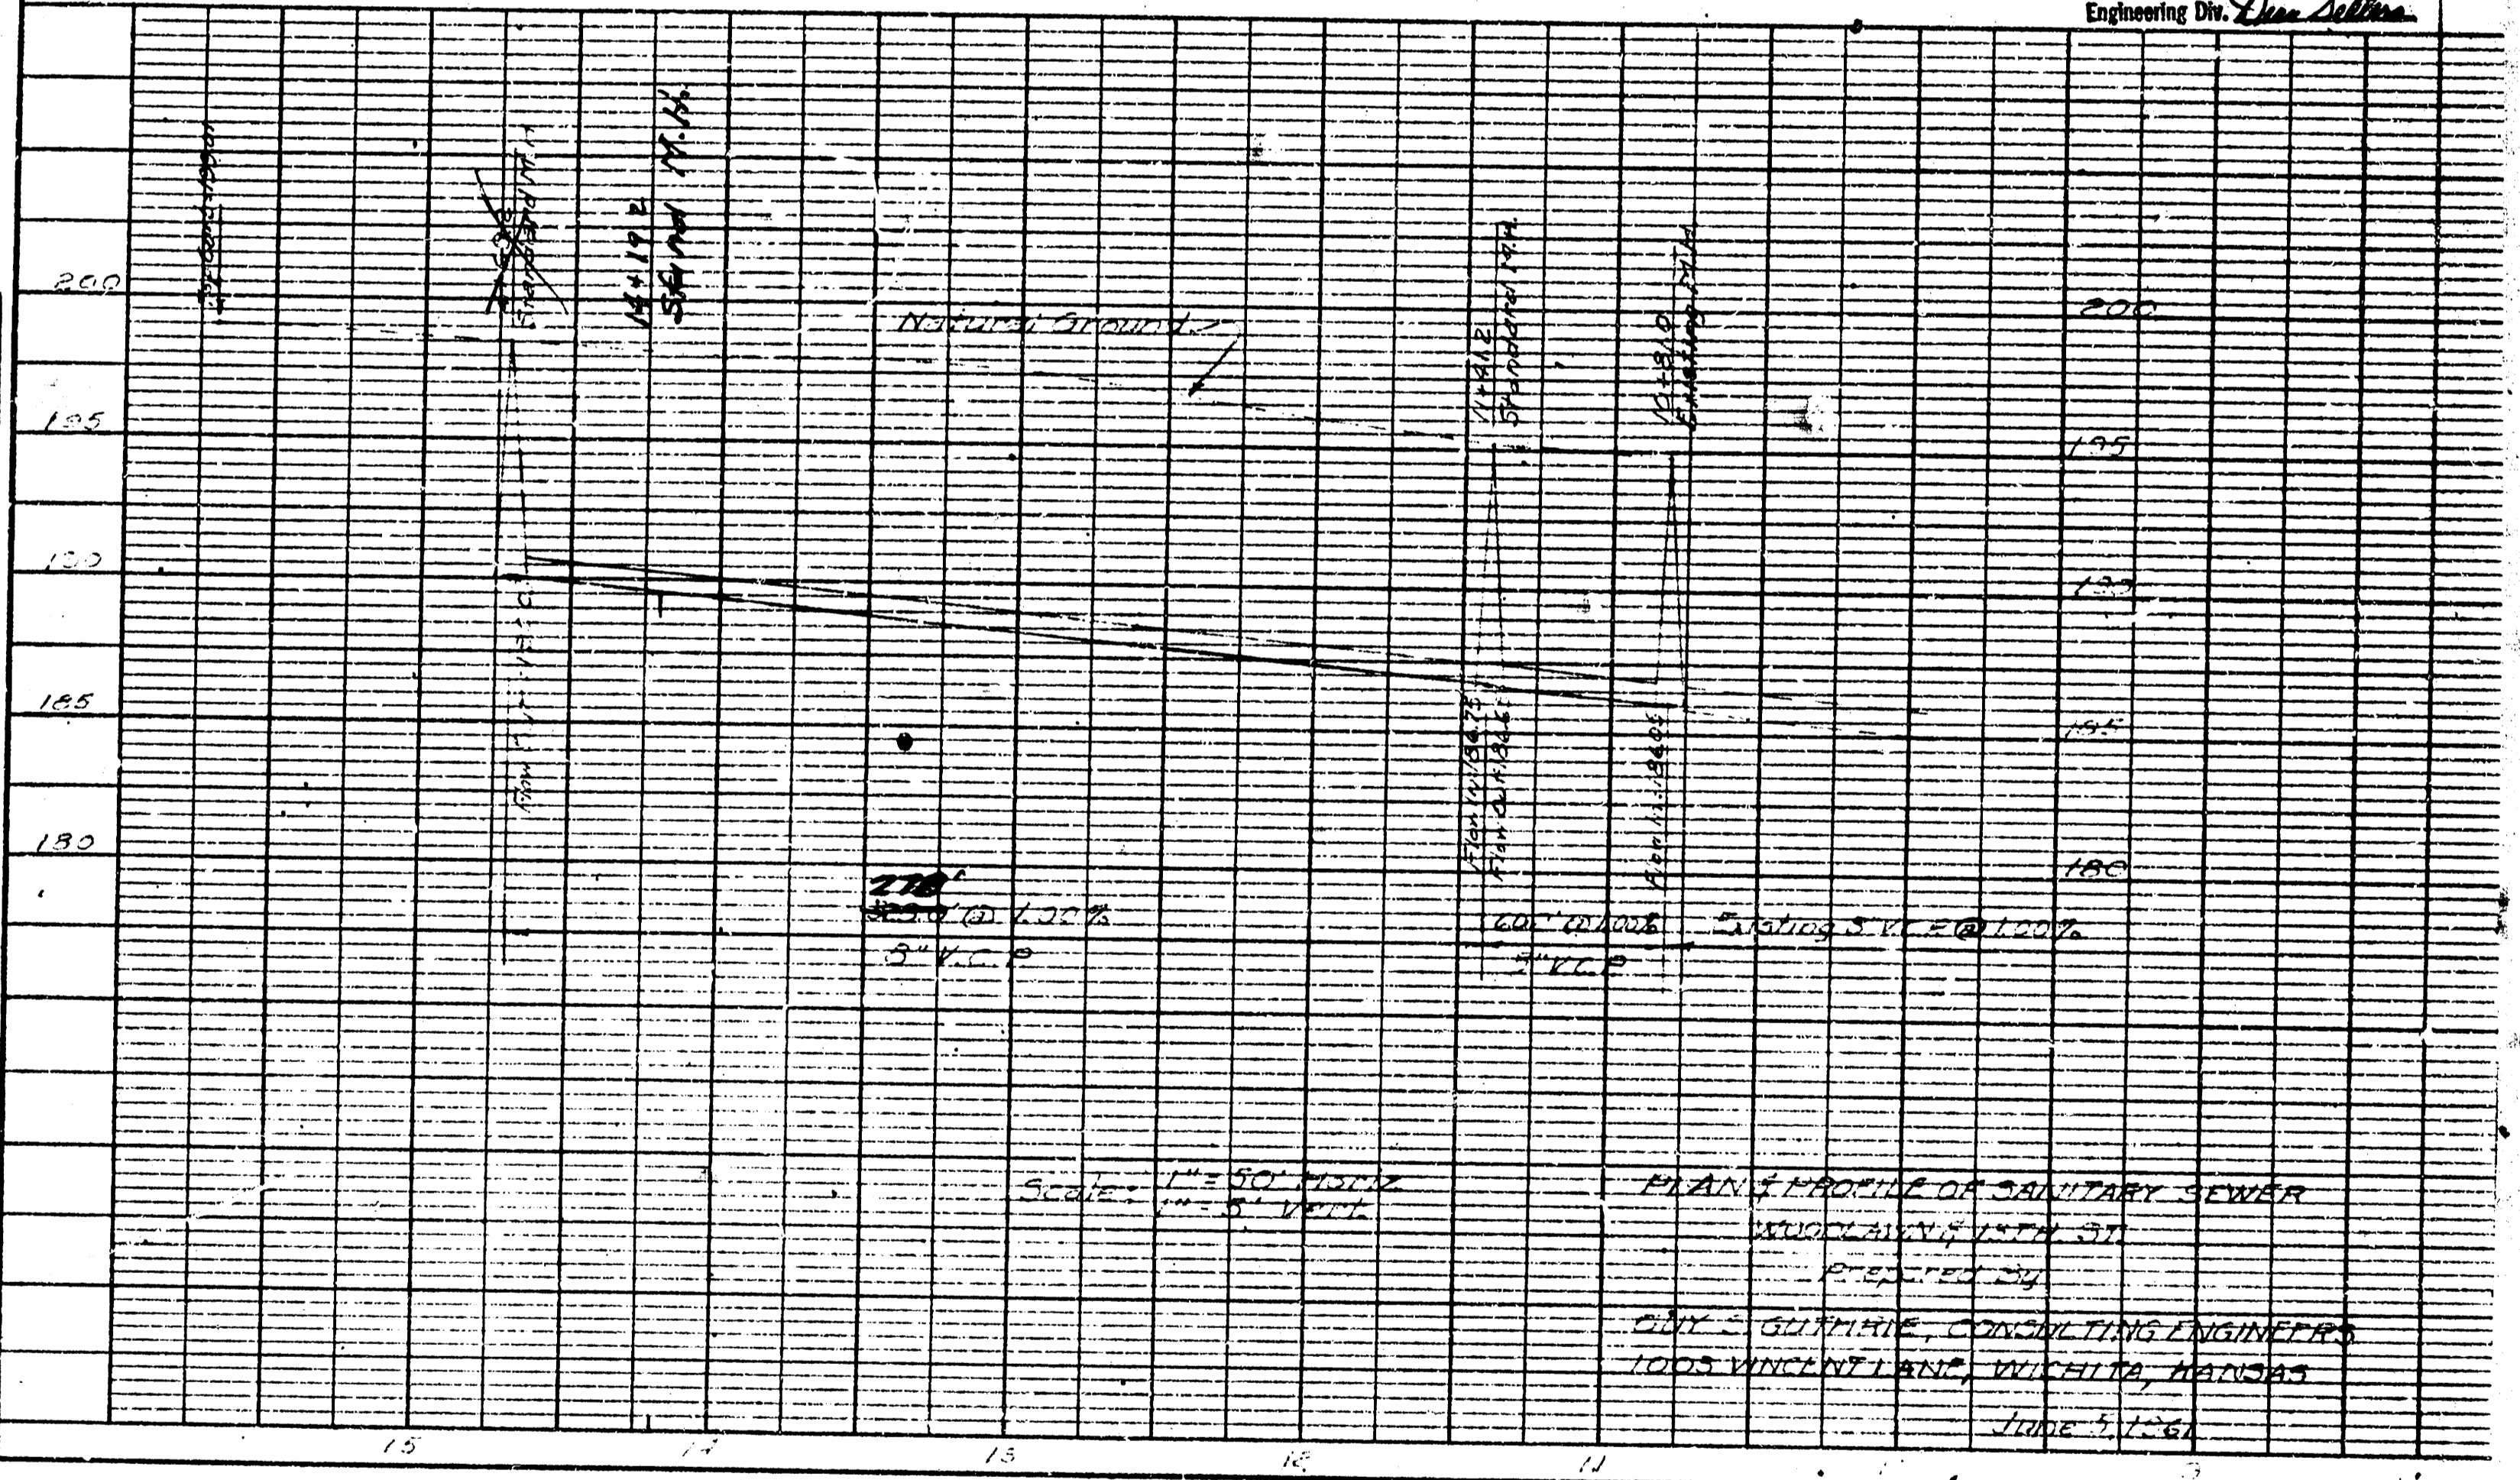

PLAN & PROFILE OF SANITARY SEWER
 PHILLIP'S PET. CO.
 CITY OF WICHITA CONSULTING ENGINEERS
 1008 VINCENT LANE, WICHITA, KANSAS
 June 1, 1961