


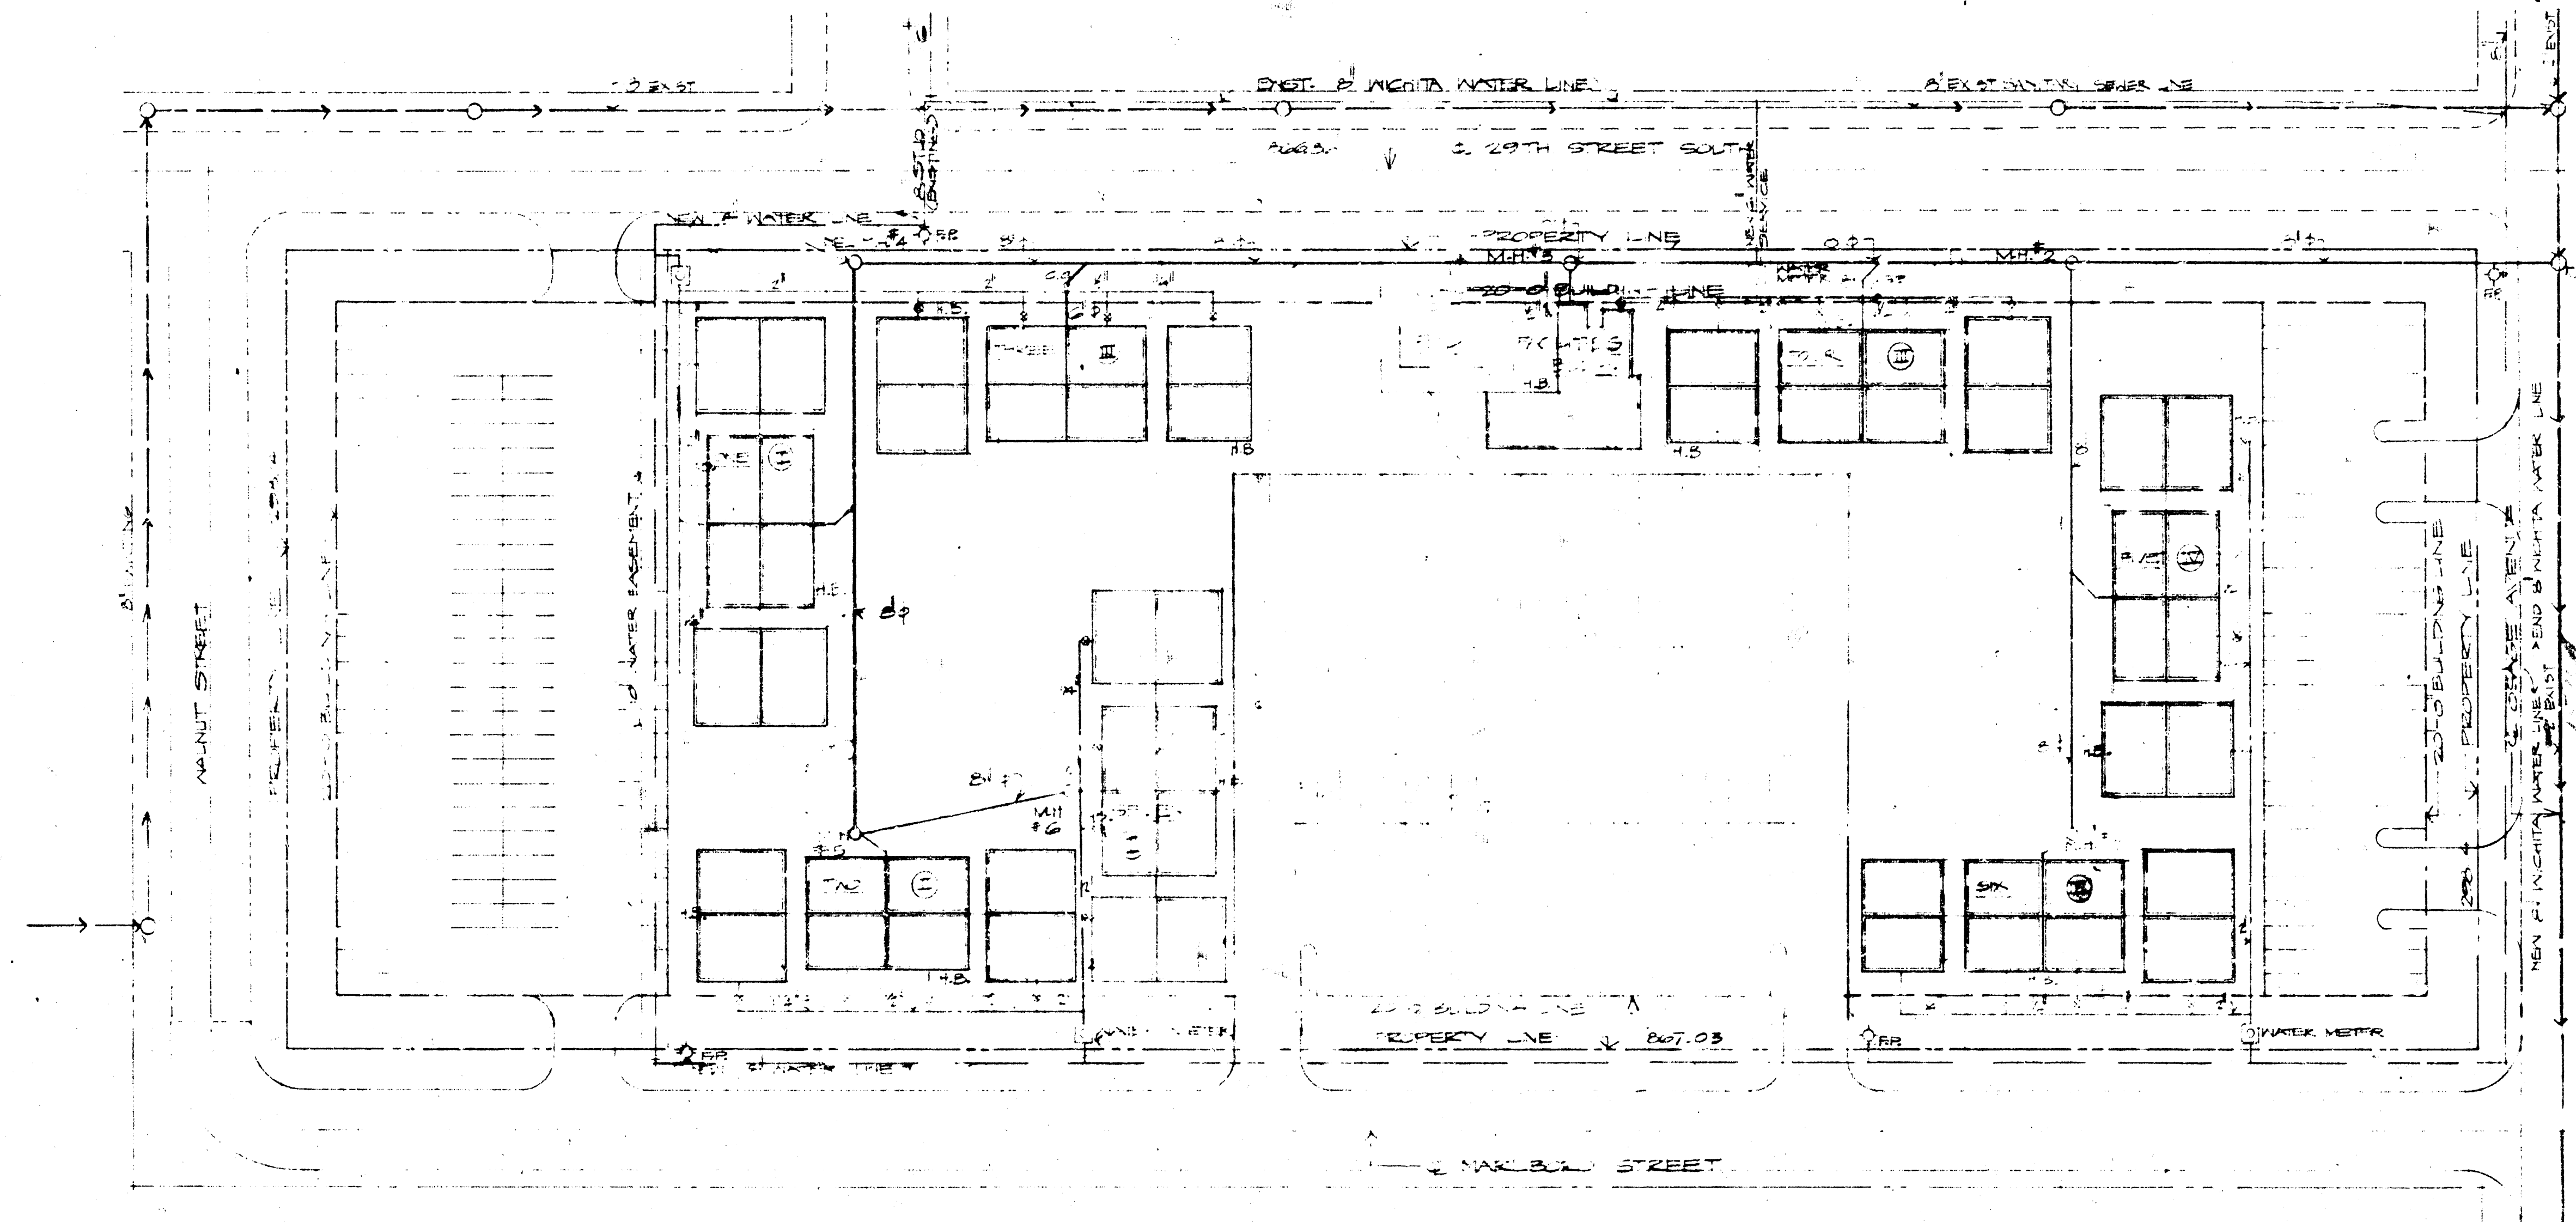

ALL MH TO BE T1A

MECHANICAL SITE PLAN

APPROVED AS NOTED
By CITY ENGINEER OF WICHITA
Sanitary Sewers: *[Signature]*
Storm Sewers: _____
Driveway Approaches: _____

NOTE TO CONTRACTOR
This project will be constructed under the supervision of the CITY ENGINEER and conforming to the SPECIFICATIONS of the CITY OF WICHITA. The CONTRACTOR will reimburse the City of Wichita for all cost of Engineering, and Inspection.

Heartland, Inc.
Wichita, Kansas 67202
Phone 313-463037

DESIGNED BY: **Heartland, Inc.**
Wichita, Kansas 67202
Construction Management

MECHANICAL SITE PLAN

PLANTATION 3 APARTMENTS
WICHITA, KANSAS

bishop & quinn - a.i.a. - architects
midwest city, oklahoma

REVISED 12 AUG 73

sheet
M
of 3

23

