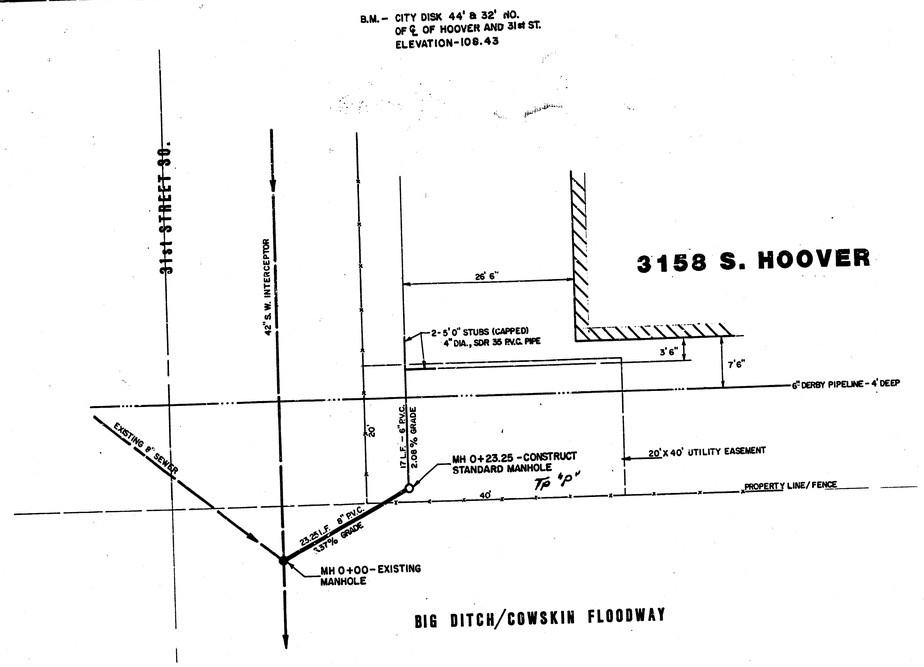

N

SCALE
PLAN 1" = 10'
PROFILE
VERT. 1" = 4'
HORZ. 1" = 10'

CITY OF WICHITA

PRIVATE PROJECT NO. 209PPS

MAY 1989

AS CONSTRUCTED

ALL PIPE IS P.V.C. – S.D.R. 35

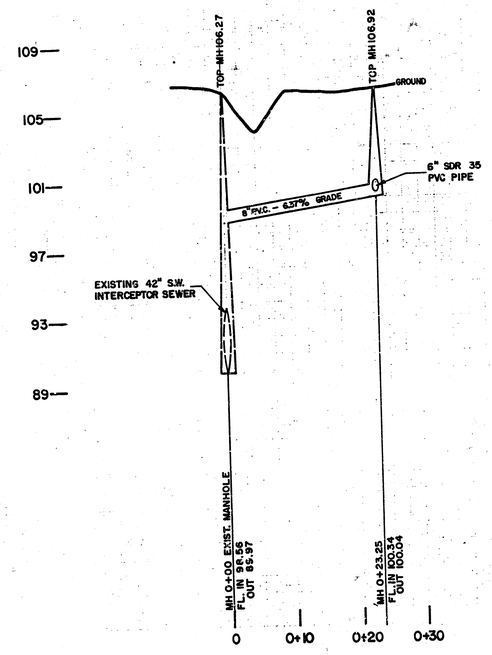

REISS & GOODNESS ENGINEERS
2160 WEST 21ST STREET
WICHITA, KANSAS 67204
(316) 832-0213

1/2

REVISION		DRAWN BY		CHECKED BY	DESIGNED BY	PROJECT	CUSTOMER	SCALE	PROJECT NO.
		JH	5-9-89	B.P.	D.C.	**POLLUTION CONTROL PROJECT**	**QUALITY MANUFACTURERS, INC.**	GIVEN	MS 1288
								DATE 4-10-89	SHEET 1 OF 1

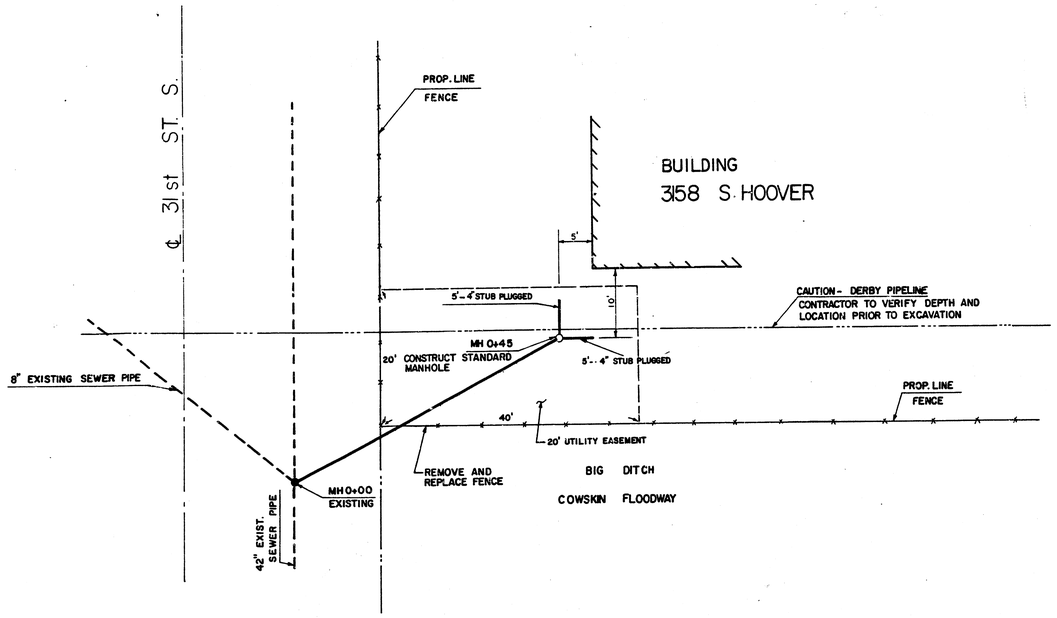

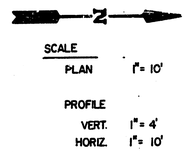

BM. CITY DISK 44' EAST & 32' NORTH OF
℄ OF HOOVER & 31st ST. S.- ELEV. 108.43

CITY OF WICHITA
PRIVATE PROJ. NO. 209PPS
APRIL 1989

NOTE TO CONTRACTOR
INSPECTION AND TESTING FOR THIS PROJECT IS TO BE PRO
BY A LICENSED CONSULTING ENGINEERING FIRM
CONTRACT WITH THE OWNER/DEVELOPER AND
ACCEPTANCE WITH THE CITY OF WI
PROJECT
BE
ANY WITHOUT WRITTEN AUTHORIZATION
CITY ENGINEER.

APPROVED AS NOTED
By CITY ENGINEER OF WICHITA
Sanitary Sewers VRH 4/13/89
Storm Sewers
Paving
Water

(ALL PIPE IS 8" PVC. SDR-35.)

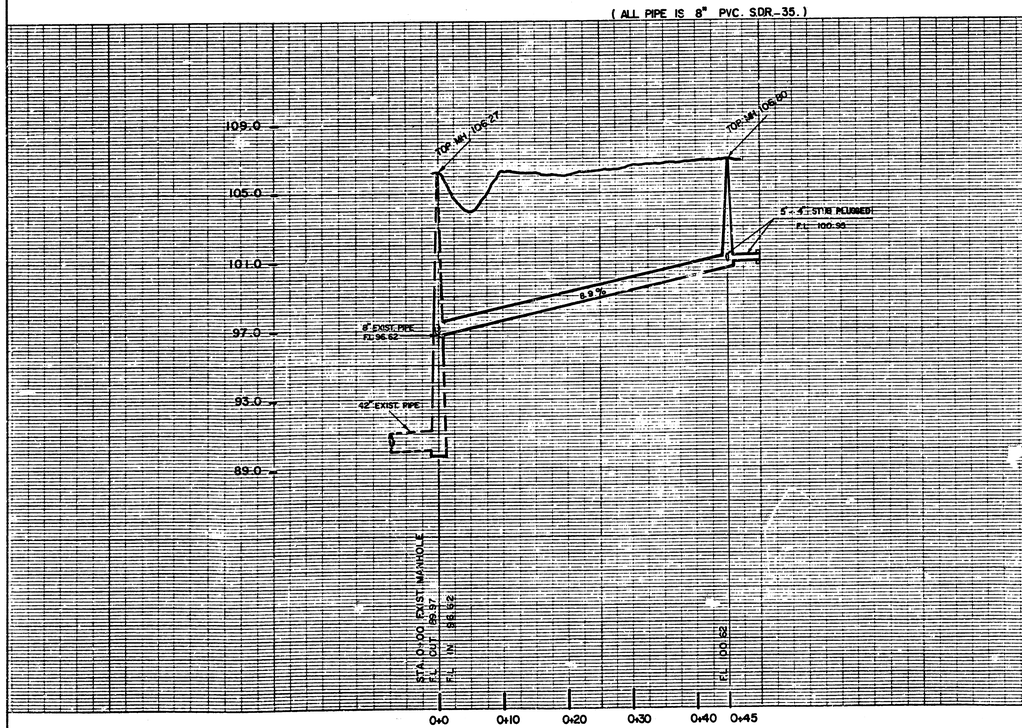

REISS & GOODNESS ENGINEERS
2150 WEST 21ST STREET
WICHITA, KANSAS 67204
(316) 832-0213

REVISION		DRAWN BY	CHECKED BY	DESIGNED BY	PROJECT	CUSTOMER	SCALE	PROJECT NO.
		Rocky	B.P	D.C	POLLUTION CONTROL PROJECT	QUALITY MANUFACTURERS, INC.	GIVEN	MS 1288
							DATE 4-10-89	SHEET 1 OF 1

2/2