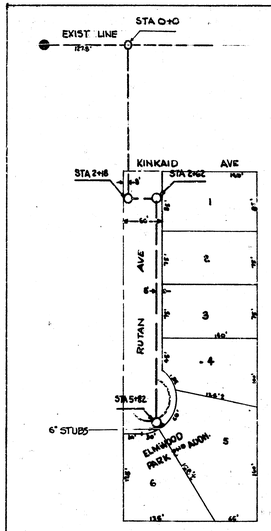

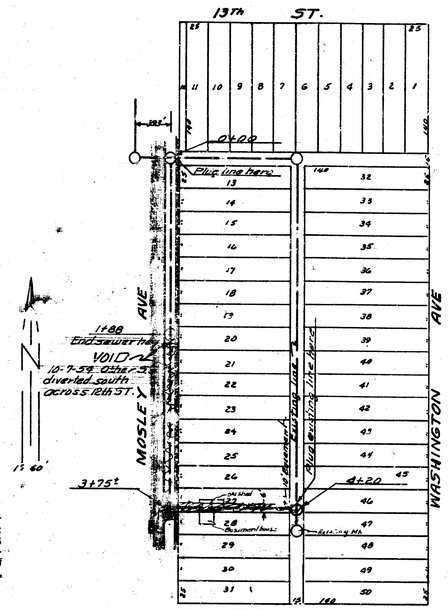

NOTE TO CONTRACTOR

This project will be constructed under the supervision of the CITY ENGINEER and conforming to the SPECIFICATIONS of the CITY OF WICHITA. The CONTRACTOR will reimburse the City of Wichita for all cost of Engineering, Plans, and Inspection.

B.M. 101.77 LARGE STAPLE IN FACE OF S.W. COR. RUTAN & KINKAID

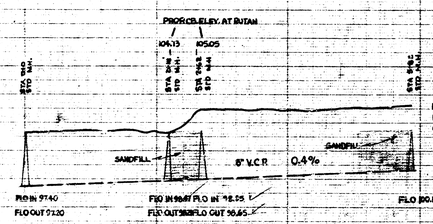

DATE 8-5-59
DRN. BY J.D.H.
CHK. BY
BK. NO.

Code Drawn by 8-17-59
Check by McClain
Book No. 7-56 K-16

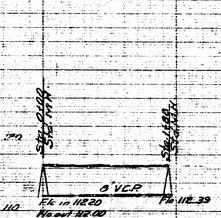

LAT 38 D.C.S. #2 S.S. 12
CITY OF WICHITA, KANS.
B.E. SMITH CITY ENGINEER
PROJ. NO. C 24-42

PRIVATE SEWER
ROCK ISLAND LUMBER CO.
CITY OF WICHITA KANSAS
B.E. SMITH, CITY ENGINEER

B.E. SMITH LICENSED 436 KANSAS

5 4 4 3