

B. M. 133.19 City Sid @ Maize & Maple
43.5' South & 327' E. of E. both.
T. B. M. 134.575 Brass cap to E-Hub
guard 1st R.C. Bridge, north
(400' N of) of Maple.




Plan Scale 1" = 40'
Profile Scale 1" = 40' Horiz.
1" = 5' Vert.

C.R.W.

50' 11"


NOTE:
Contractor to contact
Developer and establish
top of manhole elevations.

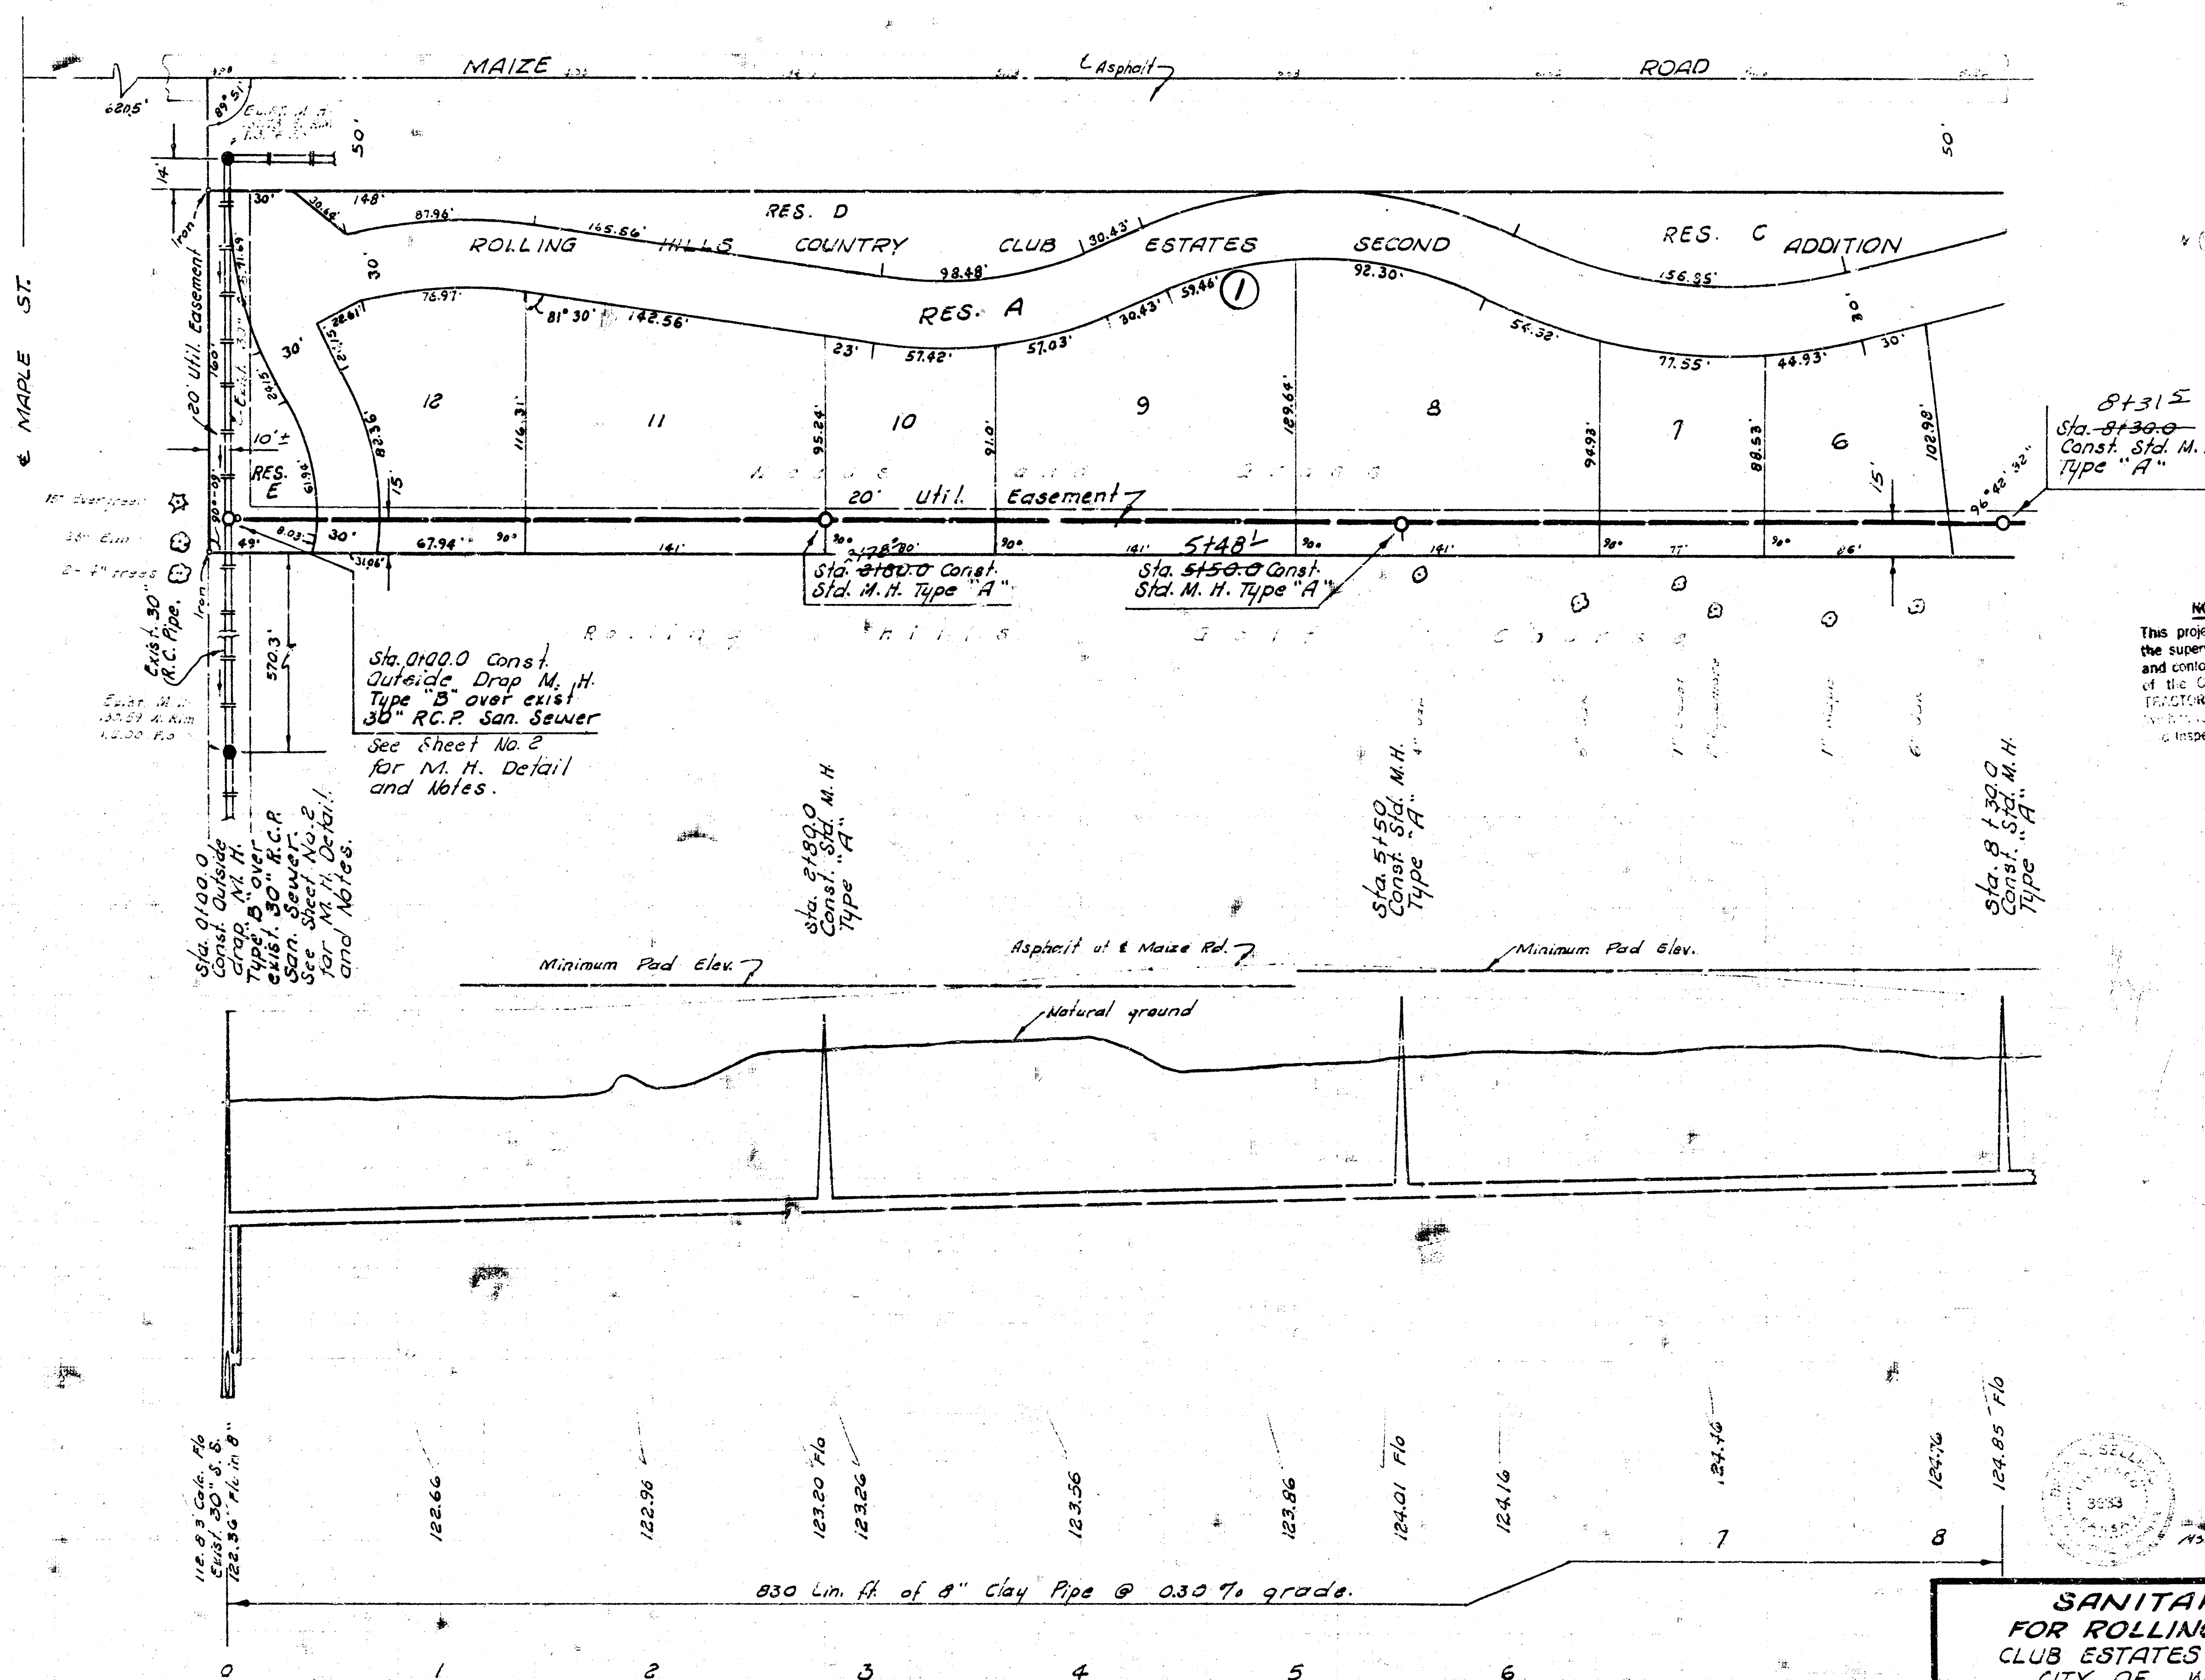

NOTE TO CONTRACTOR
This project will be constructed under
the supervision of the CITY ENGINEER
and conforming to the SPECIFICATIONS
of the CITY OF WICHITA. The CON-
TRACTOR will reimburse the City of
Wichita for all cost of Engineering, Plans
& Inspection.




**SANITARY SEWER
FOR ROLLING HILLS COUNTRY
CLUB ESTATES SECOND ADDITION
CITY OF WICHITA, KANSAS
R. W. LINN — CITY ENGINEER
DEC. 1972, PRIVATE PROJECT NO. ARK8502253**

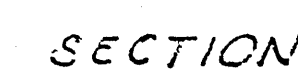

Std. Sta. 0100.0
M. H. Type "B" 5' diam.


NOTE:
All exposed Conc. pipe surface to be protected with Plastic lining as approved by the Field Engineer.
Method of removing top 1/2 of 30" R.C.P. is to be approved by the Field Engineer.

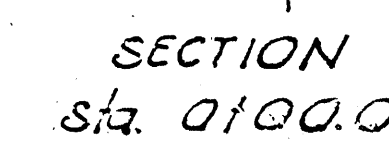

NOTE:

Outside of brick manhole at Sta. 0100.0 shall be given two coats of Bitumastic Super Service Black as manufactured by Koppers Chemicals and Coatings, or on approved equal. Application shall be according to manufacturer's recommendations.

x.35 Wyo-Dond Bentonite as manufactured by Archer Daniels Midland Co., or an approved equal shall be mixed with the backfill material lying below water table elevation at the manhole location at sta. 0+40.0. Approximately 40 pounds of Bentonite is to be uniformly mixed with the backfill material.

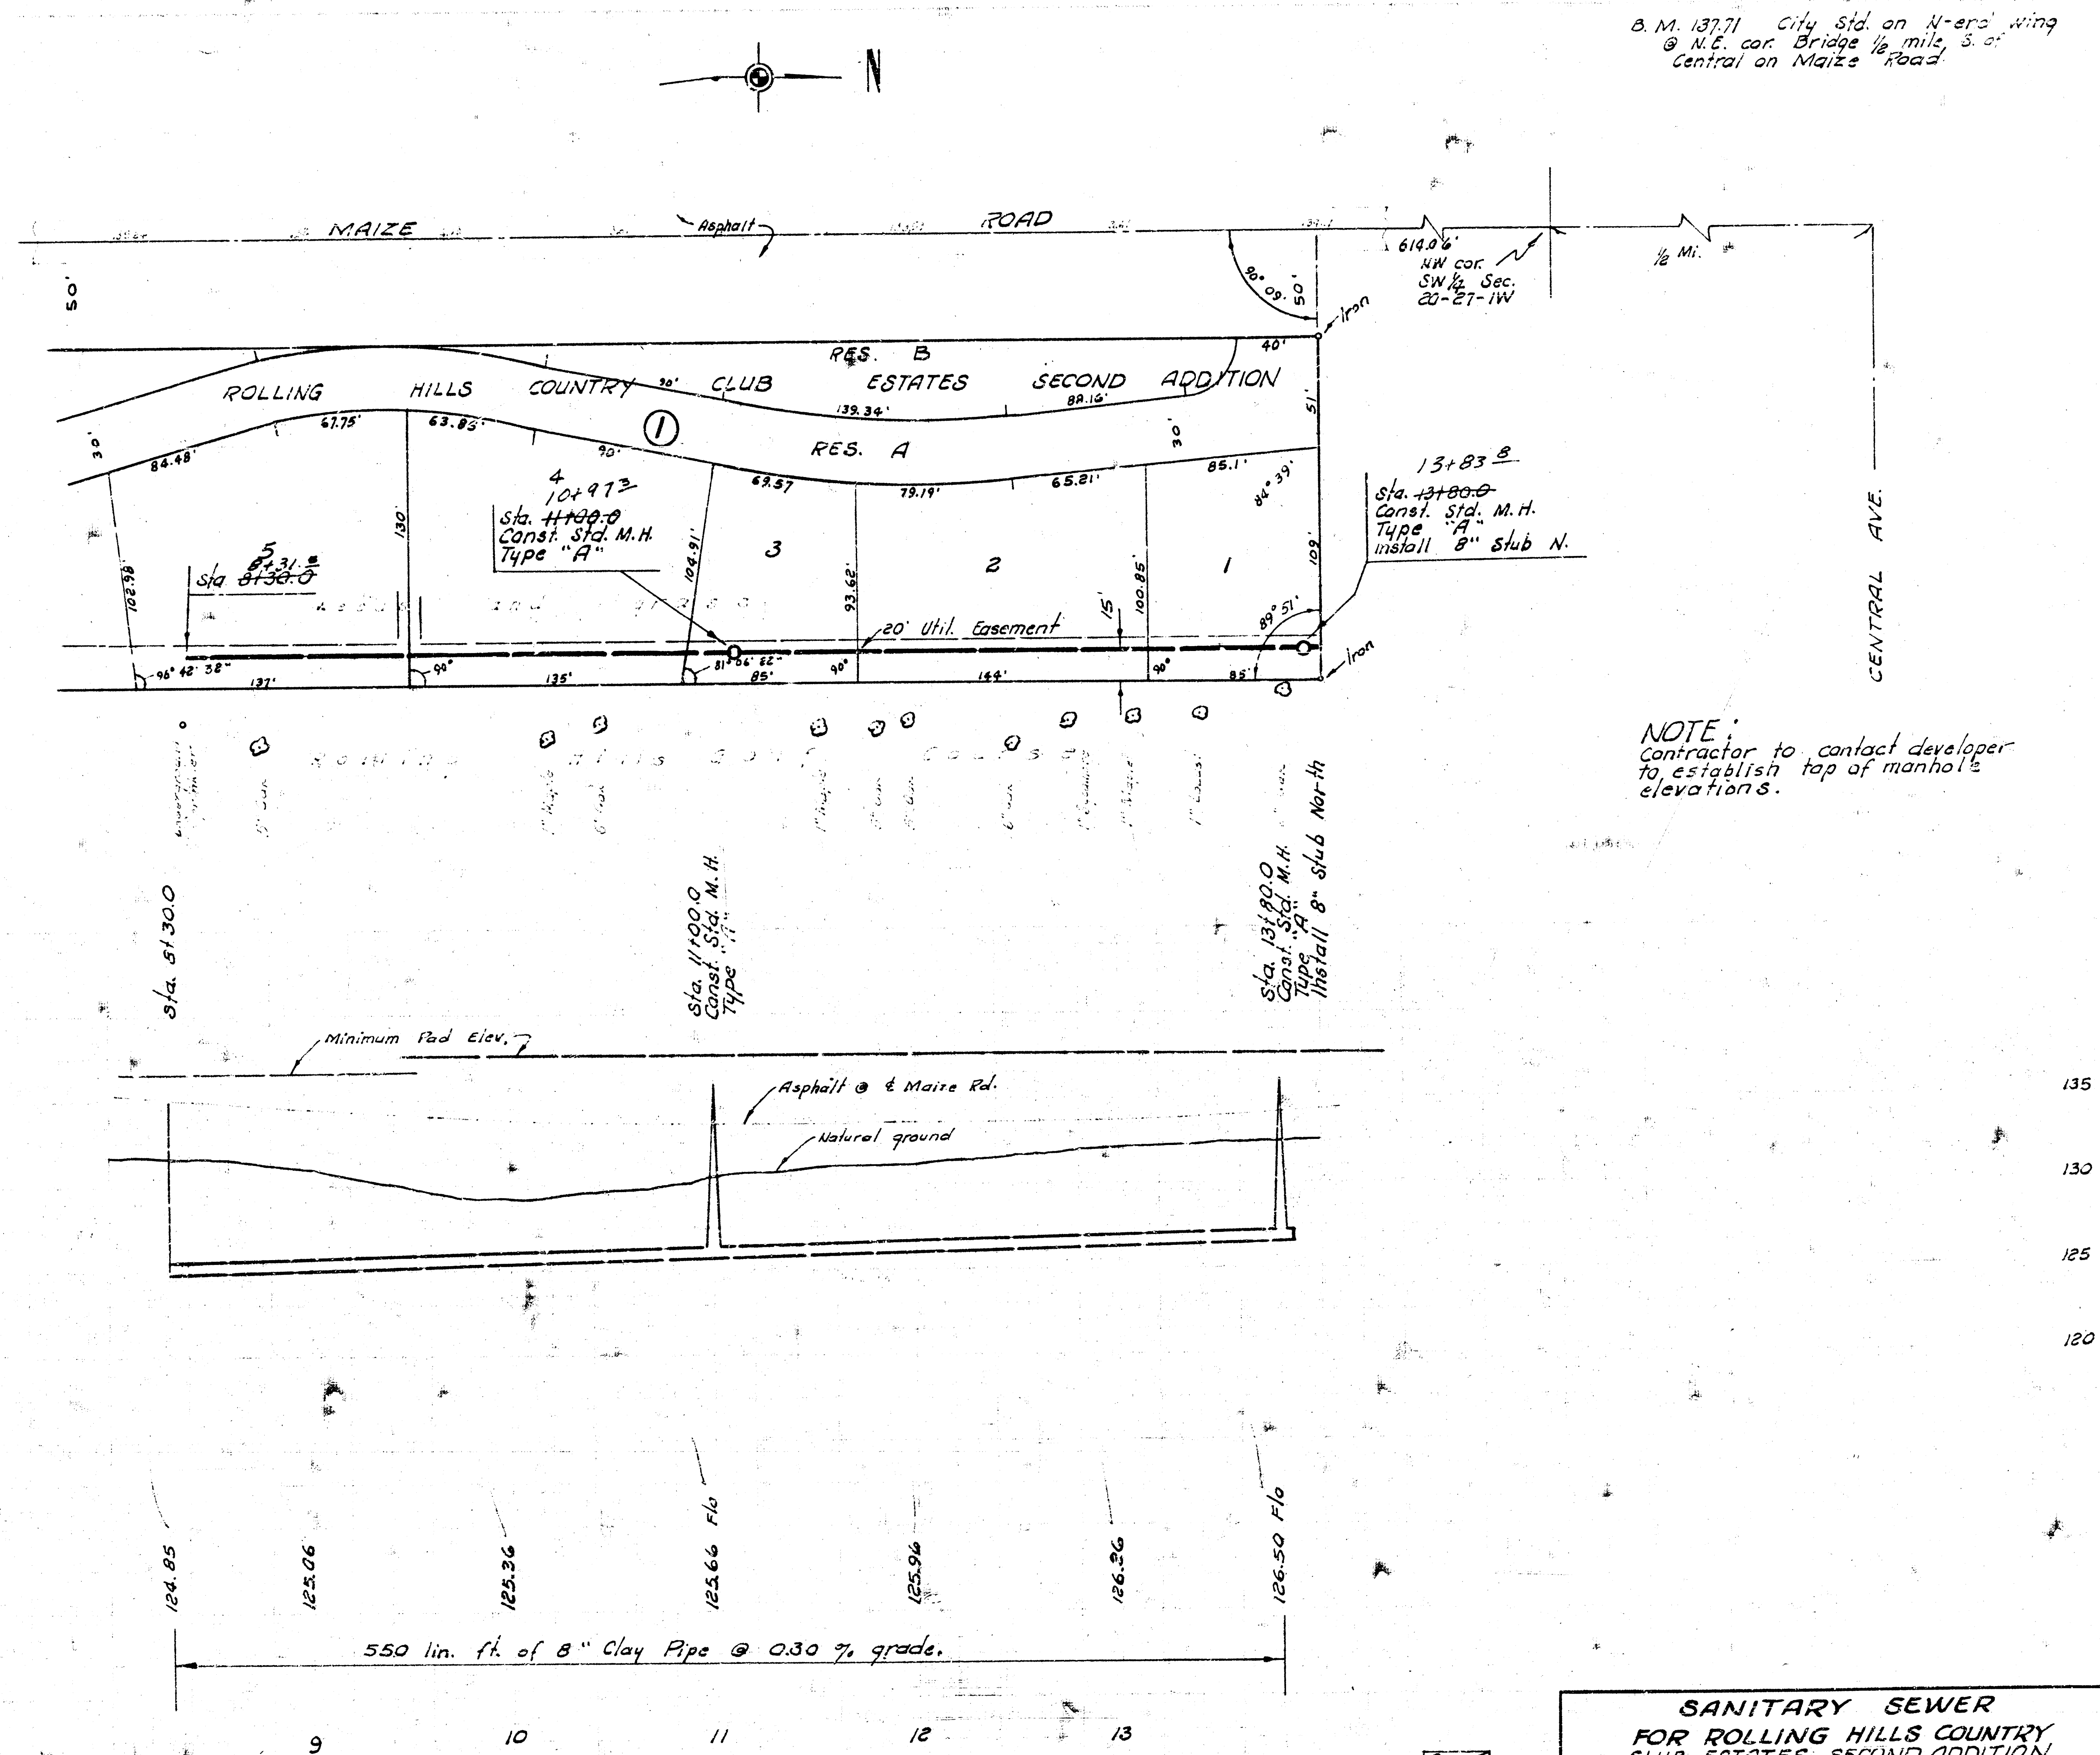

B. M. 137.71 City Std. on N-end wing
@ N.E. cor. Bridge $\frac{1}{2}$ mile S. of
Central on Maize Road.

NOTE:
Contractor to contact developer
to establish top of manhole
elevations.

SANITARY SEWER
FOR ROLLING HILLS COUNTRY
CLUB ESTATES' SECOND ADDITION
PRIVATE PROJECT NO. AAK/B502053

8