
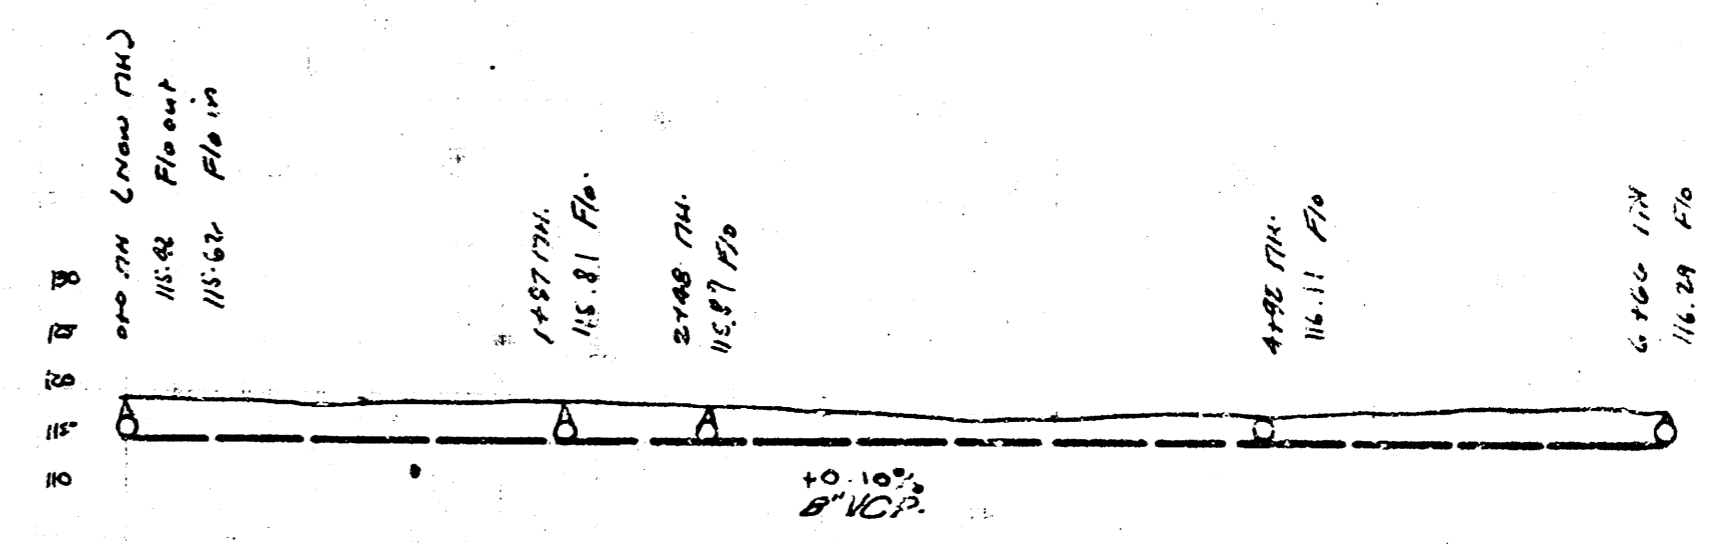


Lot 8, Dist B, 35<sup>th</sup> St

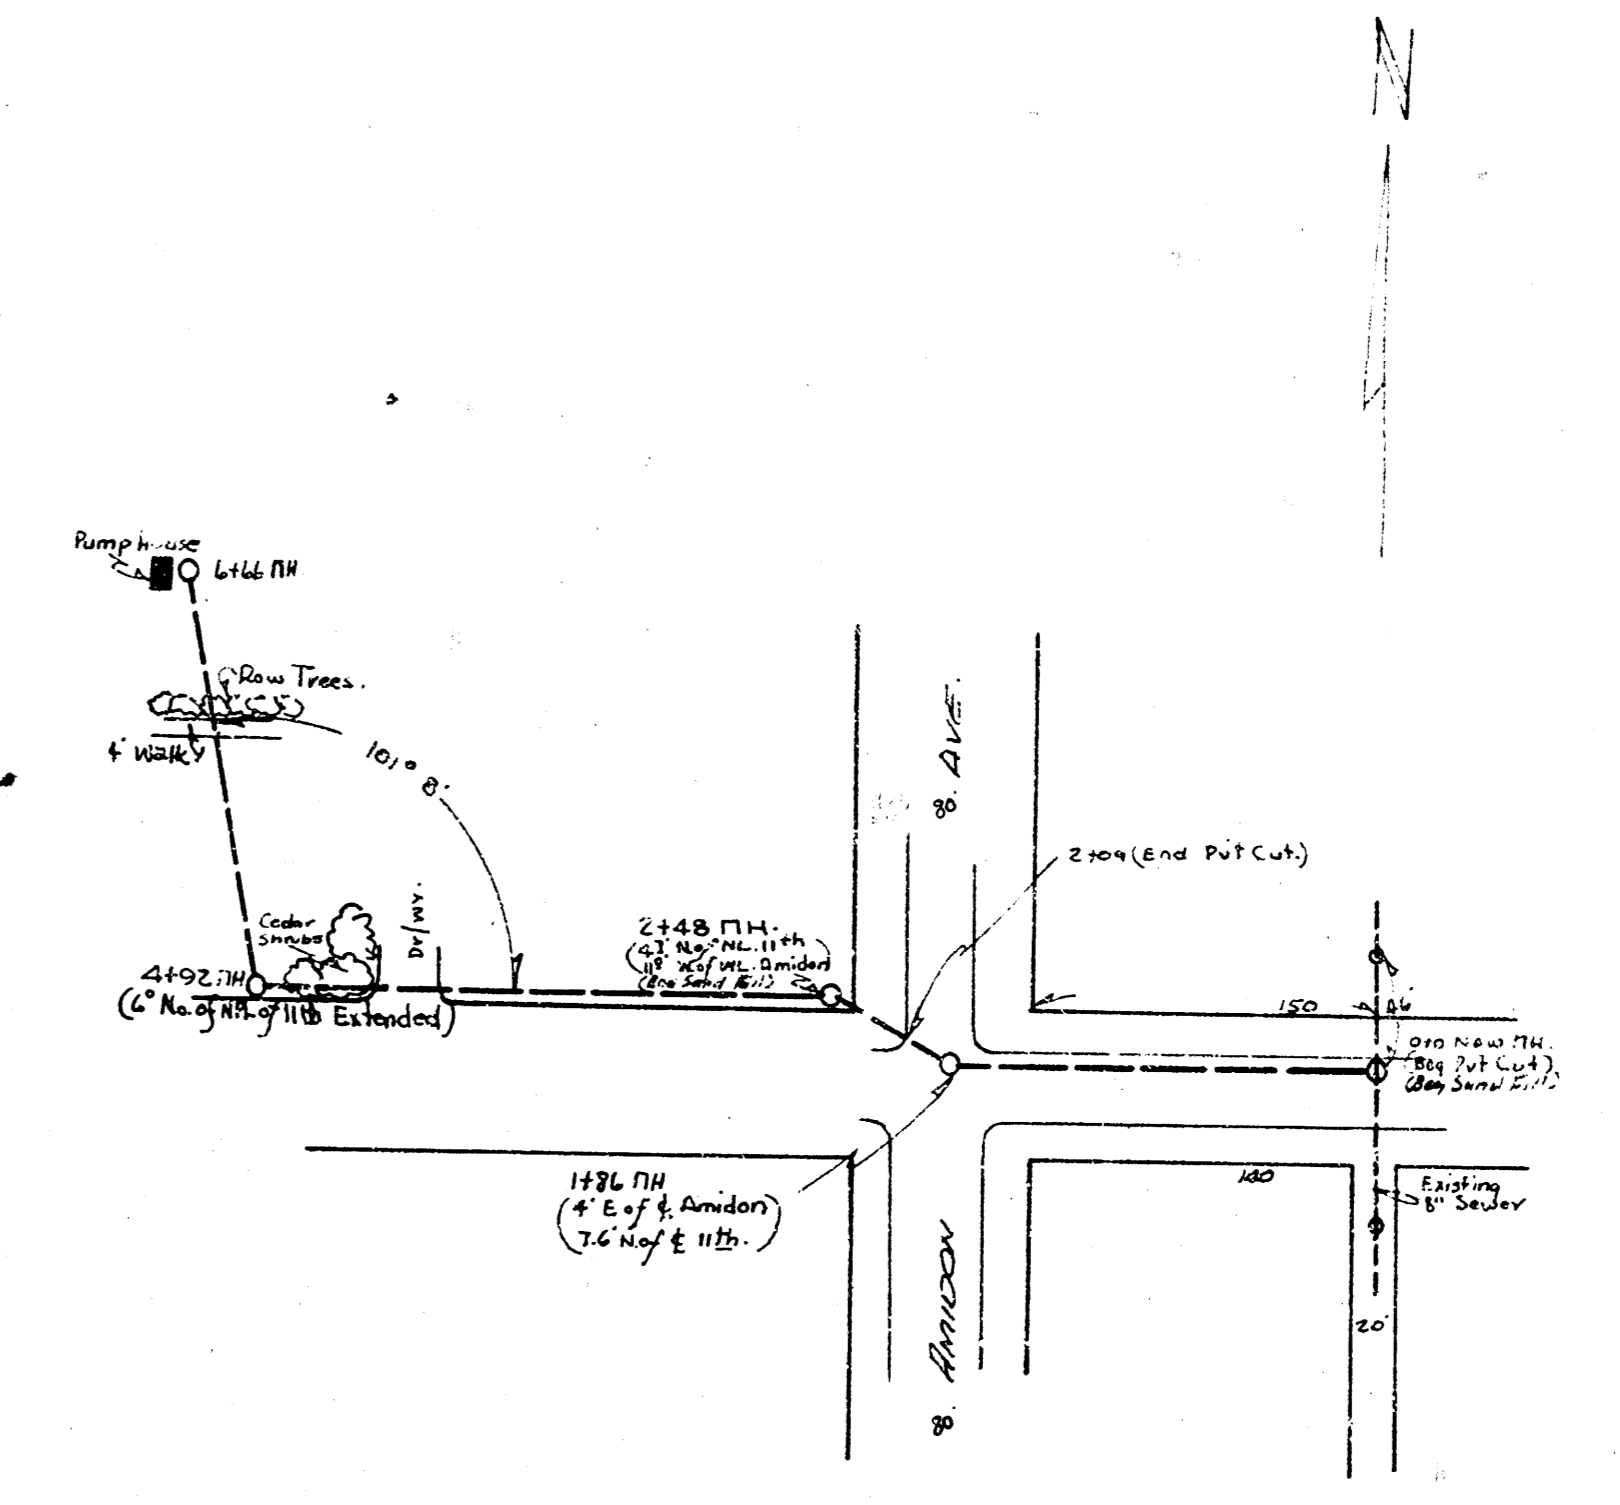

Salvation Army Sanitary Sewer  
City Prison Farm Sanitary Sewer  
Lot 8, Dist B, Sanitary Sewer #20  
City of Wichita, Kansas  
L. K. White City Engineer  
Date May 23, 1919