
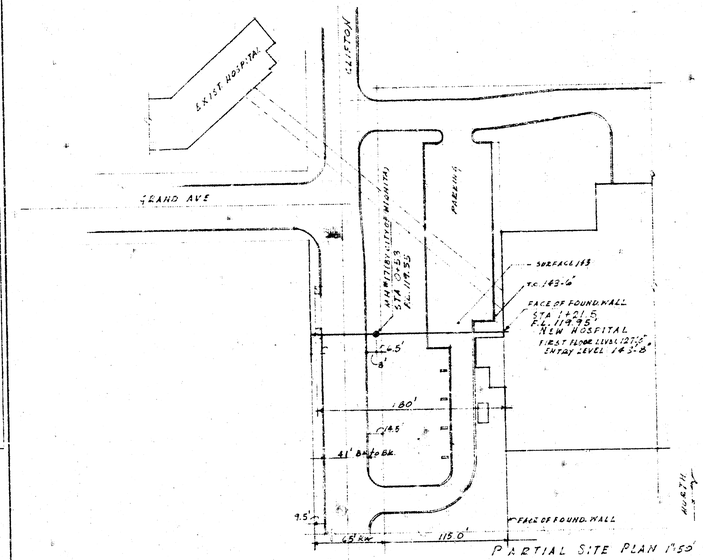


7-2-74
APPROVED AS NOTED
By CITY ENGINEER
Sanitary Sewers D.E.S.

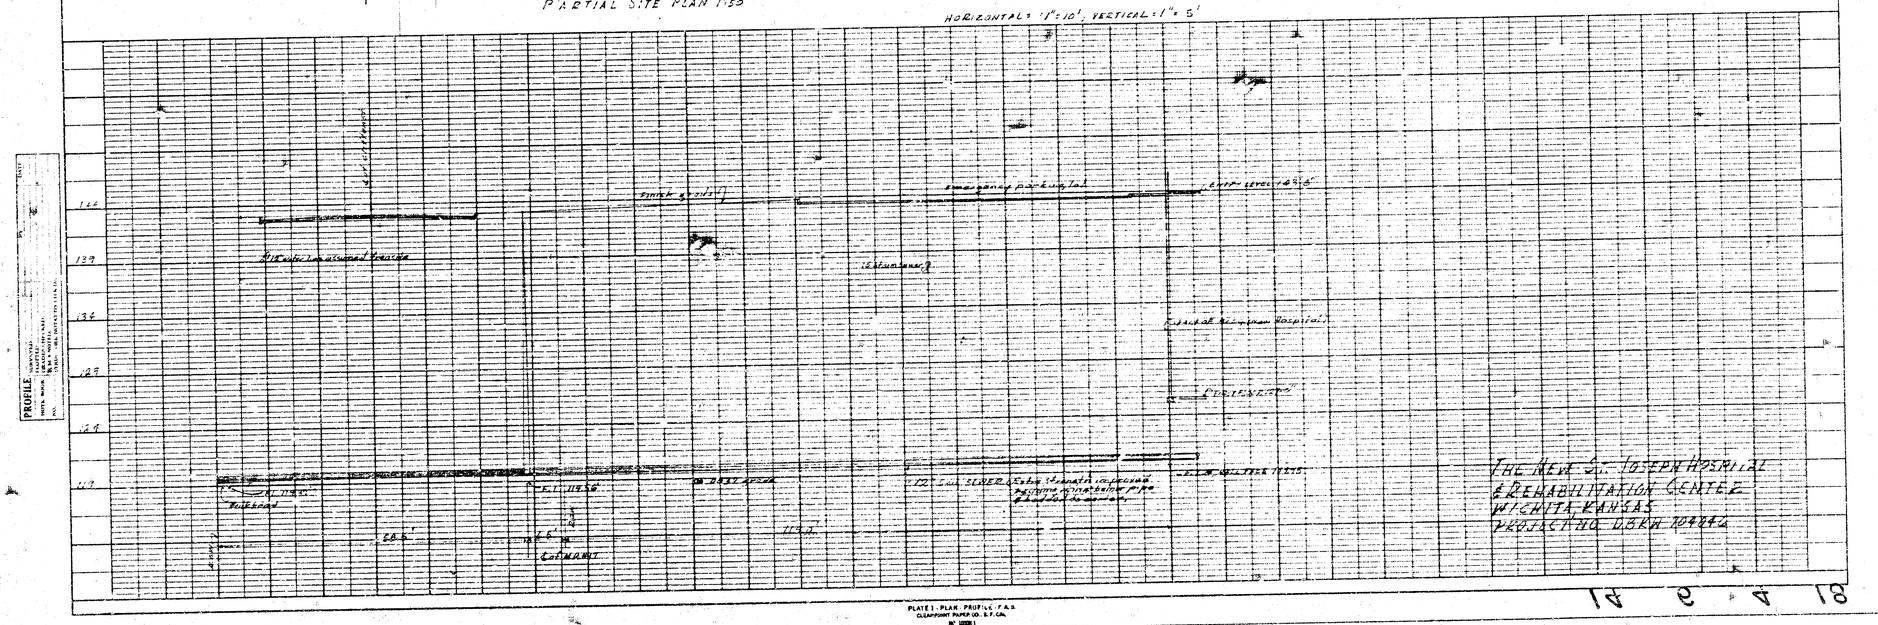

THE NEW ST. JOSEPH HOSPITAL
& REHABILITATION CENTER
WICHITA, KANSAS
PROJECT NO. USRH 1044-4

PLATE 1 - PLAN - PROFILE - T.A.D.
CLEARPOINT PAPER CO. E.T. CAL.
N° 10006 1