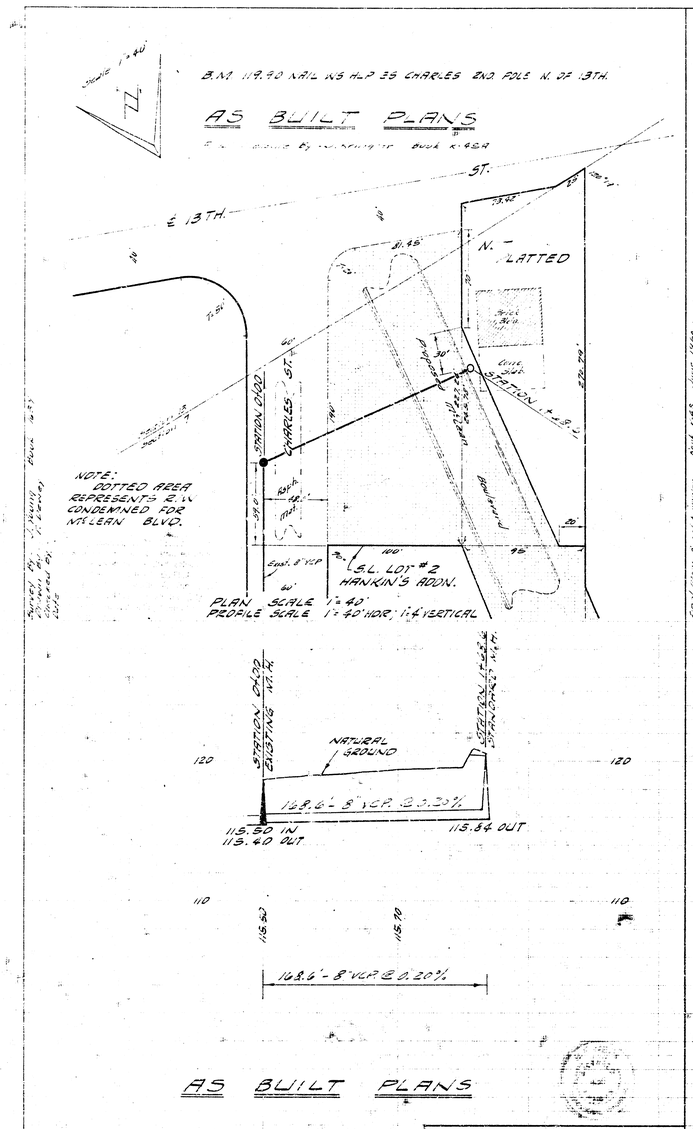

EXT. OF LAT 16 SUB. 13 SAN. SEWER 22
CITY OF WICHITA, KANSAS
B.E. SMITH CITY ENGINEER
PRIVATE JOB. MAY, 1960

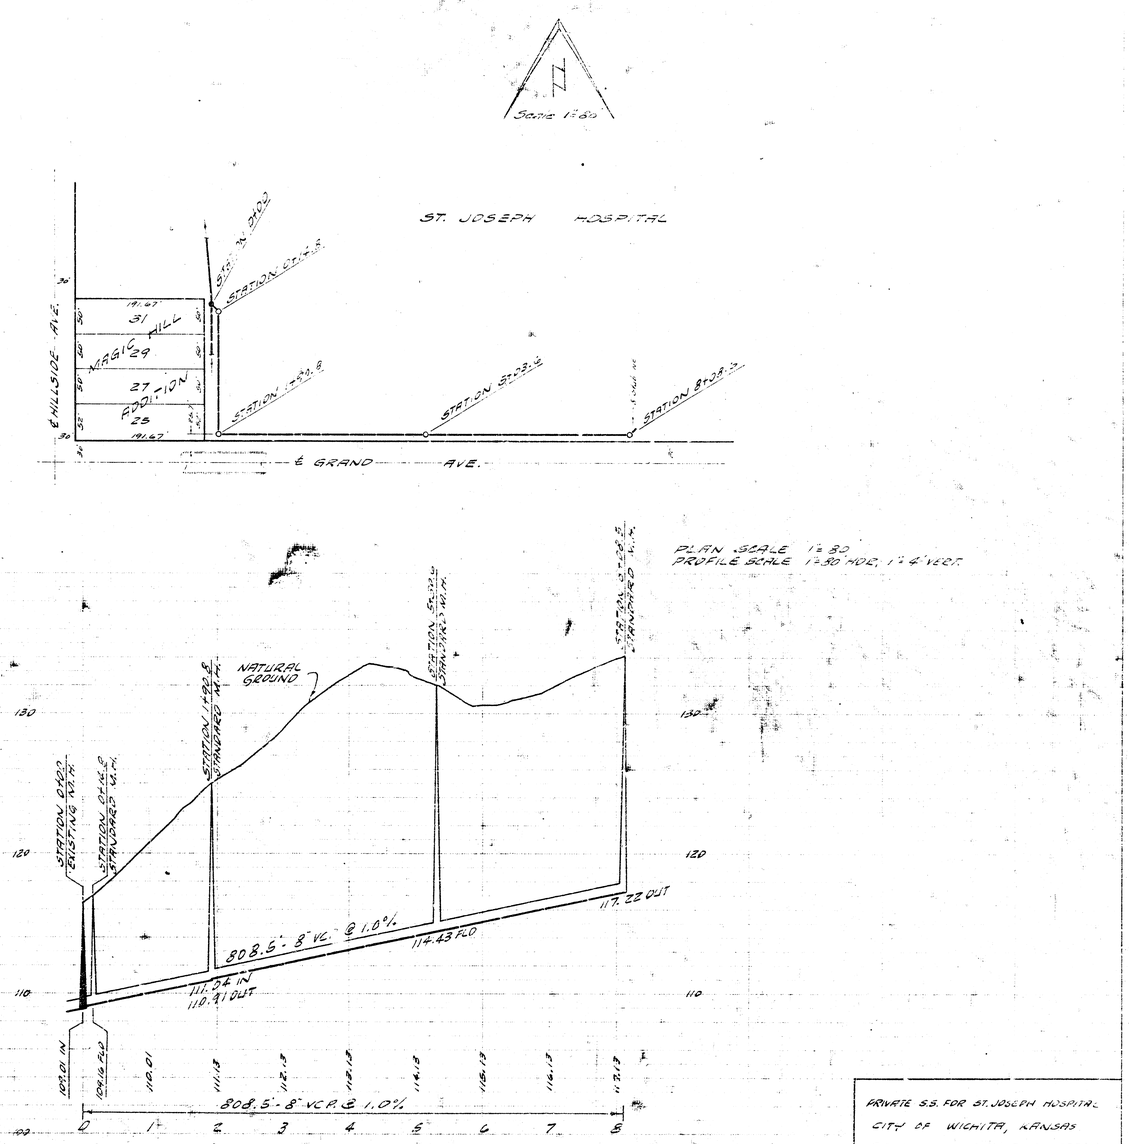

PRIVATE S.S. FOR ST. JOSEPH HOSPITAL
CITY OF WICHITA, KANSAS
B.E. SMITH CITY ENGINEER
PRIVATE JOB. JUNE 1960