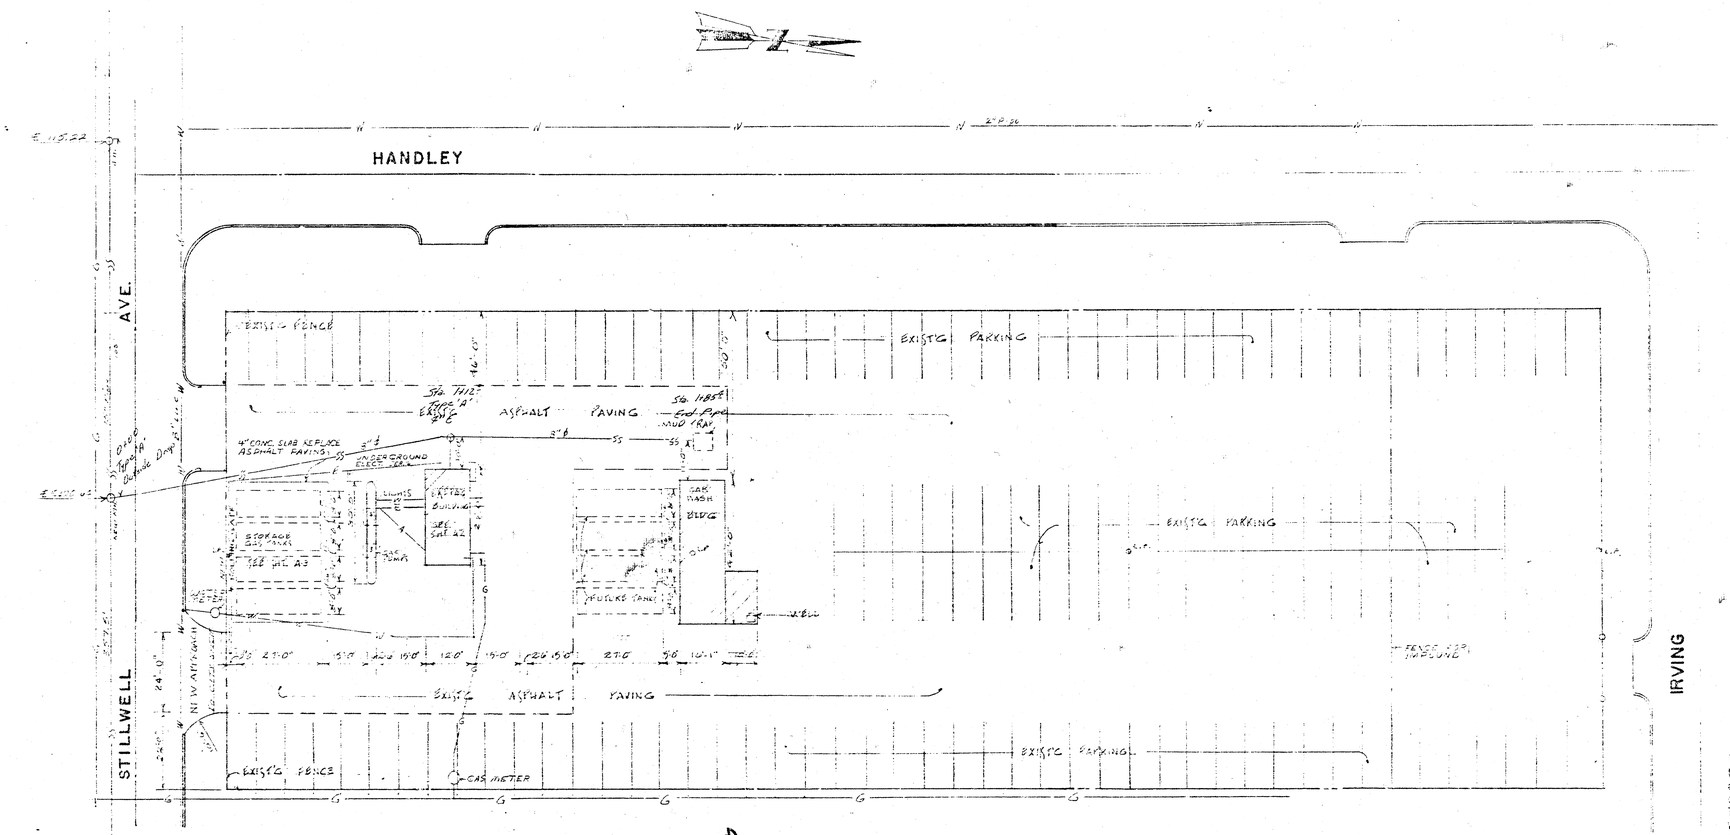


PROFILE SANITARY SEWER LINE
SCALE 1"=20'

O.W. Quit SW Top ½ Fire Plug
NE Cor. Handley & Still well
El. 126.05

SITE PLAN
SCALE 20'-0"=1"

LEGAL DESCRIPTION
LOTS 20D A [illegible] 19 [illegible] 23
THE SOUTH 20-1 OF LOT 24
FRANKLIN PARK ADDITION
WICHITA, KANSAS

GENERAL NOTE:
INSTALL 208 V. SINGLE PHASE CONTROL CIRCUIT & POWER CIRCUIT FOR 2 HP. SUBMERGIBLE PUMP AS REQUIRED BY PUMP MANUFACTURER.

NOTE TO CONTRACTOR
This project will be constructed under the supervision of the CITY ENGINEER and conforming to the SPECIFICATIONS of the CITY OF WICHITA. The CONTRACTOR shall [illegible] the CITY OF Wichita for all cost of [illegible] inspection.

8-31-79
APPROVED AS NOTED
By CITY ENGINEER OF WICHITA
Sanitary Sewers
Storm Sewers
Driveway Approaches

EIR AR01

SERVICE STATION AND CAR WASH FACILITY

068-76-28-30029-000-000-008

PREPARED BY
SEDGWICK COUNTY DEPARTMENT OF PUBLIC WORKS

REVISED	SCALE	DESIGNED	TRACED	CHECKED	SHEET NO.
	AS NOTED	GCM JUKE	N.J. GRAHAM		A-1
	DATE				
	PLANFILE		TOTAL SHEETS		