


FILMED FROM THE BEST AVAILABLE COPY

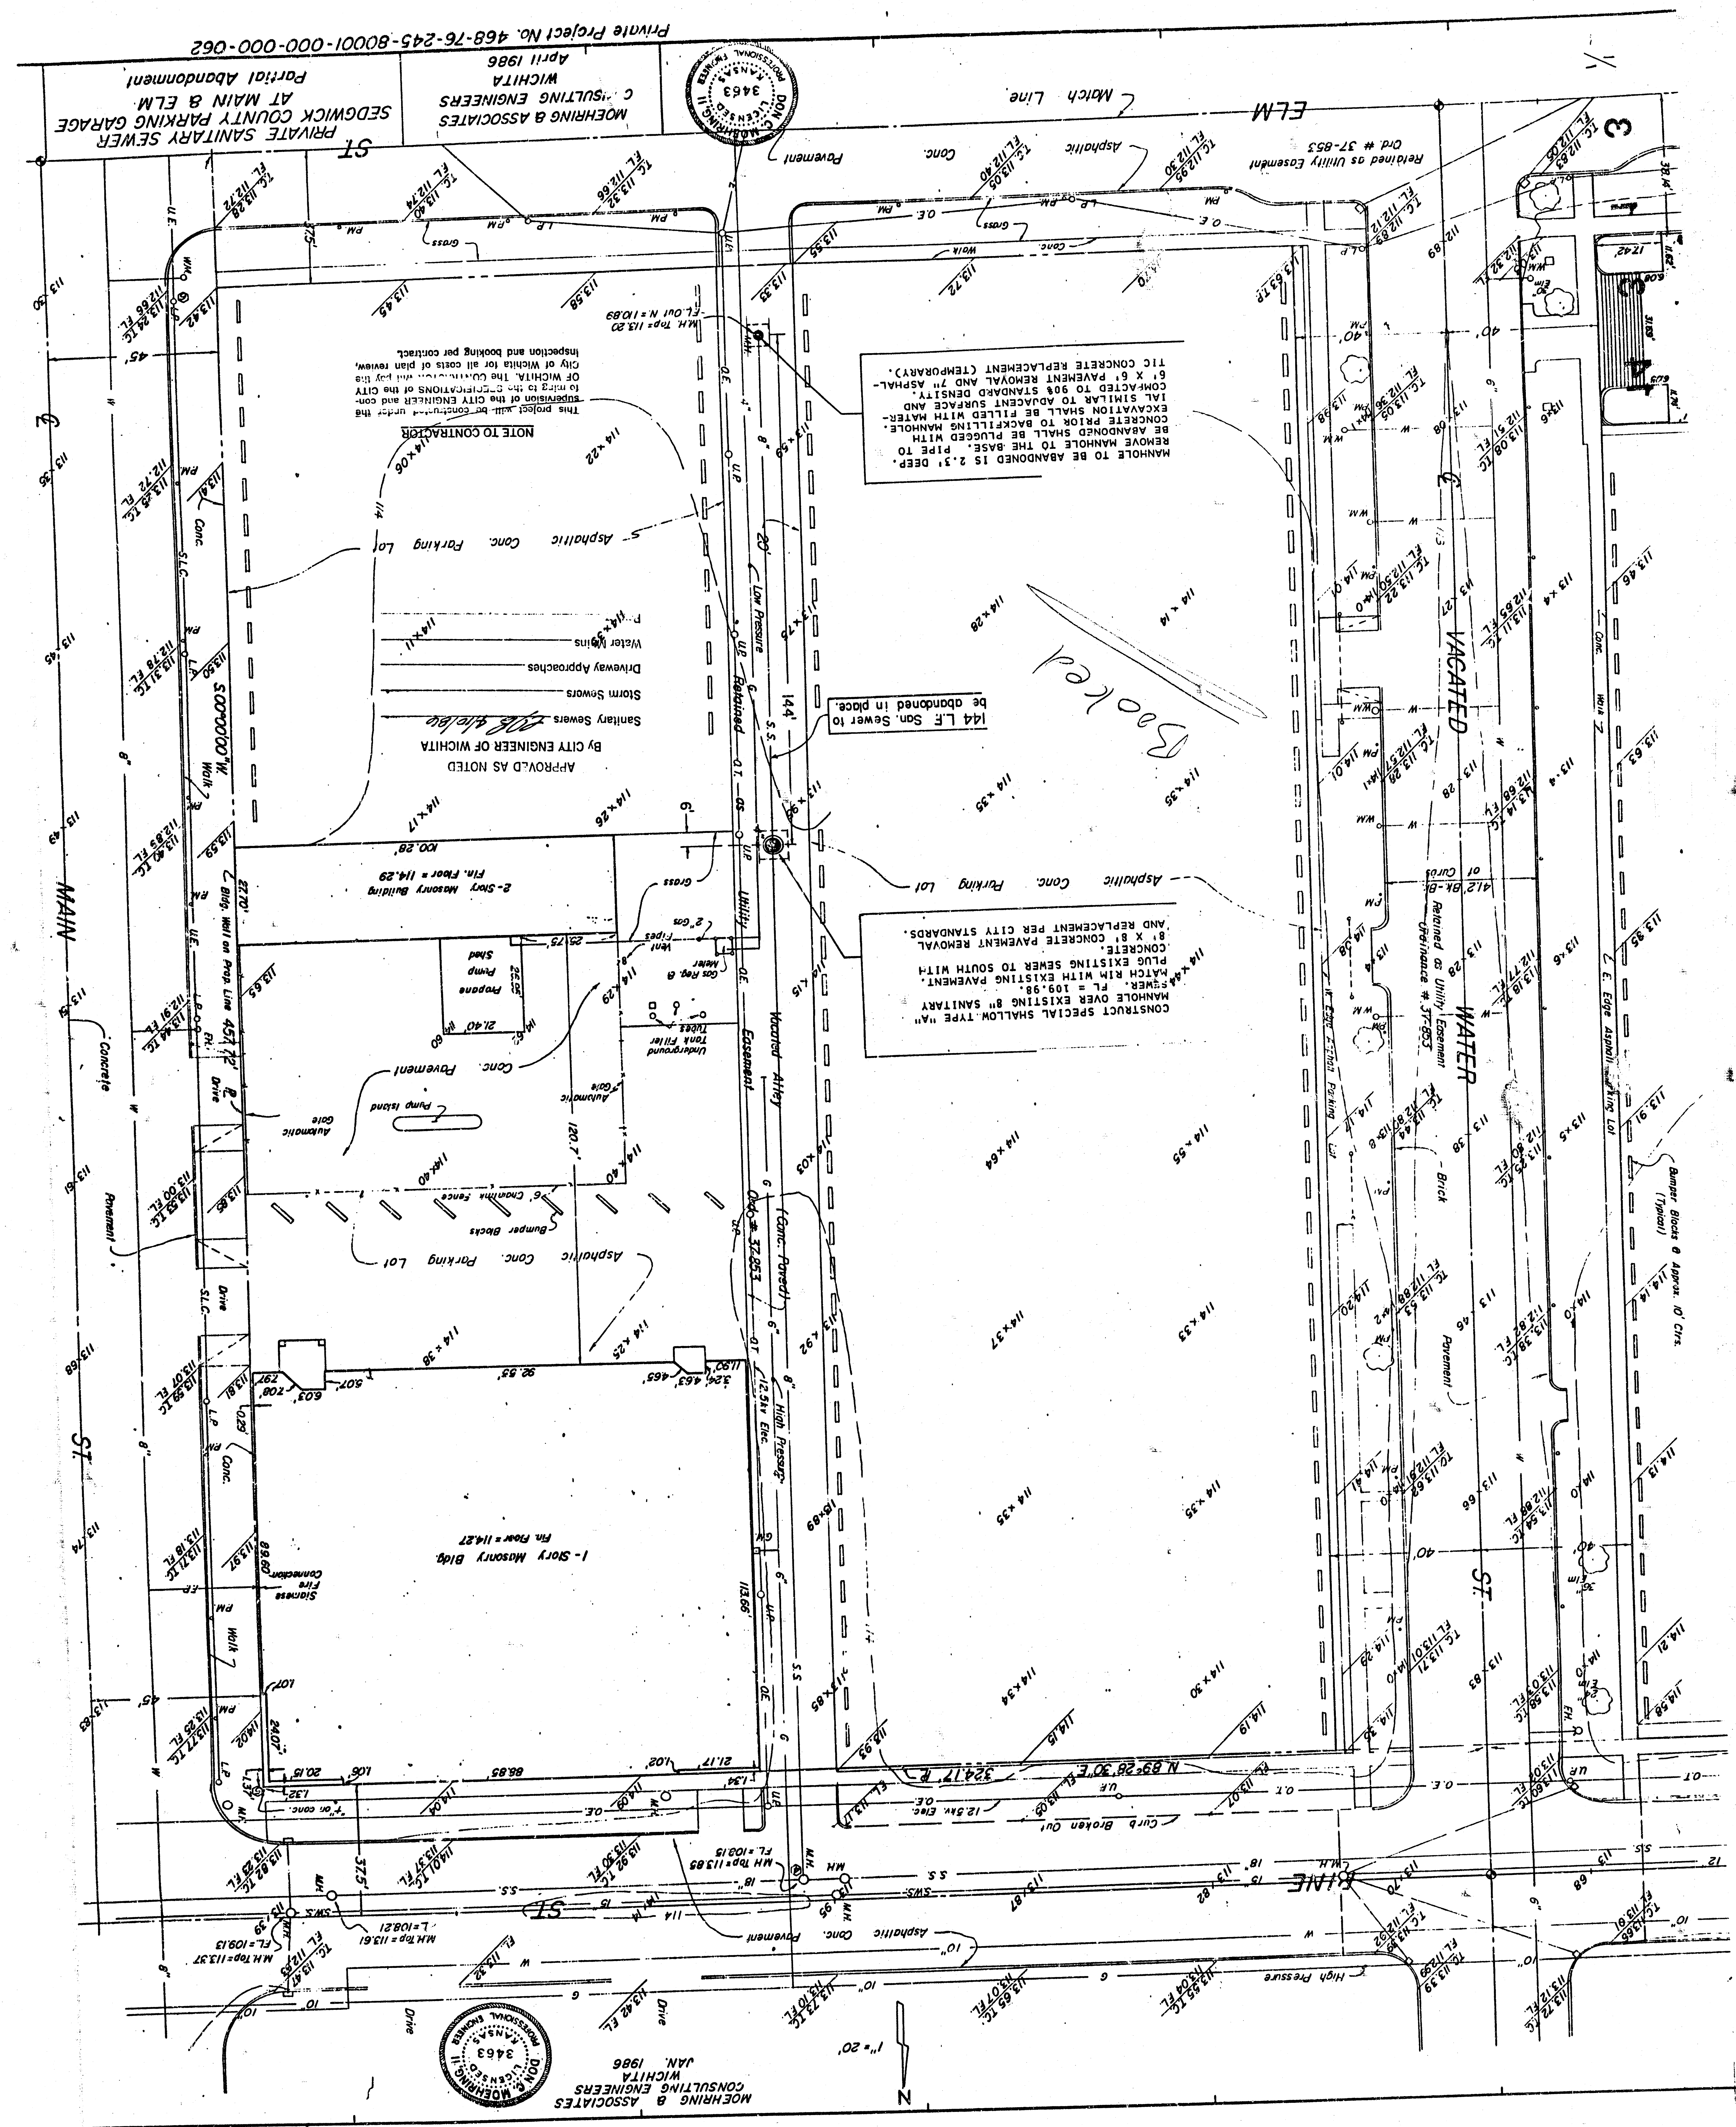

Private Project No. 468-76-245-80001-000-000-062
April 1986
WICHITA
MOEHRING & ASSOCIATES
CONSULTING ENGINEERS
Partial Abandonment
PRIVATE SANITARY SEWER
SEDGWICK COUNTY PARKING GARAGE
AT MAIN & ELM

MOEHRING & ASSOCIATES
CONSULTING ENGINEERS
WICHITA
JAN. 1986