


PUB. ROAD DIV. NO.	STATE	PROJECT NO.	FISCAL YEAR	SHEET NO.
5	KANSAS	87 RS 428(13)		

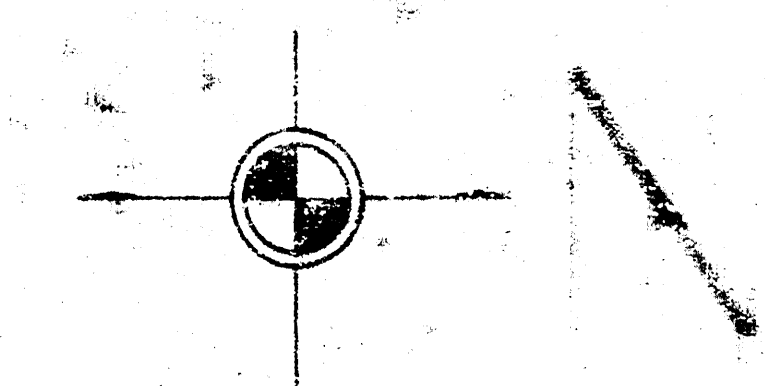

Plan Scale 1"=20'
Profile Scale 1"=20' HORIZ.
1"=5' VERT.

SEDGWICK

COUNTY


ZOO

lot 1


Block "A"

SECOND

ADDITION

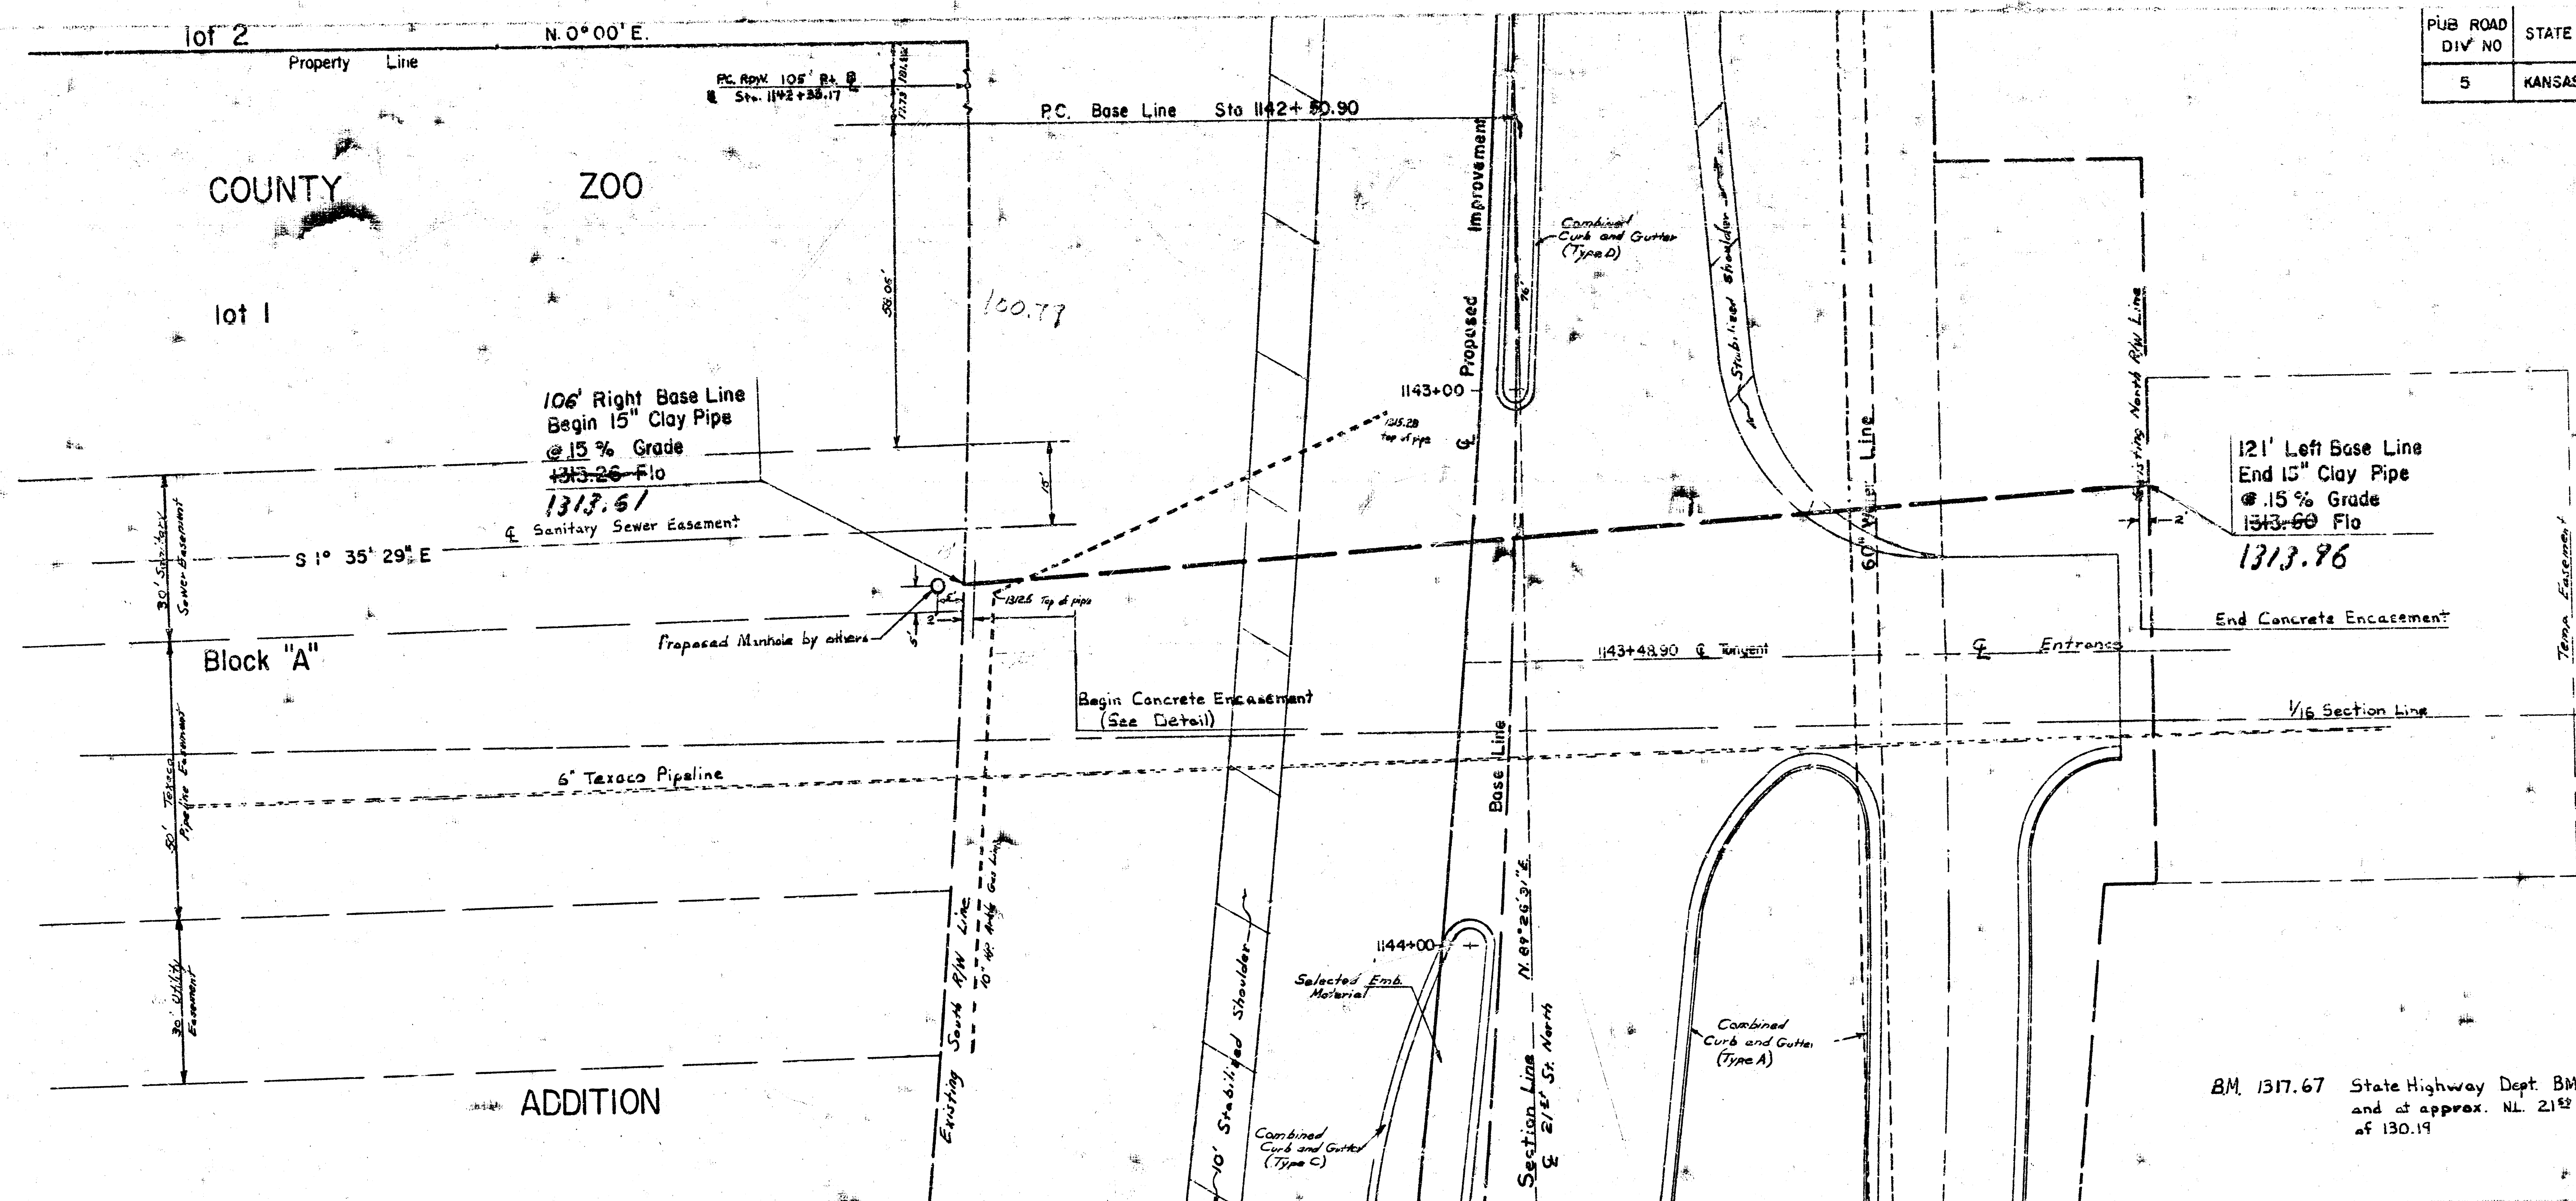

BM. 1317.67 State Highway Dept. BM #32A - Steel Fence Post at 1139+78.1 and at approx. NL 2182 Street North = City of Wichita Station of 130.19

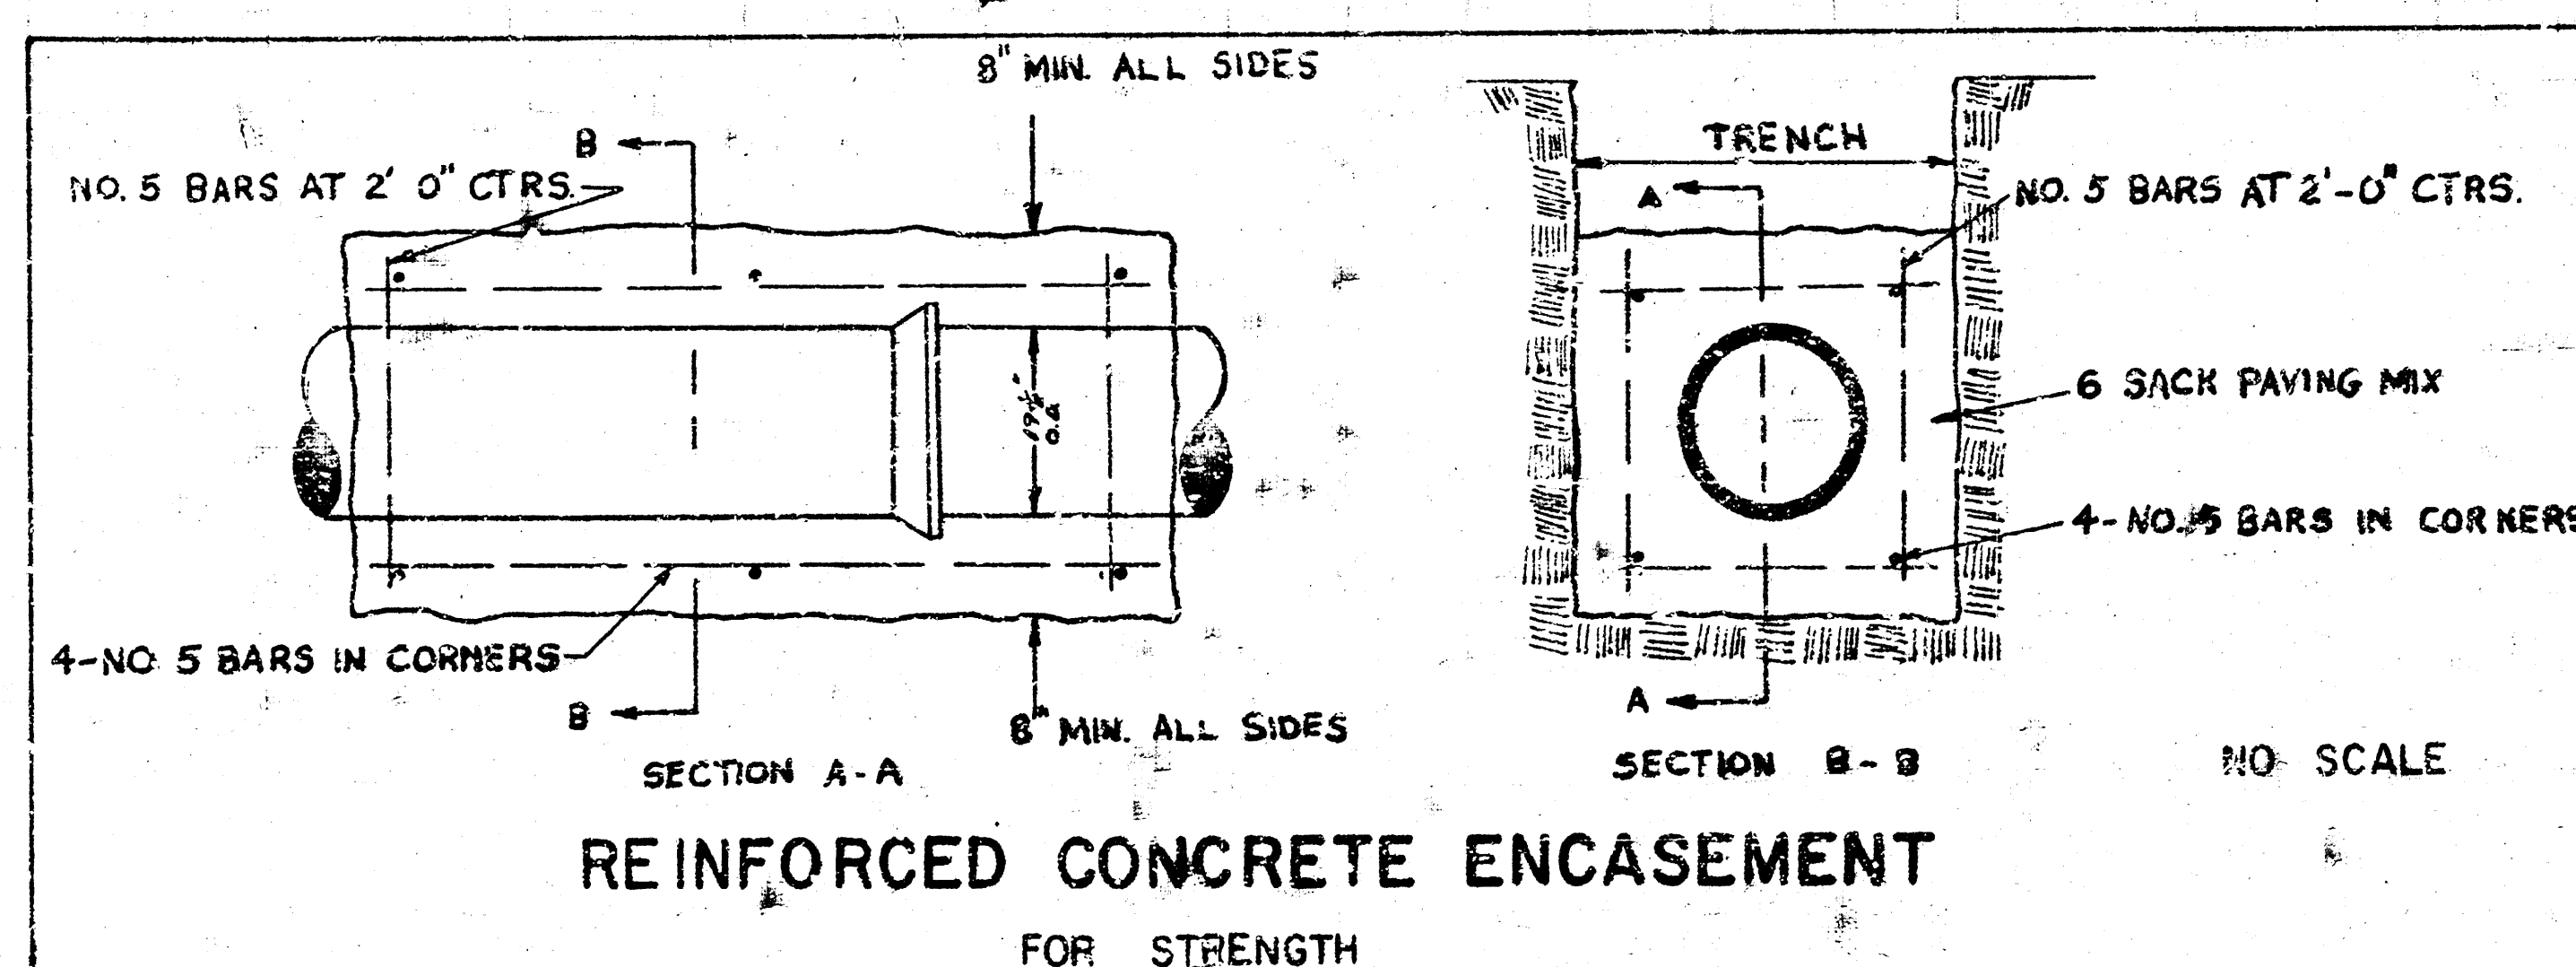


1325

1320

1315

1310

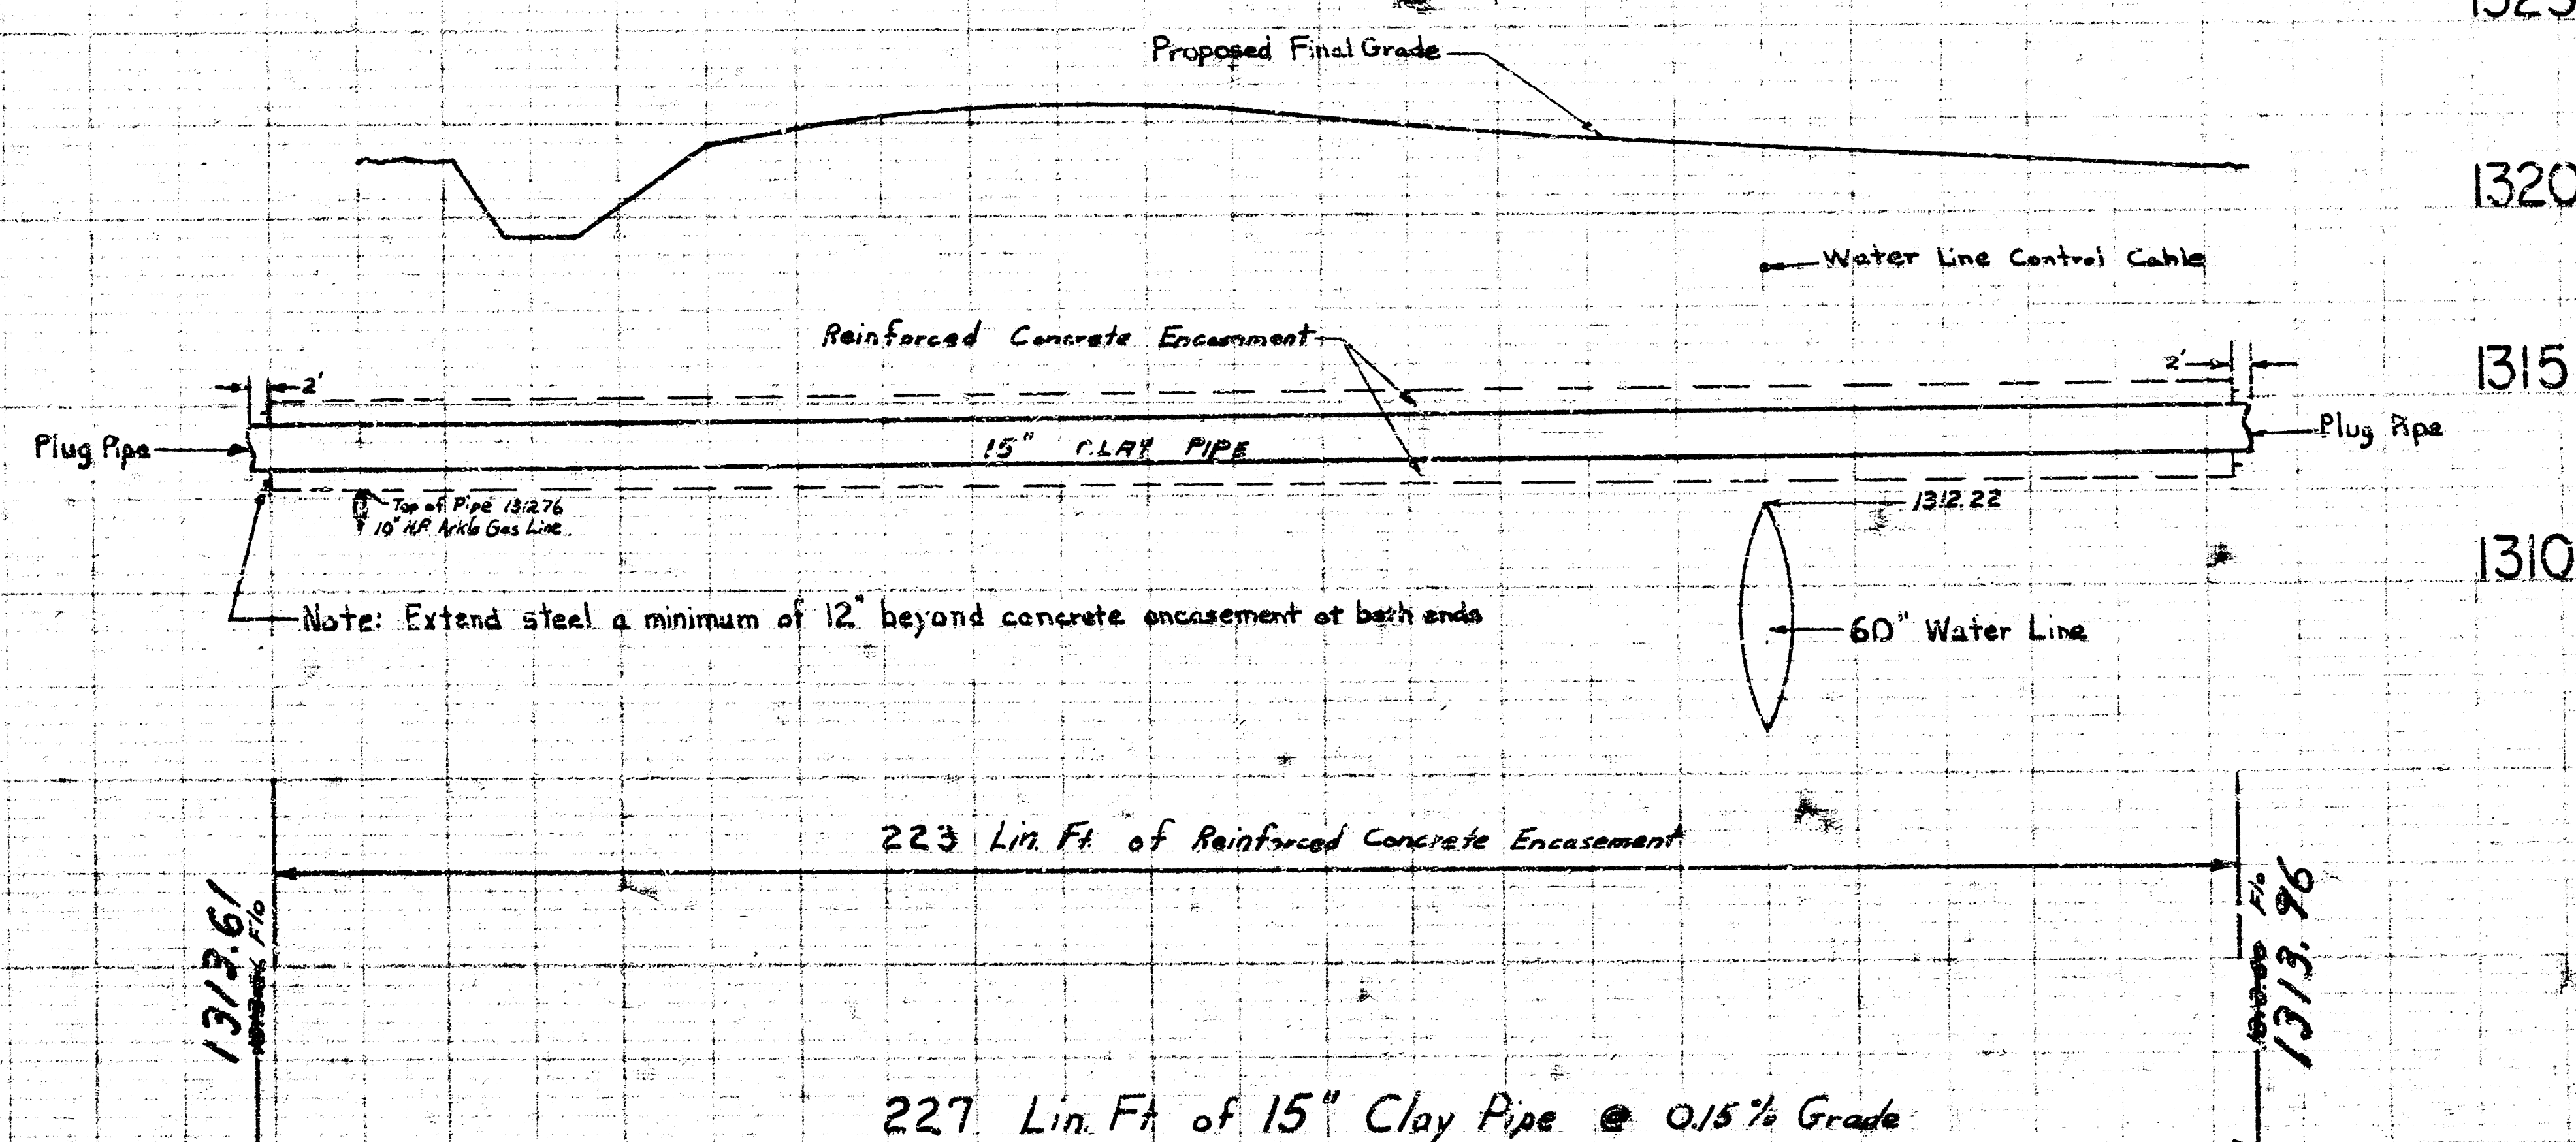

1325

1320

1315

1310

SANITARY SEWER CROSSING
TWENTY FIRST STREET
NORTH OF SEDGWICK CO.
ZOO

PRIVATE PROJECT DBKW705057