APPROVED AS NOTED
By CITY ENGINEER OF WICHITA
Sanitary Sewers _____
Storm Sewers _____
Driveway Approaches _____
Water Mains 5/15/90
Paving _____

GENERAL NOTES

1. Line No. 1 from Sta. 0+00 to Sta. 0+91.27 is a City of Wichita lateral. This line will be constructed and accepted by the City before beginning construction on the remaining lines.

2. Construction staking for all lines including the City line will be furnished by the owner. The owner will provide for inspection of all sewer lines except for the City lateral.

3. Site grading shall be completed before constructing interior lines. Manhole tops shall be 0.2' above Finish Grade. If the manhole top elevation varies more than 0.2 of a foot above Finish Ground the contractor shall verify the elevation with the Engineer prior to construction of the manhole or pay to adjust them to proper elevation.

4. During backfill operations, a safety green plastic ribbon extended across the Williams Natural Gas Company easement shall be laid 12" to 18" above the sewer line in both sides of the trench. A minimum of two feet of clearance shall be maintained between the pipe lines.

5. The buried utilities as located on the plans are approximate locations only. It should be noted that other lines and cables may exist which are not shown on these plans. The contractor shall exercise extreme caution during trenching operations to avoid damaging these lines. Any lines damaged shall be replaced or repaired immediately as directed by the Engineer at the contractor's expense.

6. The Contractor shall notify pipeline companies at least 24 hours in advance of any work being performed across and/or adjacent to pipelines.

7. The Contractor shall be responsible for maintaining continuous flow of sewage through construction. Contractor's proposed method for maintaining sewage flow shall be approved by the Engineer. Cost of maintaining flow of sewage through construction will not be paid for directly and this cost shall be considered as subsidiary to the other pay items of work.

8. The Contractor shall be responsible for preserving property irons. The Contractor will be required to re-establish any property irons which are damaged or destroyed by his construction operations. Such irons shall be re-established by a licensed land surveyor in accordance with state laws.

9. If the City of Wichita requires Bond Guarantees, testing or inspection on this project it will be the responsibility of the Contractor to contract with the City and pay for these costs. The Contractor will then be reimbursed by the owner for these expenses.

10. All sewer mains must be air tested and televised. The Contractor must provide all equipment for these tests.

11. The Contractor shall make arrangements with the County Engineering Department to close 47th Street for construction of Line No. 1 across 47th Street South. If specific signing details or route maps are required they will be furnished by the Engineer. The Contractor must also obtain a County Permit for this construction. Fees for the permit shall be paid by the owner.

12. The current site plan dated 3-20-90 indicates a number of non-typical sites. Installation of all sewer service lines shall conform to this revised site plan. These locations shall be verified by the contractor before beginning construction.

13. Risers shall be installed as shown on the standard riser detail sheet. They shall be installed at all locations where the low end of the service line is more than 2.5' above the main. (Paid for as L.F. of 4" Polyvinyl Pipe).

14. Cleanouts will be required at horizontal bends in Sewer Sewer Lines as per City Building Code.

15. Any costs for Dewatering shall be included in the price bid For Sewer Pipe.

CONSTRUCTION PLANS FOR SANITARY SEWER SYSTEM EXTENSIONS

SOUTHBOROUGH ESTATES

CITY OF WICHITA PRIVATE PROJECT NO. INDEX CODE 247PPS607861

REVISED 4-10-90

"AS BUILT PLANS"
8-9-90

APRIL 1990

POE & ASSOCIATES OF KANSAS INC.
CONSULTING ENGINEERS
434 N. Clifton, Suite 110 ■ Wichita, KS 67208 ■ 316/685-4114

INDEX

TITLE SHEET	SHEET NO. 1
TYPICAL UNIT SITE PLAN	SHEET NO. 2
OVERALL SITE PLAN	SHEET NO. 3
PLAN & PROFILE(LINE NO. 1)	SHEET NO. 4
PLAN & PROFILE(LINE NO. 1-A & 1-A-1)	SHEET NO. 5
PLAN & PROFILE(LINE NO. 2 & 2-A)	SHEET NO. 6
SEWER DETAILS	SHEET NO. 7
MANHOLE-TYPE "C"	SHEET NO. 8
MANHOLE-TYPE "P"	SHEET NO. 9
SHALLOW MANHOLE-TYPE P&C	SHEET NO. 10
VERTICAL RISER DETAIL	SHEET NO. 11

BENCH MARKS

NOTE: City of Wichita BM's have been converted to U.S.G.S. Datum.

1. B.M. 1277.04 Top of iron in thimble at SE corner Sec. 24-T28S-R1W.
2. B.M. 1275.86 City of Wichita disc 30' West and 44' North of 1/4 Cor. at Meridian Ave. and 47th St. South.
3. B.M. 1279.02 City of Wichita disc 44' North and 30' East of centerlines of Meridian Ave. and 47th St. South.
4. B.M. 1280.64 City of Wichita disc 44' North and 30' East 1/4 Cor. at Meridian Ave. and 43rd St. South.
5. BM 1273.53 Std. Tablet 41' South and 36' East of the SE Cor. Sec. 24, T28S, R1W

NOTE TO CONTRACTOR


INSPECTION AND TESTING FOR THIS PROJECT IS TO BE PROVIDED BY A LICENSED CONSULTING ENGINEERING FIRM UNDER CONTRACT WITH THE OWNER/DEVELOPER. SAID INSPECTION TO BE IN ACCORDANCE WITH THE CITY OF WICHITA STANDARD CONSTRUCTION ENGINEERING PRACTICES AND CERTIFIED BY A LICENSED PROFESSIONAL ENGINEER. NO WORK SHALL BE PERFORMED IN DEDICATED EASEMENTS OR THE PUBLIC RIGHT-OF-WAY BY THE CONTRACTOR WITHOUT SUCH INSPECTION NOR SHALL ANY WORK BE COMMENCED IN DEDICATED EASEMENTS OR PUBLIC RIGHT-OF-WAY WITHOUT WRITTEN AUTHORIZATION BY THE CITY ENGINEER.

KENNY E. HILL
LICENSED
7690
KANSAS
PROFESSIONAL ENGINEER

FILMED FROM THE BEST AVAILABLE COPY

PLAN	REVISED	BY	DATE
NOTE BOOK	PLOTTED		
NO.	CHECKED		
	AS-BUILT CHECKED		
	R.O.W. CHECKED		

PROFILE	SURVEYED	BY	DATE
NOTE BOOK	PLOTTED		
NO.	CHECKED		
	STRUCTURE NOTES PHS. CH'S CK'D		

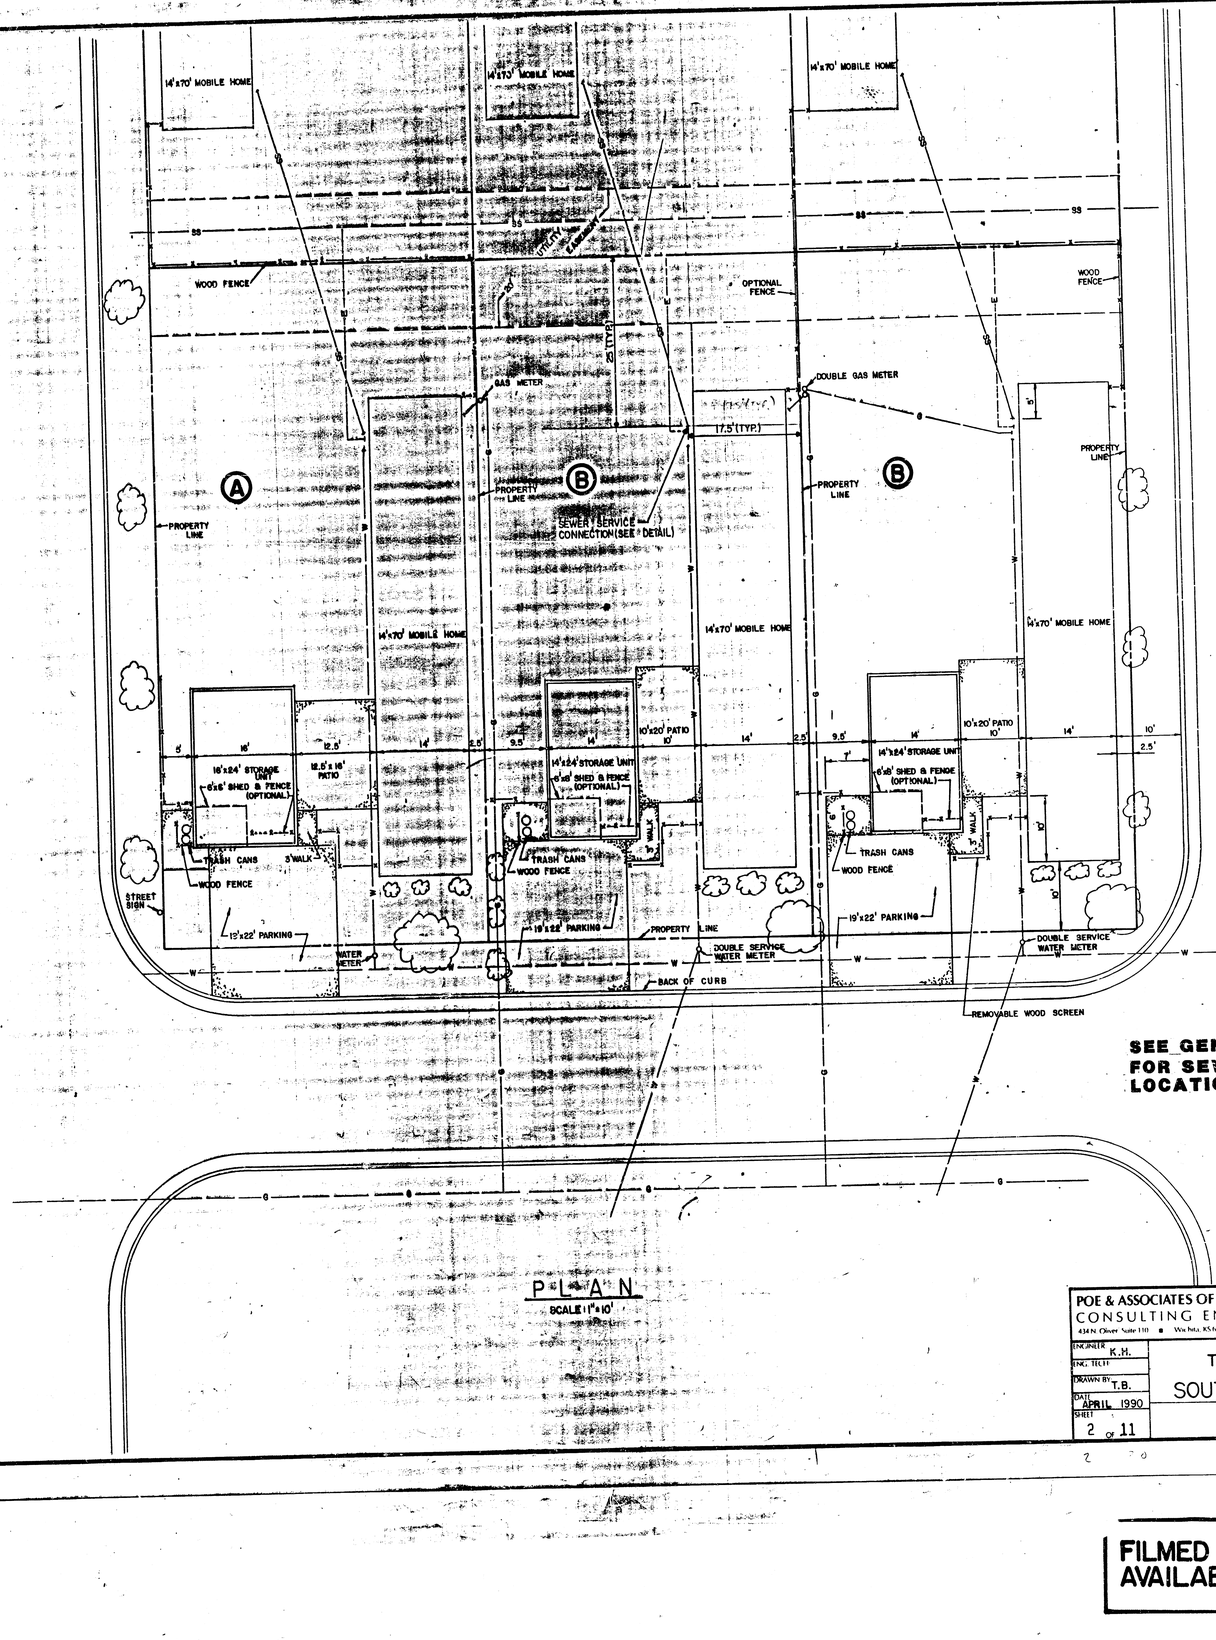

SEE GENERAL NOTE NO. 12 FOR SEWER SERVICE LOCATIONS


P L A N

SCALE 1" = 10'

POE & ASSOCIATES OF KANSAS INC.
CONSULTING ENGINEERS
434 N. Oliver Suite 110 ■ Wichita, KS 67208 ■ 316/685-3114

ENGINEER K.H.	TYPICAL UNIT SITE PLAN
ENG. TECH	SOUTHBOROUGH ESTATES
DRAWN BY T.B.	PROJECT NUMBER
DATE APRIL 1990	WC 1405-R2
SHEET 2 of 11	

FILMED FROM THE BEST AVAILABLE COPY ····

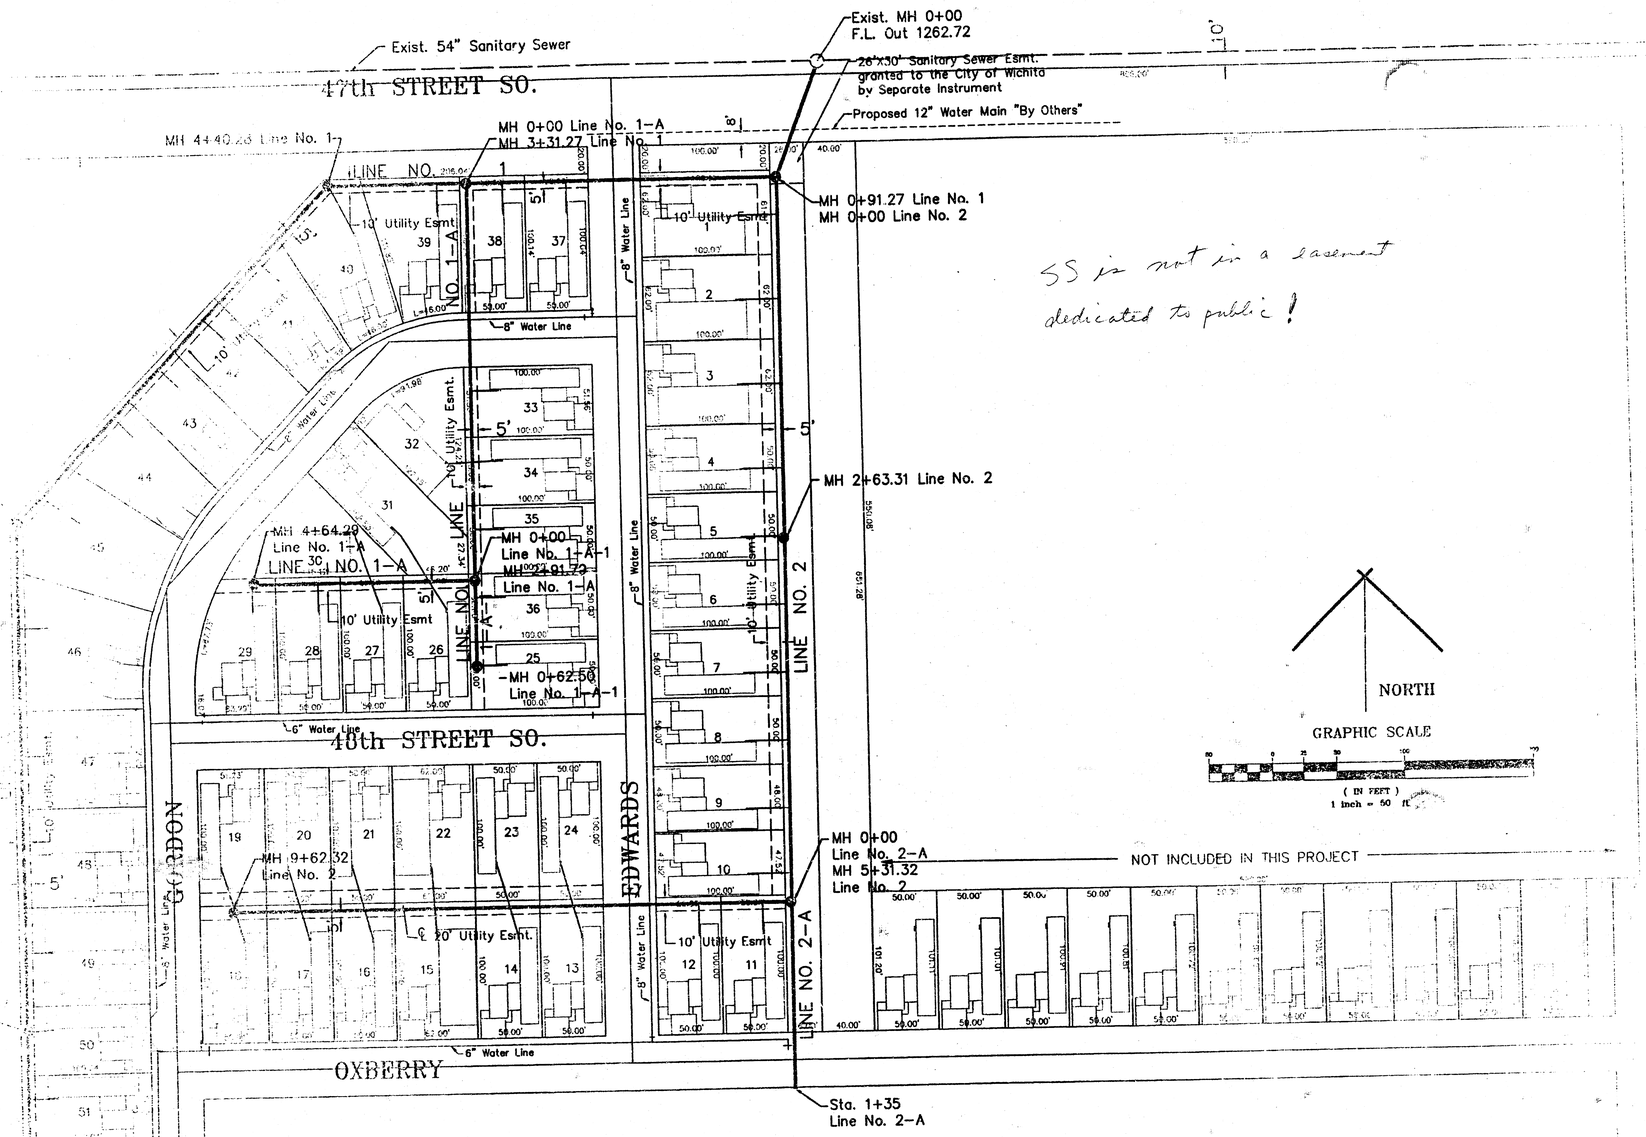

SS is not in a easement dedicated to public!

SOUTHBOROUGH ESTATES

DATE: 3-20-90

SANITARY SEWER SYSTEM EXTENSIONS

FILMED FROM THE BEST AVAILABLE COPY

STATE	PROJECT NO.	FISCAL YEAR	SHEET NO.	TOTAL SHEETS

PLAN — SURVEYED, PLOTTED, GRADES CHECKED, R/W & EASEMENT CHECKED, RT. OF WAY CHECKED, NOTE BOOK, NO., DATE, BY

Sta. 0+91.27 Line No.1
Sta. 0+00 Line No. 2
Const. Std. MI Type "P" or "C"

26'x30' Sanitary Sewer Esmt granted to the City of Wichita by Separate Instrument

-LINE NO. 2-

Water Line

EDWARDS

-LINE NO. 1-A-1-

48TH STREET SO.

-LINE NO. 2-

36" Storm Drain

12+43.5
Sta. ~~12+44~~ Line No. 1
Install 8" Cap

Water Line

Sta. 10+99.77 Line No. 1
Const. Std. MI Type "P" or "C"

Sta. 0+00 Line No. 1
Connect to Exist. Manhole
(See Detail Sh. No. 5
F.L. Out 1262.72

Remove and Replace Asphalt Pavement (See Detail Sh.No. 7)

Proposed 12" Water Main by Others

Sta. 3+31.27 Line No. 1
Sta. 0+00 Line No. 1-A
Const. Std. MI Type "P" or "C"

-LINE NO. 1-A-

GORDON

Water Line

Sta. 4+40.28 Line No. 1
Const. Std. MI Type "P" or "C"

Sta. 7+86.02 Line No. 1
Const. Std. MI Type "P" or "C"

-LINE NO. 1-

5'

CAUTION
20" GAS PIPELINE
SEE GENERAL NOTE NO. 4

NOTE: All Pipe is 8" PVC

NORTH

SCALE IN FEET
40 0 40 80
HORIZ.
0 5
Vert.

PROFILE — SURVEYED, PLOTTED, GRADES CHECKED, R/W & EASEMENT CHECKED, STRUCTURE NOTATIONS CHKD, NOTE BOOK, NO., DATE, BY

LINE NO. 1

1280
1275
1270
1265
1260

Top MH ~~1283~~ 1278.1
Top MH ~~1278.5~~ 1277.6
Top MH 1277.2
Top MH 1276.0
Top MH ~~1275.7~~ 1275.64

Original Ground Line
Final Ground Line

8" Water Line

MH Depth 15.80
MH Depth 11.22
MH Depth 10.03'
MH Depth 7.65
MH Depth 6.28

20" Gas Main Verify Depth

Line No. 2
FL 1266.13

Sta. 1+01.27
℄ Main Line Trap

Line No. 1-A
FL 1270.85

331.27 L.F. 8" Pipe @ 0.3% Grade

909.73 L.F. 8" Pipe @ 0.3% Grade

36" Storm Drain

(+99.77)
1269.36

(1435)
1269.66

1269.70

	0	1	2	3	4	5	6	7	8	9	10	11	12
	(+.00)	(+91.27)			(+31.27)	(+40.28)			(+86.02)				
	(75.32 City Datum) 1262.72 Out	(78.03 City Datum) 1266.03 Out		1266.76		1267.06	1267.31 Out		1267.46	1267.76	1268.06	1268.32 Out	1269.06
	1265.76 In	1266.13 In	1266.46		1266.85		1267.23 In					1268.42 In	
	(78.36 City Datum)	(78.73 City Datum)											

POE & ASSOCIATES OF KANSAS INC.
CONSULTING ENGINEERS
434 N Oliver Suite 110 ▫ Wichita, KS 67208 ▫ 316/685-4114

ENGINEER	KH
ENG TECH	TEB
DRAWN BY	TEB
DATE	APRIL 1990
SHEET	4 OF 11


SANITARY SEWER SYSTEM EXTENSIONS
LINE NO. 1
SOUTHBOROUGH ESTATES
PROJECT NUMBER
WC 1405-R2

4/11


FILMED FROM THE BEST AVAILABLE COPY

STATE	PROJECT NO.	FISCAL YEAR	SHEET NO.	TOTAL SHEETS

PLAN — SURVEYED, PLOTTED, NOTE BOOK, NO., DATE, BY, ALIGNMENT CHECKED, RT. OF WAY CHECKED

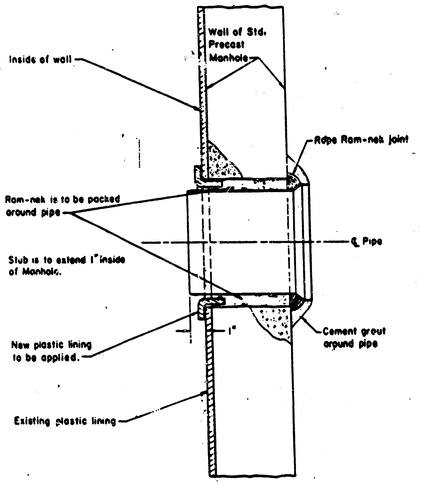



EXISTING MANHOLE CONNECTION DETAIL
NO SCALE

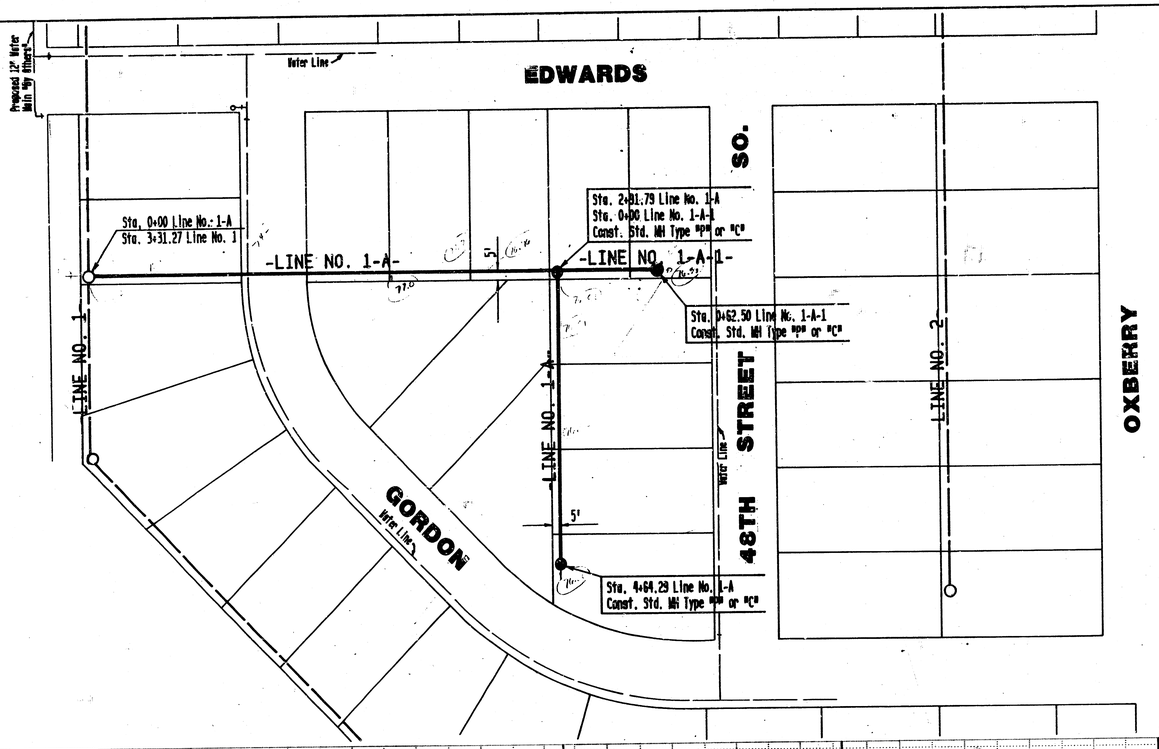


NOTE: All Pipe is 8" PVC

PROFILE — SURVEYED, PLOTTED, NOTE BOOK, NO., DATE, BY, GRADES CHECKED, ALL UTILITIES SHOWN, STRUCTURE NOTATIONS CHECKED

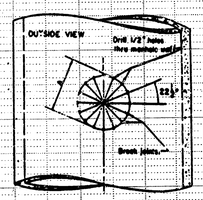

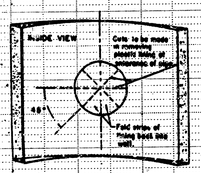

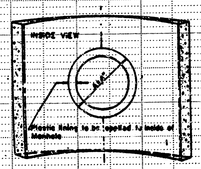

A = OUTSIDE DIAMETER OF PIPE ± 8"

POE & ASSOCIATES OF KANSAS INC.
CONSULTING ENGINEERS
434 N. Oliver, Suite 110 ■ Wichita KS 67208 ■ 316/685-4114

ENGINEER	KH
ENG. TECH	TEB
DRAWN BY	TEB
DATE	APRIL 1990
SHEET	5 OF 11

SANITARY SEWER SYSTEM EXTENSIONS
LINE NO. 1-A & 1-A-1
SOUTHBOROUGH ESTATES
PROJECT NUMBER
WC 1405-R2

5/11

FILMED FROM THE BEST AVAILABLE COPY

STATE	PROJECT NO.	FISCAL YEAR	SHEET NO.	TOTAL SHEETS

PLAN — SURVEYED / PLOTTED / NOTE BOOK / NO. — ALIGNMENT CHECKED / PROFILE CHECKED / ALL NOTES, CONSTRUCTION NOTATIONS CHKD — BY — DATE

26'x30' Sanitary Sewer Esmt. granted to the City of Wichita by Separate Instrument

NORTH

SCALE 40 0 40 80 IN FEET HORIZ. — 0 5 Vert.

Sta. 0+00 Line No. 2
Sta. 0+91.27 Line No. 1

Sta. 2+63.31 Line No. 2
Const. Std. WI Type "P" or "C"

Sta. 5+31.32 Line No. 2
Sta. 0+00 Line No. 2-A
Const. Std. WI Type "P" or "C"

Sta. 1+35 Line No. 2-A
Install 8" Cap

-LINE NO. 1- -LINE NO. 2- -LINE NO. 2-A-

Proposed 12" Water Main "By Others"

Water Line

EDWARDS

GORDON

48TH ST. SO.

OXBERRY

-LINE NO. 2-A-

Sta. 9+62.32 Line No. 2
Const. Std. WI Type "P" or "C"

Sta. 5+31.32 Line No. 2
Sta. 0+00 Line No. 2-A

EDWARDS

GORDON

48TH STREET SO.

NOTE: All Pipe is 8" PVC

PROFILE — SURVEYED / PLOTTED / NOTE BOOK / NO. — HORIZ. SCALE 1" = 40' / VERT. SCALE 1" = 5' — BY — DATE

LINE NO. 2

LINE NO. 2-A

1280 / 1275 / 1270 / 1265 / 1260

Top MH 1279.85 1278.1
Top MH 1277.8
Top MH 1277.0 1276.8
Top MH 1276.4 1274.9

Original Ground Line
Final Ground Line
8" Water Line

MH Depth 10.86
MH Depth 5.36
MH Depth 9.40
MH Depth 9.88

Line No. 1 FL 1266.03
Sta. 0+10 ℄ Main Line Trap
Line No. 1 FL 1266.13

Line No. 2-A FL 1267.72

Line No. 2 FL 1267.72 Out
Line No. 2 FL 1270.30 In

531.32 L.F. 8" Pipe @ 1% Grade
431 L.F. 8" Pipe @ 0.4% Grade
135 L.F. 8" Pipe @ 9.3% Grade

(+00) (+53.31) (+31.32) (+62.32) (+00) (.35)

1266.03 Out / 1266.13 In — 1266.13 — 1266.73 — 1266.92 — 1267.03 — 1267.38 — 1267.65 — 1267.72 Out / 1270.30 In — 1270.57 — 1270.97 — 1271.37 — 1271.77 — 1272.02 — 1267.72 — 1268.02 — 1268.13

0 1 2 3 4 5 6 7 8 9 10


POE & ASSOCIATES OF KANSAS INC.
CONSULTING ENGINEERS
434 N. Oliver, Suite 110 ■ Wichita, KS 67208 ■ 316/685-4114

ENGINEER KH
ENG. TECH TEB
DRAWN BY TEB
DATE APRIL 1990
SHEET 6 OF 11

SANITARY SEWER SYSTEM EXTENSIONS
LINE NO. 2 LINE NO. 2-A
SOUTHBOROUGH ESTATES
PROJECT NUMBER WC 1405-R2


6/11

FILMED FROM THE BEST AVAILABLE COPY

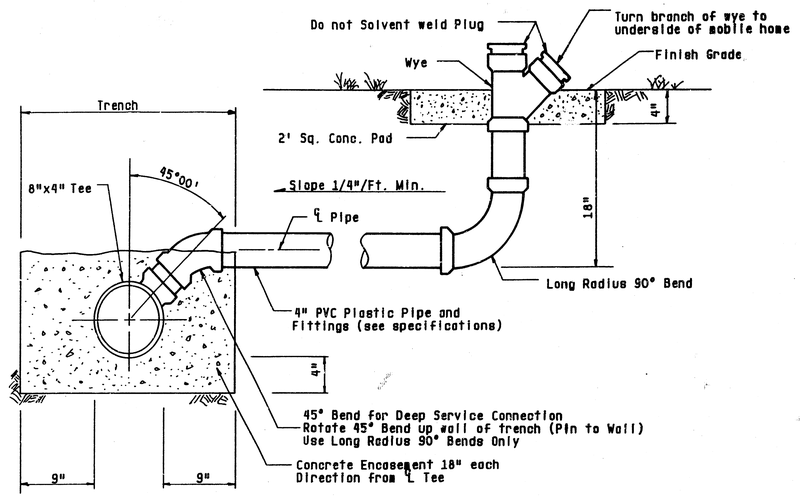


TYPICAL SINGLE SERVICE LINE

SCALE 1 1/2"=1'-0"

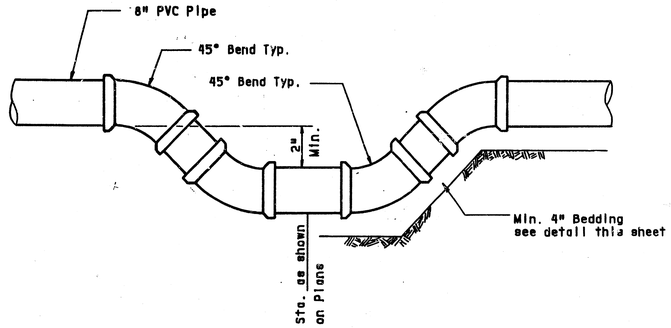


MAIN LINE TRAP

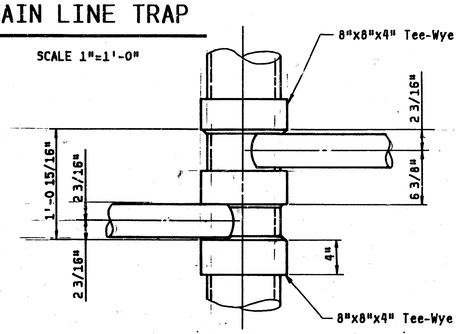


PLAN

SCALE 1 1/2"=1'-0"

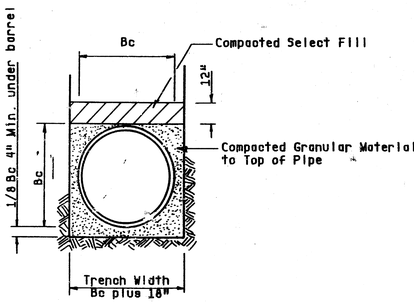


DETAIL OF IMPROVED BEDDING FOR P.V.C. PIPE

N.T.S.

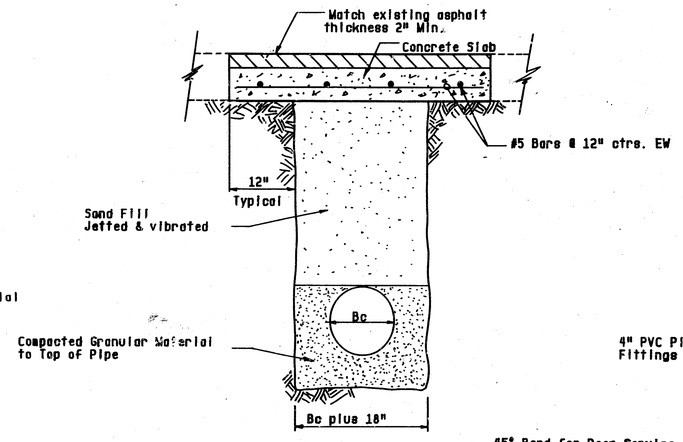

COMPOSITE PAVEMENT REPAIR

N.T.S.

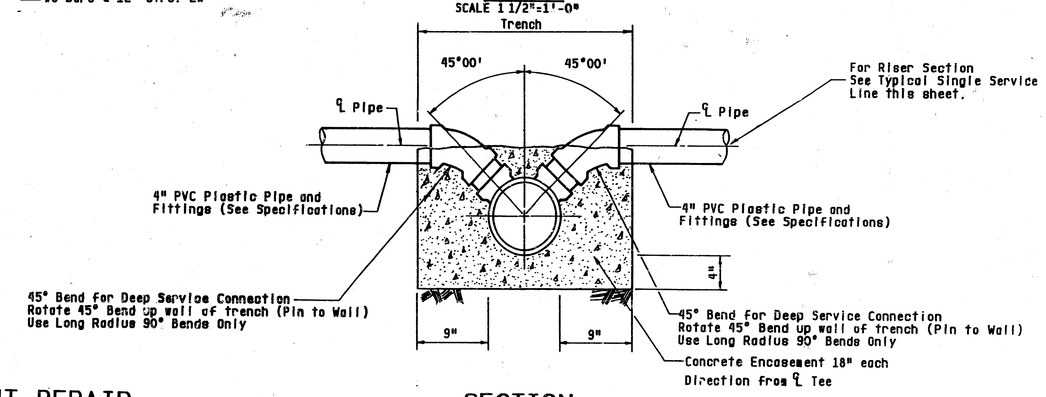

SECTION

SCALE 1 1/2"=1'-0"

TYPICAL DOUBLE SERVICE LINE

POE & ASSOCIATES OF KANSAS INC.
CONSULTING ENGINEERS
434 N. Oliver, Suite 110 ■ Wichita, KS 67208 ■ 316/685-4114


ENGINEER: K.H.	Sanitary Sewer System Extensions
ENG. TECH:	SEWER DETAILS
DRAWN BY: P.V.	SOUTHBOROUGH ESTATES
DATE: APRIL 1990	PROJECT NUMBER WC 1405-R2
SHEET: 7 of 11	

PLAN / PROFILE — SURVEYED, PLOTTED, ALIGNMENT CHECKED, GRADES CHECKED, AS-BUILT, STRUCTURE NOTATIONS CHECKED — BY — DATE — NOTE BOOK — NO.


FILMED FROM THE BEST AVAILABLE COPY

SEWER APPURTENANCES DETAILS


STANDARD MANHOLE TYPE "C"

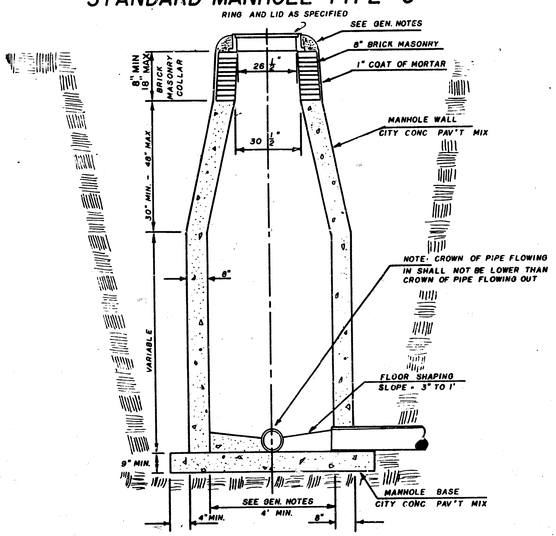

INSIDE DROP MANHOLE TYPE "C"

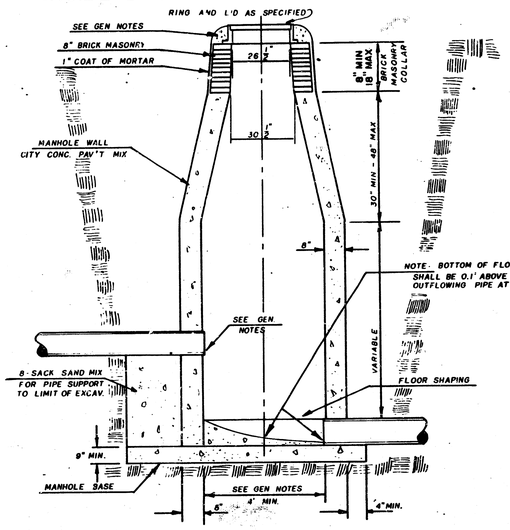

OUTSIDE DROP MANHOLE TYPE "C"

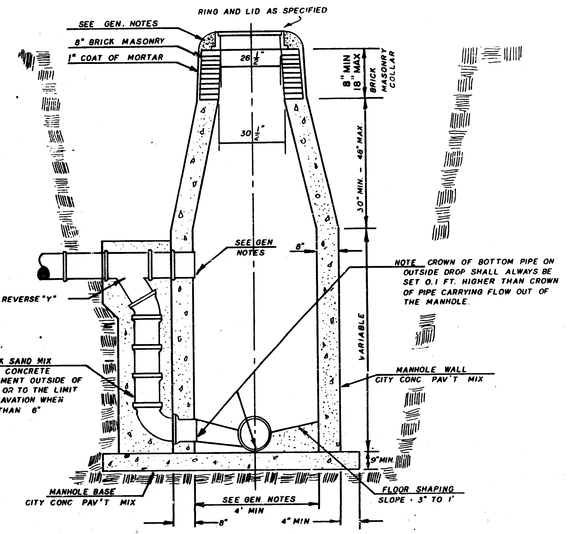

GENERAL NOTES

1. MORTAR USED IN MASONRY CONSTRUCTION SHALL CONTAIN 8 SACKS OF CEMENT PER CUBIC YARD. CONCRETE USED IN MANHOLE WALLS AND BASES SHALL CONFORM TO THE REQUIREMENTS OF CONCRETE FOR CONCRETE PAVEMENT CONSTRUCTION AS SPECIFIED IN THE CITY STANDARD PAVING SPECIFICATIONS USING CITY CONCRETE PAVEMENT MIX WITHOUT AIR ENTRAINING ADMIXTURE. MORTAR SHALL BE PLACED AROUND THE MANHOLE RING AS SHOWN ON THE DRAWINGS WHEN MANHOLES ARE CONSTRUCTED IN UNPAVED AREAS. TYPE "C" MANHOLES CAN BE CONSTRUCTED ONLY WHERE PIPE SIZES ARE 8" OR SMALLER. THE INSIDE DIAMETER OF TYPE "C" MANHOLES SHALL BE 4'. COMPLETED MANHOLE SHALL BE WITHOUT LEAKS AND WATER TIGHT.

2. REINFORCING STEEL SHALL BE INSTALLED IN THE MANHOLE BASE. REINFORCING STEEL SHALL CONSIST OF NO. 4 BARS PLACED ON 6" CENTERS IN BOTH DIRECTIONS. REINFORCING STEEL SHALL BE PLACED 6" ABOVE THE BOTTOM OF THE MANHOLE BASE. COST OF FURNISHING AND INSTALLING REINFORCING STEEL SHALL BE INCLUDED IN THE UNIT PRICE BID FOR THE MANHOLE.

3. AN OPENING SHALL BE CUT IN THE MANHOLE WALL FOR THE UPPER INLET PIPE FOR INSIDE AND OUTSIDE DROP MANHOLES. THE UPPER INLET PIPE SHALL BE GROUTED INTO THIS OPENING WITH NON-SHRINK GROUT. THE EXTERIOR OF THIS COMPLETED CONNECTION SHALL BE SEALED WITH AN APPROVED BITUMINOUS COATING SUCH THAT THE CONNECTION WILL BE WATER TIGHT.

4. THE FLOORS OF ALL MANHOLES SHALL BE SHAPED WITH FLOW CHANNELS SUCH THAT THE MANHOLES WILL BE SELF CLEANING AND FREE OF AREAS WHERE SOLIDS COULD BE DEPOSITED AS SEWAGE FLOWS THROUGH THE MANHOLE FROM ALL INLET PIPES TO THE OUTLET PIPE. FLOW CHANNELS SHALL BE FORMED TO MATCH THE BOTTOM HALVES OF THE INFLOWING PIPES AND THE OUTFLOWING PIPE AS SHOWN BY THE DRAWINGS EXCEPT FOR INSIDE DROP MANHOLES. FLOW CHANNELS FOR INSIDE DROP MANHOLES SHALL BE CONSTRUCTED AS INDICATED BY THE DRAWING. MANHOLE FLOORS SHALL HAVE SLOPES OF 3 INCHES PER FOOT IN THE AREAS OUTSIDE OF THE FLOW CHANNELS SLOPED TOWARD THE FLOW CHANNELS. PIPES LAID THROUGH MANHOLE SHALL HAVE THE TOP HALF REMOVED TO WEAT LINES FOR THE FULL INSIDE DIAMETER OF THE MANHOLE. MANHOLE FLOORS SHALL THEN BE SHAPED AROUND THE BOTTOM HALF OF THE PIPE WHICH FORMS THE FLOW CHANNEL.

5. PIPES INSTALLED WITHIN THE EXCAVATION MADE FOR THE MANHOLE SHALL BE CRADLED WITH CONCRETE TO THE LIMITS OF THE MANHOLE EXCAVATION. WHEN CLAY PIPE IS USED, THE CRADLE SHALL EXTEND TO THE FIRST JOINT OUTSIDE THE MANHOLE. THE CRADLE SHALL BE TERMINATED AT THE CLAY PIPE JOINT IN A MANNER WHICH WILL MAINTAIN THE FLEXIBILITY OF THE JOINT. COST OF CRADLE WITHIN MANHOLE EXCAVATION OR TO CLAY PIPE JOINTS ADJACENT TO MANHOLE SHALL BE INCLUDED IN THE UNIT PRICE BID FOR THE MANHOLE.

6. MANHOLE COVER CASTINGS AND MANHOLE FRAME CASTINGS SHALL CONFORM TO THE REQUIREMENTS AS INDICATED IN THE STANDARD SPECIFICATIONS AND AS SHOWN IN THE STANDARD DETAIL DRAWING.

7. THE VERTICAL DROP IN INSIDE DROP MANHOLES SHALL NOT EXCEED 4' FOR INFLOWING PIPES SIZED 12" OR SMALLER AND 2' FOR INFLOWING PIPES LARGER THAN 12". THE CROWNS OF INFLOWING PIPES SHALL NEVER BE SET LOWER THAN THE CROWN OF THE OUTFLOWING PIPE.

8. STANDARD MANHOLES TYPE "C" AND STANDARD INSIDE DROP MANHOLES TYPE "C" SHALL BE BID AS STANDARD MANHOLES FOR THE TYPE AND DIAMETER INDICATED. OUTSIDE DROP MANHOLES TYPE "C" SHALL BE BID AS STANDARD OUTSIDE DROP MANHOLES FOR THE TYPE AND DIAMETER INDICATED. ALL MANHOLE DIAMETERS WILL BE 4' UNLESS INDICATED OTHERWISE.

JNL JAN. 1982


POE & ASSOCIATES OF KANSAS INC.
CONSULTING ENGINEERS
434 N. Oliver, Suite 110 ■ Wichita, KS 67208 ■ 316/685-4114

ENGINEER: K.H.	Sanitary Sewer System Extensions
ENG. TECH:	Manhole - Type "C"
DRAWN BY:	SOUTHBOROUGH ESTATES
DATE: APRIL 1990	PROJECT NUMBER
SHEET 8 OF 11	WC 1405-R2


8/11

FILMED FROM THE BEST AVAILABLE COPY


SEWER APPURTENANCES DETAILS

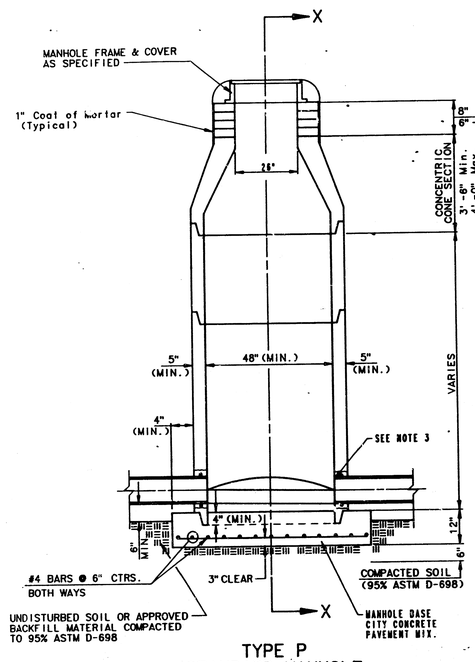


TYPE P
STANDARD MANHOLE

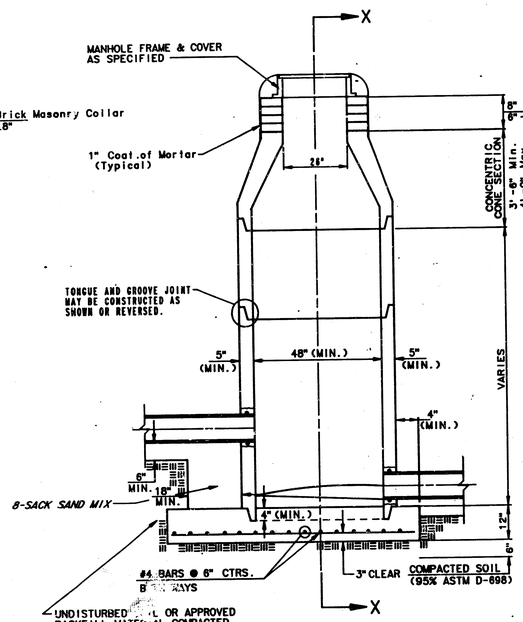

TYPE P
INSIDE DROP MANHOLE

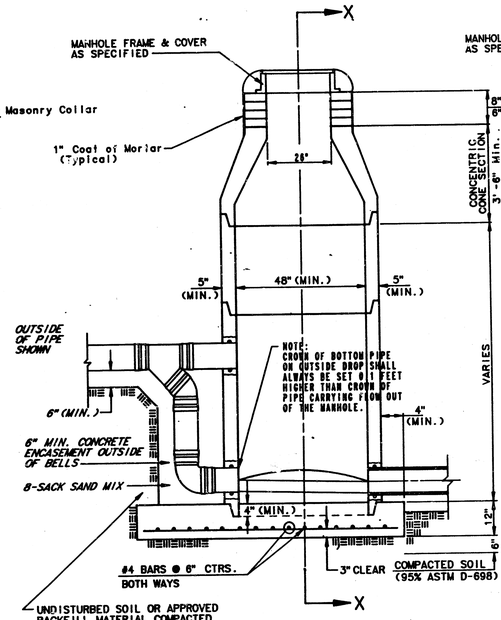

TYPE P
OUTSIDE DROP MANHOLE

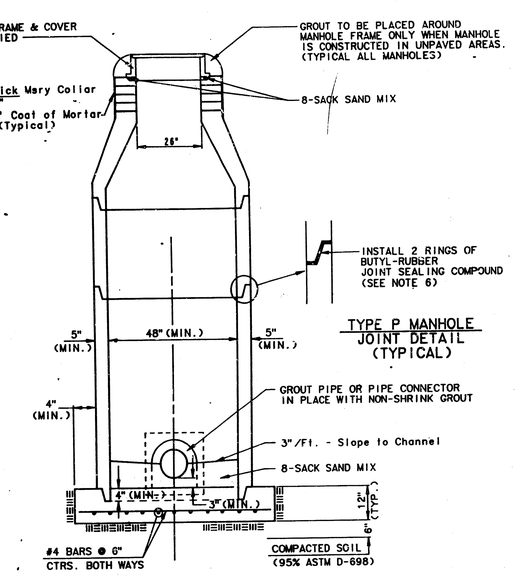

TYPE P MANHOLE
JOINT DETAIL
(TYPICAL)

SECTION X
(TYPICAL)

GENERAL NOTES

PRECAST MANHOLE NOTES

1. ALL PRECAST CONCRETE MANHOLE SECTIONS SHALL CONFORM TO THE LATEST REVISION OF A.S.T.M. C478 AS MODIFIED BY THE SPECIFICATIONS.
2. NON-SHRINK GROUT SHALL BE NON-METALLIC TYPE.
3. APPROVED FLEXIBLE WATERSTOP GASKETS SHALL BE INSTALLED TO JOIN THE SEWER TO THE MANHOLE WALL WHEN A.B.S. COMPOSITE PIPE OR P.V.C. PIPE IS USED. FOR OTHER TYPES OF PIPE THE SEWER SHALL BE GROUTED IN PLACE WITH NON-SHRINK GROUT. THE SEWER PIPE SHALL BE SUPPORTED WITH CONCRETE ENCASEMENT A MINIMUM OF 3 FEET FROM THE MANHOLE WALL AND TO THE FIRST JOINT FOR V.C.P. SUCH THAT THE JOINT REMAINS FLEXIBLE.
4. ALL INSIDE SURFACES OF THE CONCRETE MANHOLE WHICH WOULD BE EXPOSED TO SEWER GAS SHALL BE COATED WITH 2 COATS THEMEC SERIES 66 HI-BUILD EPOXOLINE, DRY THICKNESS OF 8 MILS (MIN.)
5. EXTERIOR MANHOLE WALLS SHALL BE COATED WITH 1 COAT MOBILARMA 633 BITUMINOUS COATING.
6. JOINT SEALING COMPOUND SHALL BE KENT SEAL NO. 2 OR APPROVED EQUAL.
7. PRECAST MANHOLES SHALL BE SET AT LEAST 4 INCHES INTO THE MANHOLE BASE.
8. TOP OF MANHOLE FLOOR SLAB SHALL BE AT LEAST 3 INCHES BELOW THE FLOW LINE OF THE OUTLET PIPE TO INSURE SUFFICIENT MINIMUM THICKNESS OF SHAPED INVERT.
9. LIFTING HOLES SHALL BE FILLED WITH NON-SHRINK GROUT AND THE INTERIOR SURFACE COATED AS SPECIFIED.
10. MORTAR USED IN MASONRY CONSTRUCTION SHALL CONTAIN 6 SACKS OF CEMENT PER CUBIC YARD. CONCRETE USED IN MANHOLE BASES SHALL CONFORM TO THE REQUIREMENTS OF CONCRETE FOR CONCRETE PAVEMENT CONSTRUCTION AS SPECIFIED IN THE CITY STANDARD PAVING SPECIFICATIONS USING CITY CONCRETE PAVEMENT MIX WITHOUT AIR ENTRAINING ADMIXTURE. MORTAR SHALL BE PLACED AROUND THE MANHOLE RING AS SHOWN ON THE DRAWINGS WHEN MANHOLES ARE CONSTRUCTED IN UNPAVED AREAS. MANHOLES CONSTRUCTED WHERE PIPE SIZES ARE SMALLER THAN 24" SHALL HAVE AN INSIDE DIAMETER OF 4'. MANHOLES CONSTRUCTED WHERE PIPE SIZES ARE 24" OR LARGER SHALL HAVE AN INSIDE DIAMETER OF 5'. COMPLETED MANHOLE SHALL BE WITHOUT LEAKS AND WATER TIGHT.
11. REINFORCING STEEL SHALL BE INSTALLED IN THE MANHOLE BASES AND SHALL CONSIST OF NO. 4 BARS PLACED ON 6" CENTERS IN BOTH DIRECTIONS. THE MANHOLE BASE REINFORCEMENT SHALL BE PLACED AT LEAST 3" ABOVE THE BOTTOM OF THE MANHOLE BASE. ALL COSTS FOR FURNISHING AND INSTALLING REINFORCING STEEL SHALL BE INCLUDED IN THE UNIT PRICE BID FOR THE MANHOLE.
12. OPENINGS SHALL BE CUT INTO THE MANHOLE WALL WHEN OUTSIDE DROPS ARE CONSTRUCTED ON EXISTING MANHOLES. SUCH OPENINGS CUT INTO EXISTING MANHOLES SHALL BE AS SMALL AS PRACTICAL TO FACILITATE INSTALLING AND GROUTING THE NEW PIPE IN PLACE. WATERSTOP GASKETS SHALL BE USED WITH P.V.C. AND A.B.S. COMPOSITE PIPE. THE NEW PIPE SHALL BE GROUTED INTO THE OPENING USING AN APPROVED NONSHRINK GROUT FOR THE FULL MANHOLE WALL THICKNESS. THE EXTERIOR OF THE COMPLETED CONNECTION SHALL BE SEALED WITH AN APPROVED BITUMINOUS COATING SUCH THAT THE CONNECTION WILL BE WATER TIGHT. FLOOR OF MANHOLE SHALL BE MODIFIED TO FORM NEW FLOW CHANNEL FOR THE NEW CONNECTION AS INDICATED BY THE DRAWING. THIS WORK, INCLUDING MODIFICATION OF MANHOLE FLOOR, SHALL BE PAID FOR AT THE UNIT PRICE BID FOR OUTSIDE DROP STACK CONSTRUCTED ON EXISTING MANHOLE.
13. THE FLOORS OF ALL MANHOLES SHALL BE SHAPED WITH FLOW CHANNELS SUCH THAT THE MANHOLES WILL BE SELF CLEANING AND FREE OF AREAS WHERE SOLIDS COULD BE DEPOSITED AS SEWAGE FLOWS THROUGH THE MANHOLE FROM ALL INLET PIPES TO THE OUTLET PIPE. FLOW CHANNELS SHALL BE FORMED TO MATCH THE BOTTOM HALVES OF THE INFLOWING PIPES AND THE OUTFLOWING PIPE AS SHOWN BY THE DRAWINGS EXCEPT FOR INSIDE DROP MANHOLES. FLOW CHANNELS FOR INSIDE DROP MANHOLES SHALL BE CONSTRUCTED AS INDICATED BY THE DRAWING. MANHOLE FLOORS SHALL HAVE SLOPES OF 3 INCHES PER FOOT IN THE AREAS OUTSIDE OF THE FLOW CHANNELS SLOPED TOWARD THE FLOW CHANNELS. PIPES LAID THROUGH MANHOLES SHALL HAVE THE TOP HALF REMOVED TO HEAT LINES FOR THE FULL INSIDE DIAMETER OF THE MANHOLE. MANHOLE FLOORS SHALL THEN BE SHAPED AROUND THE BOTTOM HALF OF THE PIPE WHICH FORMS THE FLOW CHANNEL.
14. PIPES INSTALLED WITHIN THE EXCAVATION MADE FOR THE MANHOLE SHALL BE CRADLED WITH CONCRETE TO THE LIMITS OF THE MANHOLE EXCAVATION. WHEN CLAY PIPE IS USED, THE CRADLE SHALL EXTEND TO THE FIRST JOINT OUTSIDE THE MANHOLE. THE CRADLE SHALL BE TERMINATED AT THE CLAY PIPE JOINT IN A MANNER WHICH WILL MAINTAIN THE FLEXIBILITY OF THE JOINT. COST OF CRADLE WITHIN MANHOLE EXCAVATION OR TO CLAY PIPE JOINTS ADJACENT TO MANHOLE SHALL BE INCLUDED IN THE UNIT PRICE BID FOR THE MANHOLE.
15. MANHOLE COVER CASTINGS AND MANHOLE FRAME CASTINGS SHALL CONFORM TO THE REQUIREMENTS AS INDICATED IN THE STANDARD SPECIFICATIONS AND AS SHOWN IN THE STANDARD DETAIL DRAWING.
16. THE VERTICAL DROP IN INSIDE DROP MANHOLES SHALL NOT EXCEED 4' FOR INFLOWING PIPES SIZED 12" OR SMALLER AND 2' FOR INFLOWING PIPES LARGER THAN 12". THE CROWNS OF INFLOWING PIPES SHALL NEVER BE SET LOWER THAN THE CROWN OF THE OUTFLOWING PIPE.
17. STANDARD MANHOLES AND STANDARD INSIDE DROP MANHOLES SHALL BE BID AS STANDARD MANHOLES FOR THE TYPE AND DIAMETER INDICATED. OUTSIDE DROP MANHOLES SHALL BE BID AS STANDARD OUTSIDE DROP MANHOLES FOR THE TYPE AND DIAMETER INDICATED. ALL MANHOLE DIAMETERS WILL BE 4' UNLESS INDICATED OTHERWISE.
18. A BRICK MASONRY COLLAR SHALL BE INSTALLED BETWEEN THE CAST IRON FRAME AND THE CONCENTRIC CONE. THE COLLAR WILL HAVE 8" WALLS AND A VERTICAL HEIGHT OF 6" MINIMUM AND 18" MAXIMUM. A 1" COAT OF MORTAR WILL BE PLASTERED ON THE OUTSIDE OF THE COLLAR.


POE & ASSOCIATES OF KANSAS INC.
CONSULTING ENGINEERS
434 N. Oliver, Suite 110 ■ Wichita, KS 67208 ■ 316/685-4114

ENGINEER: K.H.
ENG. TECH:
DRAWN BY:
DATE: APRIL 1990
SHEET: 9 of 11

Sanitary Sewer System Extensions
Manhole - Type "P"
SOUTHBOROUGH ESTATES
PROJECT NUMBER
WC 1405-R2

FILMED FROM THE BEST AVAILABLE COPY


SEWER APPURTENANCES DETAILS

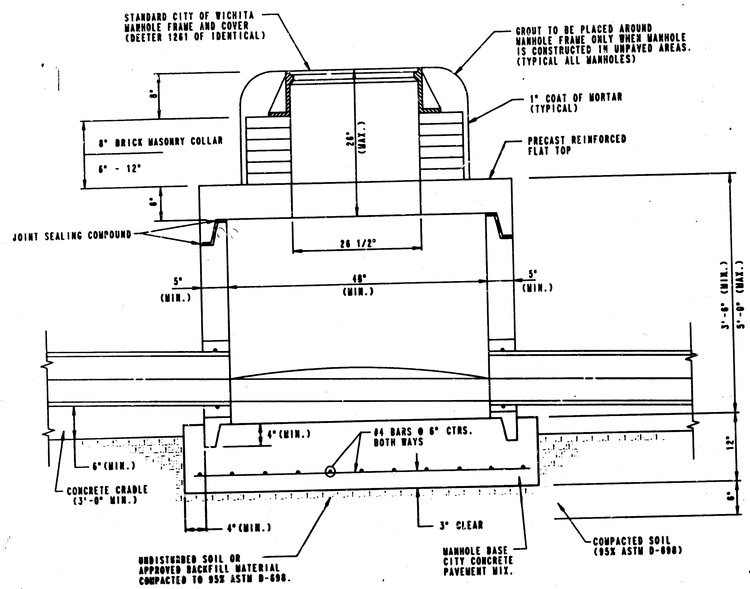

TYPE P
SHALLOW MANHOLE
(PRECAST)

PRECAST MANHOLE NOTES

1. ALL PRECAST CONCRETE MANHOLE SECTIONS SHALL CONFORM TO THE LATEST REVISION OF A.S.T.M. C478 AS MODIFIED BY THE SPECIFICATIONS.
2. APPROVED FLEXIBLE WATERSTOP GASKETS SHALL BE INSTALLED TO JOIN THE SEWER TO THE MANHOLE WALL WHEN PLASTIC PIPE IS USED. FOR OTHER TYPES OF PIPE THE SEWER SHALL BE GROUTED IN PLACE WITH NON-SHRINK GROUT.
3. NON-SHRINK GROUT SHALL BE NON-METALLIC TYPE.
4. PIPES INSTALLED WITHIN THE EXCAVATION MADE FOR THE MANHOLE SHALL BE CRADLED WITH CONCRETE TO THE LIMITS OF THE MANHOLE EXCAVATION (3" MIN.). WHEN CLAY PIPE IS USED, THE CRADLE SHALL EXTEND TO THE FIRST JOINT OUTSIDE THE MANHOLE (3" MIN.). THE CRADLE SHALL BE TERMINATED AT THE CLAY PIPE JOINT IN A MANNER WHICH WILL MAINTAIN THE FLEXIBILITY OF THE JOINT. COST OF CRADLE WITHIN MANHOLE EXCAVATION OR TO CLAY PIPE JOINTS ADJACENT TO MANHOLE SHALL BE INCLUDED IN THE UNIT PRICE BID FOR THE MANHOLE.
5. ALL INSIDE SURFACES OF THE CONCRETE MANHOLE WHICH WOULD BE EXPOSED TO SEWER GAS SHALL BE COATED WITH 2 COATS THEREO SERIES 66 HI-BUILD EPOXOLINE, DRY THICKNESS OF 8 MILS (MIN.).
6. EXTERIOR MANHOLE WALLS SHALL BE COATED WITH 1 COAT MOBILARMA 633 BITUMINOUS COATING.
7. JOINT SEALING COMPOUND SHALL BE KENT SEAL NO. 2 OR APPROVED EQUAL.
8. PRECAST MANHOLES SHALL BE SET AT LEAST 4 INCHES INTO THE MANHOLE BASE.
9. TOP OF MANHOLE FLOOR SLAB SHALL BE AT LEAST 3 INCHES BELOW THE FLOW LINE OF THE OUTLET PIPE TO INSURE SUFFICIENT MINIMUM THICKNESS OF SHAPED INVERT.
10. LIFTING HOLES SHALL BE FILLED WITH NON-SHRINK GROUT AND THE INTERIOR SURFACE COATED AS SPECIFIED.
11. MORTAR USED IN MASONRY CONSTRUCTION SHALL CONTAIN 8 SACKS OF CEMENT PER CUBIC YARD. CONCRETE USED IN MANHOLE BASES SHALL CONFORM TO THE REQUIREMENTS OF CONCRETE FOR CONCRETE PAVEMENT CONSTRUCTION AS SPECIFIED IN THE CITY STANDARD PAVING SPECIFICATIONS USING CITY CONCRETE PAVEMENT MIX WITHOUT AIR ENTRAINING ADMIXTURE. MORTAR SHALL BE PLACED AROUND THE MANHOLE RING AS SHOWN ON THE DRAWINGS WHEN MANHOLES ARE CONSTRUCTED IN UNPAVED AREAS. MANHOLES CONSTRUCTED WHERE PIPE SIZES ARE SMALLER THAN 24" SHALL HAVE AN INSIDE DIAMETER OF 4'. MANHOLES CONSTRUCTED WHERE PIPE SIZES ARE 24" OR LARGER SHALL HAVE AN INSIDE DIAMETER OF 5'. COMPLETED MANHOLE SHALL BE WITHOUT LEAKS AND WATER TIGHT.
12. REINFORCING STEEL SHALL BE INSTALLED IN THE MANHOLE BASES AND SHALL CONSIST OF NO. 4 BARS PLACED ON 6" CENTERS IN BOTH DIRECTIONS. THE MANHOLE BASE REINFORCEMENT SHALL BE PLACED AT LEAST 3" ABOVE THE BOTTOM OF THE MANHOLE BASE. ALL COSTS FOR FURNISHING AND INSTALLING REINFORCING STEEL SHALL BE INCLUDED IN THE UNIT PRICE BID FOR THE MANHOLE.
13. THE FLOORS OF ALL MANHOLES SHALL BE SHAPED WITH FLOW CHANNELS SUCH THAT THE MANHOLES WILL BE SELF CLEARING AND FREE OF AREAS WHERE SOLIDS COULD BE REPOSITED AS SEWAGE FLOWS THROUGH THE MANHOLE FROM ALL INLET PIPES TO THE OUTLET PIPE. FLOW CHANNELS SHALL BE FORMED TO MATCH THE BOTTOM HALVES OF THE INFLOWING PIPES AND THE OUTFLOWING PIPE AS SHOWN BY THE DRAWINGS. MANHOLE FLOORS SHALL HAVE SLOPES OF 3 INCHES PER FOOT IN THE AREAS OUTSIDE OF THE FLOW CHANNELS SLOPED TOWARD THE FLOW CHANNELS. PIPES LAID THROUGH MANHOLES SHALL HAVE THE TOP HALF REMOVED TO NEAT LINES FOR THE FULL INSIDE DIAMETER OF THE MANHOLE. MANHOLE FLOORS SHALL THEN BE SHAPED AROUND THE BOTTOM HALF OF THE PIPE WHICH FORMS THE FLOW CHANNEL.
14. MANHOLE COVER CASTINGS AND MANHOLE FRAME CASTINGS SHALL CONFORM TO THE REQUIREMENTS AS INDICATED IN THE STANDARD SPECIFICATIONS AND AS SHOWN IN THE STANDARD DETAIL DRAWING.
15. THE CROWNS OF INFLOWING PIPES SHALL NEVER BE SET LOWER THAN THE CROWN OF THE OUTFLOWING PIPE.
16. A BRICK MASONRY COLLAR SHALL BE INSTALLED BETWEEN THE CAST IRON FRAME AND THE PRECAST REINFORCED FLAT TOP. THE COLLAR WILL HAVE 8" WALLS AND A VERTICAL HEIGHT OF 6" MINIMUM AND 18" MAXIMUM. A 1" COAT OF MORTAR WILL BE PLASTERED ON THE OUTSIDE OF THE COLLAR.
17. SHALLOW MANHOLES TYPE "P" SHALL BE BID AS SHALLOW MANHOLES FOR THE TYPE AND DIAMETER INDICATED. ALL MANHOLE DIAMETERS WILL BE 4' UNLESS INDICATED OTHERWISE.

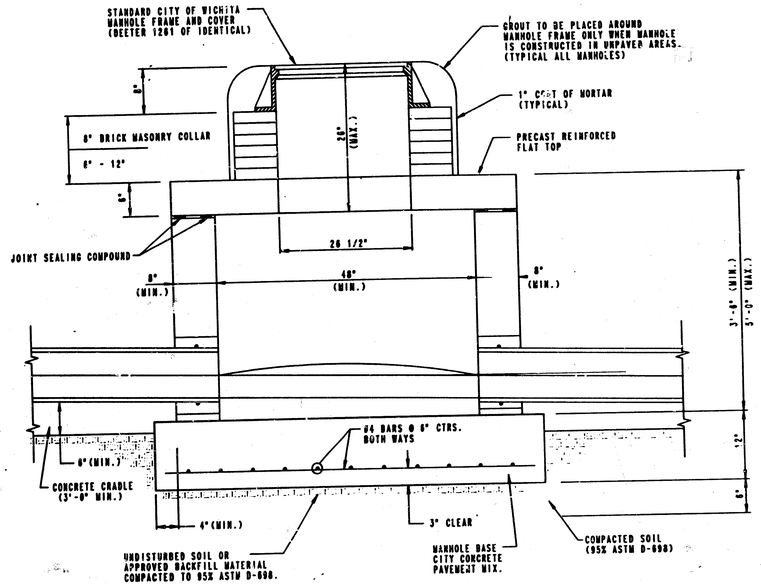

TYPE C
SHALLOW MANHOLE
(CAST-IN-PLACE)

CAST-IN-PLACE MANHOLE NOTES

1. APPROVED FLEXIBLE WATERSTOP GASKETS SHALL BE INSTALLED TO JOIN THE SEWER TO THE MANHOLE WALL WHEN PLASTIC PIPE IS USED. FOR OTHER TYPES OF PIPE THE SEWER SHALL BE GROUTED IN PLACE WITH NON-SHRINK GROUT.
2. NON-SHRINK GROUT SHALL BE NON-METALLIC TYPE.
3. PIPES INSTALLED WITHIN THE EXCAVATION MADE FOR THE MANHOLE SHALL BE CRADLED WITH CONCRETE TO THE LIMITS OF THE MANHOLE EXCAVATION (3" MIN.). WHEN CLAY PIPE IS USED, THE CRADLE SHALL EXTEND TO THE FIRST JOINT OUTSIDE THE MANHOLE (3" MIN.). THE CRADLE SHALL BE TERMINATED AT THE CLAY PIPE JOINT IN A MANNER WHICH WILL MAINTAIN THE FLEXIBILITY OF THE JOINT. COST OF CRADLE WITHIN MANHOLE EXCAVATION OR TO CLAY PIPE JOINTS ADJACENT TO MANHOLE SHALL BE INCLUDED IN THE UNIT PRICE BID FOR THE MANHOLE.
4. JOINT SEALING COMPOUND SHALL BE KENT SEAL NO. 2 OR APPROVED EQUAL.
5. TOP OF MANHOLE FLOOR SLAB SHALL BE AT LEAST 3 INCHES BELOW THE FLOW LINE OF THE OUTLET PIPE TO INSURE SUFFICIENT MINIMUM THICKNESS OF SHAPED INVERT.
6. MORTAR USED IN MASONRY CONSTRUCTION SHALL CONTAIN 8 SACKS OF CEMENT PER CUBIC YARD. CONCRETE USED IN MANHOLE WALLS AND BASES SHALL CONFORM TO THE REQUIREMENTS OF CONCRETE FOR CONCRETE PAVEMENT CONSTRUCTION AS SPECIFIED IN THE CITY STANDARD PAVING SPECIFICATIONS USING CITY CONCRETE PAVEMENT MIX WITHOUT AIR ENTRAINING ADMIXTURE. MORTAR SHALL BE PLACED AROUND THE MANHOLE RING AS SHOWN ON THE DRAWINGS WHEN MANHOLES ARE CONSTRUCTED IN UNPAVED AREAS. TYPE "C" MANHOLES CAN BE CONSTRUCTED ONLY WHERE PIPE SIZES ARE 8" OR SMALLER. THE INSIDE DIAMETER OF TYPE "C" MANHOLES SHALL BE 4'. COMPLETED MANHOLE SHALL BE WITHOUT LEAKS AND WATER TIGHT.
7. REINFORCING STEEL SHALL BE INSTALLED IN THE MANHOLE BASE. REINFORCING STEEL SHALL CONSIST OF No. 4 BARS PLACED ON 6" CENTERS IN BOTH DIRECTIONS. REINFORCING STEEL SHALL BE PLACED AT LEAST 3" ABOVE THE BOTTOM OF THE MANHOLE BASE. COST OF FURNISHING AND INSTALLING REINFORCING STEEL SHALL BE INCLUDED IN THE UNIT PRICE BID FOR THE MANHOLE.
8. THE FLOORS OF ALL MANHOLES SHALL BE SHAPED WITH FLOW CHANNELS SUCH THAT THE MANHOLES WILL BE SELF CLEANING AND FREE OF AREAS WHERE SOLIDS COULD BE DEPOSITED AS SEWAGE FLOWS THROUGH THE MANHOLE FROM ALL INLET PIPES TO THE OUTLET PIPE. FLOW CHANNELS SHALL BE FORMED TO MATCH THE BOTTOM HALVES OF THE INFLOWING PIPES AND THE OUTFLOWING PIPE AS SHOWN BY THE DRAWINGS. MANHOLE FLOORS SHALL HAVE SLOPES OF 3 INCHES PER FOOT IN THE AREAS OUTSIDE OF THE FLOW CHANNELS SLOPED TOWARD THE FLOW CHANNELS. PIPES LAID THROUGH MANHOLE SHALL HAVE THE TOP HALF REMOVED TO NEAT LINES FOR THE FULL INSIDE DIAMETER OF THE MANHOLE. MANHOLE FLOORS SHALL THEN BE SHAPED AROUND THE BOTTOM HALF OF THE PIPE WHICH FORMS THE FLOW CHANNEL.
9. MANHOLE COVER CASTINGS AND MANHOLE FRAME CASTINGS SHALL CONFORM TO THE REQUIREMENTS AS INDICATED IN THE STANDARD SPECIFICATIONS AND AS SHOWN IN THE STANDARD DETAIL DRAWING.
10. THE CROWNS OF INFLOWING PIPES SHALL NEVER BE SET LOWER THAN THE CROWN OF THE OUTFLOWING PIPE.
11. A BRICK MASONRY COLLAR SHALL BE INSTALLED BETWEEN THE CAST IRON FRAME AND THE PRECAST REINFORCED FLAT TOP. THE COLLAR WILL HAVE 8" WALLS AND A VERTICAL HEIGHT OF 6" MINIMUM AND 18" MAXIMUM. A 1" COAT OF MORTAR WILL BE PLASTERED ON THE OUTSIDE OF THE COLLAR.
12. SHALLOW MANHOLES TYPE "C" SHALL BE BID AS SHALLOW MANHOLES FOR THE TYPE AND DIAMETER INDICATED. ALL MANHOLE DIAMETERS WILL BE 4' UNLESS INDICATED OTHERWISE.

POE & ASSOCIATES OF KANSAS INC.
CONSULTING ENGINEERS
434 N. Oliver, Suite 110 ■ Wichita, KS 67208 ■ 316/685-4114

ENGINEER: K.H.
ENG. TECH:
DRAWN BY:
DATE: APRIL 1990
SHEET: 10 OF 11

Sanitary Sewer System Extensions


SHALLOW MANHOLE TYPE P&C
SOUTHBOROUGH ESTATES

PROJECT NUMBER
WC 1405-R2

FILMED FROM THE BEST AVAILABLE COPY


REVISED APRIL, 1980
REVISED SEPT. 1989

VERTICAL RISER DETAIL

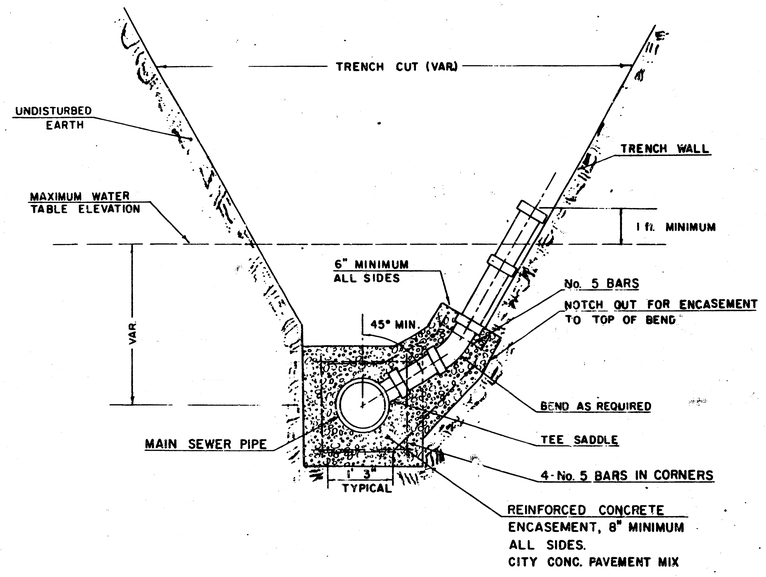


TYPICAL RISER FOR SLOPING TRENCH WALLS

NOTE:
TOP OF 4" OR 6" RISER PIPE TO BE EXTENDED TO AN ELEVATION OF 1 ft. MINIMUM ABOVE THE WATER TABLE ELEVATION, WHEN WATER EXISTS, OR TO AN ELEVATION SUITABLE FOR PROVIDING SERVICE TO THE LOT TO BE SERVED AND THEN PLUGGED.

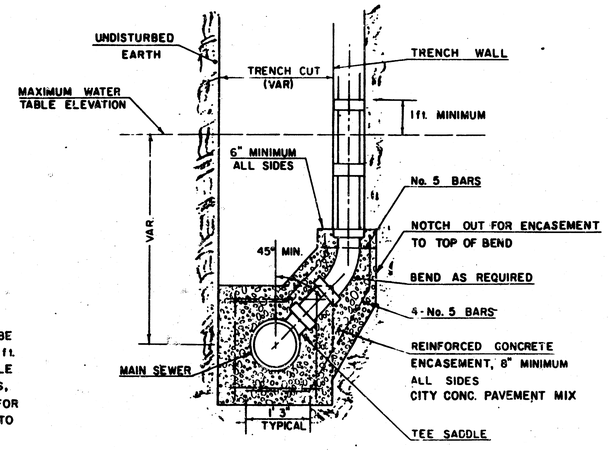

TYPICAL RISER FOR VERTICAL TRENCH WALLS

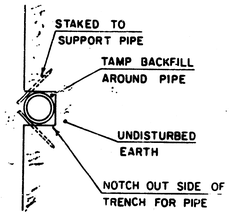

GENERAL NOTE

RISERS SHALL BE INSTALLED TO SERVE ALL LOTS OR TRACTS WHEN THE MAIN SEWER LINE IS BELOW THE WATER TABLE. RISERS SHALL ALSO BE INSTALLED TO SERVE ALL LOTS AND TRACTS WHEN THE MAIN SEWER LINE DEPTH IS SUCH THAT WOULD MAKE THE BUILDING SEWER LINE CONNECTION DIFFICULT. INSTALLATION OF RISERS BECAUSE OF MAIN LINE SEWER DEPTH SHALL BE AS APPROVED BY THE ENGINEER. THE LOCATION OF RISERS TO SERVE DEVELOPED PROPERTY SHALL BE APPROVED BY THE PROPERTY OWNER. PIPE STUBS SHALL BE INSTALLED IN MANHOLES WHERE LOCATIONS OF MANHOLES WILL PROVIDE SATISFACTORY SERVICE CONNECTIONS AS DETERMINED BY THE FIELD ENGINEER. THE VERTICAL DISTANCE BETWEEN THE FLOW LINE OF THE MANHOLE PIPE STUB AND THE FLOW LINE OF THE MAIN SEWER LINE SHALL NOT EXCEED 1 FT. MANHOLE PIPE STUBS SHALL NOT BE SET BELOW AN ELEVATION WHICH WILL PERMIT THE TOP OF THE INSIDE OF THE STUB TO MATCH THE TOP OF THE INSIDE OF THE MAIN SEWER PIPE. PIPE STUBS AND RISERS INSTALLED TO SERVE COMMERCIAL OR INDUSTRIAL PROPERTY SHALL BE 6 INCH. PIPE STUBS AND RISERS INSTALLED TO SERVE RESIDENTIAL PROPERTY MAY BE EITHER 6 INCH OR 4 INCH DEPENDING UPON THE AVAILABLE GRADE AND THE SIZE OF THE LOT AS DETERMINED BY THE FIELD ENGINEER. ENCASEMENT OF VITRIFIED CLAY MAIN SEWER PIPE SHALL EXTEND TO THE FIRST JOINT IN THE MAIN SEWER CLAY PIPE ON EACH SIDE OF THE RISER INSTALLATION. ENCASEMENT OF A.B.S. COMPOSITE OR P.V.C. MAIN SEWER PIPE SHALL EXTEND A MINIMUM OF 3 FT. ON BOTH SIDES OF THE CENTERLINE OF THE RISER. FOUR INCH AND SIX INCH RISER PIPE SHALL BE ENCASED WITH CONCRETE TO THE TOP OF THE BEND AS INDICATED IN THE DRAWINGS. FOUR INCH AND SIX INCH CLAY PIPE USED FOR RISERS SHALL BE EXTRA STRENGTH PIPE CONFORMING TO THE REQUIREMENTS OF THE LATEST REVISION OF A.S.T.M. DESIGNATION C700 WITH COMPRESSION JOINTS AS SPECIFIED FOR CLAY PIPE IN THE STANDARD SPECIFICATIONS. FOUR INCH AND SIX INCH A.B.S. OR P.V.C. PIPE SHALL BE PIPE APPROVED FOR USE IN THE CITY BY THE CHIEF PLUMBING AND MECHANICAL INSPECTOR FOR THE CENTRAL INSPECTION DIVISION OF THE DEPARTMENT OF HOUSING AND ECONOMIC DEVELOPMENT. LOCATIONS OF THE ENDS OF THE RISERS SHALL BE MARKED BY FASTENING GREEN COLORED PLASTIC TAPE TO THE END OF THE RISER WHICH SHALL BE EXTENDED TO THE GROUND SURFACE AS THE EXCAVATION IS BACKFILLED SUCH THAT THE COLORED TAPE WILL BE VISIBLE WHEN THE PROJECT IS COMPLETED. SUCH GREEN PLASTIC TAPE SHALL BE 4 MIL POLYETHYLENE FILM WITH A MINIMUM WIDTH OF 3" SPECIALLY MANUFACTURED FOR THE PURPOSE OF IDENTIFICATION OF UNDERGROUND SEWERS. THE ENDS OF THE RISER PIPE AND MANHOLE STUBS SHALL BE CAPPED OR PLUGGED USING FITTINGS FURNISHED BY THE MANUFACTURER OF THE PIPE. CONTRACTOR'S METHODS FOR SUPPORTING AND BACKFILLING RISER PIPE SHALL BE APPROVED BY THE ENGINEER.

FURNISHING AND INSTALLING RISERS SHALL BE PAID FOR AT THE UNIT PRICES BID FOR 4" PIPE, 6" PIPE AND REINFORCED CONCRETE ENCASEMENT FOR THE VARIOUS MAIN SEWER PIPE SIZES INDICATED; WHICH PRICE SHALL INCLUDE ALL COSTS FOR COMPLETION OF THIS ITEM INCLUDING SADDLES, BENDS, CONCRETE, REINFORCING STEEL, CAPS OR PLUGS, AND ALL OTHER NECESSARY MATERIALS OR WORK. CONCRETE ENCASEMENT OF THE RISER PIPE TO THE TOP OF THE BEND AS SHOWN BY THE DRAWINGS WILL NOT BE PAID FOR DIRECTLY AND THE COST FOR THIS WORK SHALL BE CONSIDERED AS SUBSIDIARY TO THE OTHER ITEMS OF WORK.

THE PROJECT INSPECTOR SHALL REPORT ON INSPECTOR CARDS THE LOCATION OF ALL RISERS CONSTRUCTED AS MEASURED FROM THE NEAREST MANHOLE, THE DIRECTION OF SERVICE, THE ELEVATION OF THE TOP OF THE RISER, AND THE PAY QUANTITIES INVOLVED. THE PROJECT INSPECTOR SHALL ALSO REPORT ON INSPECTOR CARDS THE LOCATION, DIRECTION OF SERVICE, AND SIZE OF ALL STUBS INSTALLED IN MANHOLES.

POE & ASSOCIATES OF KANSAS INC.
CONSULTING ENGINEERS
434 N. Oliver, Suite 110 ■ Wichita, KS 67208 ■ 316/685-4114

ENGINEER: K.H.	Sanitary Sewer System Extensions
ENG. TECH:	VERTICAL RISER DETAIL
DRAWN BY:	SOUTHBOROUGH ESTATES
DATE: APRIL 1990	PROJECT NUMBER
SHEET: 11 OF 11	WC 1405-R2

FILMED FROM THE BEST AVAILABLE COPY