


NOTE: CONTRACTOR SHALL USE EXCESS EXCAVATED MATERIAL TO MAINTAIN A MINIMUM COVER OF 30" OVER THE TOP OF THE SANITARY SEWER PIPE. CONTRACTOR WILL BE REQUIRED TO MAKE ARRANGEMENTS WITH BUSINESS ON SAUDER ADDITION SUCH THAT WILL PERMIT CONSTRUCTION OF THIS SEWER WITHOUT ADVERSELY AFFECTING VEHICULAR ACCESS TO THIS PROPERTY.

B.M. 113.096 City Std. Disc. #3 West of & West St. + 3.4' North of & Irving.
B.M. 113.62 "a" cut E-End Return, N-side McCormick on Dr to T & F. Shacks Across from E-End Return McCormick & Kessler.

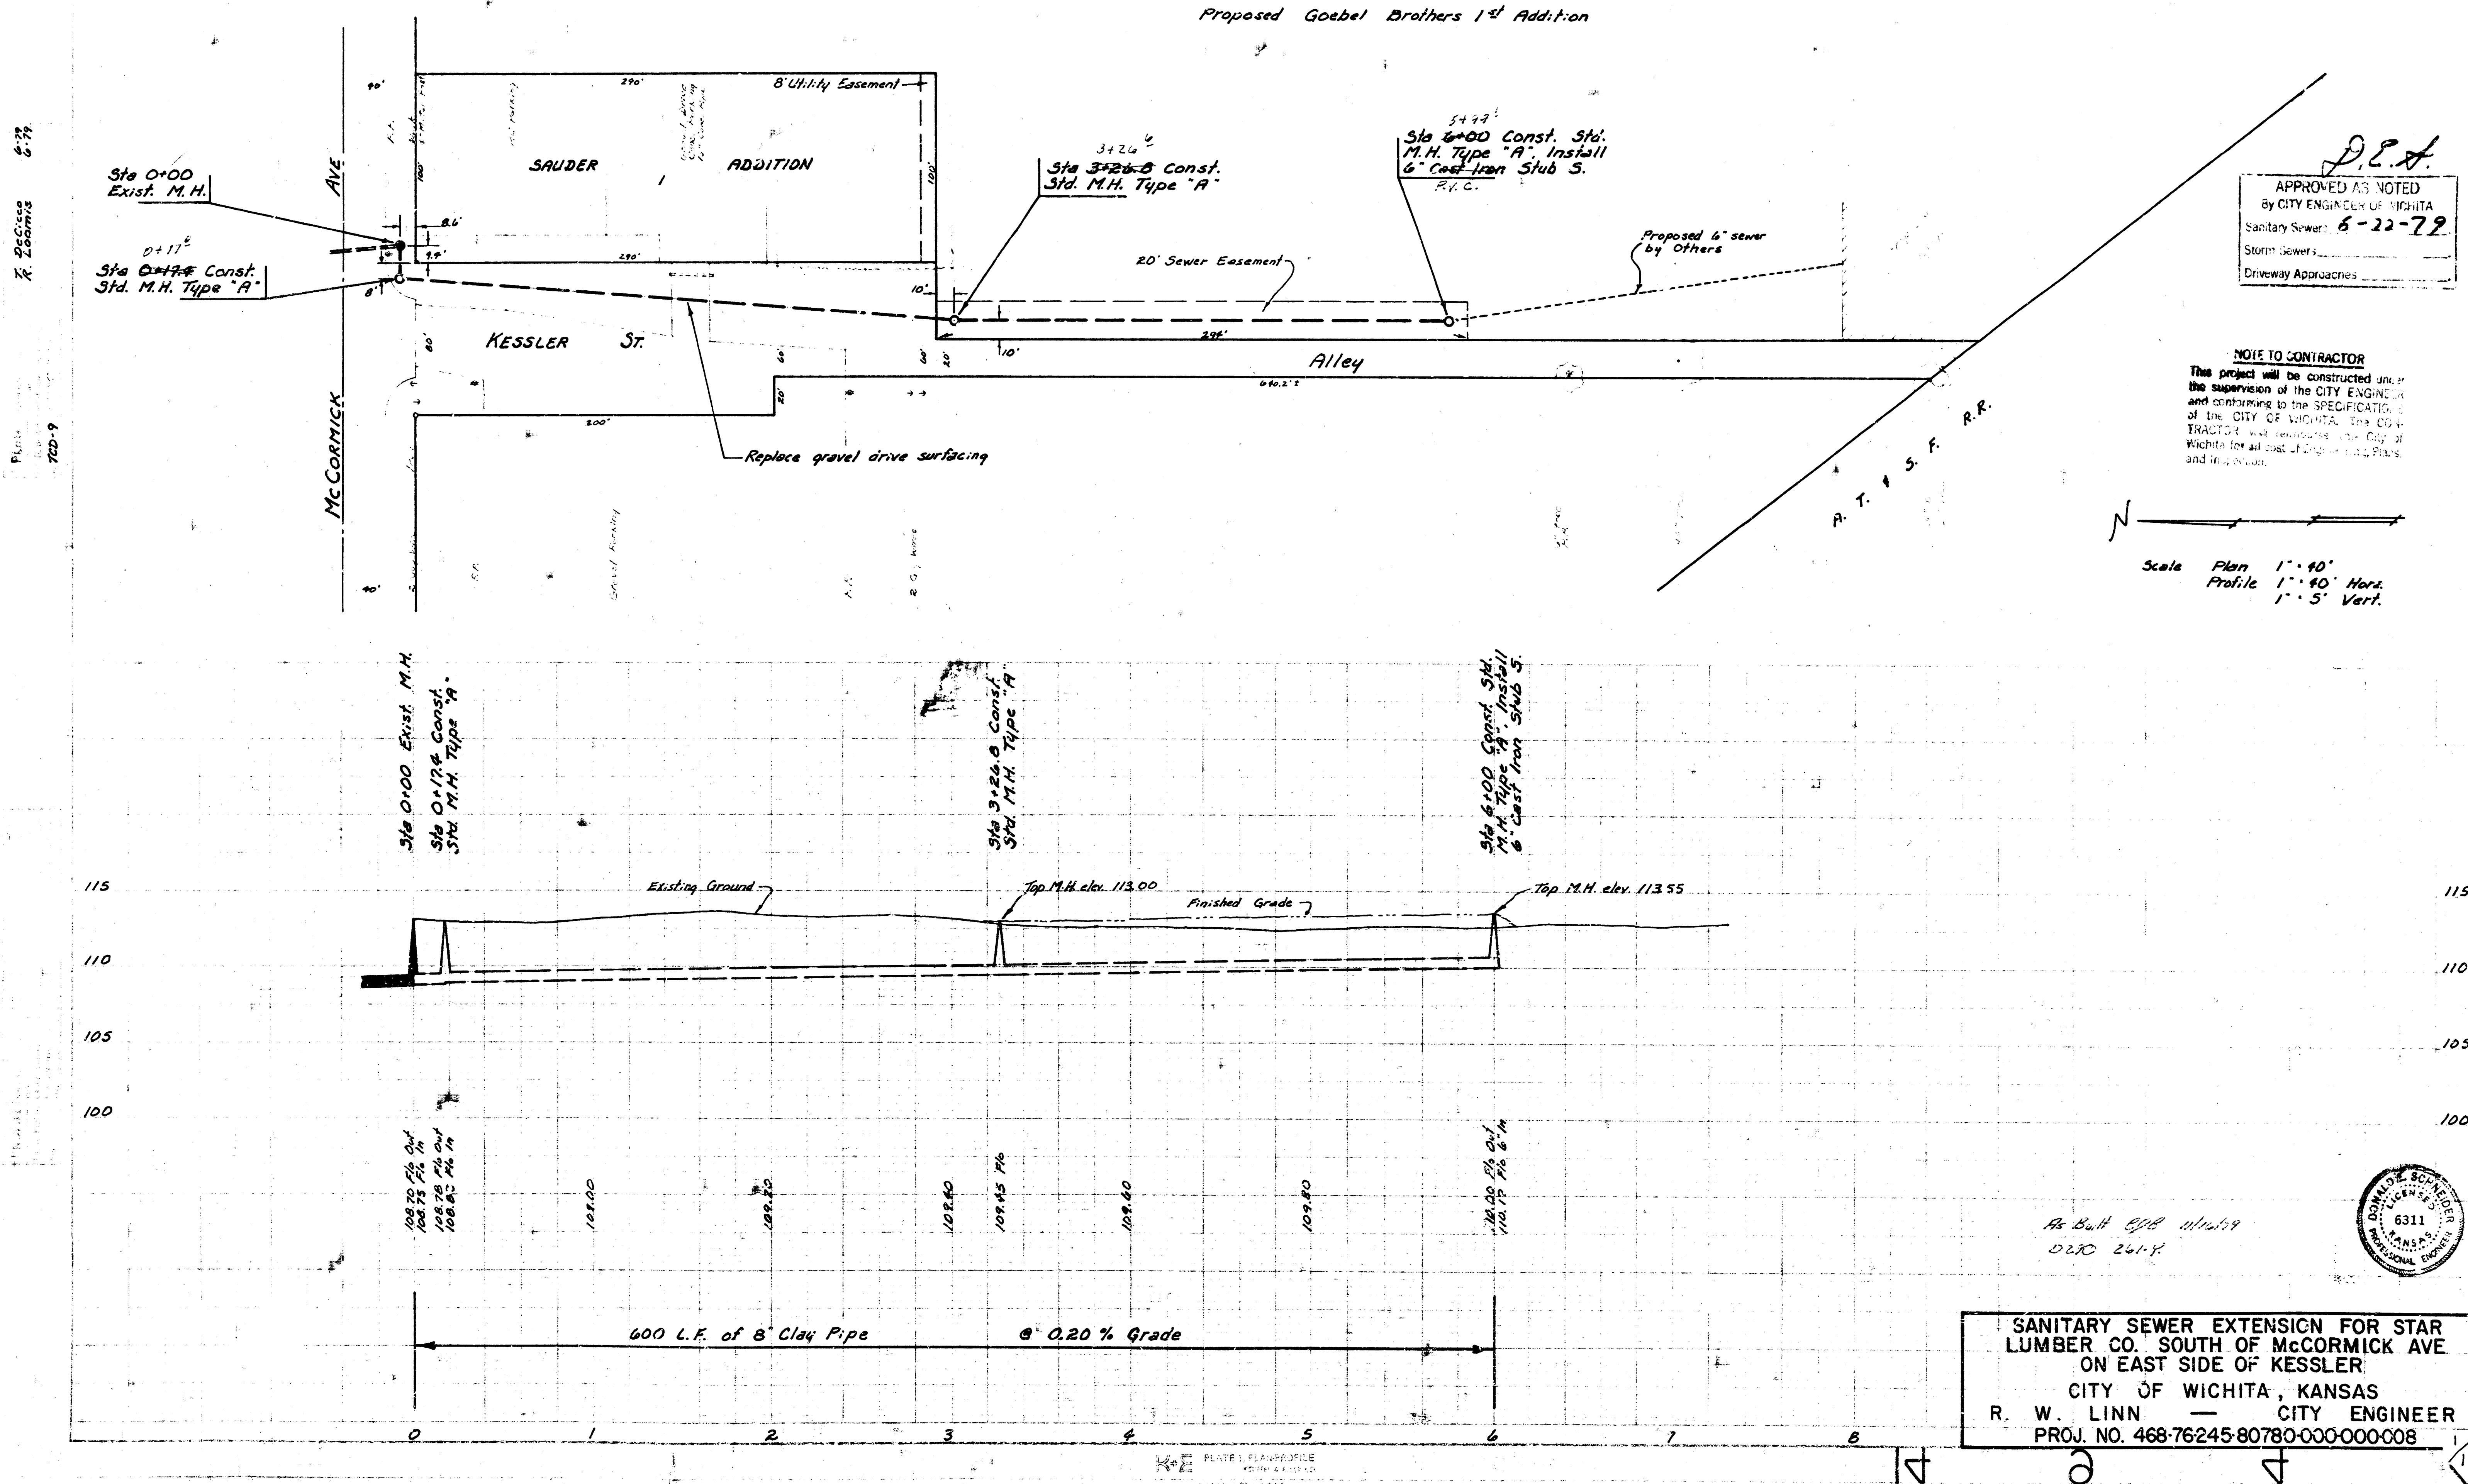

FILMED FROM THE BEST AVAILABLE COPY