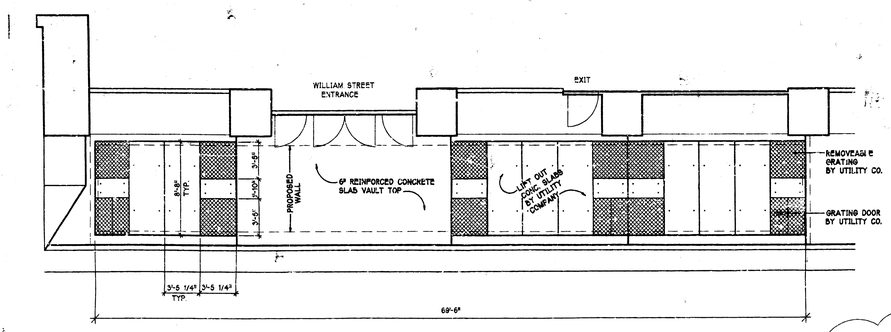

ENLARGED PLAN VIEW
ELECTRICAL VAULT SCALE: 1"=5'-0"

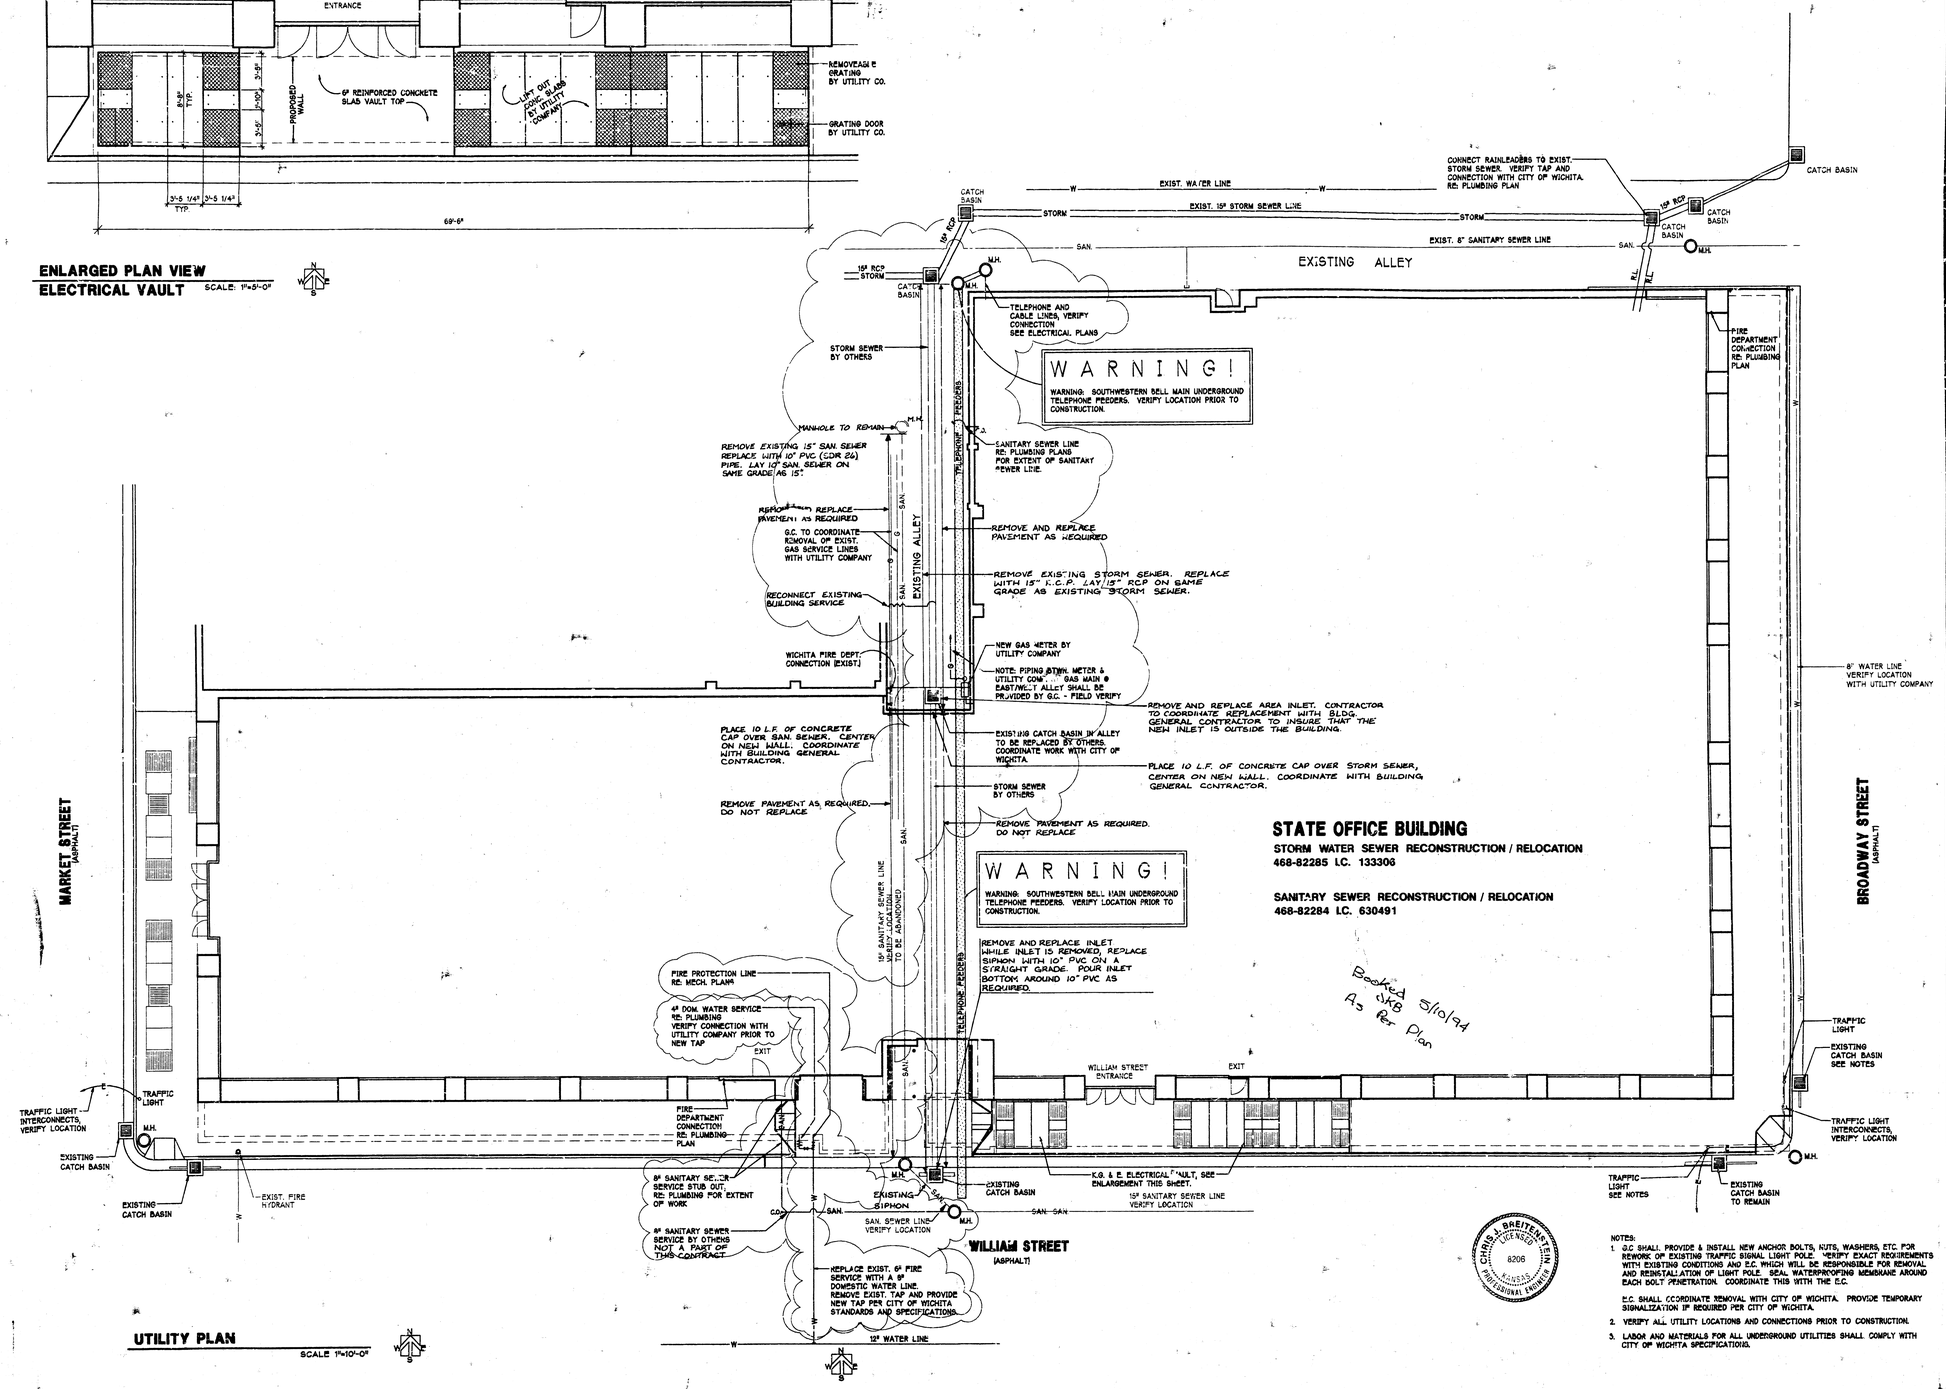

UTILITY PLAN SCALE 1"=10'-0"

CHRIS J. BREITENSTEIN LICENSED 8206 KANSAS PROFESSIONAL ENGINEER

NOTES:
1. G.C SHALL PROVIDE & INSTALL NEW ANCHOR BOLTS, NUTS, WASHERS, ETC. FOR REWORK OF EXISTING TRAFFIC SIGNAL LIGHT POLE. VERIFY EXACT REQUIREMENTS WITH EXISTING CONDITIONS AND E.C. WHICH WILL BE RESPONSIBLE FOR REMOVAL AND REINSTALLATION OF LIGHT POLE. SEAL WATERPROOFING MEMBRANE AROUND EACH BOLT PENETRATION. COORDINATE THIS WITH THE E.C.

   E.C. SHALL COORDINATE REMOVAL WITH CITY OF WICHITA. PROVIDE TEMPORARY SIGNALIZATION IF REQUIRED PER CITY OF WICHITA.
2. VERIFY ALL UTILITY LOCATIONS AND CONNECTIONS PRIOR TO CONSTRUCTION.
3. LABOR AND MATERIALS FOR ALL UNDERGROUND UTILITIES SHALL COMPLY WITH CITY OF WICHITA SPECIFICATIONS.

OBLINGER MASON McCLUGGAGE & VAN SICKLE CORPORATION
Architects Planners Landscape Architects
P.O. Box 9848
Wichita, Kansas 67201
824 N. Main
Wichita, Kansas 67203
(316) 262-0451
(316) 262-5485 FAX

STATE OFFICE BUILDING
(former Dillard's Building)
WICHITA, KANSAS

PROJECT NO.
DATE:
REVISED:
DRAWN:
CHECKED:

SHEET
SP-2
OF SHEETS

FILMED FROM THE BEST AVAILABLE COPY.