


Sta 3470.3 Const. Special Inlet. See Detail Rt-Plug Ex. 6" C.I.P. in Ex. Inlet. Fill Inlet with Sand & 4" Conc. Cap.

Riser pipe and cover to be set 1ft. ± above finished grade to prevent entrance of storm water.

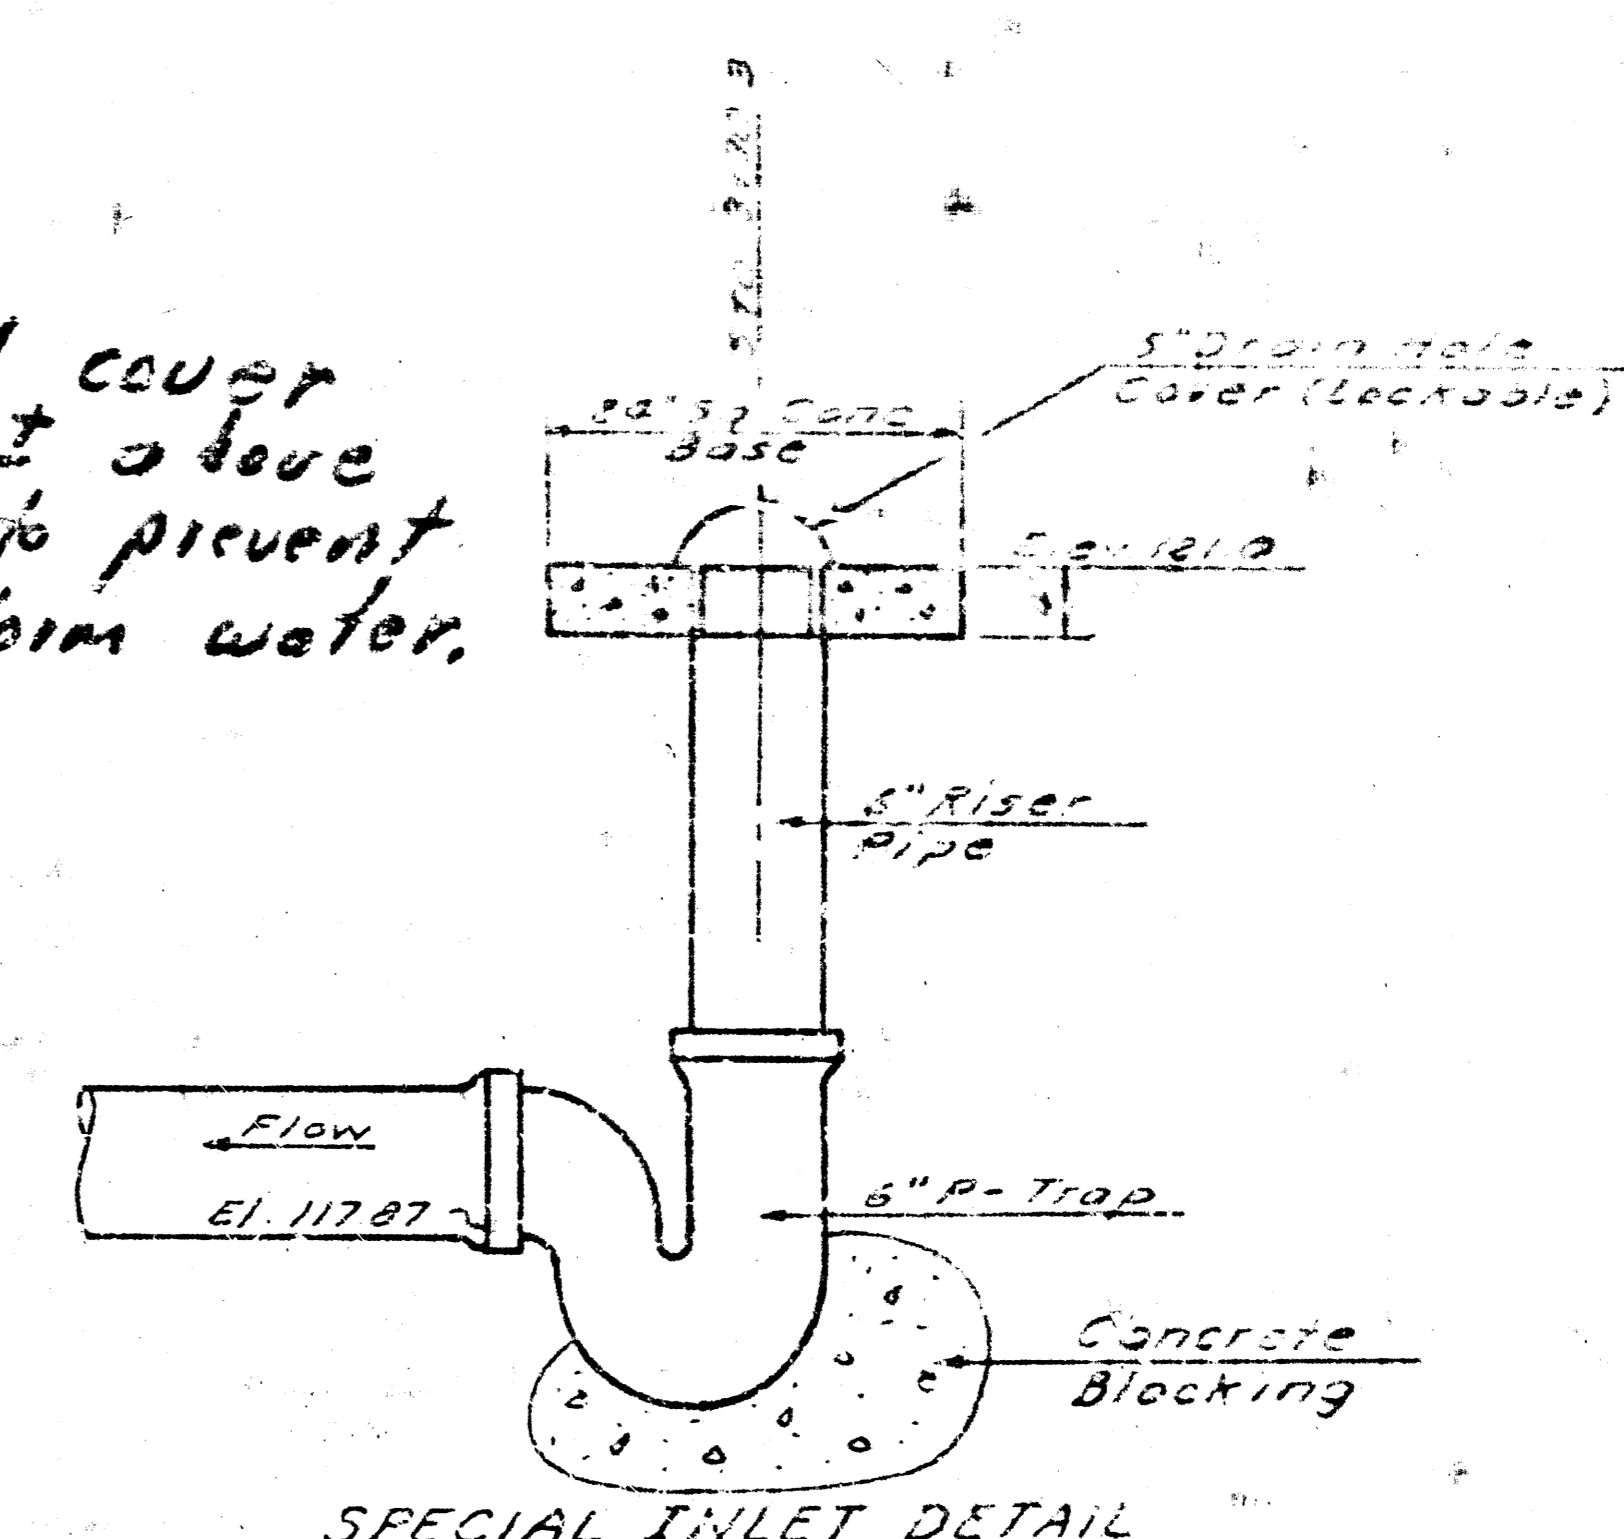

NOTE TO CONTRACTOR
 This project will be constructed under the supervision of the CITY ENGINEER and conforming to the SPECIFICATIONS of the CITY OF WICHITA. The CONTRACTOR will reimburse the City of Wichita for all cost of engineering, plans, and inspection.

5-24-77
 APPROVED AS NOTED
 by CITY ENGINEER OF WICHITA
 S. E. S.
 Sanitary Sewers _____
 Storm Sewers _____
 Driveway Approaches _____



SAN SEWER 707024