


Note: Install stubs south & southwest out of new man hole.

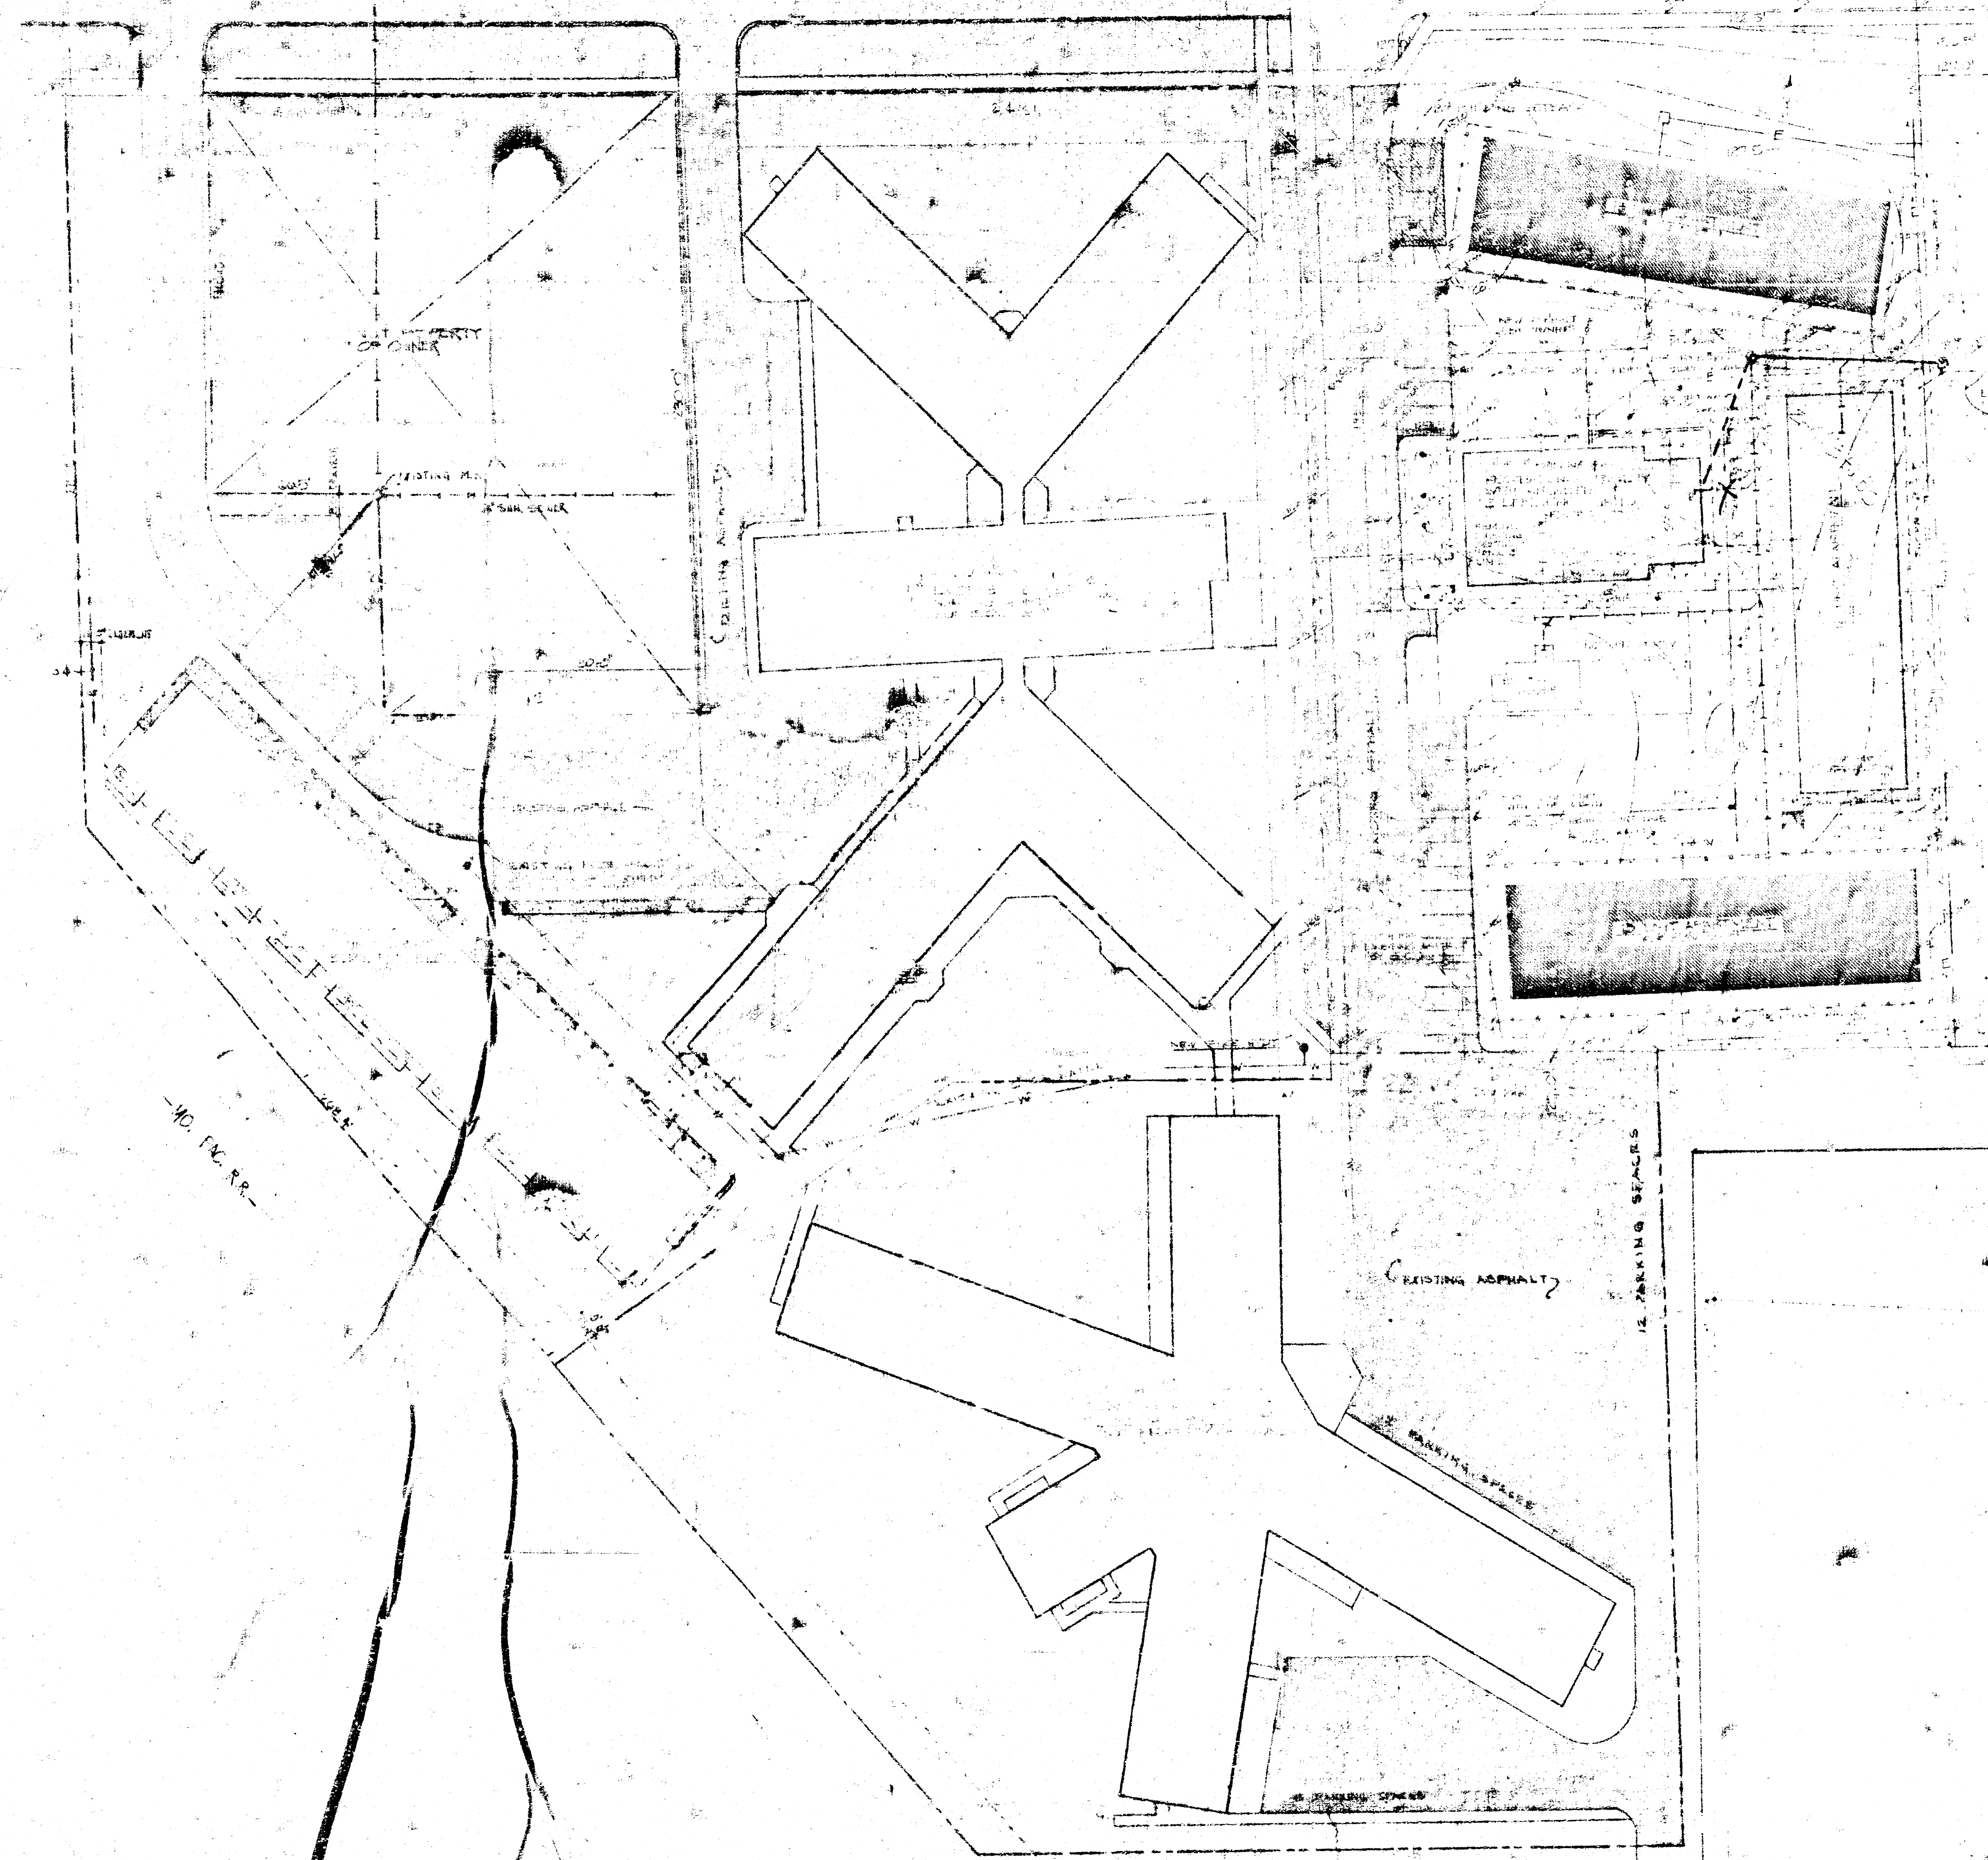

MATERIALS SYMBOLS

- CONCRETE
- BRICK
- ROUGH WORK
- FINISHED WORK
- PAVING
- GRAVEL
- INSULATION
- PIPE, JOINT, FITTING

PLAT PLAN SYMBOLS

- SEWER
- GAS
- WATER
- PROPERTY LINE
- FINISH CONTOUR
- EXISTING CONTOUR
- EXISTING GRIDES
- FINISH GRADE
- SEWER MANHOLE
- VALLEY DESIGN OF RETENTION

10-22-74
 APPROVED AS NOTED
 By CITY ENGINEER OF WICHITA
 Sanitary Sewers *J. D. S.*
 Storm Sewers
 Driveway Approaches

NOTE TO CONTRACTOR
 The project will be constructed under the supervision of the CITY ENGINEER and conforming to the SPECIFICATIONS of the CITY OF WICHITA. The CONTRACTOR will reimburse the City of Wichita for all cost of Engineering, Plans, and Inspection.



PLOT PLAN

- GENERAL NOTES:
- 1. ALL DIMENSIONS ARE BY CONTRACTOR UNLESS SPECIFICALLY CALLED OUT OTHERWISE.
 - 2. ALL DIMENSIONS ARE TO FACE UNLESS OTHERWISE NOTED.

Proj. No. DBKW 704060