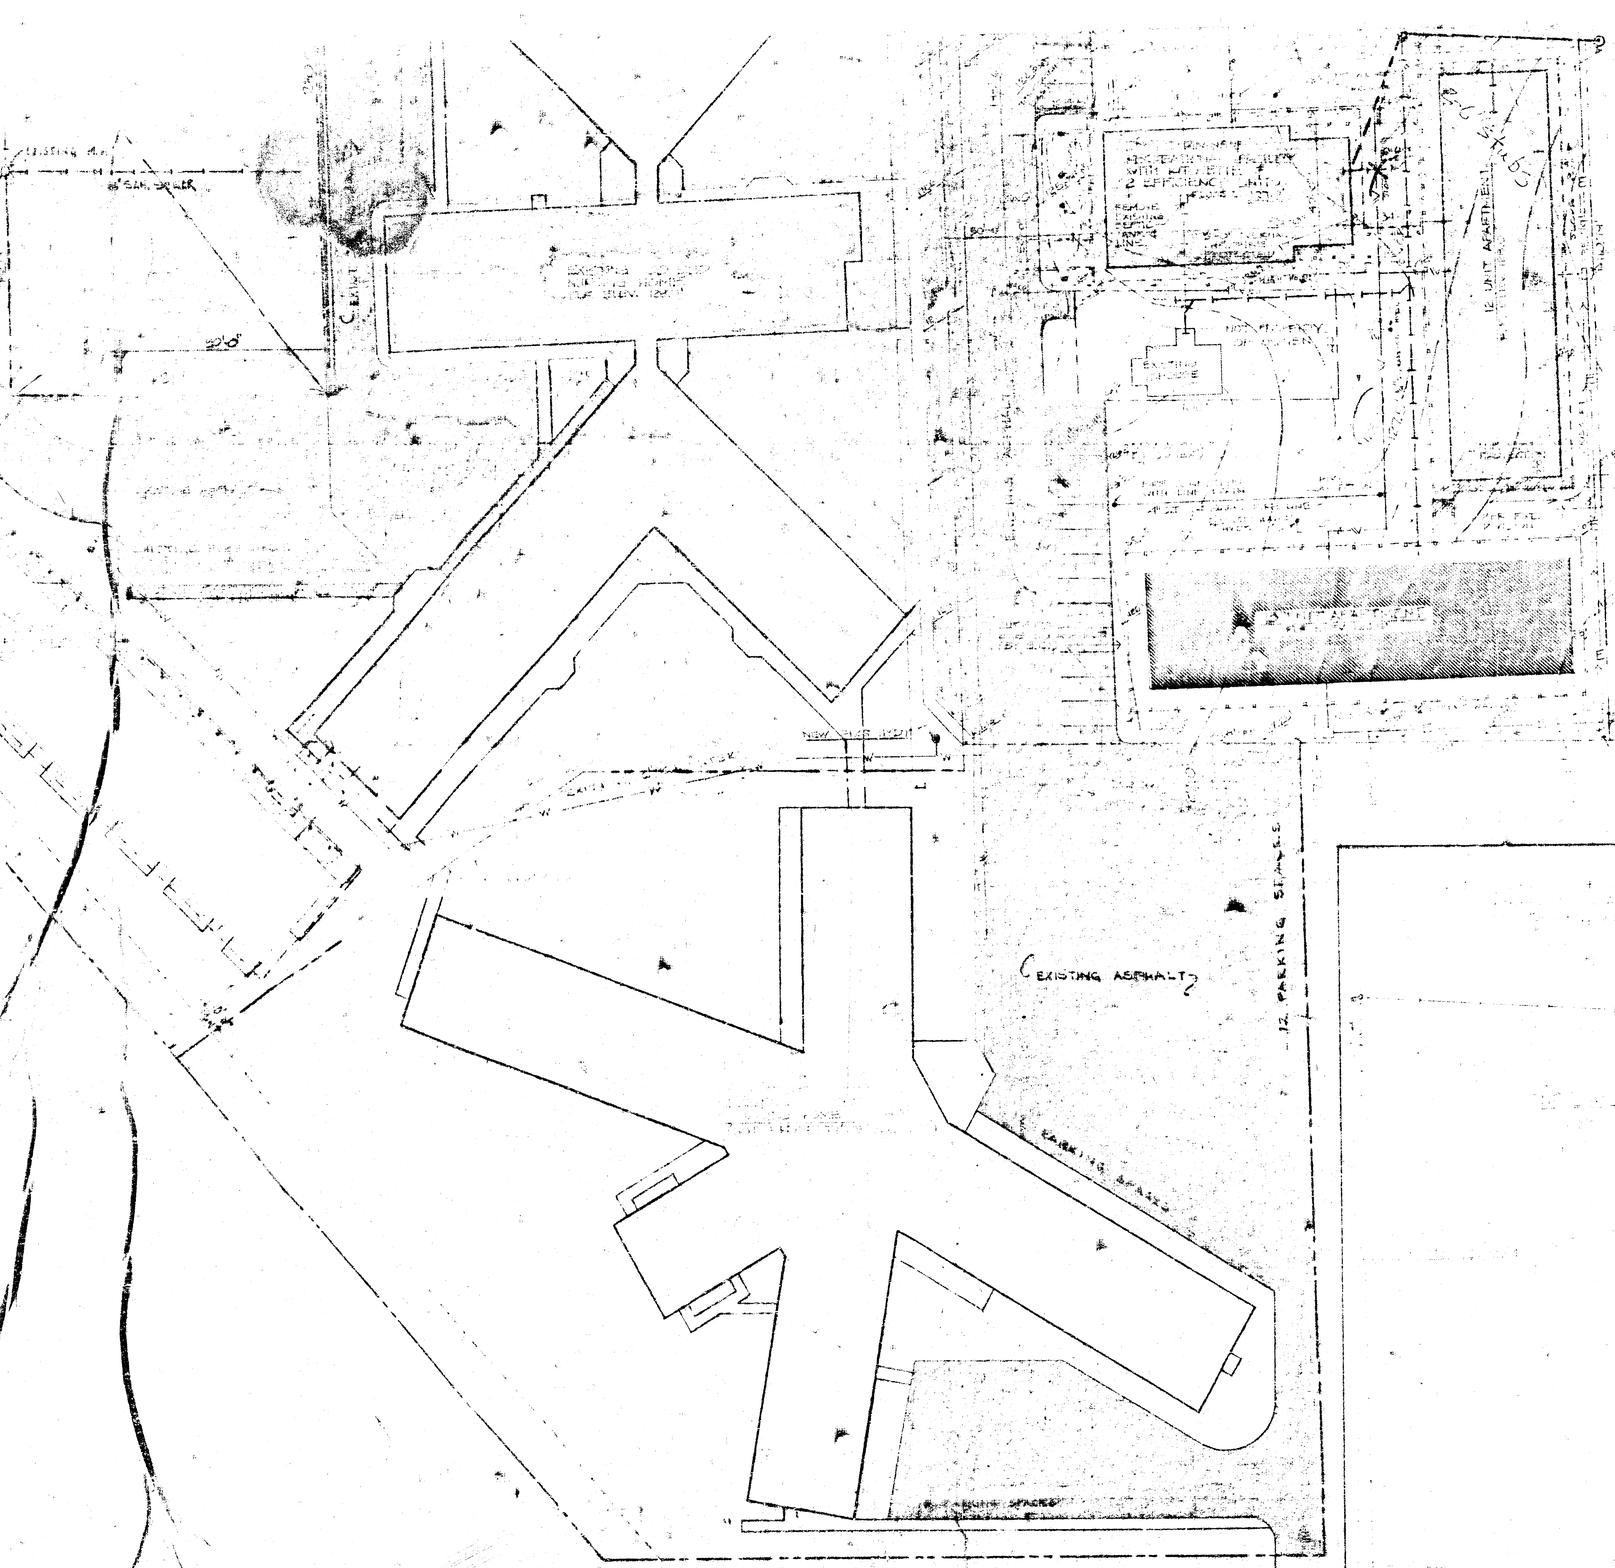

PLOT PLAN 1" = 30'-0"

LOT 1 SPORTSMEN'S THIRD ADDITION

GENERAL NOTES

- [illegible] BY CONTRACTOR UNLESS SPECIFICALLY CALLED [illegible]
- [illegible] EXPANSION JOINT WHERE SIDEWALKS AND PORCHES [illegible] SURFACES
- [illegible] TO [illegible] UNIFORM SCALE FROM BUILDING AND/OR CONFORM TO REVISIONS [illegible] NOTED SHOWN. CUT JOINTS AT 5'-0" O.C. [illegible] AT 30'-0" O.C.
- [illegible] PAINT 10'-0" AWAY FROM BUILDING. NO [illegible] SLOPE MORE THAN ONE FT. RISE IN FOUR FT. DISTANCE.
- ALL COMPACTED FILL 95% PROCTOR TO EXTEND 6'-0" BEYOND BUILDING, DRIVES, AND PARKING. ALL LOADS BEARING TO SOIL 1,750 LBS./ SQ. FT. MAX.
- ALL EARTHWORK BY GENERAL CONTRACTOR TO COMPACTED ELEVATIONS REQUIRED UP TO LIMIT OF GRADING LINE
- ALL CONTRACTORS TO VERIFY ALL DIMENSIONS AND CONDITIONS, INCLUDING ALL UTILITIES, PRIOR TO STARTING EACH PHASE OF WORK

PLOT PLAN SYMBOLS

- SEWER
- GAS
- WATER
- PROPERTY LINE
- FINISH CONTOURS
- EXISTING CONTOURS
- EXISTING GRADES
- FINISH GRADE
- [illegible]
- VALVE - DIRECTION OF INCREASE

10-22-74

APPROVED AS NOTED
By CITY ENGINEER OF WICHITA
Sanitary Sewers 8" D.E.S.
Storm Sewers
Driveway Approaches

NOTE TO CONTRACTOR

This project will be constructed under the supervision of the CITY ENGINEER and conforming to the SPECIFICATIONS of the CITY OF WICHITA. The CONTRACTOR will reimburse the City of Wichita for all cost of Engineering, Plans, and Inspection.

R. L. HOLLIS
LICENSED
550
KANSAS
PROFESSIONAL ENGINEER

FIRE PROTECTION REVISION — 7/12/74