



PLAN	DATE	BY	CHECKED	DATE	BY
1	8-28-80	J.E.B.			

PROFILE	DATE	BY	CHECKED	DATE	BY
1	8-28-80	J.E.B.			

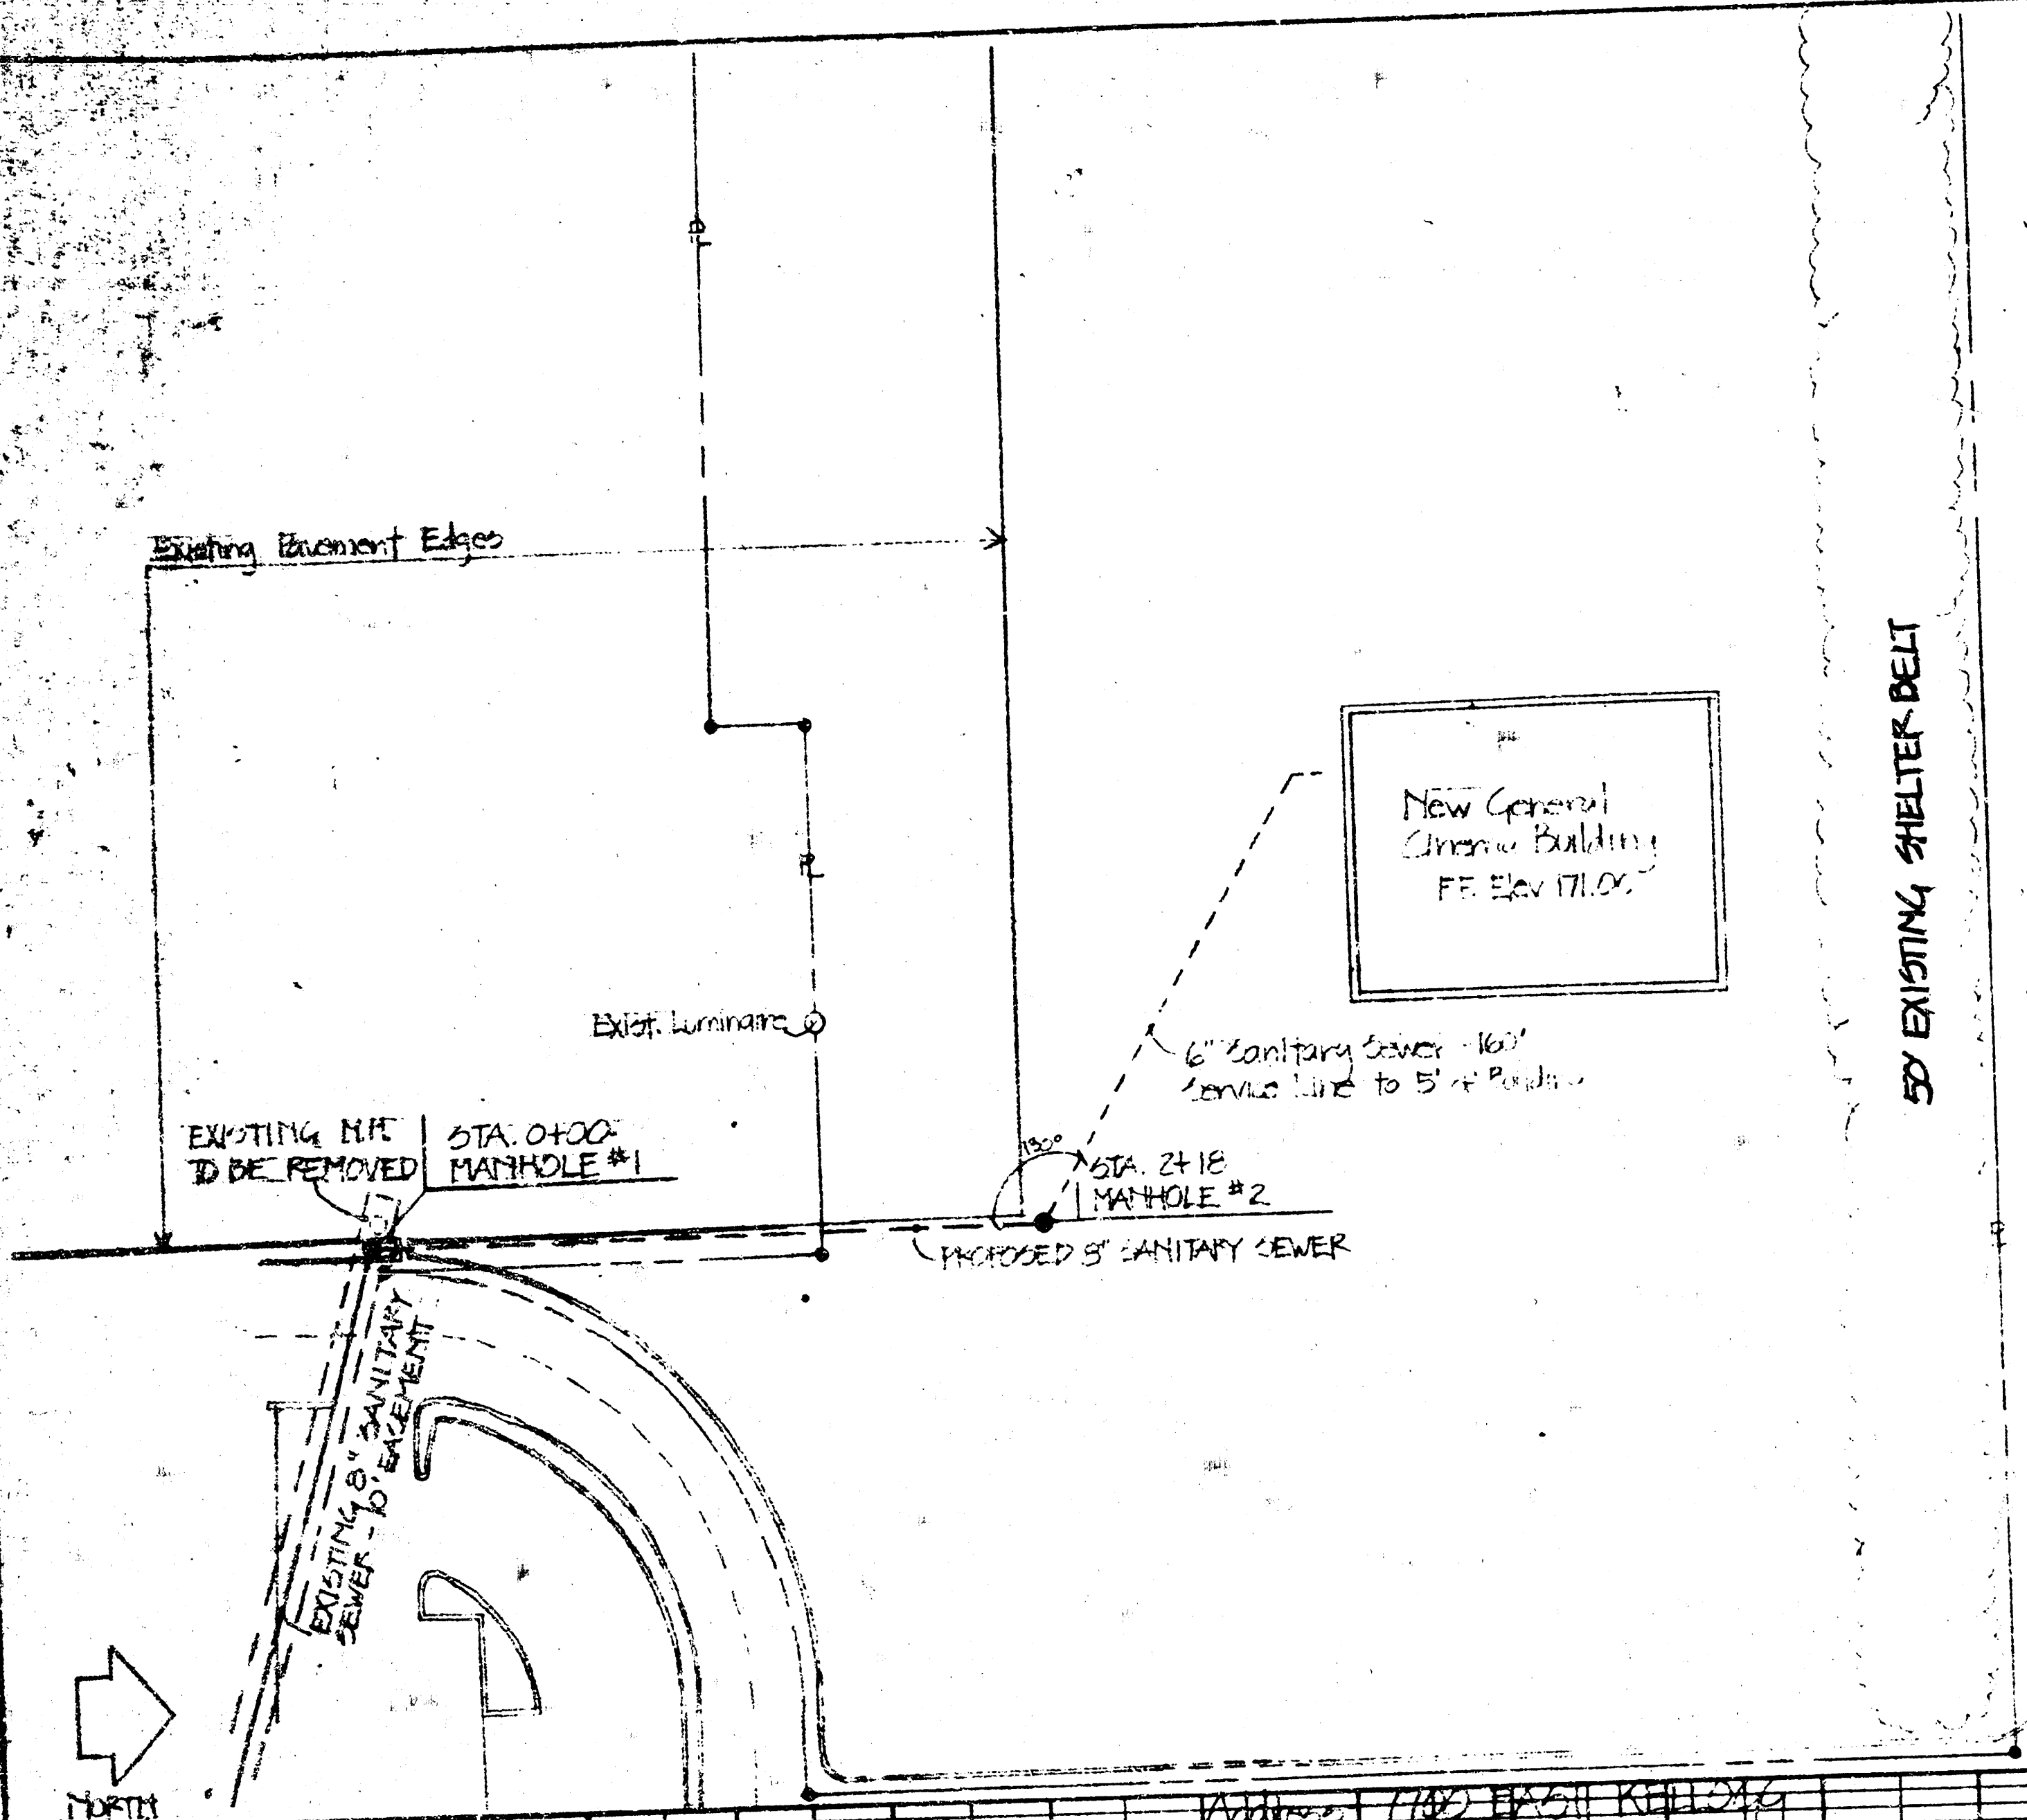

NOTE TO CONTRACTOR
 This project will be constructed under the supervision of the CITY ENGINEER and conforming to the SPECIFICATIONS of the CITY OF WICHITA. The CONTRACTOR will reimburse the City of Wichita for all cost of ~~the project~~ ^{inspection}.

8-28-80
APPROVED AS NOTED
 By CITY ENGINEER OF WICHITA
 Sanitary Sewers *J.E.B.*
 Storm Sewers
 Driveway Approaches

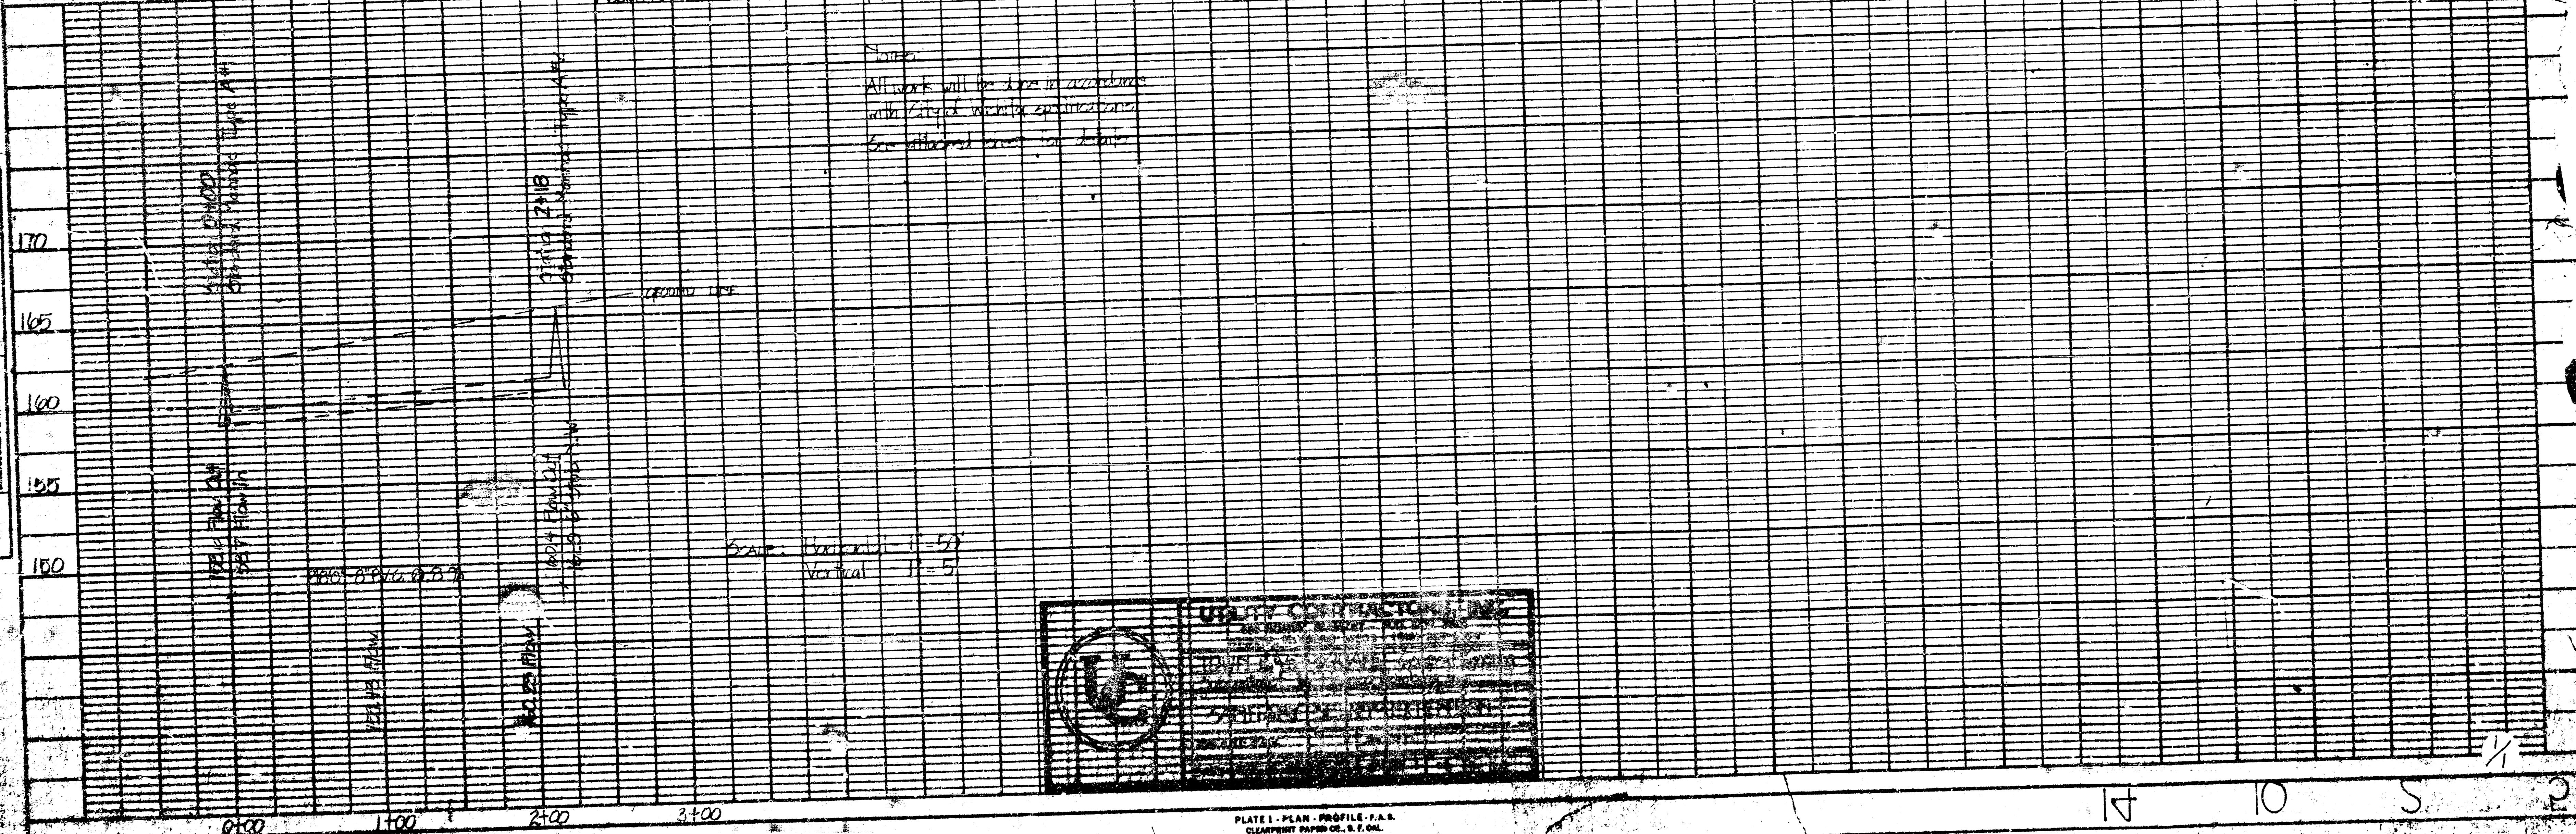

Notes:
 All work will be done in accordance with City of Wichita specifications. See attached sheet for details.

