



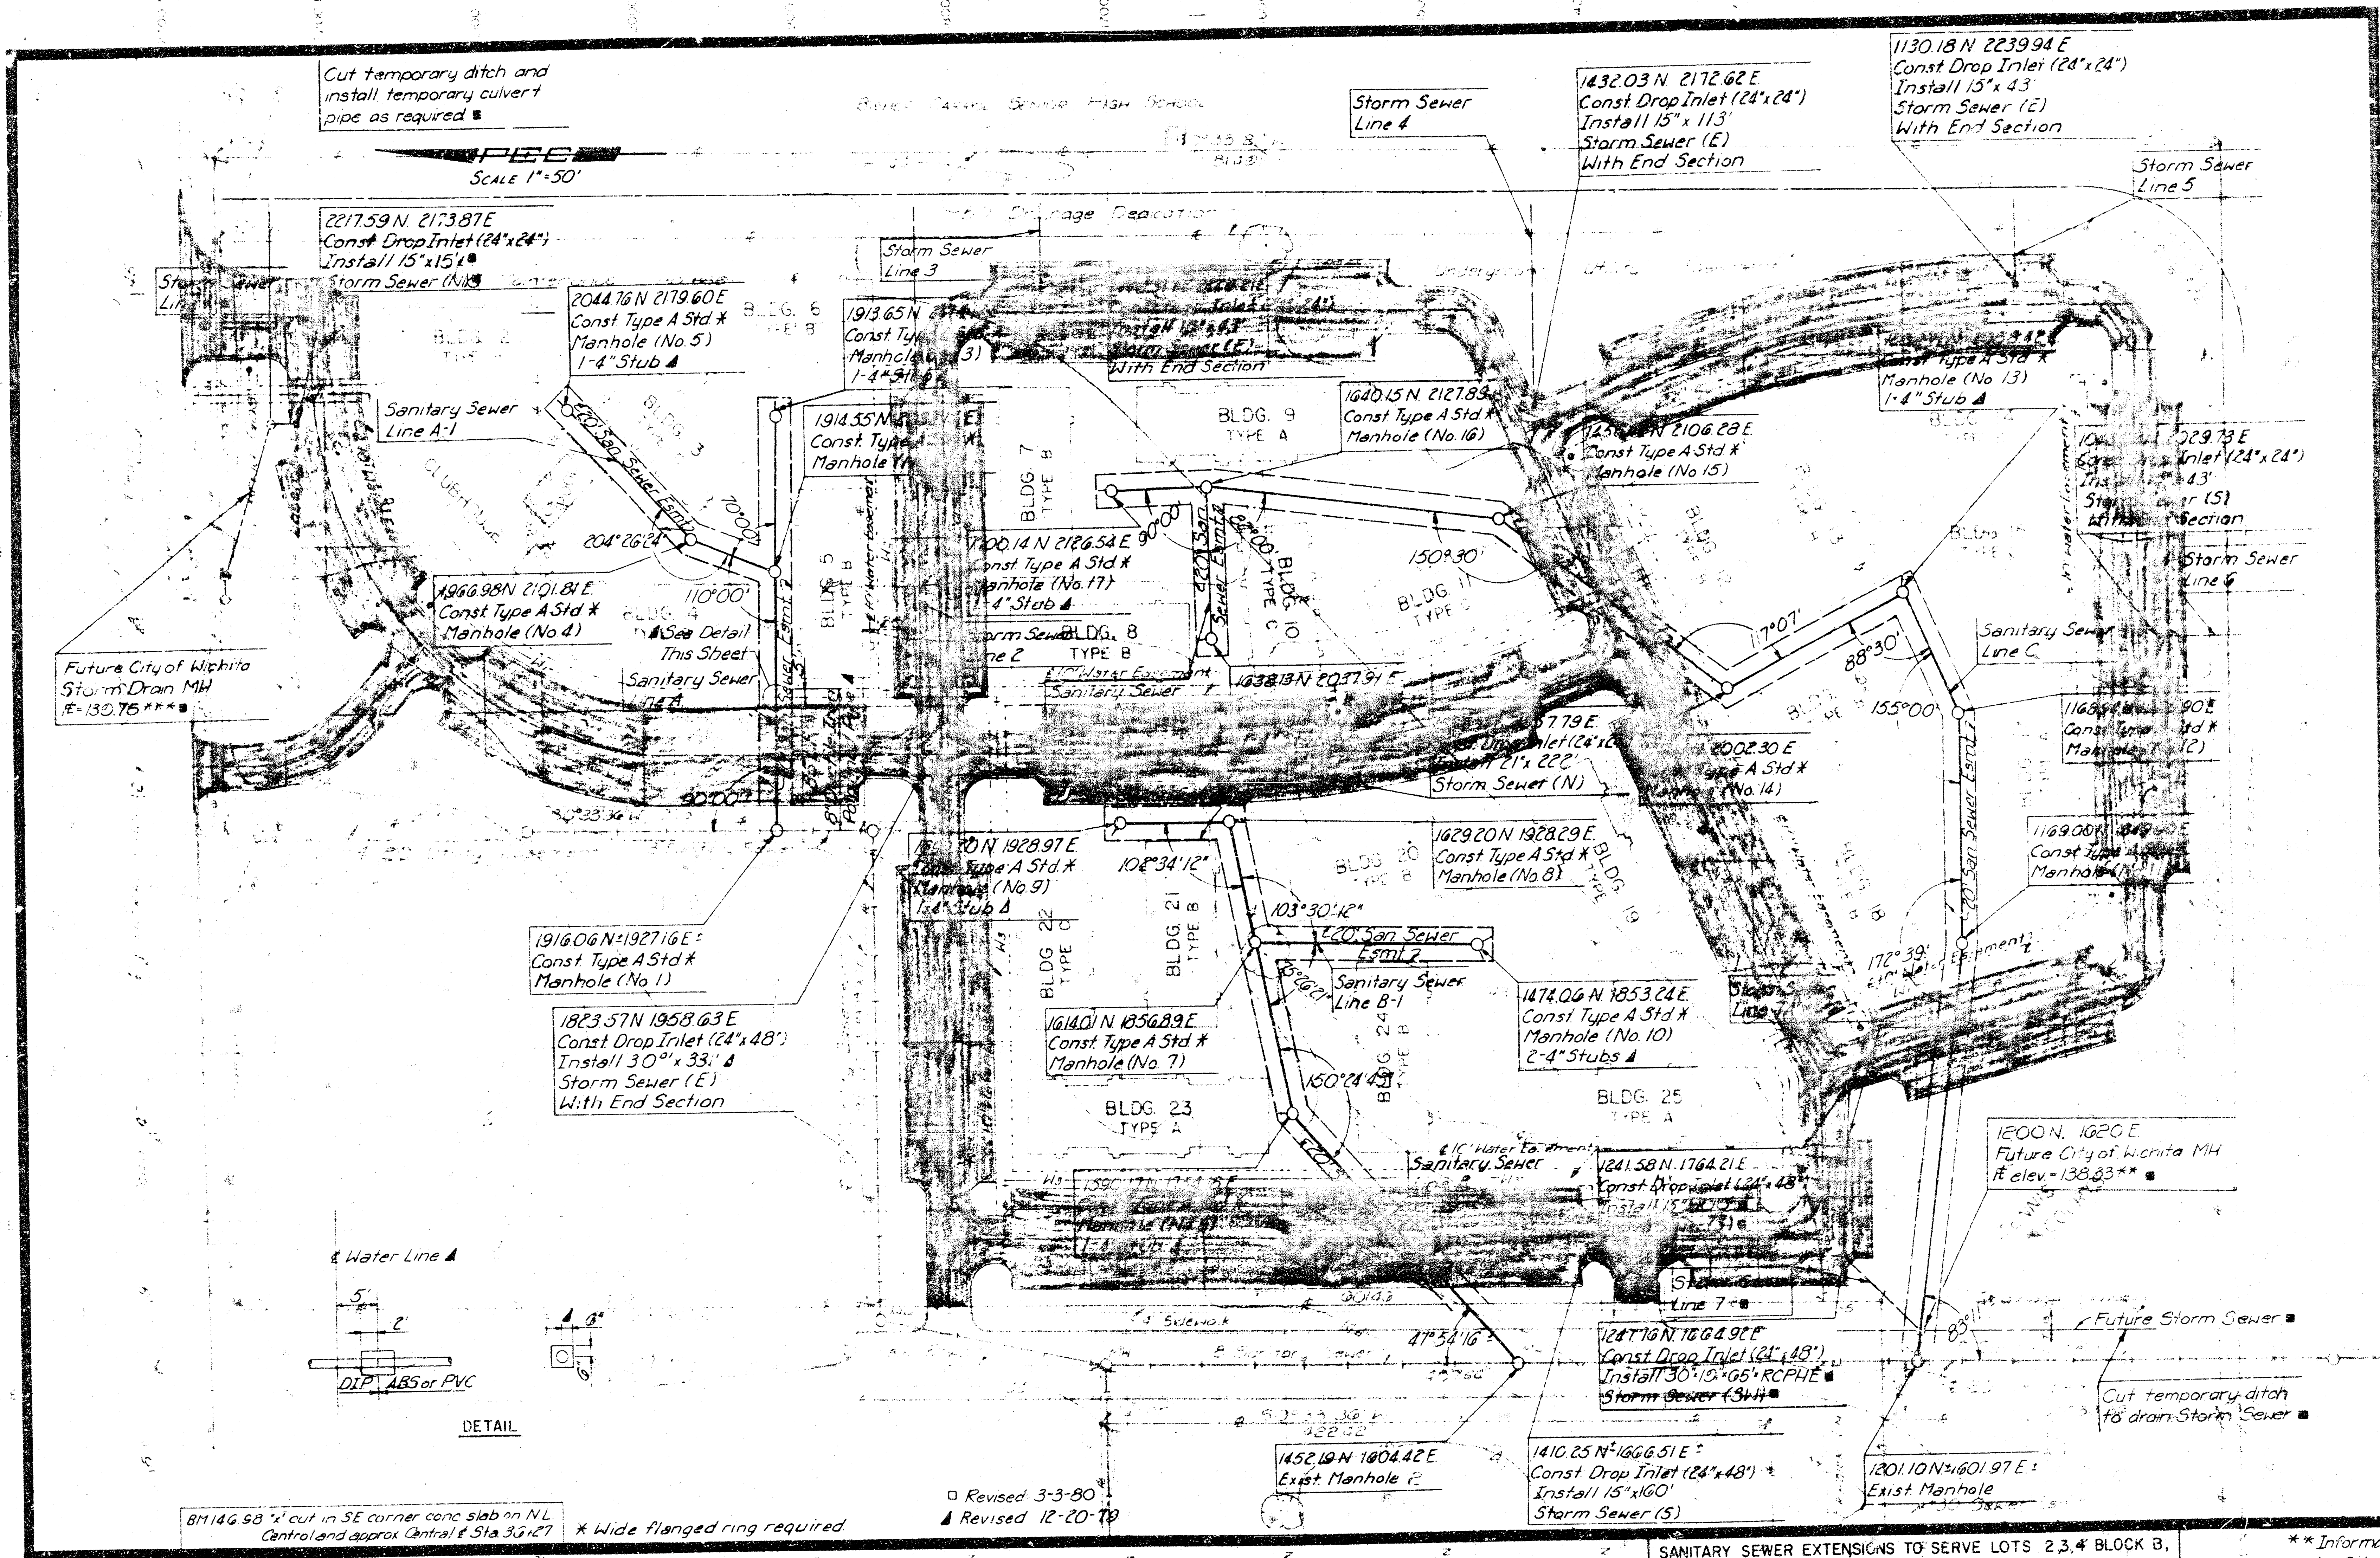

***Information provided by consultant designing Storm Drain for City of Wichita.

12-21-79

P.C.D.

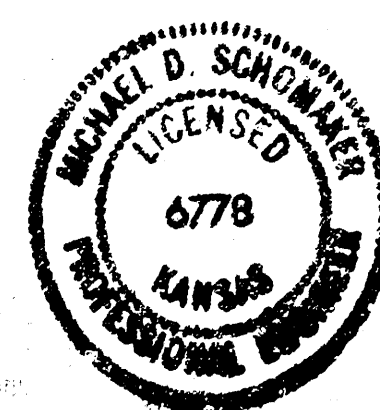



CITY OF WICHITA PROJECT NO. 468-76-245-80889-000-000-008

PROFESSIONAL ENGINEERING CONSULTANTS, P.A.			
ENGINEERS WICHITA, KANSAS			
Designed by	Job No.	Sh. of	
Drawn by	Date		


**Information provided by City of Wichita.

5-8

FILMED FROM THE BEST

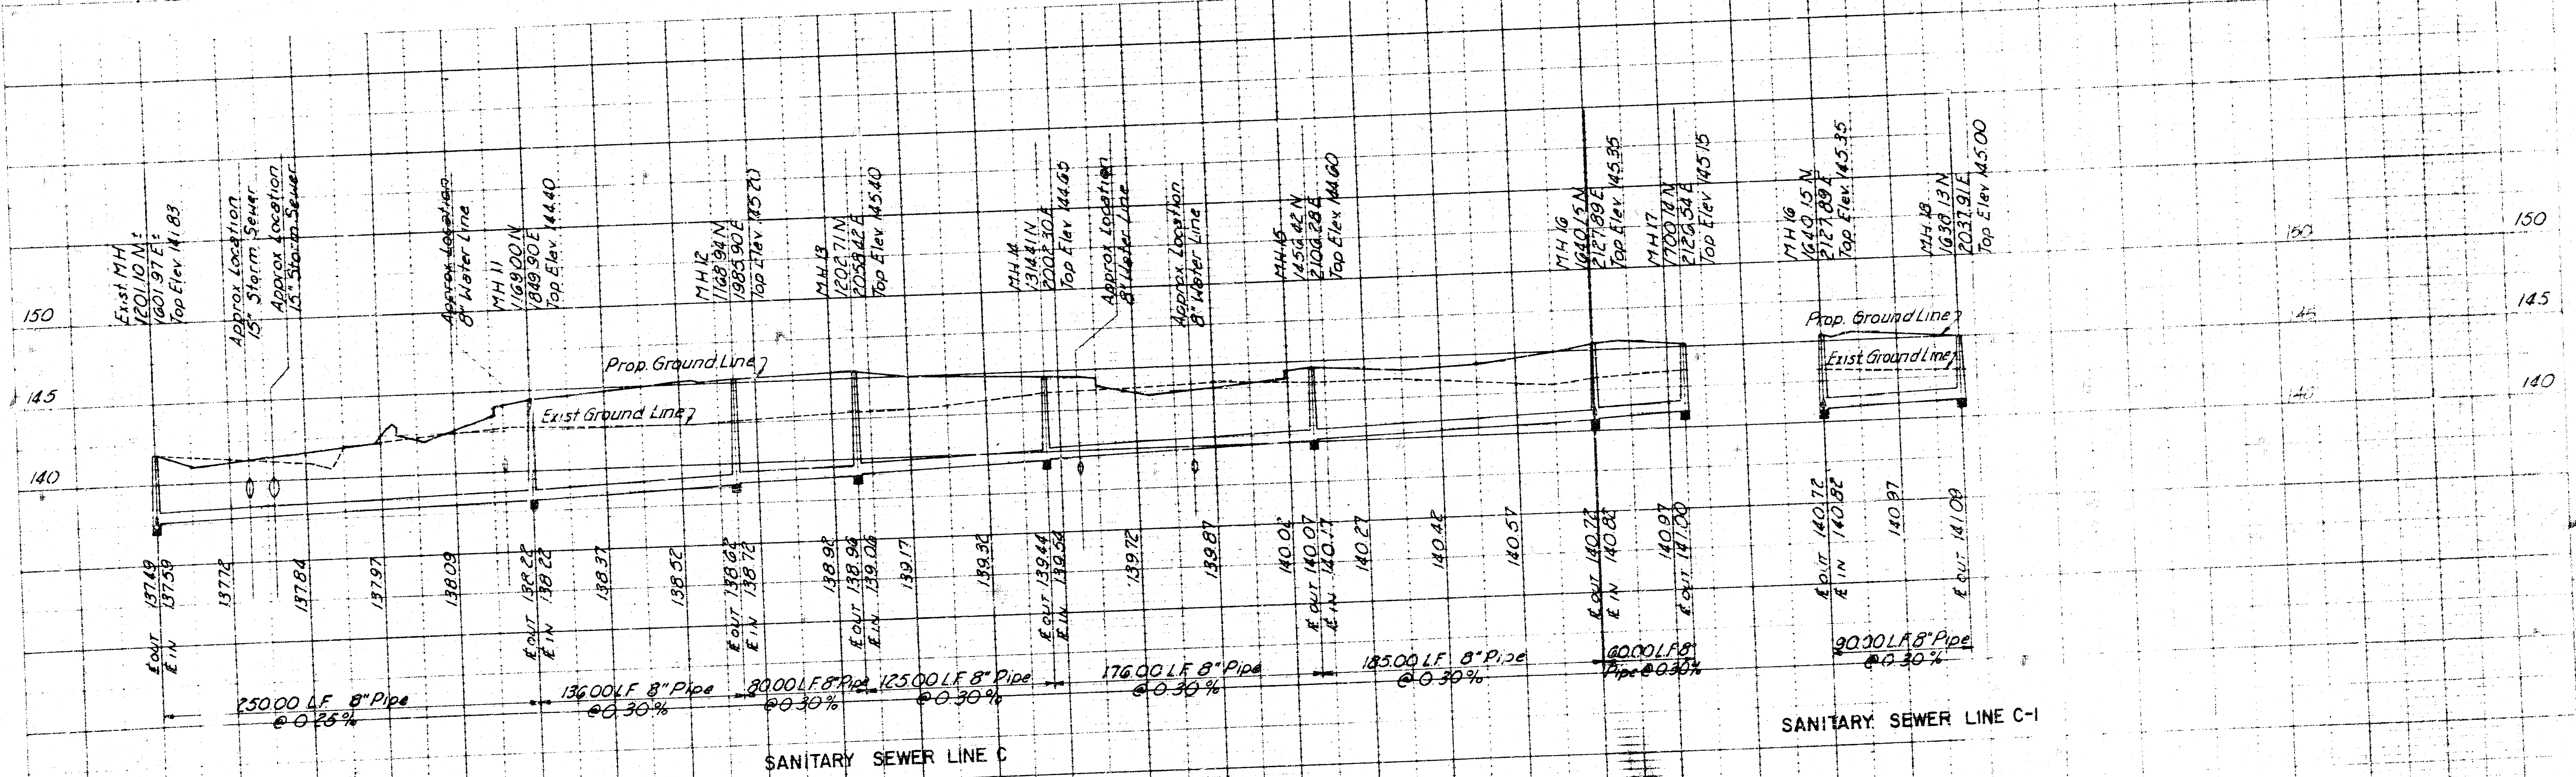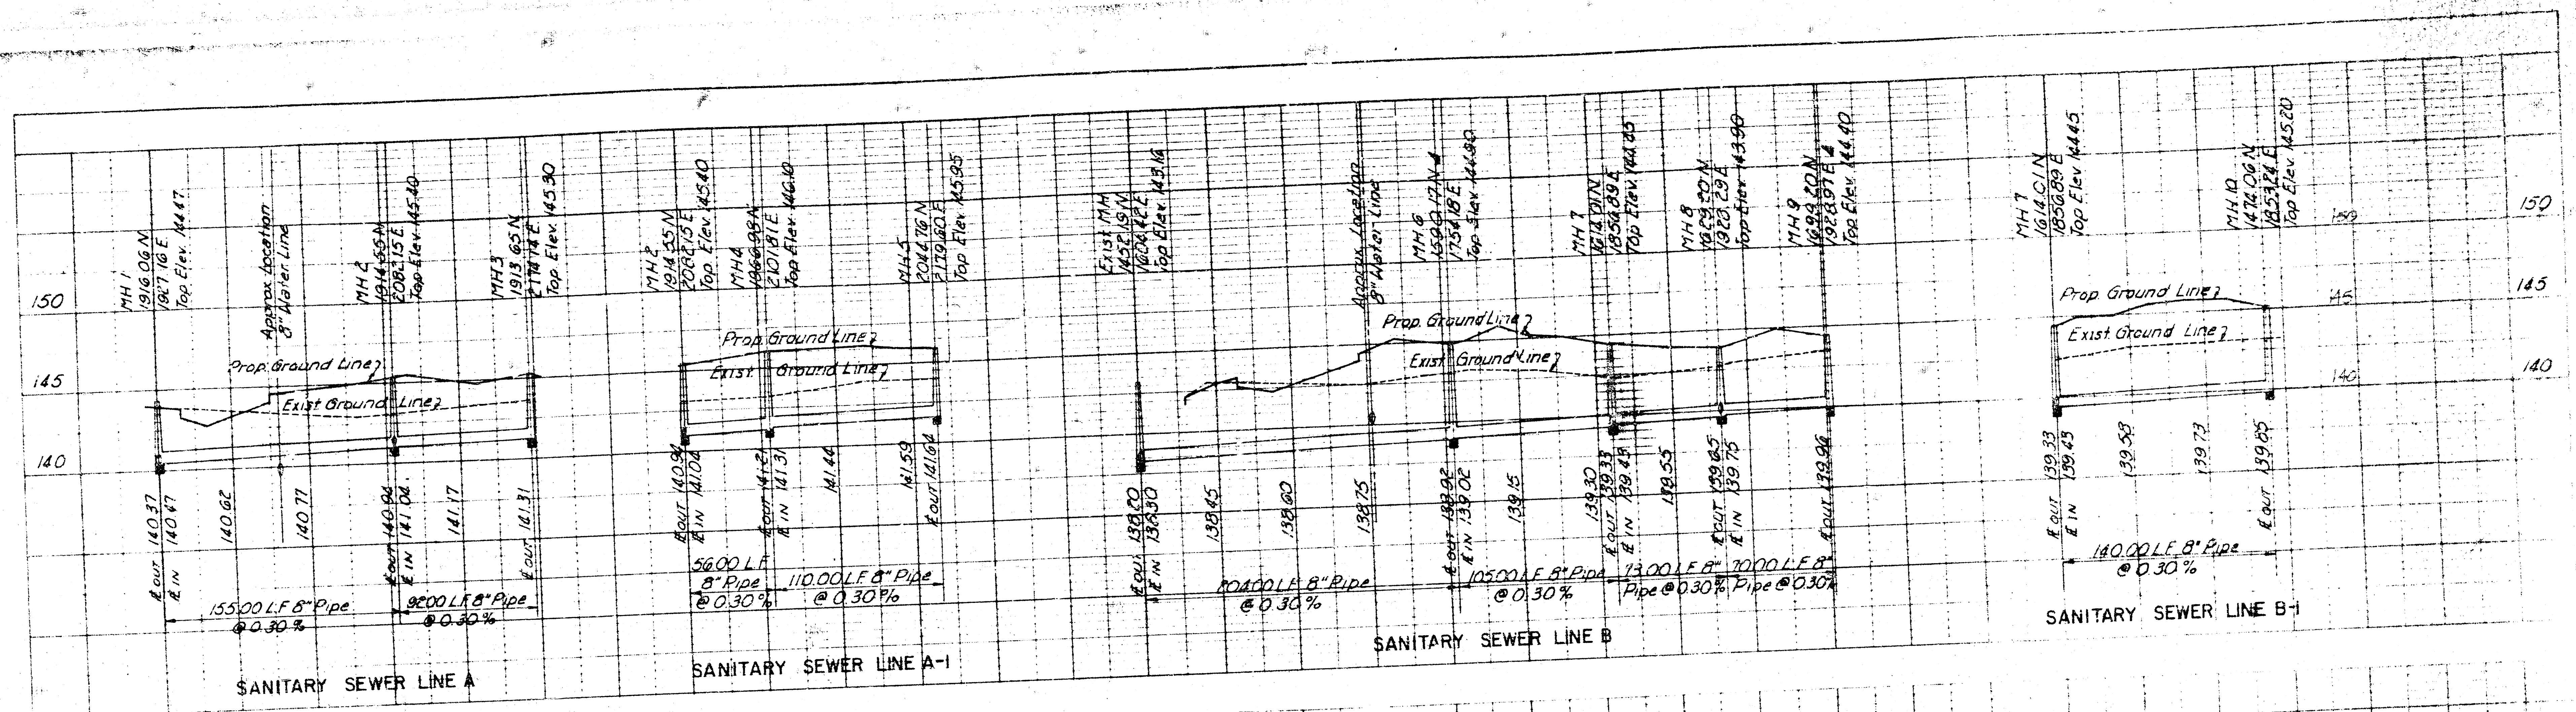

A Revised 12-20-79

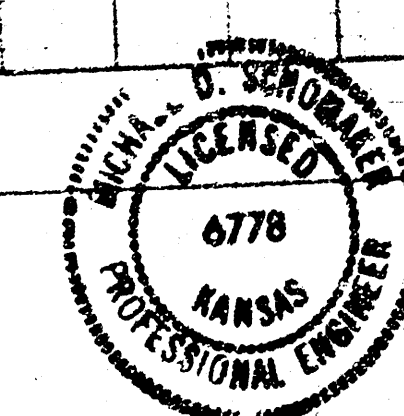

PROFESSIONAL ENGINEERING CONSULTANTS, P.A.			
ENGINEERS WICHITA, KANSAS			
Designed by	Job No. 30-70-955	Sht. of	
Drawn by	Date: Aug. 1979		

FROM THE BEST