


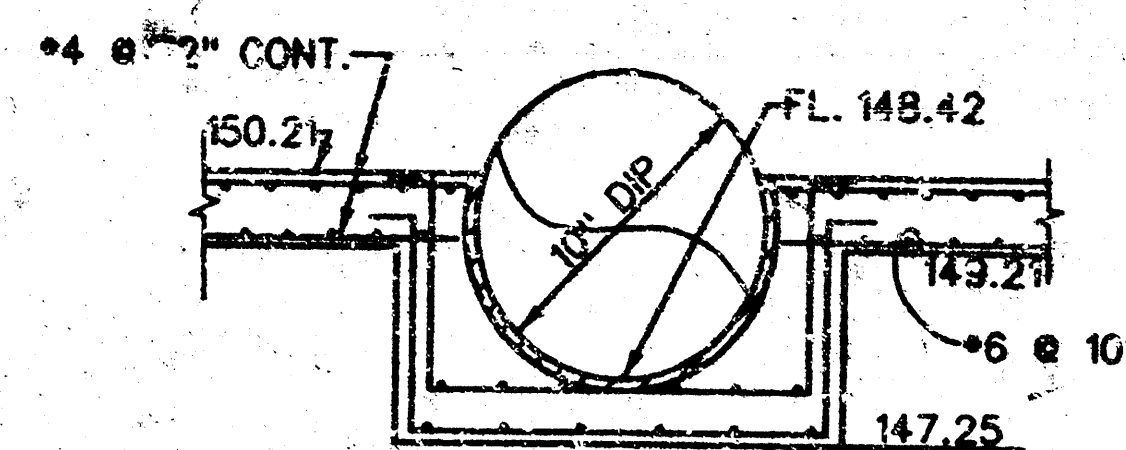

REINFORCING PER 8/5-6 SPANNING ACROSS ROOF



TUNNEL CROSSING SECTION

STA 1+93
END 8" PVC
STORM SEWER

STA 0+00
EXISTING MANHOLE


DURING CONSTRUCTION
OF UNDERGROUND TUNNEL
SEWER LINE TO REMAIN
IN SERVICE AND PROTECTED.

STA 0+52
END OF CONSTRUCTION

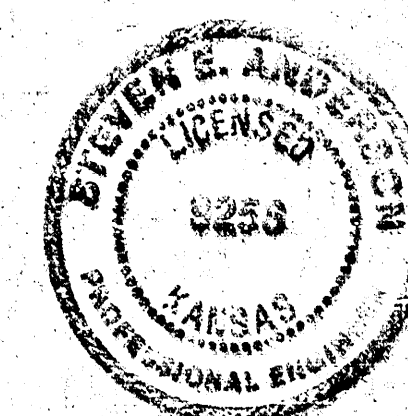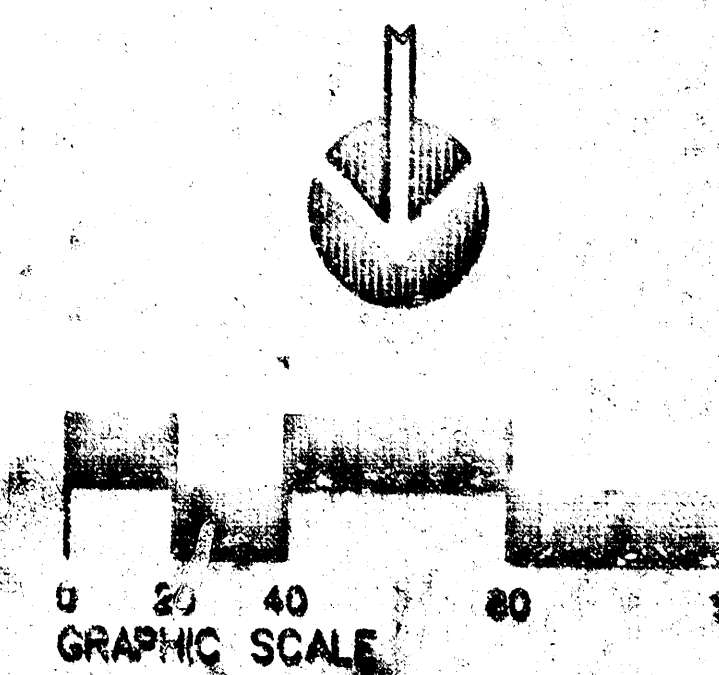

As Built Plans
S. G. ANDERSON, P.E.
December, 1955

PROFILE: VERT. - 1"=1'
HORIZ. - 1"=40'

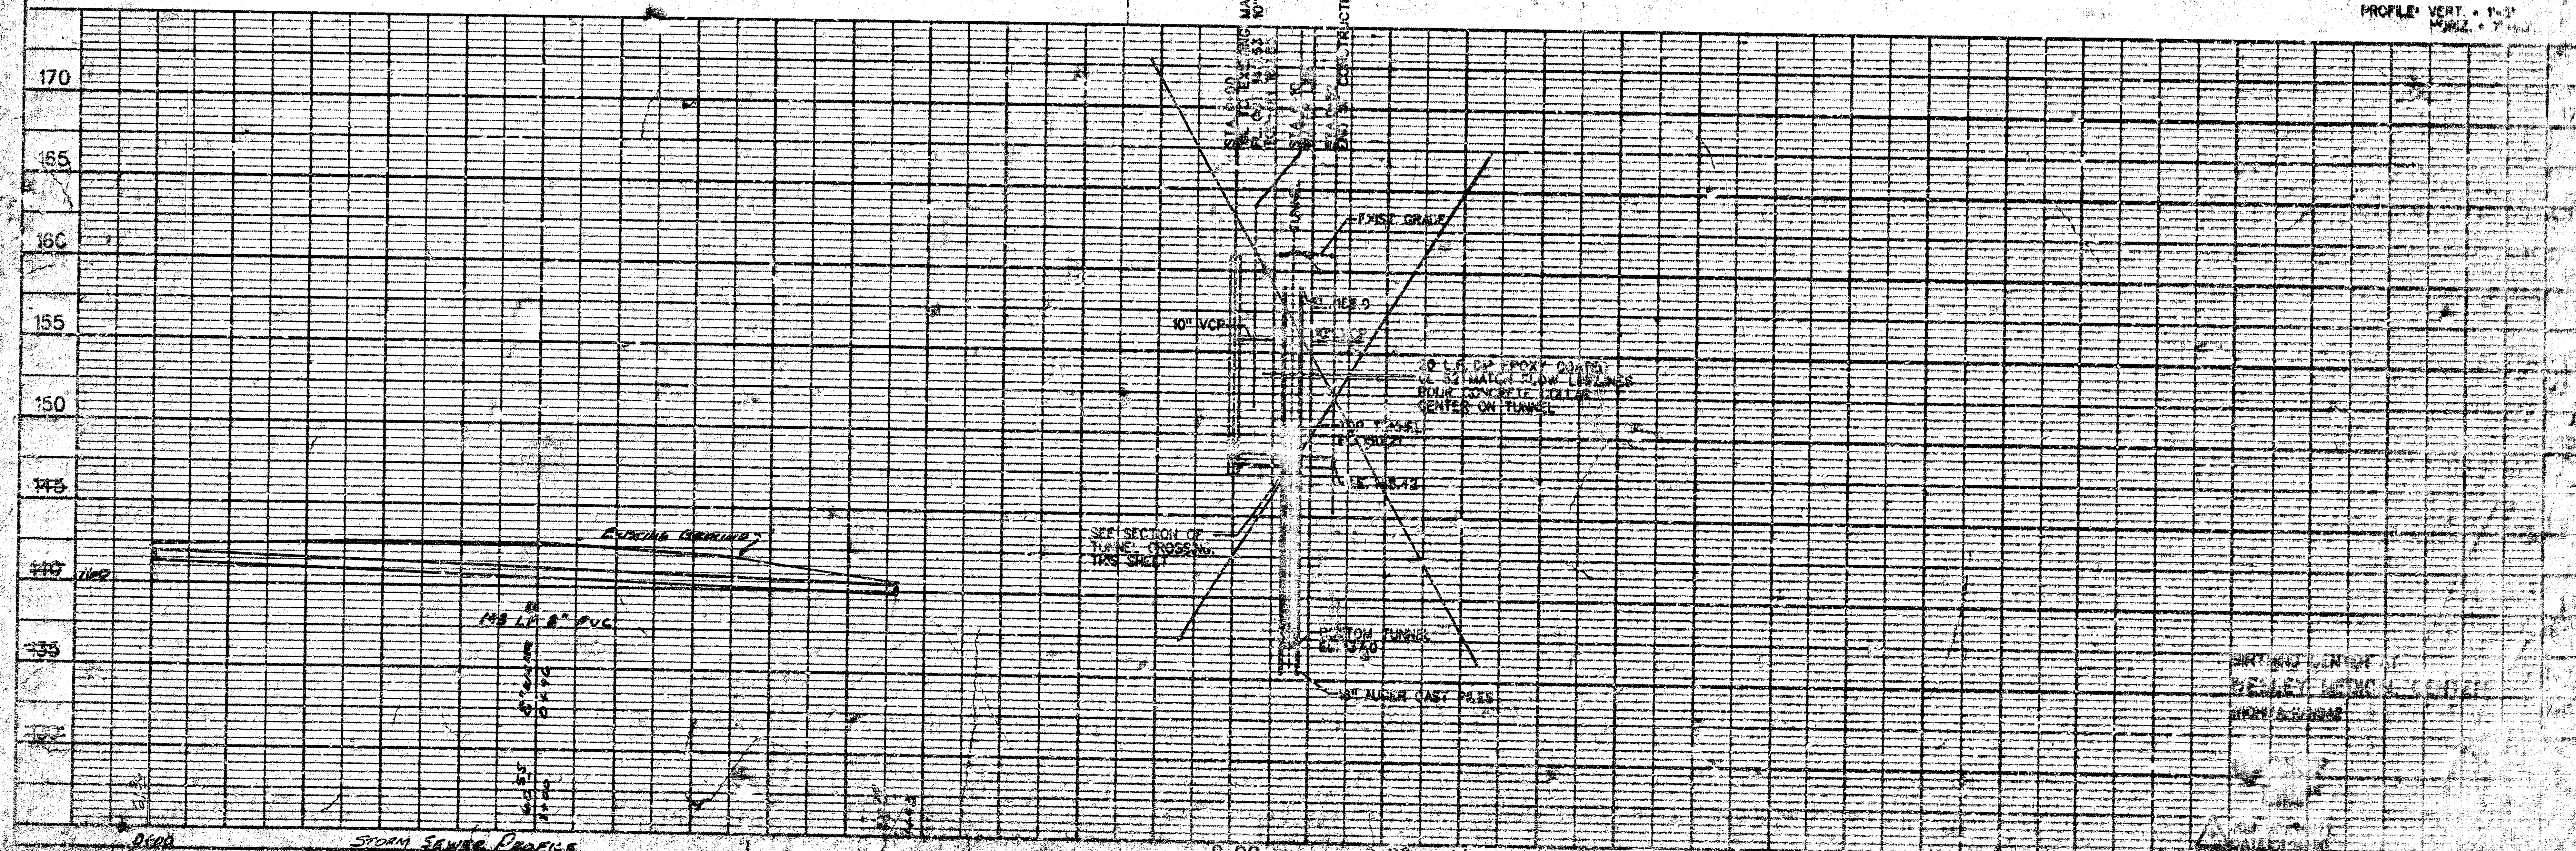

SANITARY SEWER PROFILE