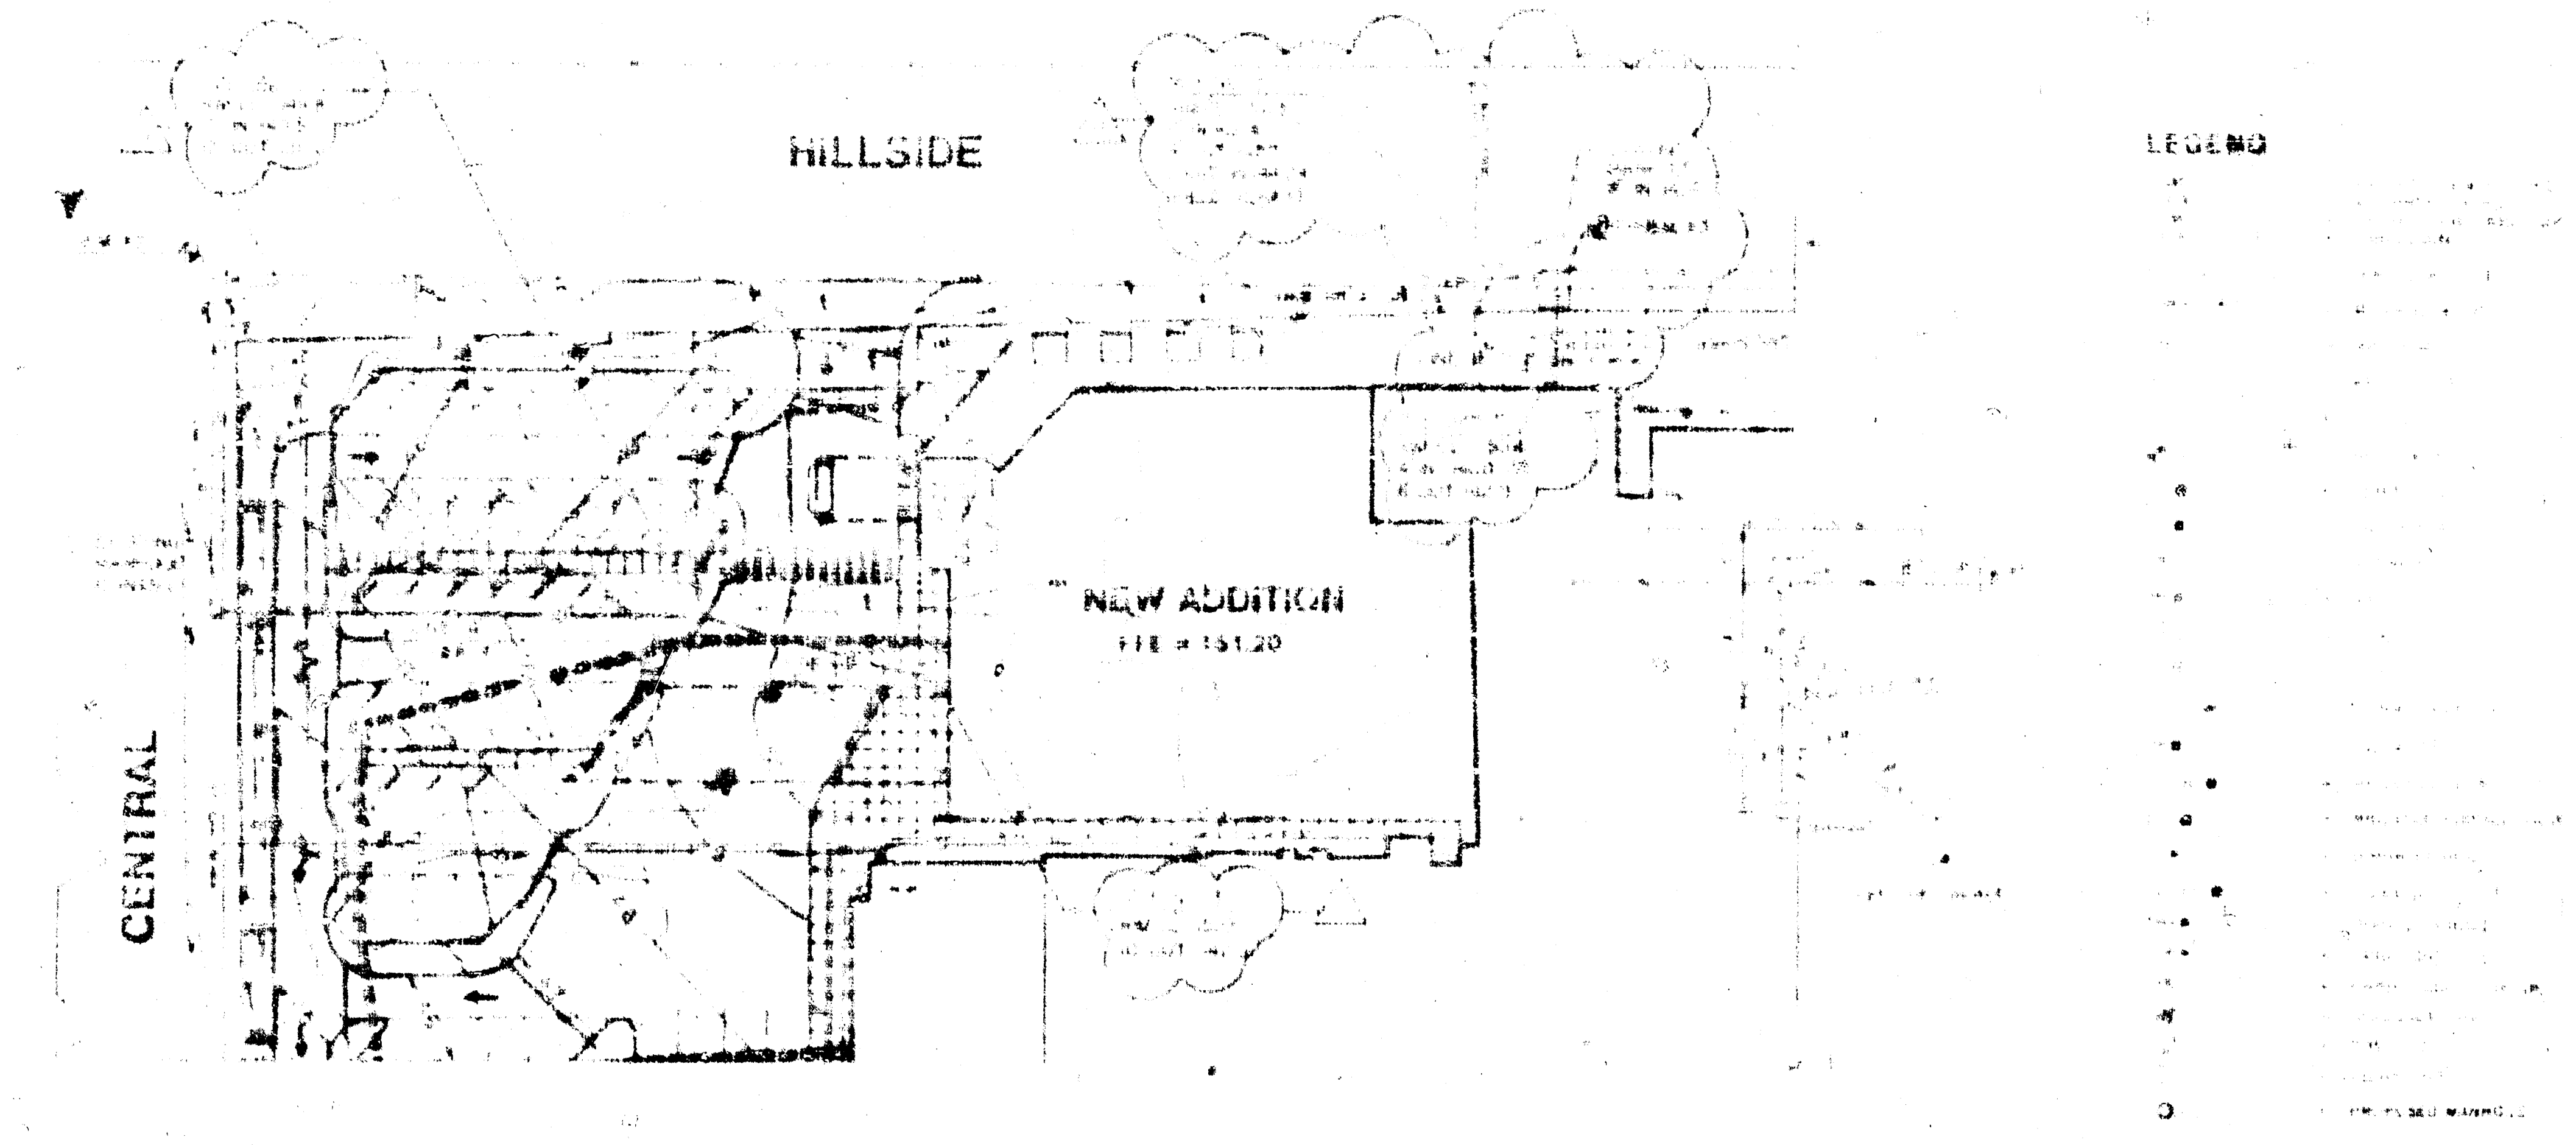

GENERAL NOTES

1. PROPOSED SANITARY SEWER TO BE BUILT TO CITY OF WICHITA STANDARD SPECIFICATIONS.
2. ALL LINES TO BE TV & AIR TESTED.
3. ALL MANHOLES TO BE VACUUM TESTED.

[illegible]

INSPECTION AND TESTING FOR THIS PROJECT IS TO BE PROVIDED BY A LICENSED CONSULTING ENGINEERING FIRM UNDER CONTRACT WITH THE OWNER/DEVELOPER. SAID INSPECTION TO BE IN ACCORDANCE WITH THE CITY OF WICHITA STANDARD CONSTRUCTION AND TESTING PRACTICES AND CERTIFIED BY A LICENSED PROFESSIONAL ENGINEER. NO WORK SHALL BE PERFORMED IN DEDICATED EASEMENTS OR THE PUBLIC RIGHT-OF-WAY BY THE CONTRACTOR WITHOUT CITY INSPECTION NOR SHALL ANY WORK BE COMMENCED IN DEDICATED EASEMENTS OR PUBLIC RIGHT-OF-WAY WITHOUT WRITTEN AUTHORIZATION BY THE CITY ENGINEER.

APPROVED AS NOTED
BY CITY ENGINEER OF WICHITA

Sanitary Sewer [illegible]
Storm Sewer ______
Driveway Approaches ______
Water Mains ______
Paving ______

BENCH MARK INFORMATION

BM #1 "[illegible]" CUT ON [illegible] CURB BACK OF TRAFFIC SIGNAL POLE ON N.E. CORNER CENTRAL & HILLSIDE. ELEV= [illegible]

BM #2 "[illegible]" CUT ON EAST [illegible] HILLSIDE [illegible] WALK ACROSS CENTRAL & HILLSIDE. ELEV= [illegible]

PLAN SCALE: 1" = 40'

PROFILE SCALE: HORIZ. 1" = [illegible]
VERT. 1" = [illegible]

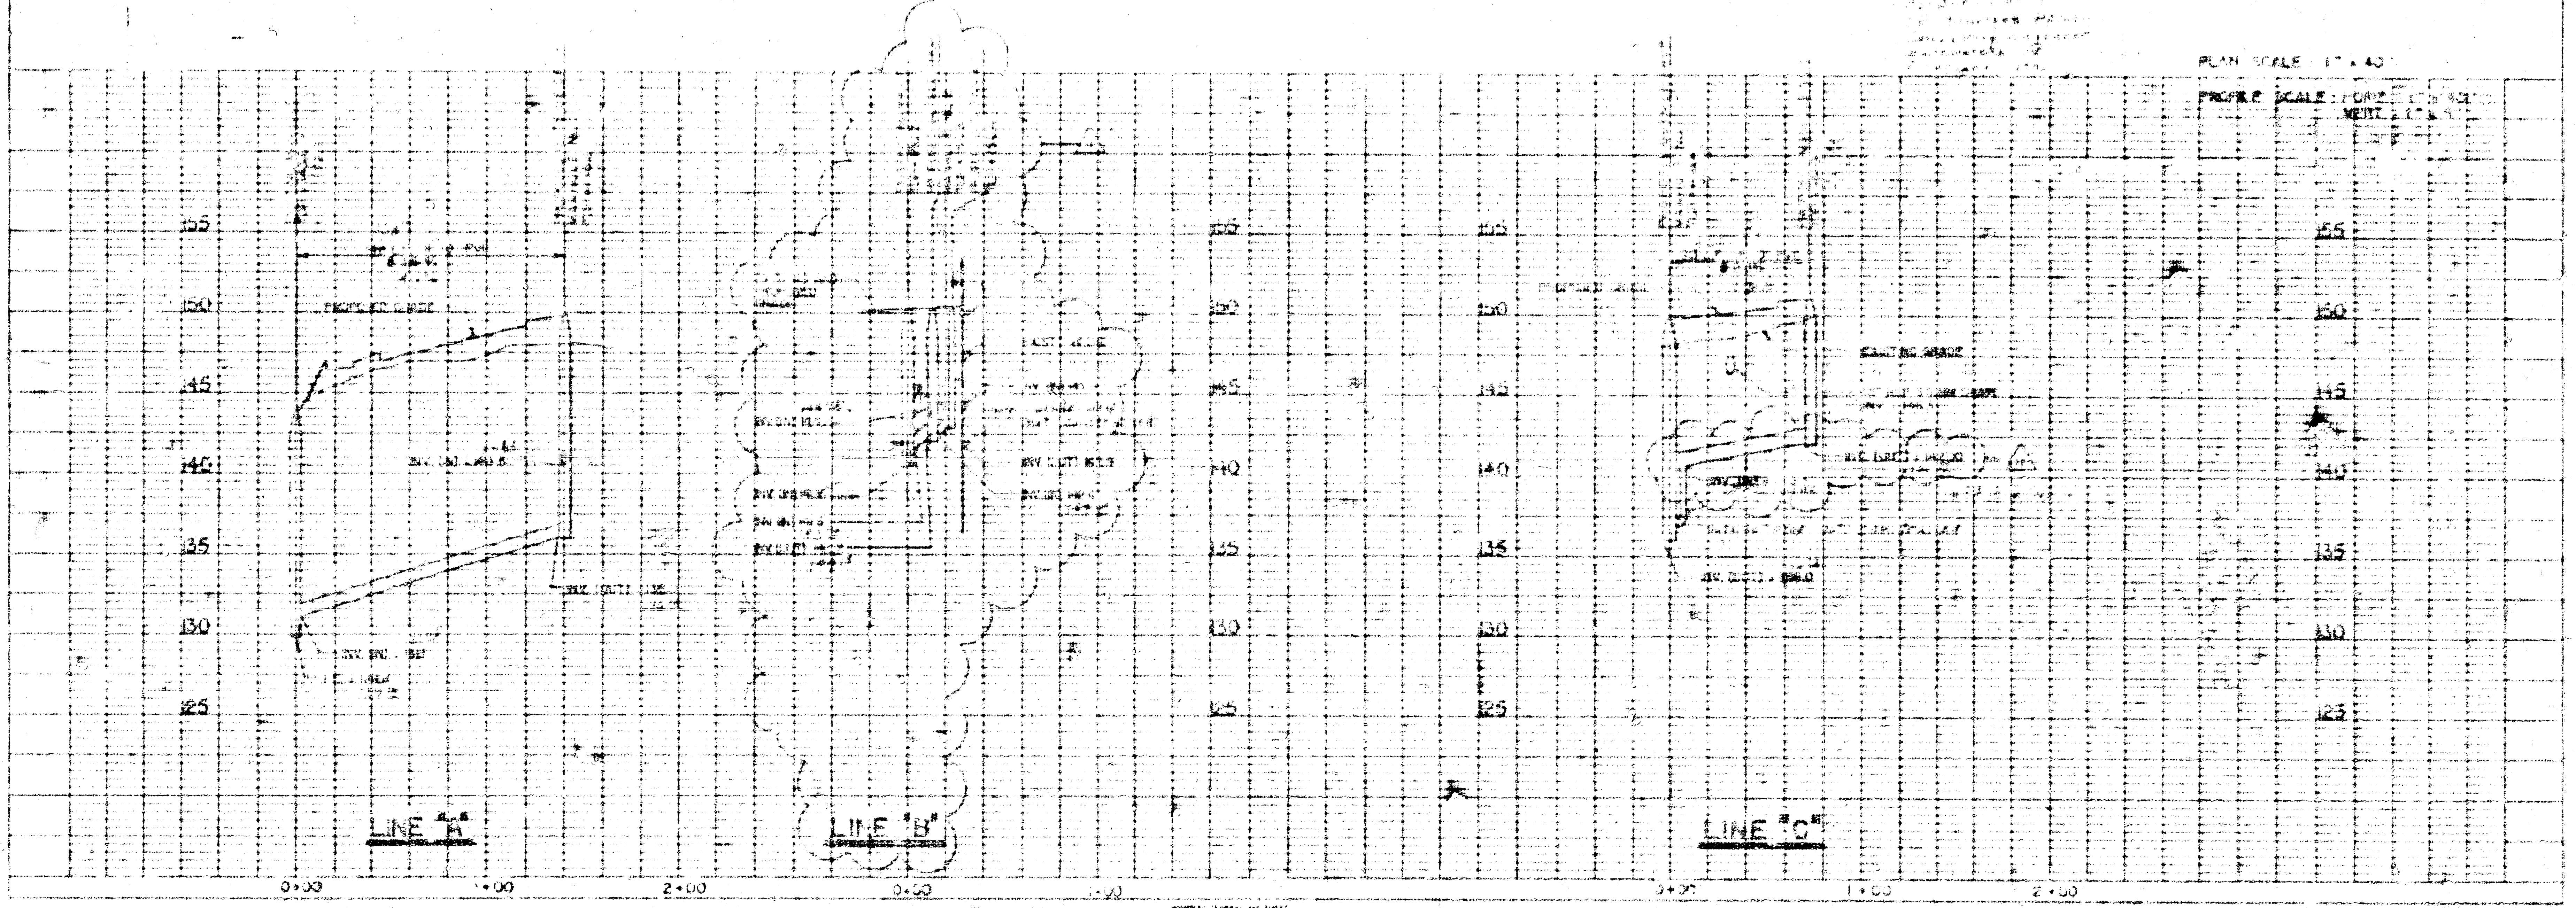

CITY OF WICHITA PRIVATE PROJECT NO. 3[illegible]2PPS(607AS1)

VOLUME TWO

GOULD TURNER GROUP, P.C.
ARCHITECTS & PLANNERS
4400 HARDING ROAD, SUITE 1000
NASHVILLE, TN 37205

WESLEY MEDICAL CENTER
ADDITIONS AND RENOVATIONS
WICHITA, KANSAS

HCA The Healthcare Company

DATE
2.28.9[illegible]

10864

SANITARY SEWER PLAN AND PROFILE

C4.03

FILMED FROM THE BEST