



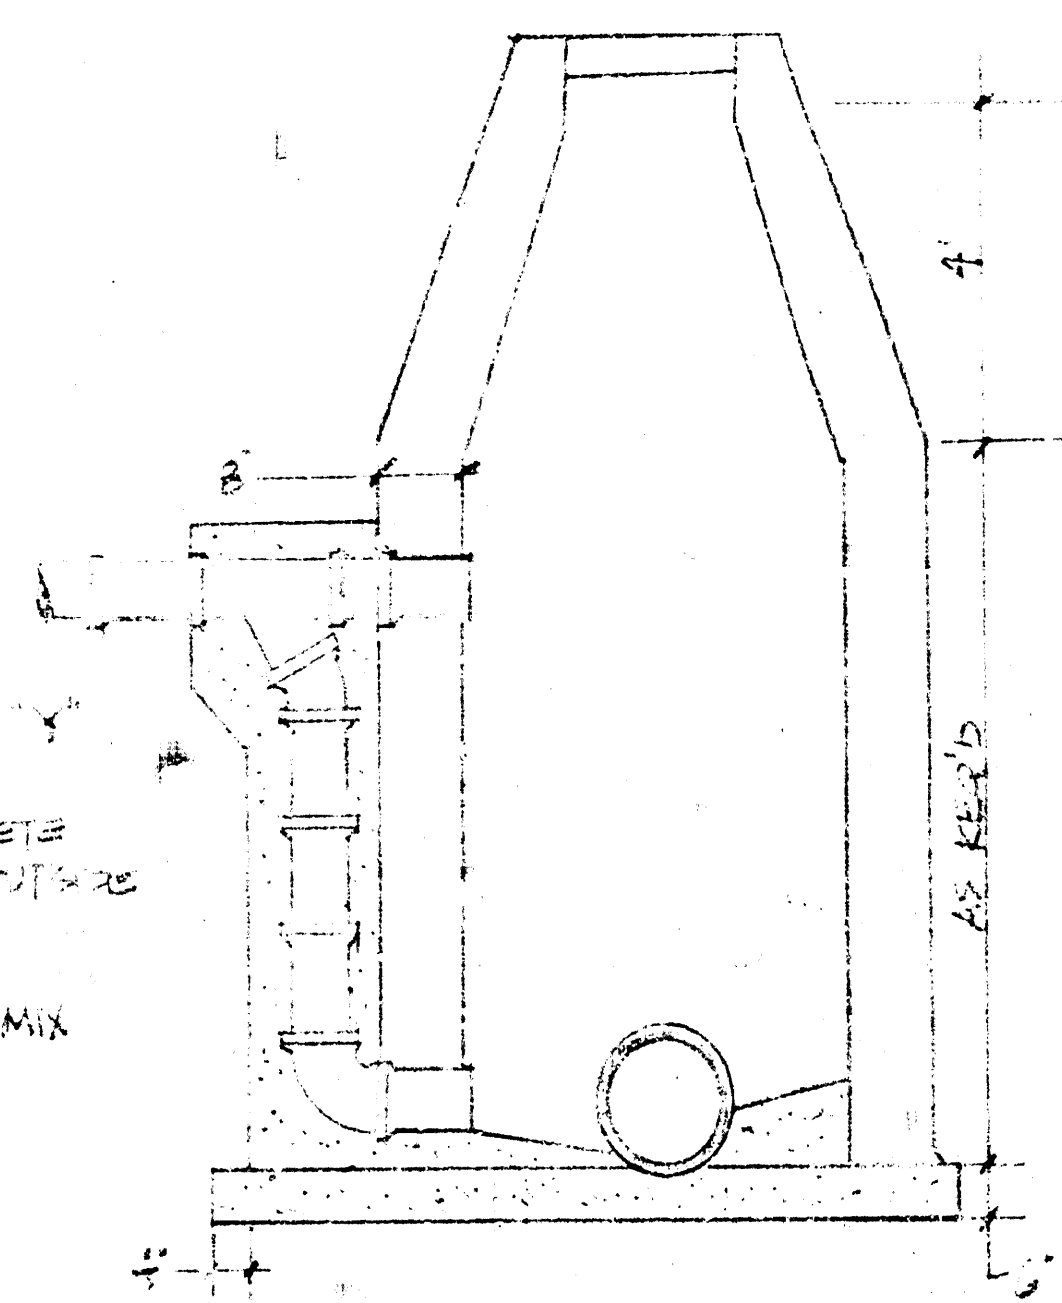


OUTSIDE DROP MANHOLE
TYPE "A" or "C"

HILLSIDE AVE.

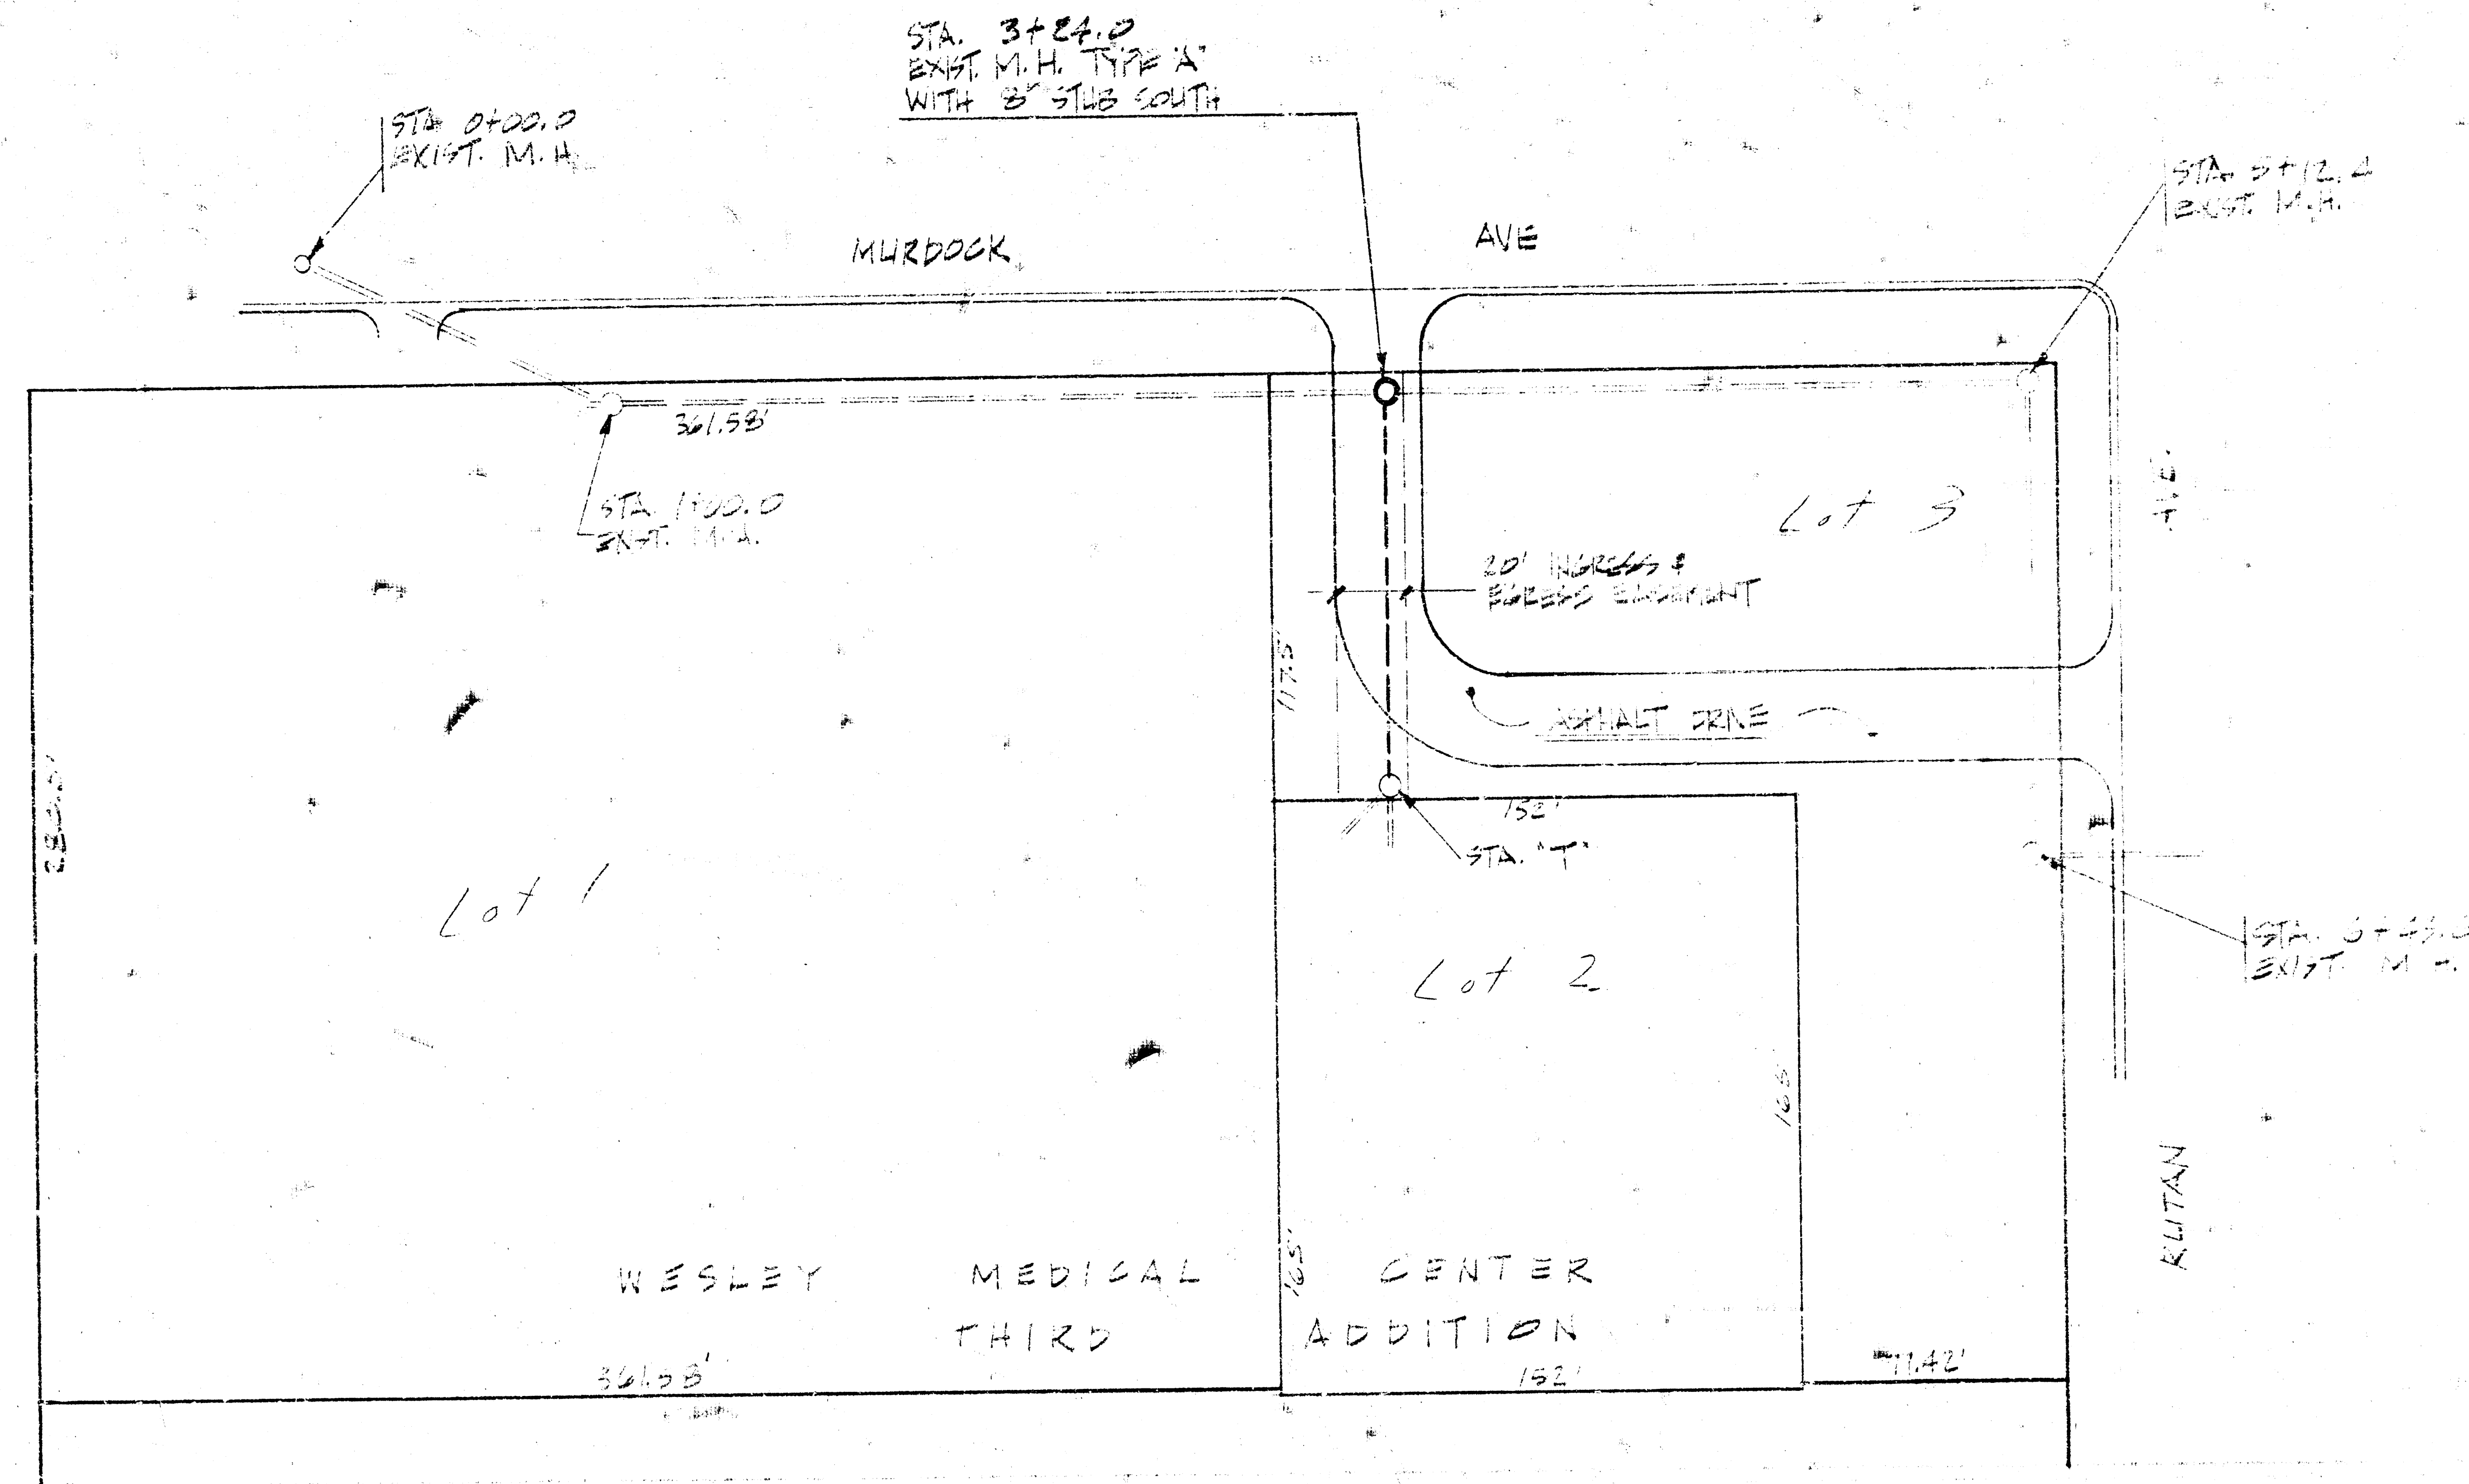

7-9-75
APPROVED AS NOTED
BY CITY ENGINEER OF WICHITA
Sanitary Sewers D.E.S.
Storm Sewers _____
Driveway Approaches _____

Central
Air Conditioning Co., Inc.
Mechanical Contractors

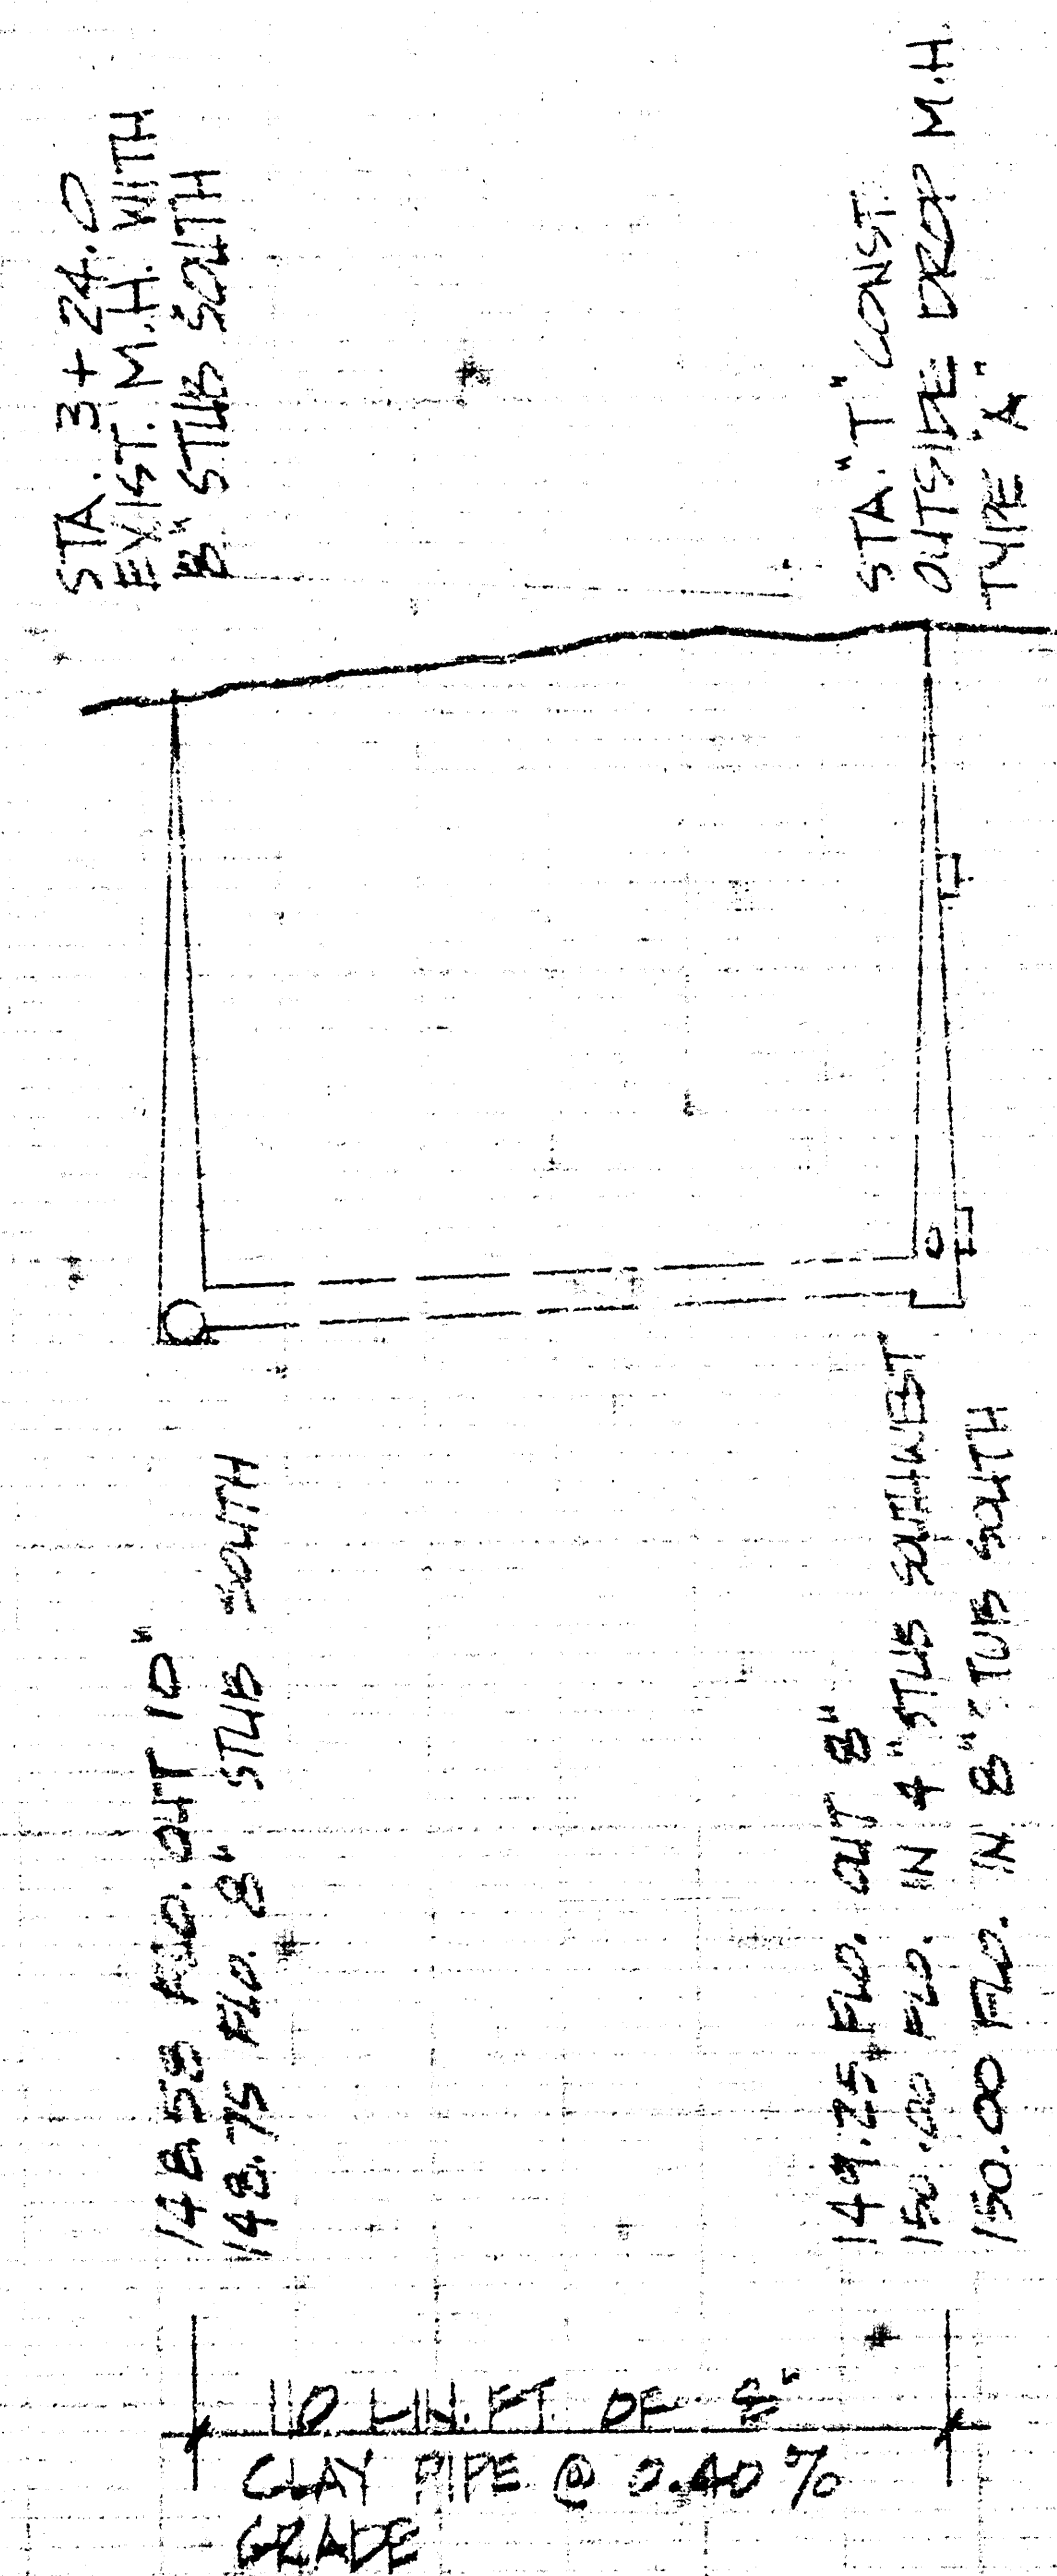

GENERAL NOTES:
1. ALL PIPING PER CITY
OF WICHITA STANDARDS
2. ALL EXCAVATION PER
CITY STANDARDS
3. ALL BACKFILL PER CITY
OF WICHITA STANDARDS

ADDITION TO A PART OF
DIST. M. S. S. NO. 12
CITY OF WICHITA, KANSAS
PROJECT NO. DRAW 205 P. 2