
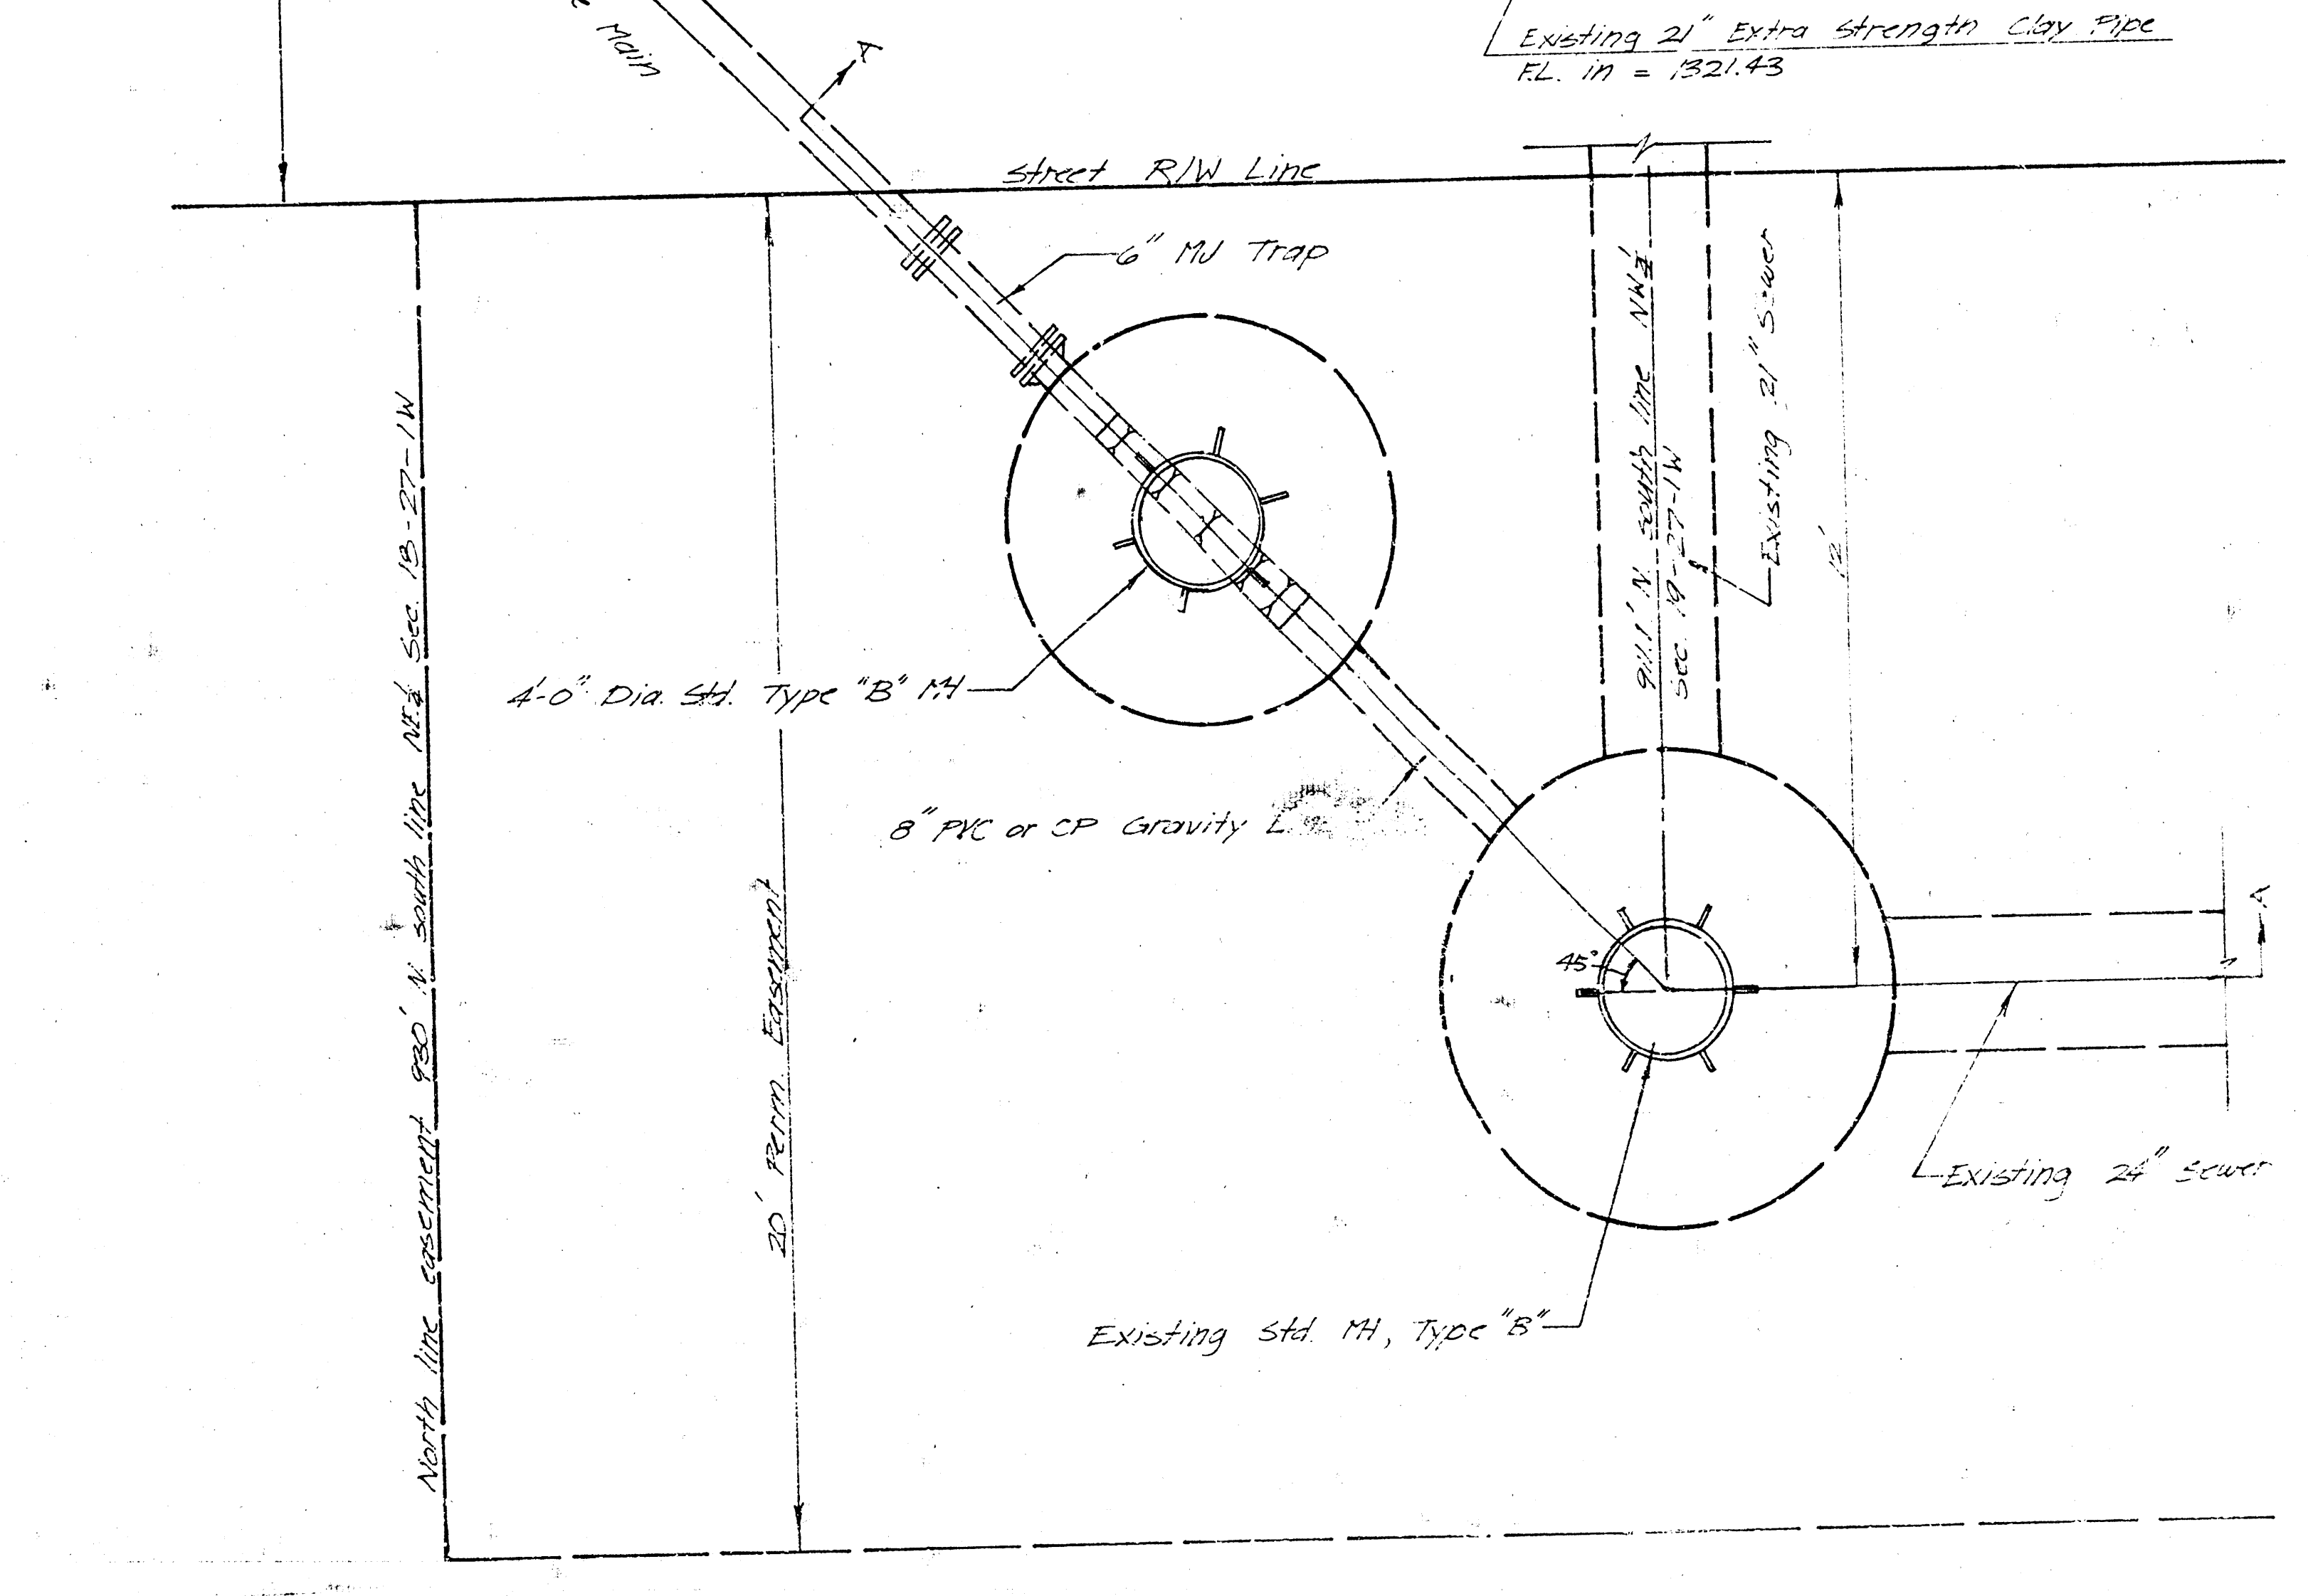
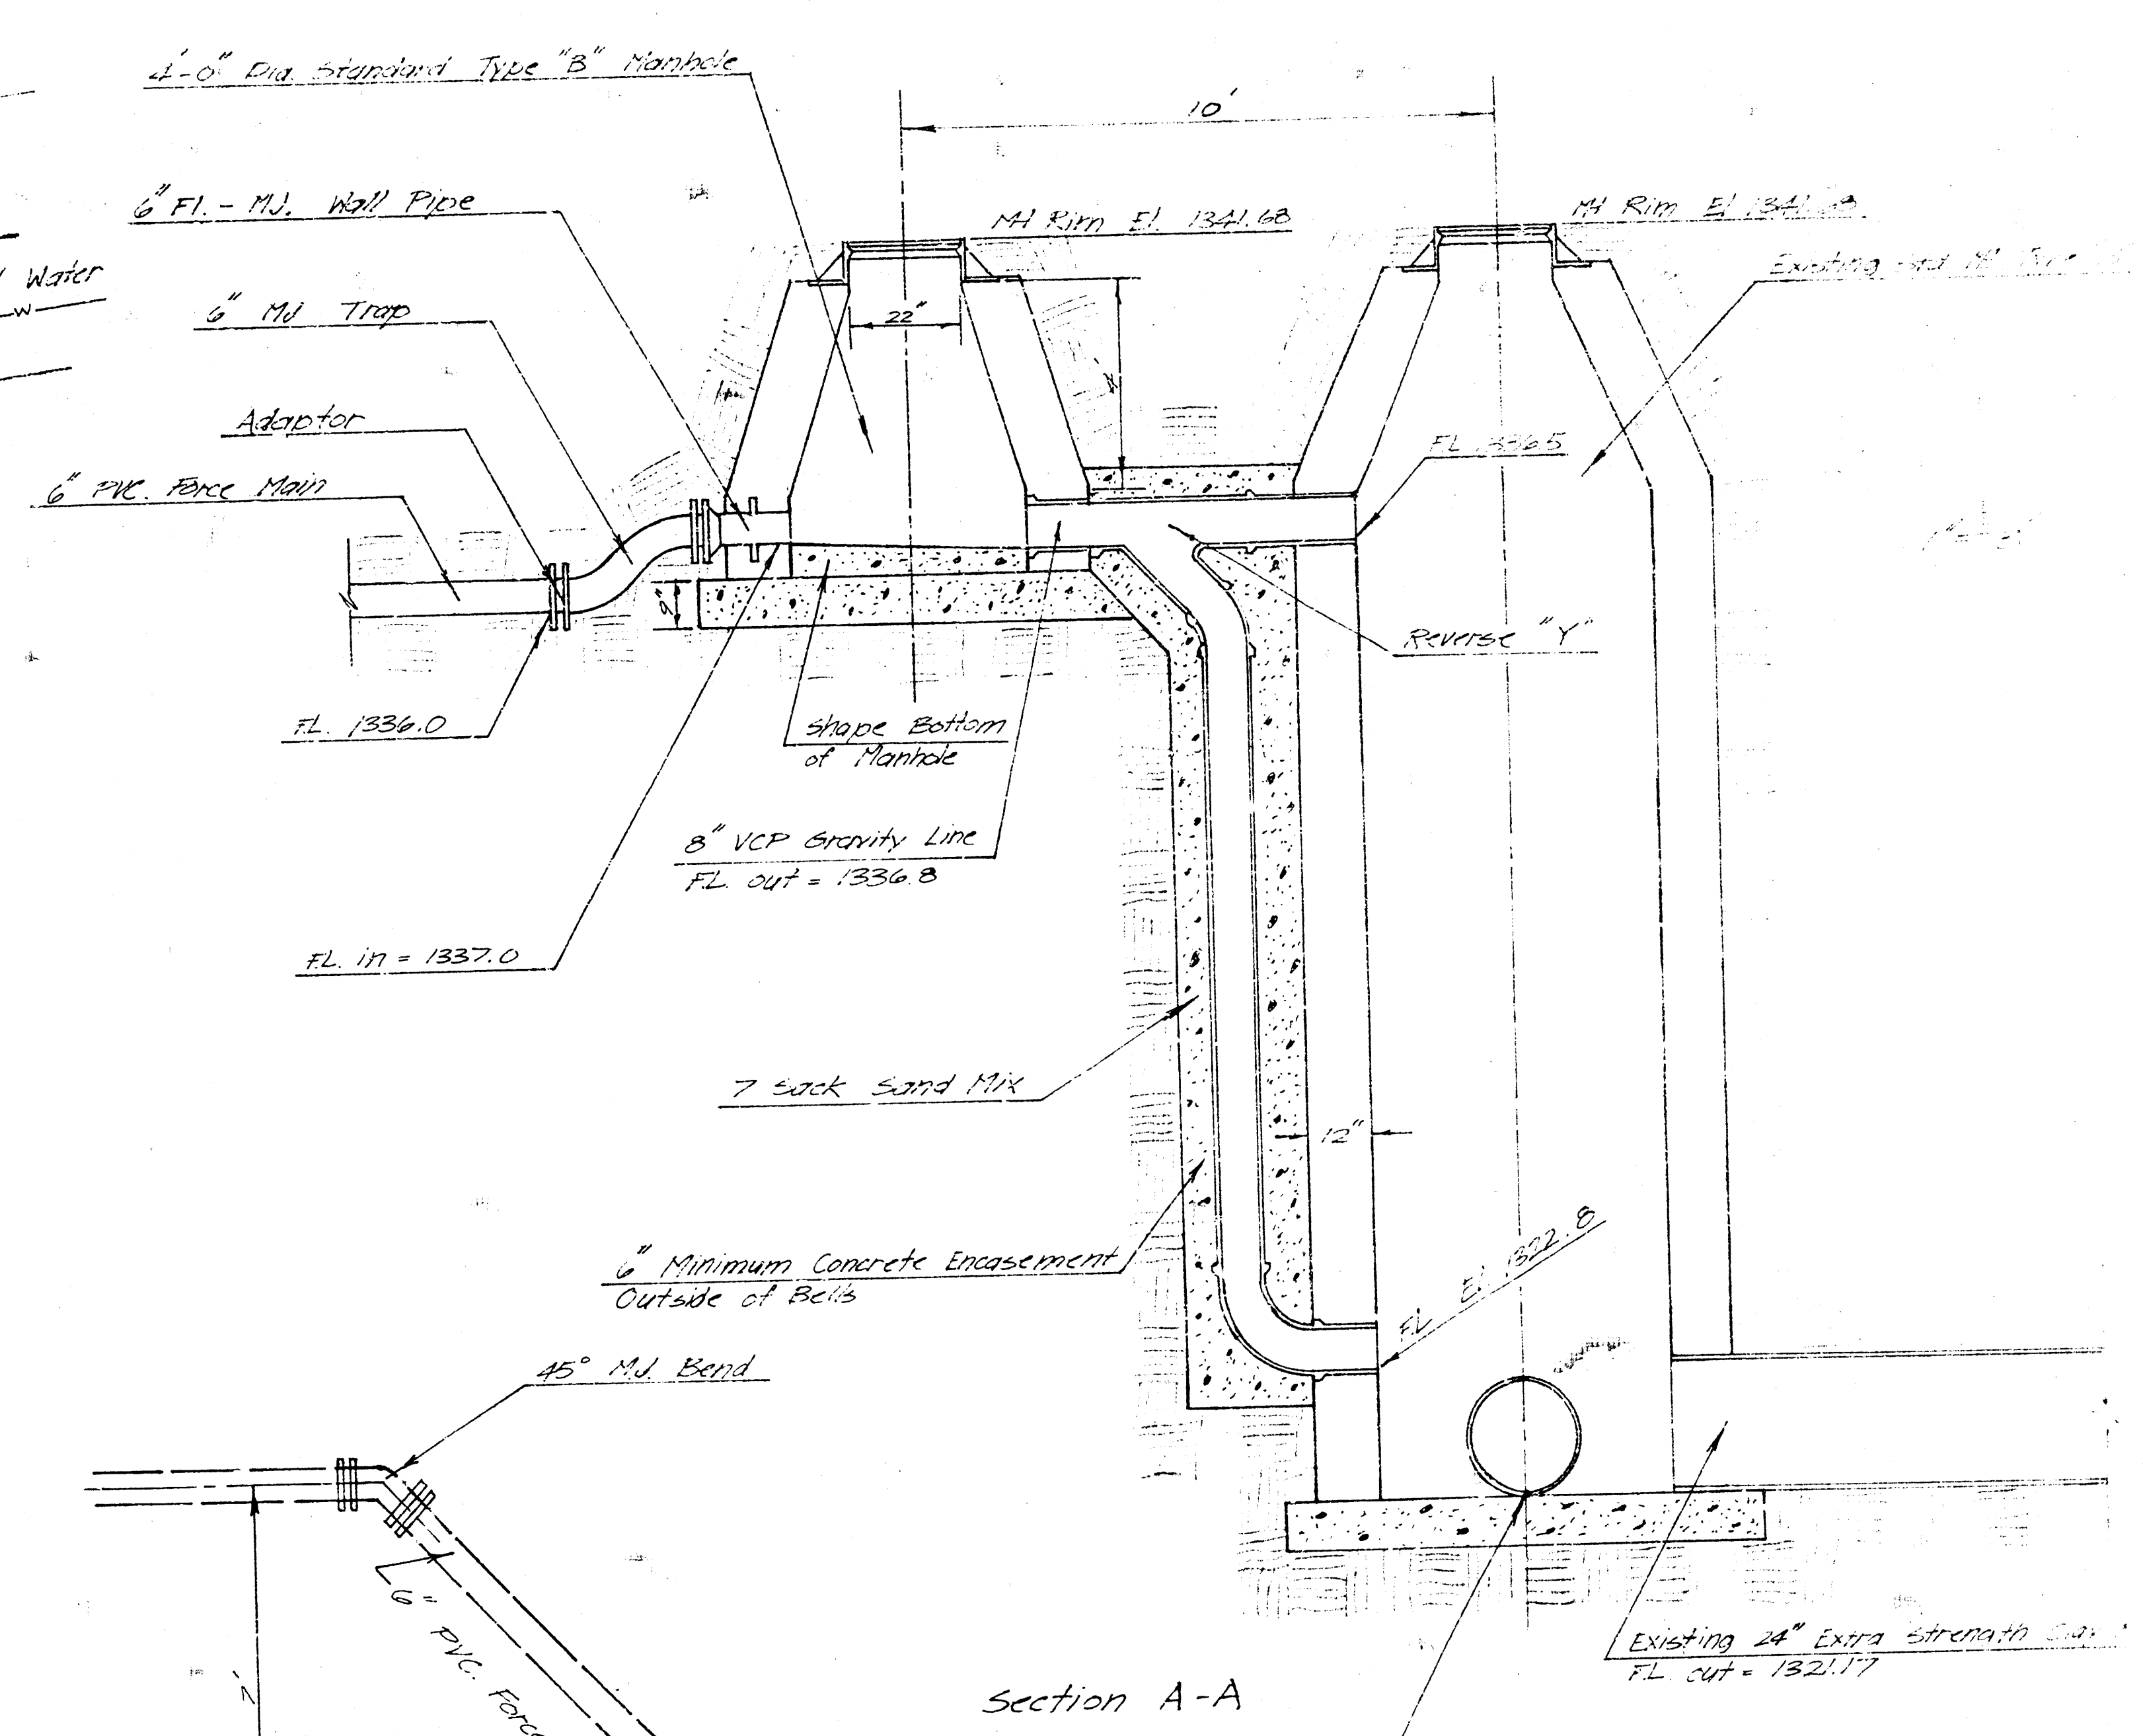
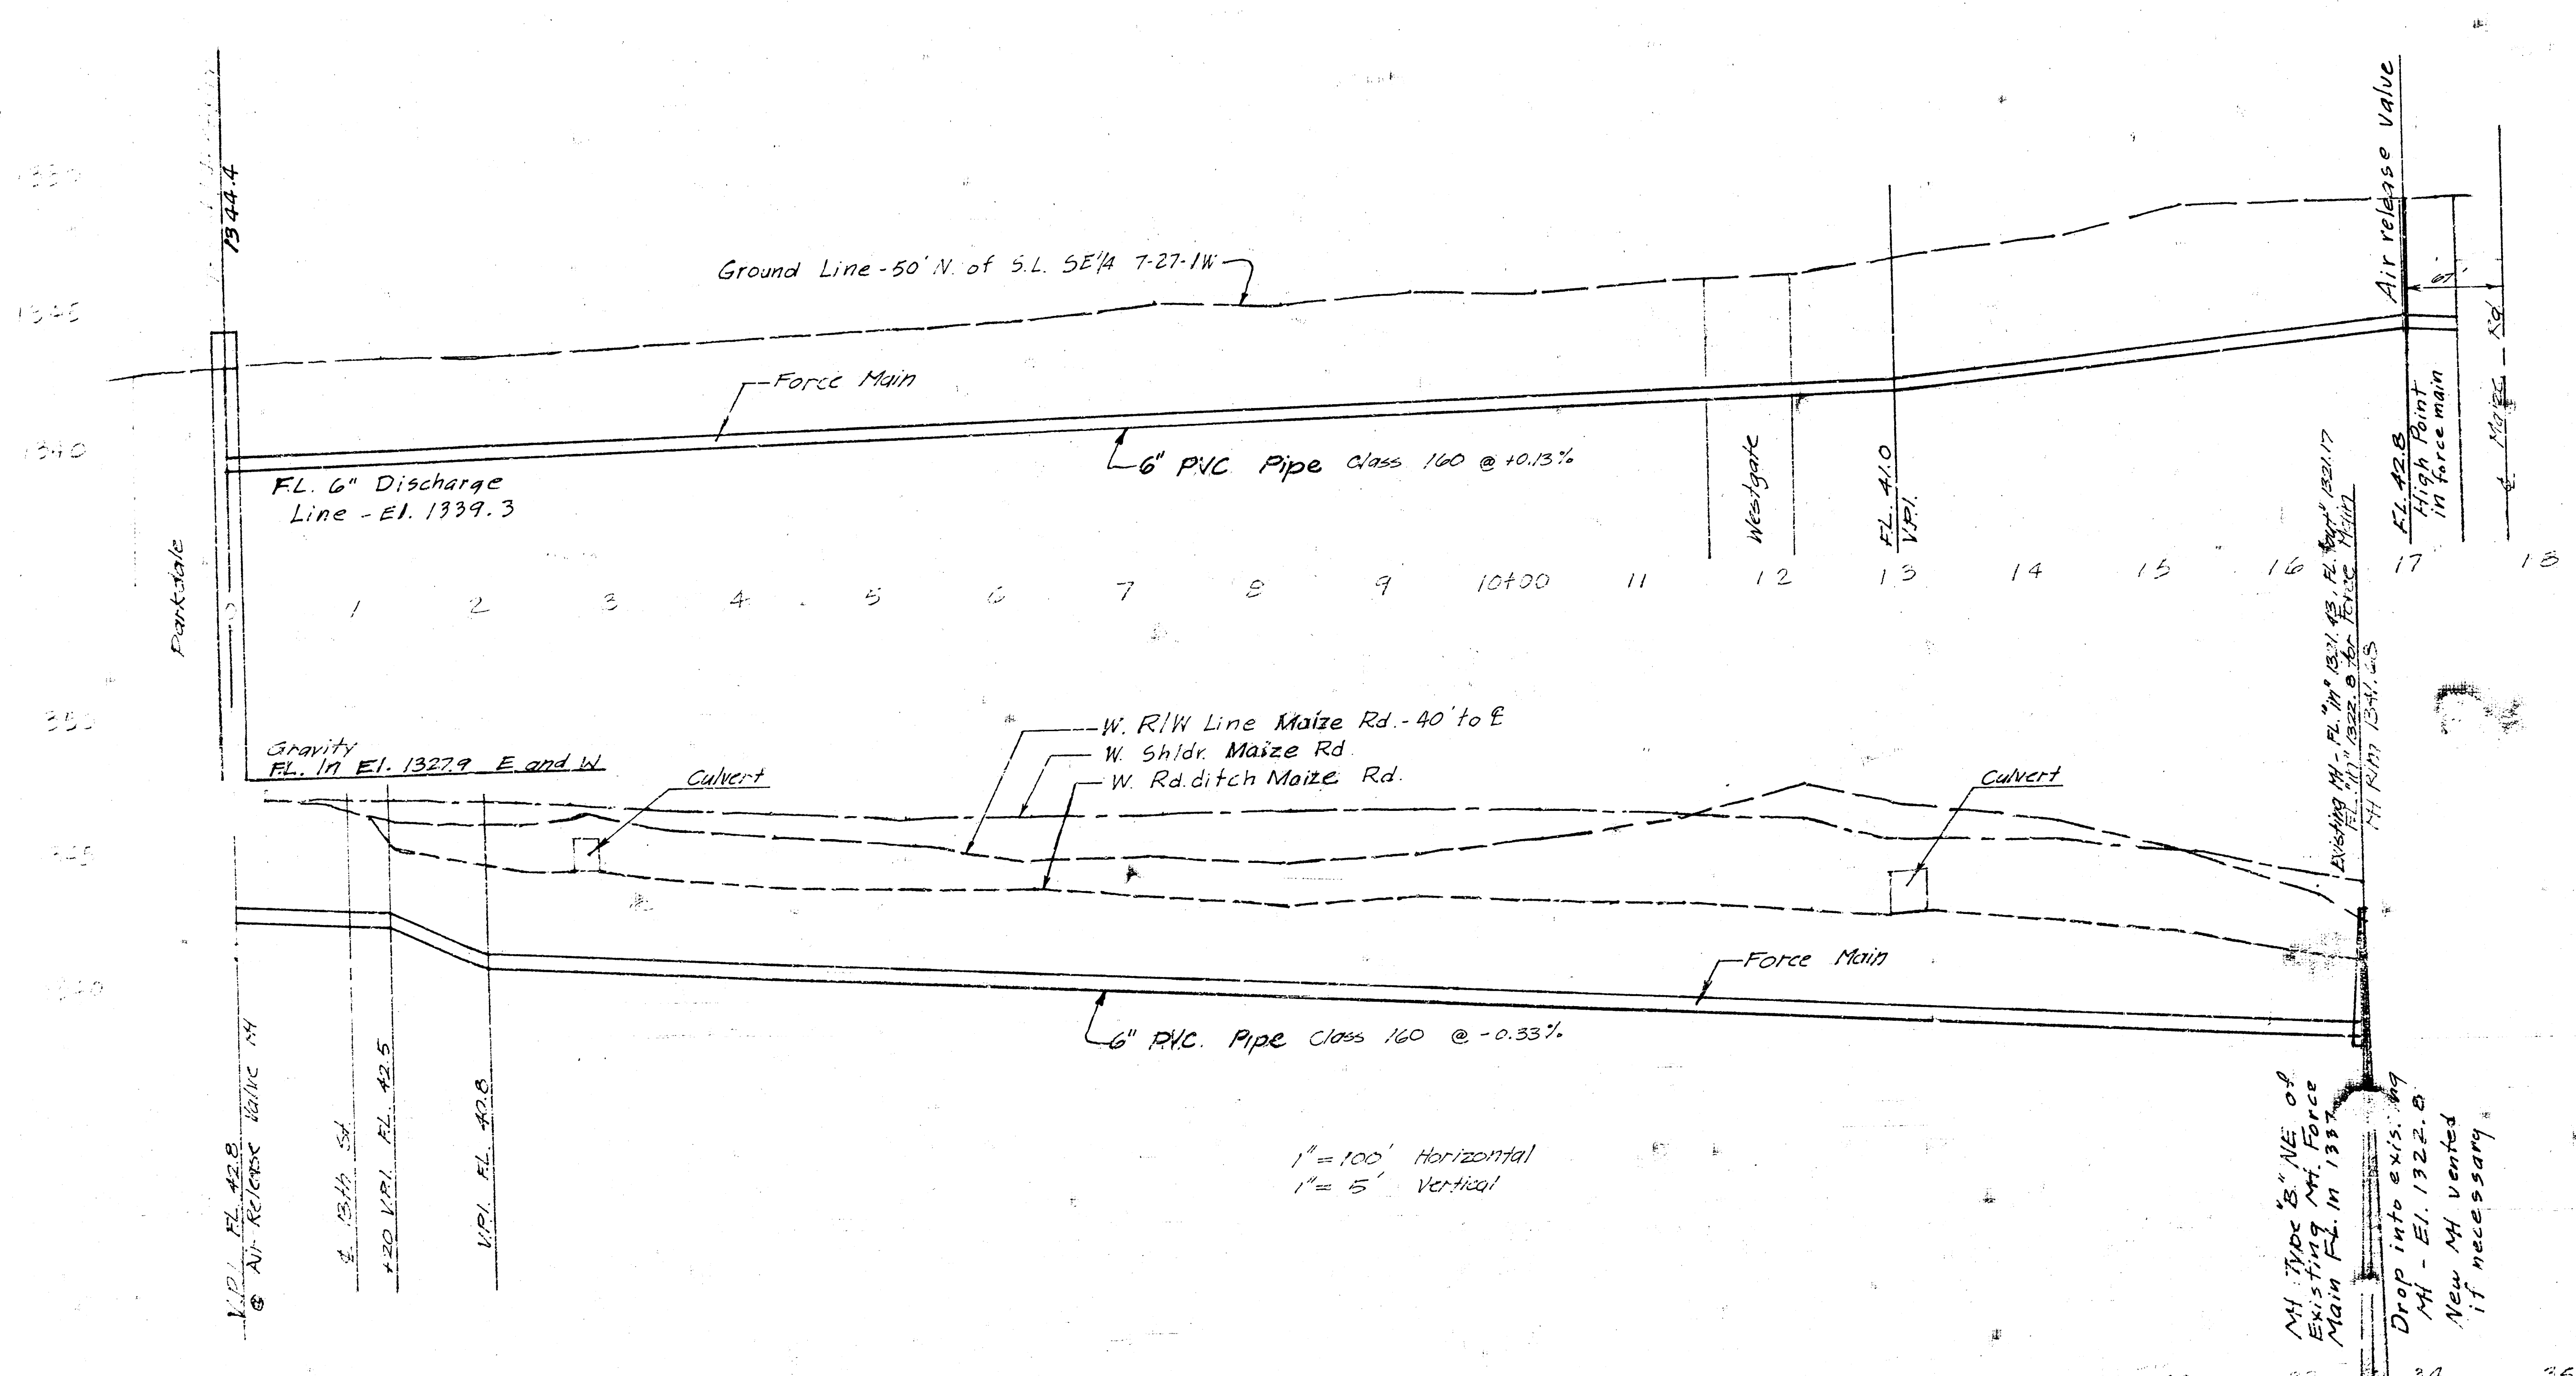


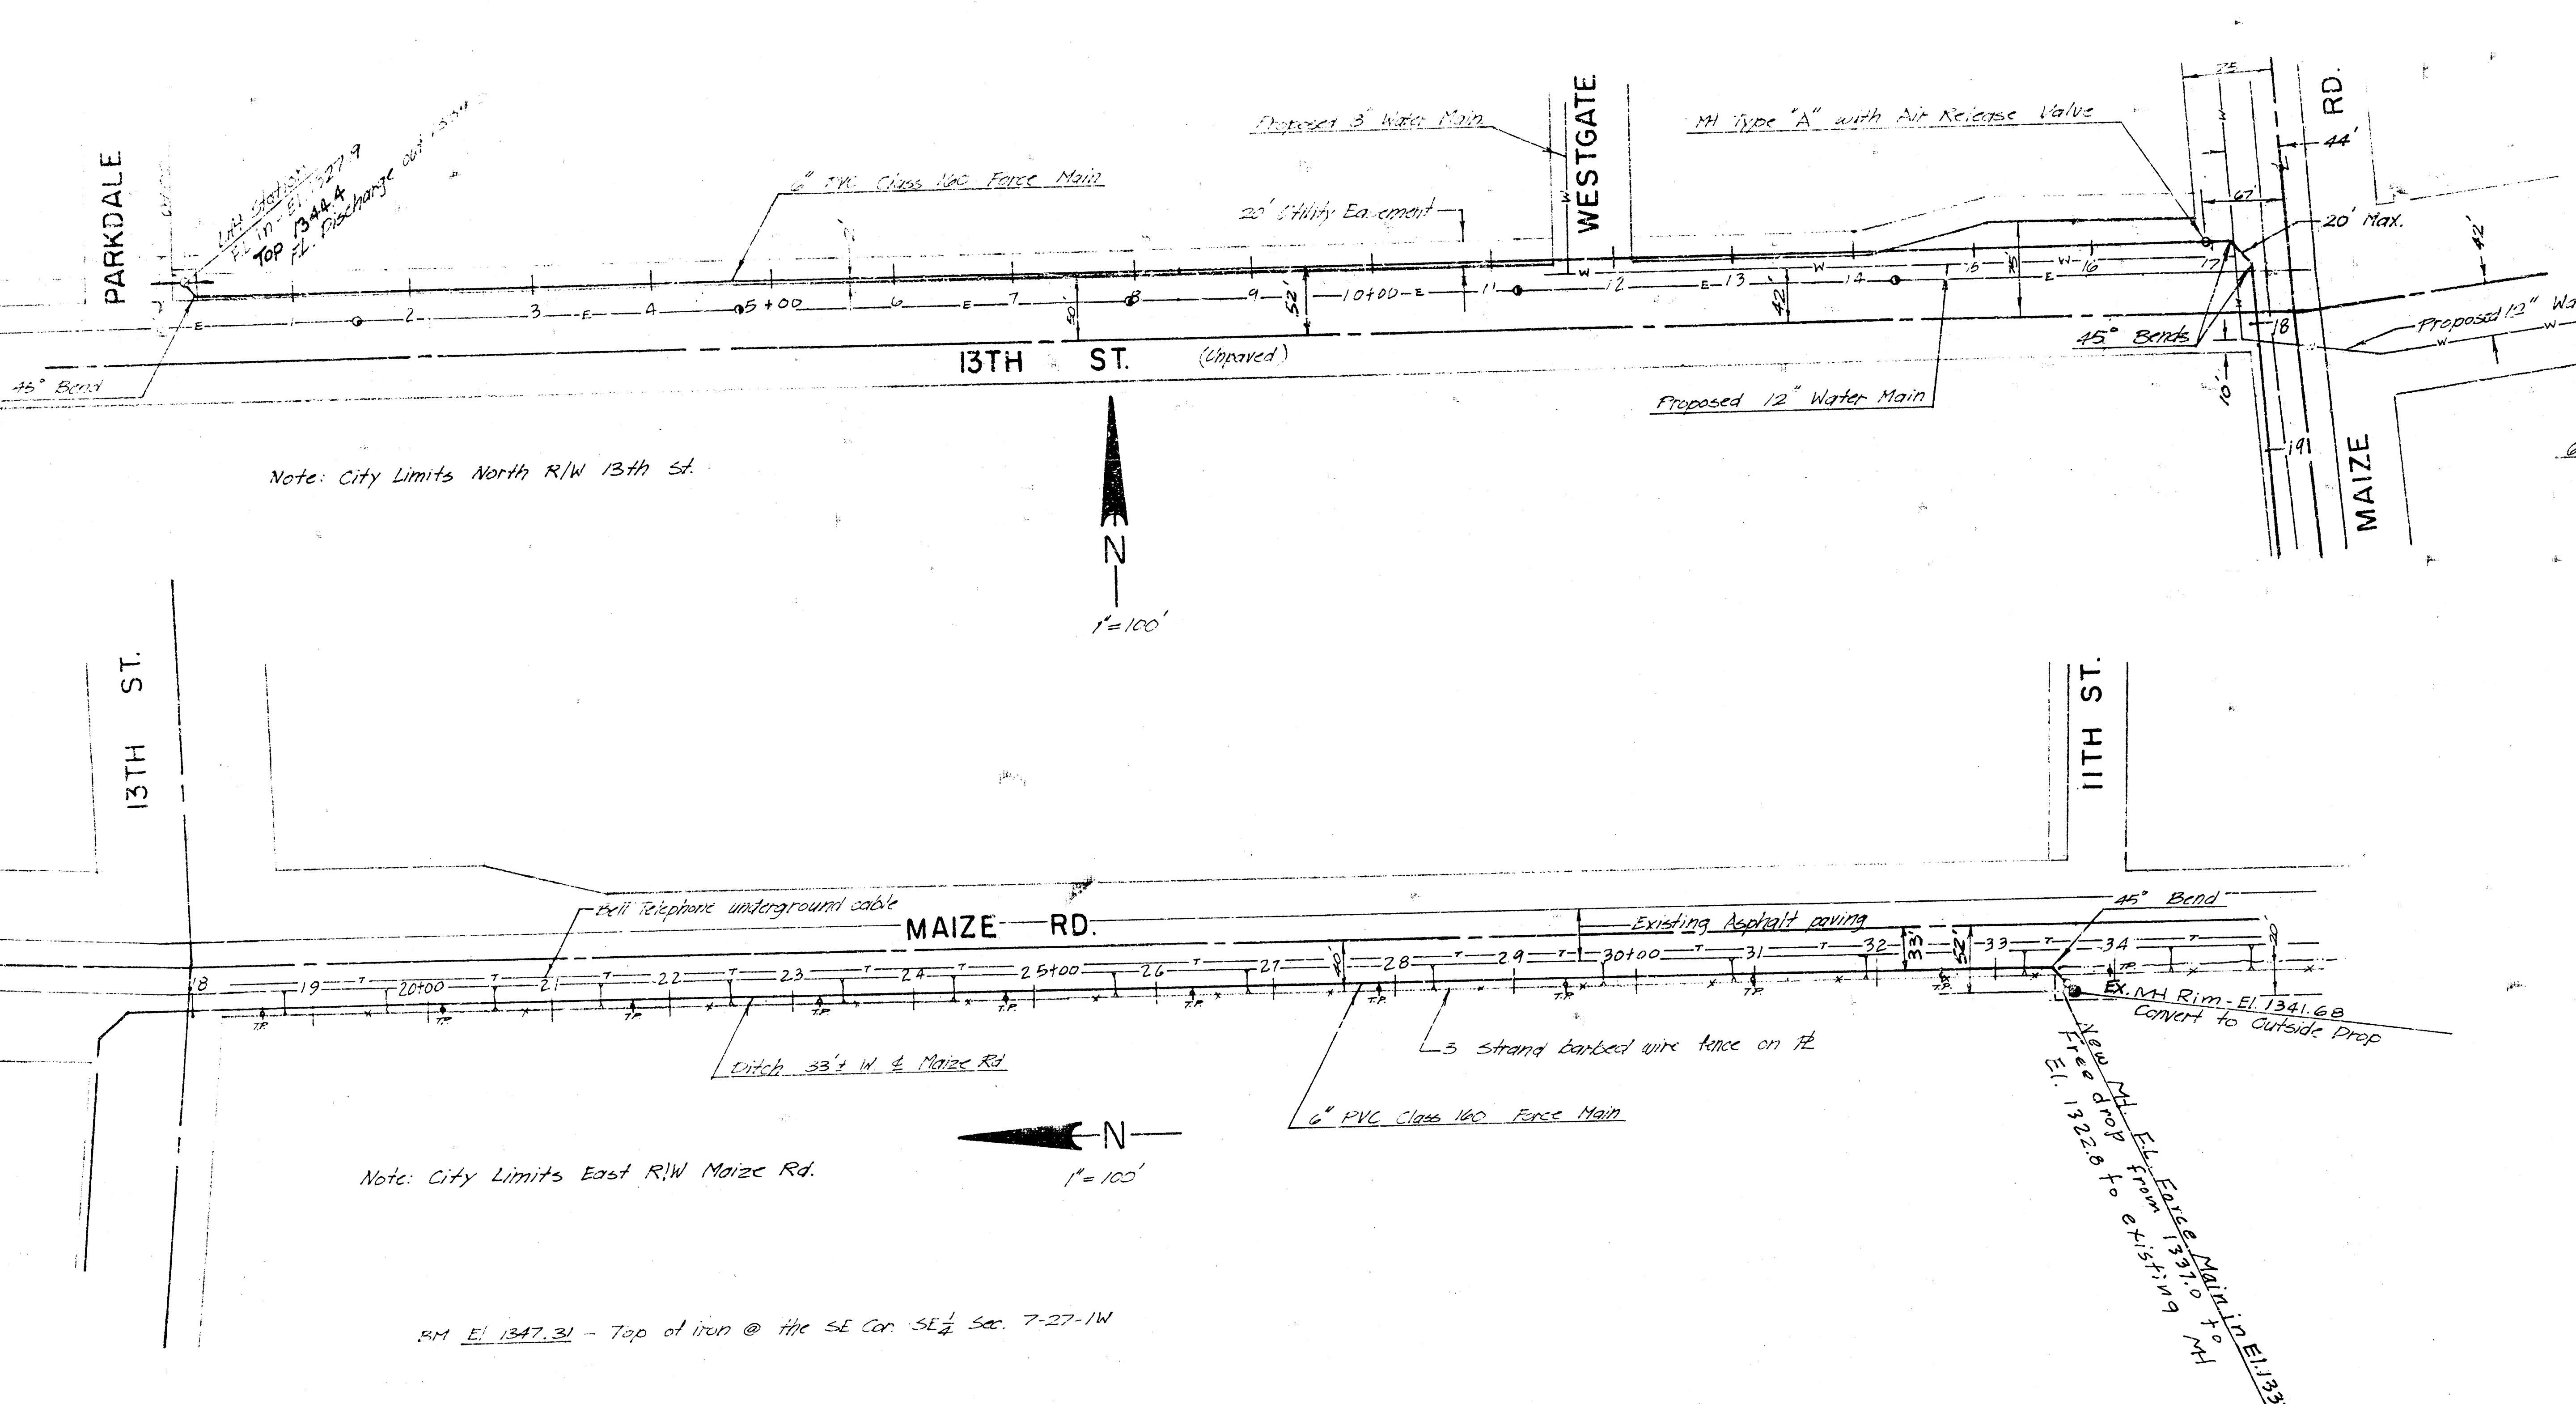

Force Main & LHM Station for Westlink Village Fourteenth Add. Wichita, Sedgwick County, Kansas

8-17-77

APPROVED AS NOTED
By CITY ENGINEER OF WICHITA

Sanitary Sewers *[Signature]*


Storm Sewers _____

Driveway Approaches _____

K.O. Taylor, P.E.
Rev. 7-21-77
Rev. 8-13-77
Rev. 8-16-77


NOTE TO CONTRACTOR
This project will be constructed under the supervision of the CITY ENGINEER and conforming to the SPECIFICATIONS of the CITY OF WICHITA. The CONTRACTOR will reimburse the City of Wichita for all cost of Engineering Plans, and Inspection.

Parkdale Water

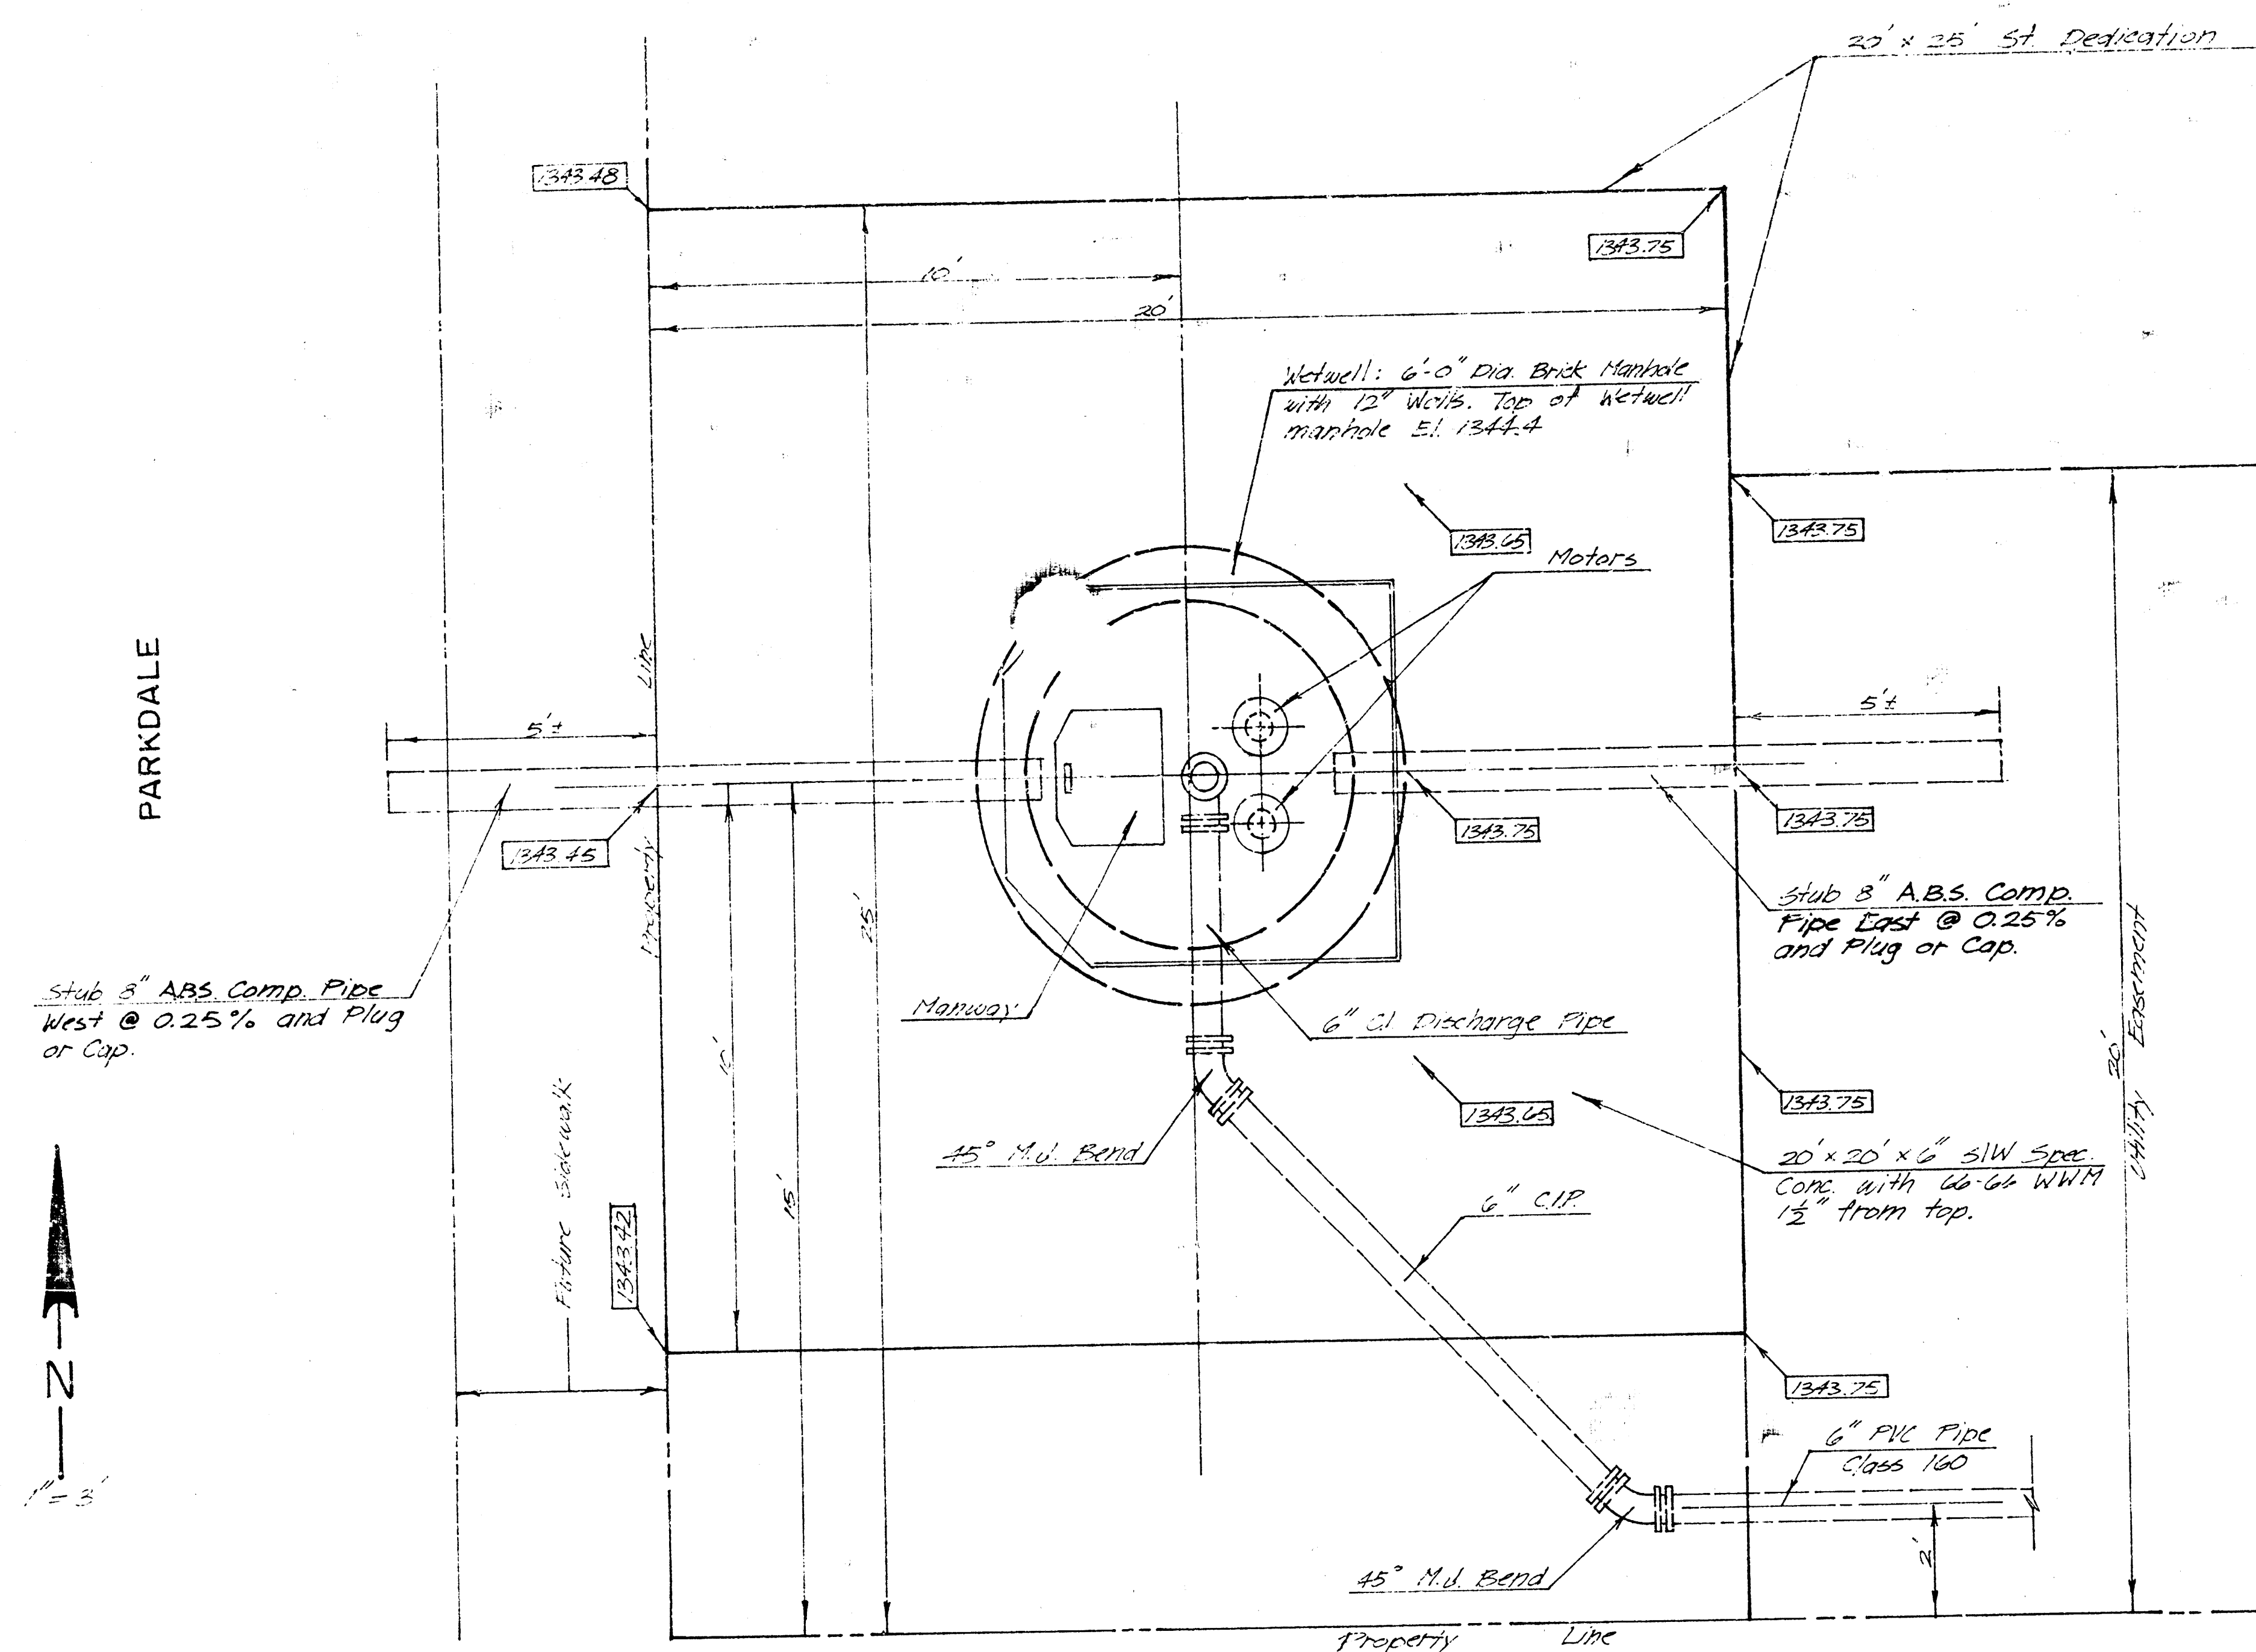


Note: Natural Ground El. 1343.4 ± @ LHM Station Site

13TH STREET
LIFT STATION DETAIL

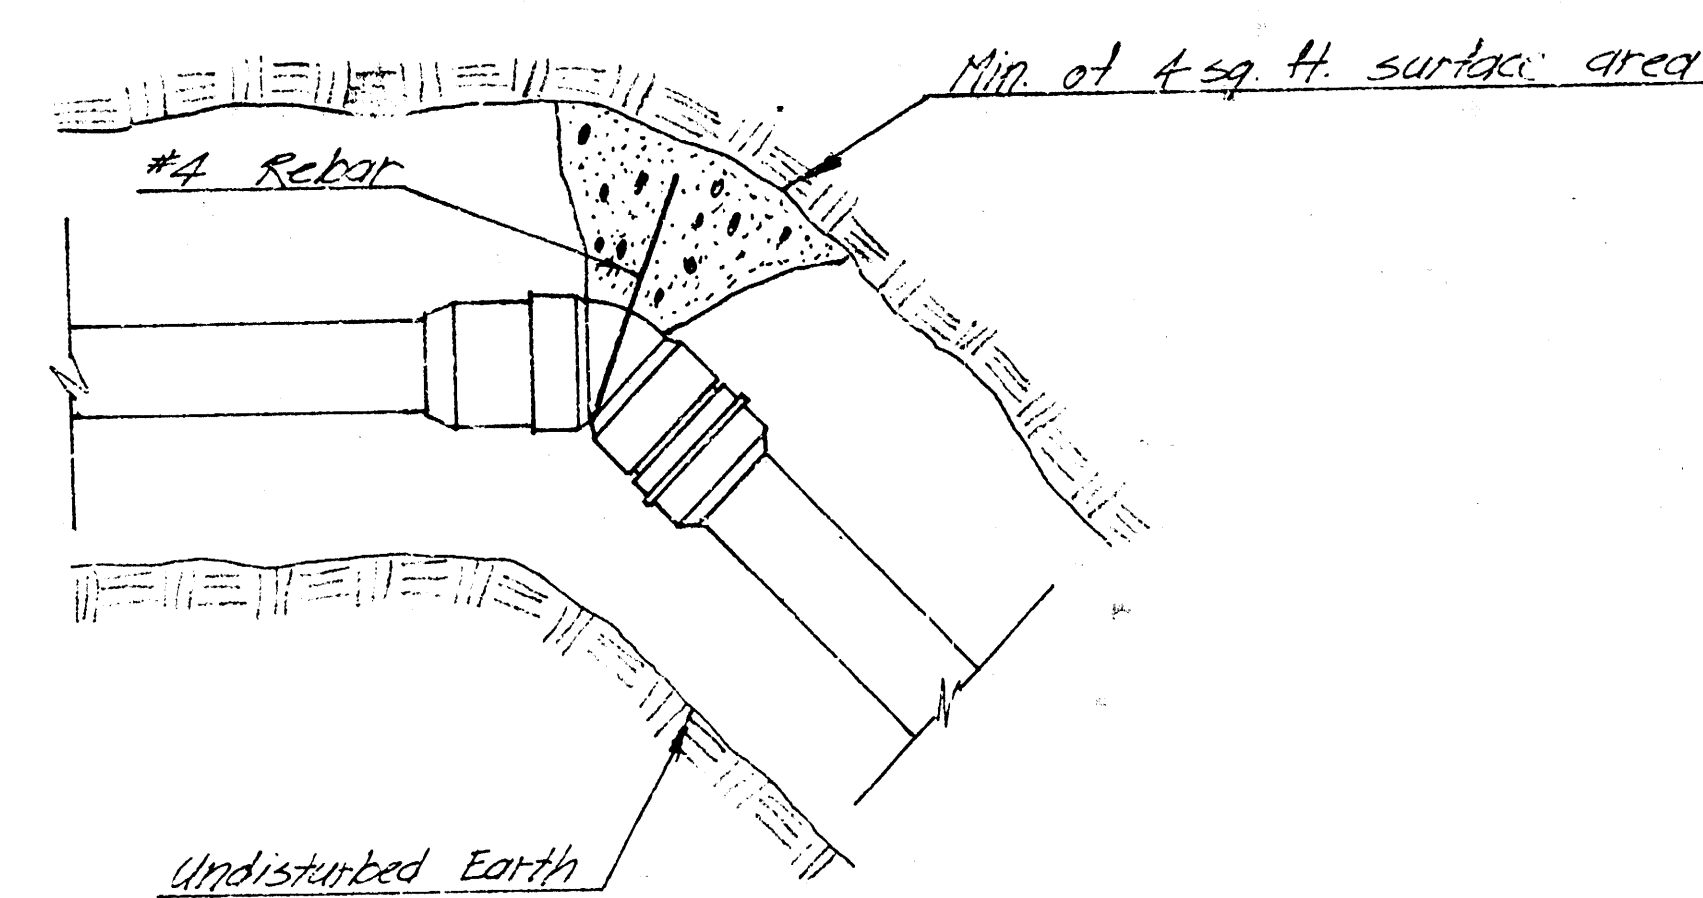

THRUST BLOCK DETAIL

B.M. El. 1347.31 - Top of Iron @ SE Cor. of E 1/4 Sec. 7-27-1N
City Datum = El. shown minus 1187.4

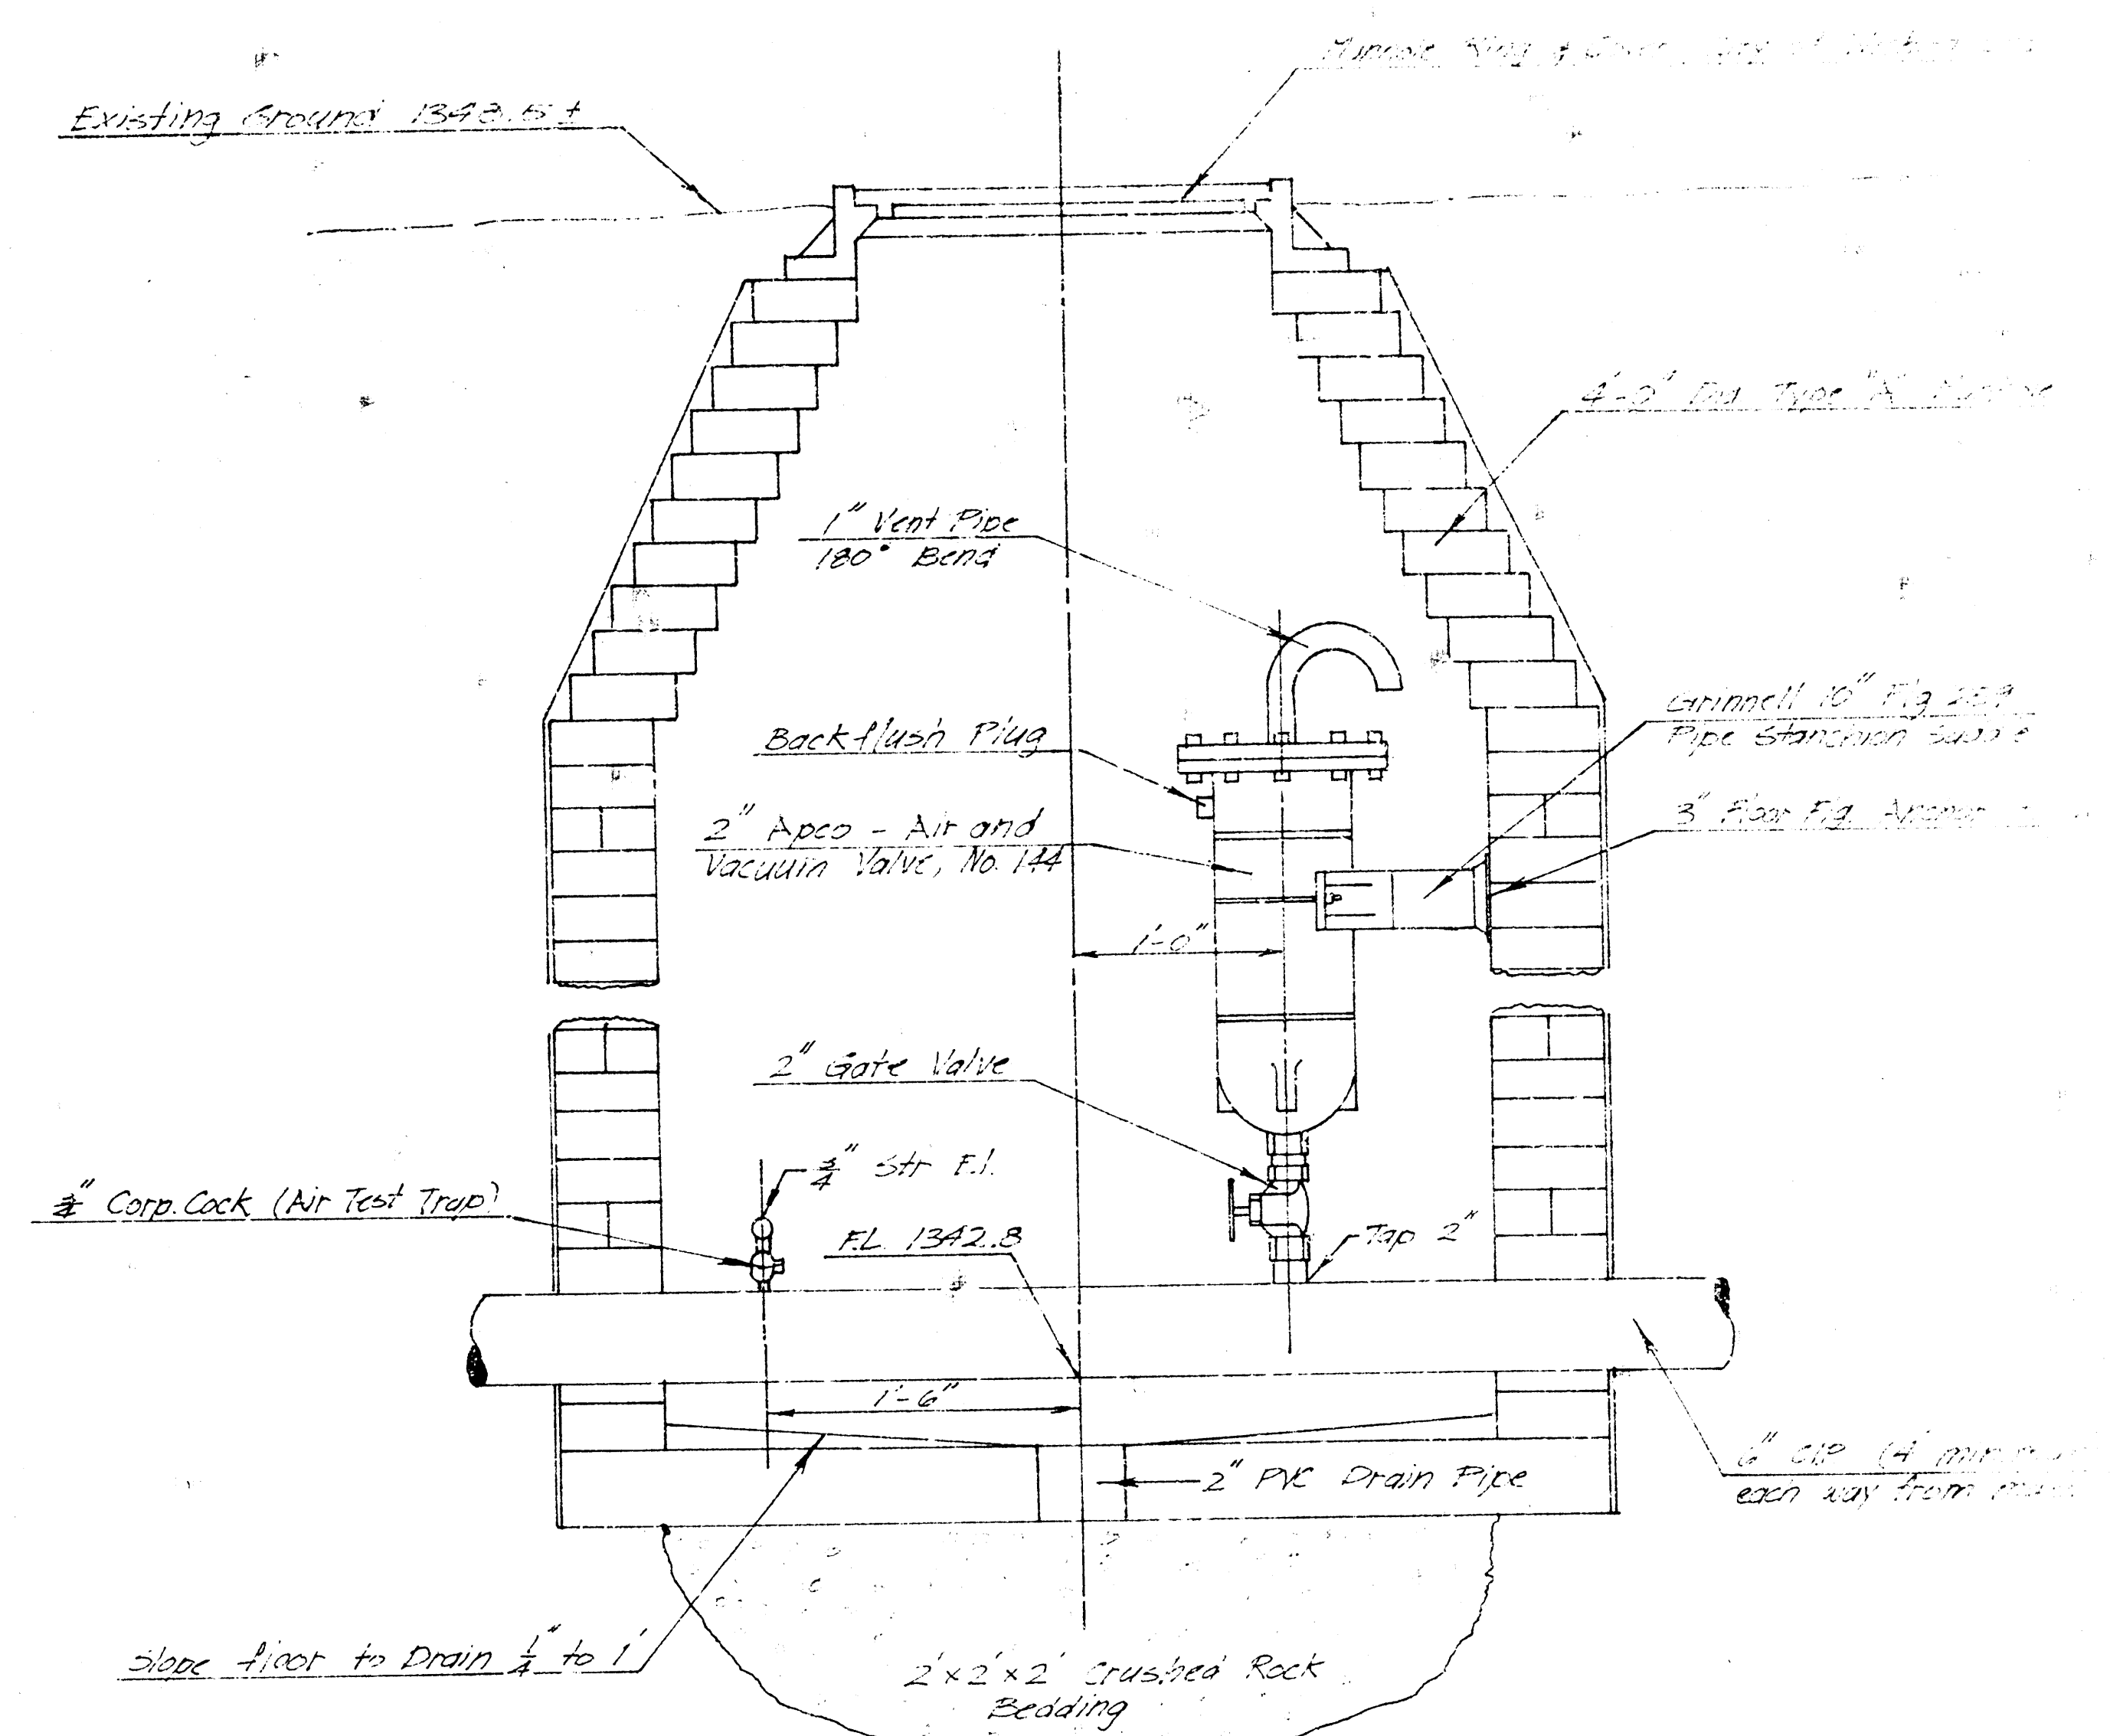

AIR-RELEASE VALVE MANHOLE
NO SCALE

K.O. TAYLOR, P.E.
AUG. 16, 1977



